




LADDER DETAILS

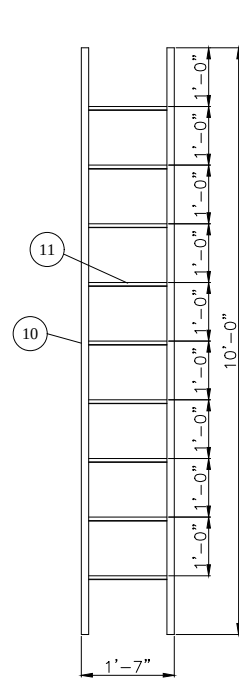


BOTTOM BAND DETAIL

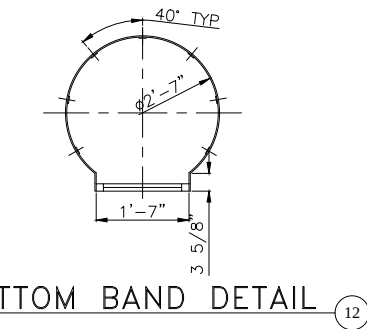

BAND DETAIL

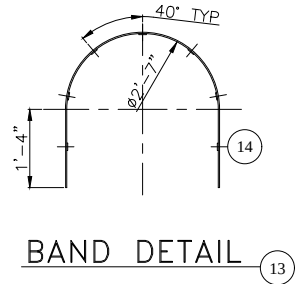


PLATFORM DETAILS

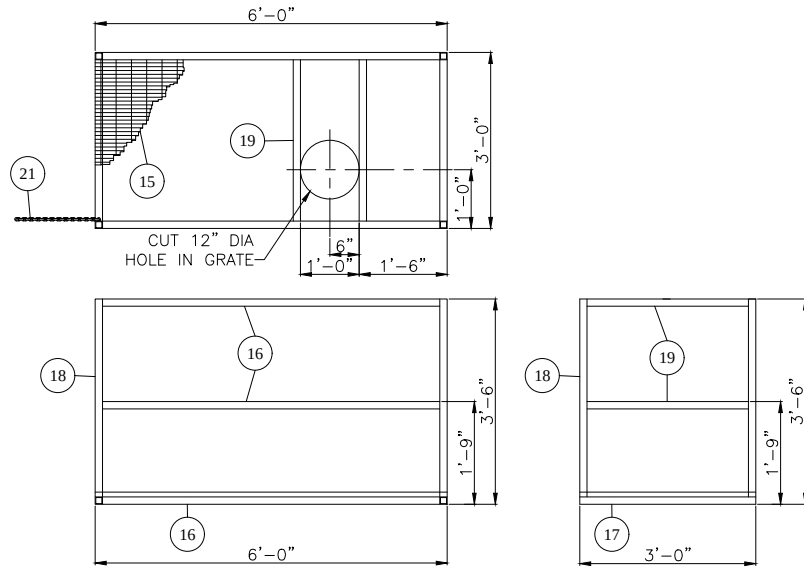


BILL OF MATERIALS

ITEM	REQ'D	PART	DESCRIPTION	MATERIAL	WEIGHT
1	12	INSUL	1 1/2" x 45" COV x 126" LG SHT RIGID URETH., CORR & STUCCO EMBOSS ALUM BOTH SIDES	-	-
2	4	INSUL	1 1/2" x 45" COV x 120" LG SHT RIGID URETH., CORR & STUCCO EMBOSS ALUM BOTH SIDES	-	-
3	40 FT	DOOR	C-CHANNEL	-	-
4	24 FT	DOOR	CORNER CHANNEL	-	-
5	24 FT	DOOR	DOOR FRAME	-	-
6	4	DOOR	HINGES	-	-
7	24 FT	DOOR	WEATHER STRIPPING	-	-
8	1	DOOR	CLOSURE	-	-
9	2	-	ACCESS DOORS FOR HEATERS	-	-
10	2	LADDER	RAIL: 1 1/2" x 1 1/2" x .100" HSS x 10-6" LG	SA-36	62#
11	9	LADDER	RUNGS: 1" x 1" x 1/8" ANGLE x 16" LG	SA-36	10#
12	2	CAGE	BAND: 2" x 1/4" FB ROLL TO 31" ID x 7'-1 1/4" LG	SA-36	24#
13	2	CAGE	BAND: 2" x 1/4" FB ROLL TO 31" ID x 6'-9 1/2" LG	SA-36	20#
14	7	CAGE	BAR: 2" x 1/4" FB x 7'-6" LG	SA-36	140#
15	1	PLATFORM	1" x 1/8" GRATING x 3'-0" W x 6'-0" W	SA-36	90#
16	6	PLATFORM	1 1/2" x 1 1/2" x .100" HSS x 5'-9" LG	SA-36	63#
17	2	PLATFORM	1 1/2" x 1 1/2" x .100" HSS x 3'-0" LG	SA-36	11#
18	4	PLATFORM	1 1/2" x 1 1/2" x .100" HSS x 3'-4 1/2" LG	SA-36	25#
19	4	PLATFORM	1 1/2" x 1 1/2" x .100" HSS x 2'-9" LG	SA-36	20#
20	10	PLATFORM	1 1/2" CLUTHE CAPS	POLY	-
21	1	PLATFORM	CHAIN c/w EYEBOLT AND CLIP	-	-
22	2	LOUVRE	12" x 12" FUGITIVE EMISSION VENT (NO SLIDE CLOSURE)	-	-

ELEVATION VIEW

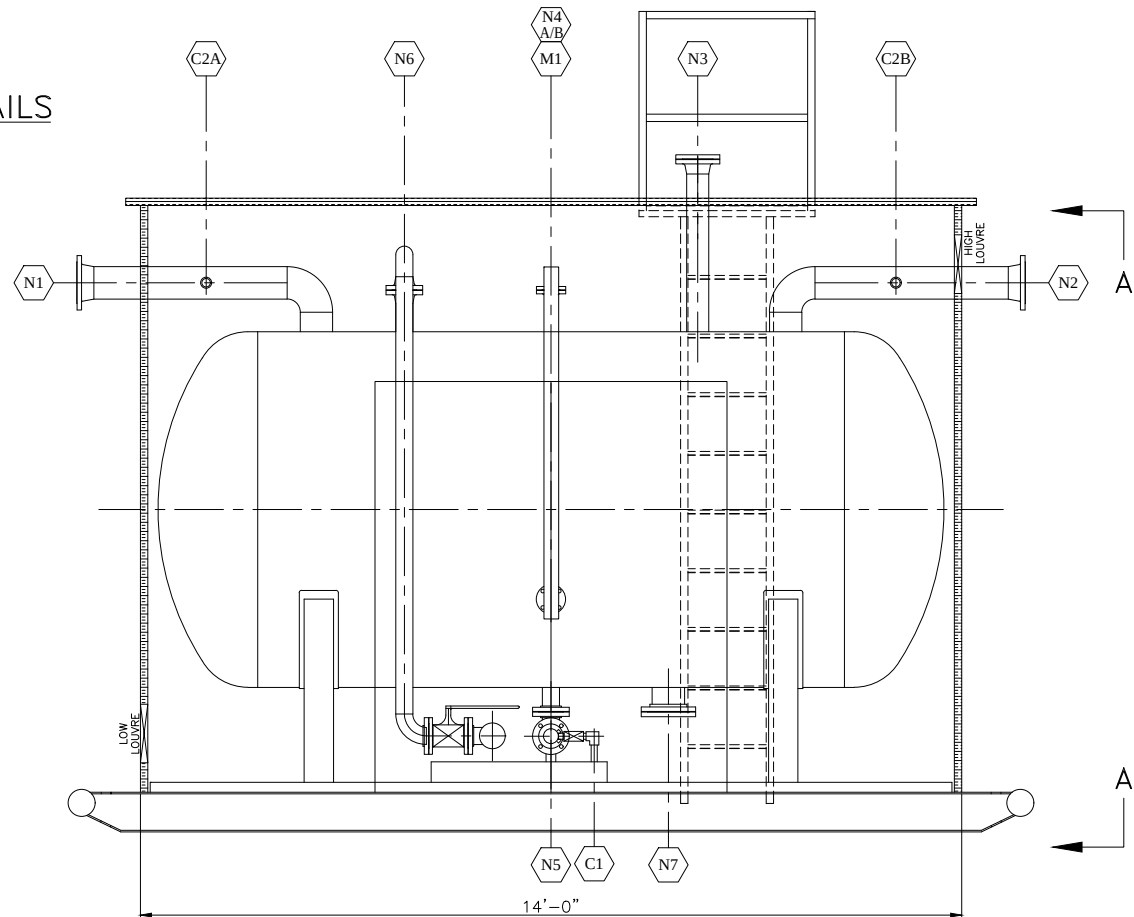

ORIENTATION VIEW A-A

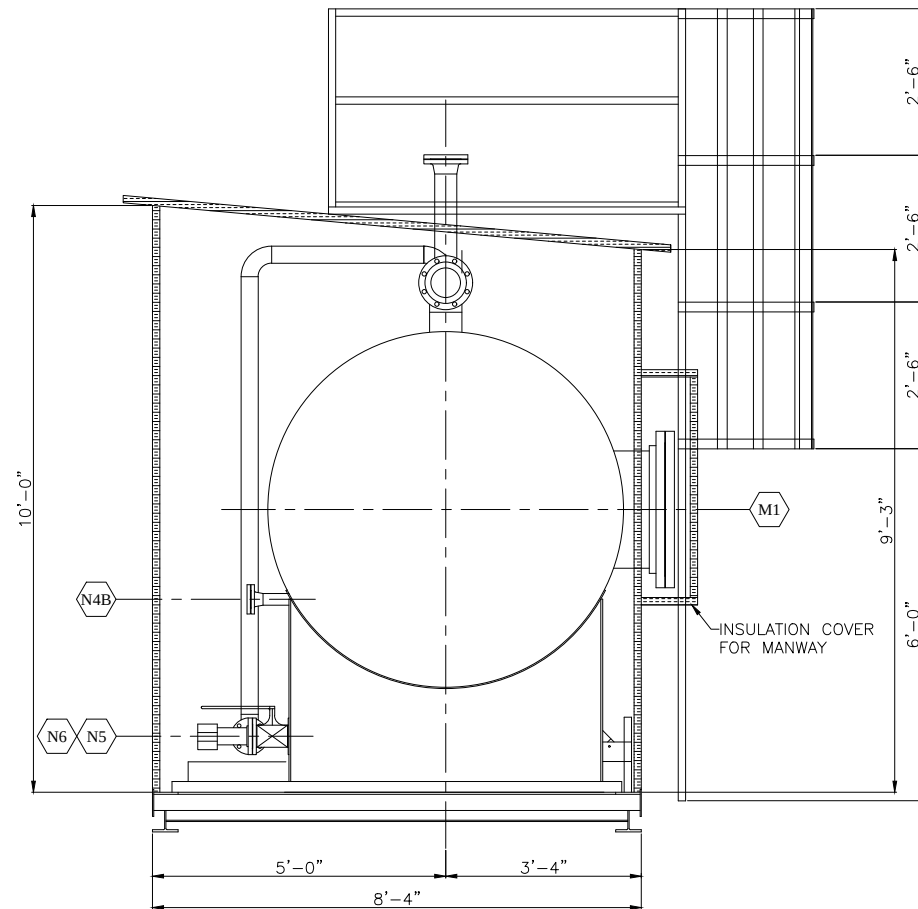

REV. NO.	DATE	REVISION	BY	APP'D
0	06/20/03	ISSUED FOR FABRICATION	DSG	
1	07/25/03	AS BUILT DRAWING	JMB	

BILTON
Welding & Manufacturing Ltd.
BOX 6106
5815 37 Street
INNISFAIL, AB
CANADA
403-227-7799
1-888-227-4923
FAX 227-7796

This drawing is property of BILTON WELDING & MANUFACTURING LTD., and is lent to the recipient for their confidential use only. In consideration of the loan of this drawing, the recipient promises and agrees that it shall not be used in any way detrimental to the interests of BILTON WELDING & MANUFACTURING LTD., that it shall be returned upon request, and that it shall not be reproduced, copied, lent, or otherwise disposed of, directly or indirectly, without the written consent of BILTON WELDING & MANUFACTURING LTD.

BP CANADA ENERGY			
60 BBL ABOVE GROUND SINGLE WALL FLARE KNOCKOUT DRUM BUILDING & LADDER DETAILS			
DATE: 06/20/03	SHEET: 3 OF 4		
SCALE: N.T.S.	JOB NO.:		
DRAWN BY: DSG	A662	SIZE D	
PURCHASE ORDER:	LOCATION: 10-07 COMPRESSOR	DRAWING NO.:	REV.
APP'D BY:	CRN: N/A	A662-3	1