

E:\Work\PC-516 B-13059 HDS362C w 10HP Tundra Oil & Gas co Asher Engineering AB\PID-A-B13059 Rev 2 AB.dwg, 11/27/13 11:12:27 AM, scottcp, Property of PC Compression Inc. Duplication or transmittal without written con

V-1800 FILTER/SCRUBBER

CUSTOMER SUPPLIED
Manufacturer: WATERFLOOD
Model: FUEL GAS-8
Size: 203mm x 1524mm LG
(8.625" x 60" LG)
MAWP: 1930kPag(280psi) @ 200°F
MDMT: -29°F @ 1793kPag(260psi)
N.L.
CRN:
Serial No:
c/w PECO RFG3R FILTER

F-1830 FILTER

CUSTOMER SUPPLIED
Manufacturer: PECO
Model: 89-1-336-6-285-2F
Size: 168mm x 1753mm LG
(6.625" x 69" LG)
MAWP: 1910kPag(277psi) @ 130°F
MDMT: -29°F @ 1910kPag(277psi)
Corrosion Allowance: 1/16"
PECO Element#: NGGC-336-PL20
PECO Gasket#: 8-150 FLEX
CRN:
Serial No:

K-1810 COMPRESSOR

Manufacturer: BLACKMER
Model: HDS362C
Discharge MAWP: 2310kPag(335psi) @ 200°F
Rated for 2310kPag(335psi) @ 8% H2S
Rating: 15HP @ 825rpm
Serial No:
c/w OIL FILTER
c/w HEAVY DUTY FLYWHEEL

D-1815 COMPRESSOR DRIVER

Manufacturer: TECO WESTINGHOUSE
Model: XH0104/575
Type: AEHHXU
Frame: 215T
HP Rating: 10hp @ 1800RPM
Rating: 600VAC/3PH/60Hz
AMPS:
Serial No:
CSA INVERTER DUTY
20:1CT 10:1VT

AC-1820 AIR COOLER


SHIP LOOSE
Manufacturer: AXH AIR-COOLERS
Model: 18VVF
c/w 457.2mm(18") 3 BLADE
Fan Make & Model: MOORE; 1K/S10
FAN SPEED: 1750 RPM
A/C MAWP: 1482kPag @ 177°C (215psi @ 350°F)
MDMT: -29°C @ 1482kPag (-20°F @ 215psi)
Corrosion Allowance: 3.2mm (0.125")
100% UT Header Seam; 100% RT NOZZEL BW ONLY; PWHT
CRN:
Serial No: _____ NB#: _____

D-1825 AIR COOLER DRIVER

c/w AC-1820, SHIP LOOSE
Manufacturer: TECO WESTINGHOUSE
Cat. No: XH0034/575
Type:
Frame: 182T
Rating: 2.2kW (3HP) @ 1800 RPM
600VAC/3PH/60Hz
AMPS:
CSA CLASS 1 GR C&D
Serial No:

BILL of MATERIAL


ITEM TAG	DESCRIPTION
PSV-1810	TAYLOR, 82D3341347, 1"x1" NPT, SET @ 200psi, 'D' ORIFICE
PSLL-1810	CCS, 6900GZE14, SET @ 20 PSI DECR.
PSLL-1811	CCS, 6900GZE12, SET @ 12 PSI DECR.
PSHH-1810	CCS, 6900GZE18, SET @ 175 PSI INCR.
TSHH-1810	CCS, 6900TUE18, SET @ 300 °F INCR.
TW-1810	THERMOWELL, ¾"x½"x3" LAG (1½"U) x ¾" BORE, 316SS
LSHH-1800	WELLMARK, 790SF-2A, 2" NPT
PI-1800	SSLF, ½"LM x 4" FACE, 0-60psi
PI-1810	SSLF, ¼"LM x 2½" FACE, 0-60psi
PI-1811	SSLF, ¼"LM x 2½" FACE, 0-300psi
PI-1812	SSLF, ¼"LM x 2½" FACE, 0-60psi
PI-1830	SSLF, ½"LM x 4" FACE, 0-300psi
PI-1831	SSLF, ½"LM x 4" FACE, 0-300psi
TI-1800	TREND, ½"CBM x3" FACE x2½" STEM, -40 to 160°F
TW-1800	THERMOWELL, ¾"x½"x2½" STEM x STD BORE, 316SS
TI-1811	TREND, ½"CBM x3" FACE x2½" STEM, 50 to 500°F
TW-1811	THERMOWELL, ¾"x½"x2½" STEM x STD BORE, 316SS
TI-1820	TREND, ½"CBM x3" FACE x2½" STEM, -40 to 160°F
TW-1821	THERMOWELL, ¾"x½"x2½" STEM x STD BORE, 316SS
LG-1800	PENBERTHY, 1RM-6, NACE
GV-1800/1802	PENBERTHY, 330J, GUAGE VALVE, NACE
LG-1830	PENBERTHY, 1RM-4, NACE
GV-1830/1831	PENBERTHY, 330J-NQ, ½"x½"x½" GUAGE VALVE, NACE
CS-1800	STRAINER, 1½"150#, 150% O.A., #40 MESH
1800	FLEXTech, 285psi@100°F, 215psi@350°F, 1½" 150#x8½" LG
LSHH-1830	WELLMARK, 790SF-2A, 2" NPT
FC-1830	MURPHY, 1"x1"x2" - 8½" E-E, 15700799

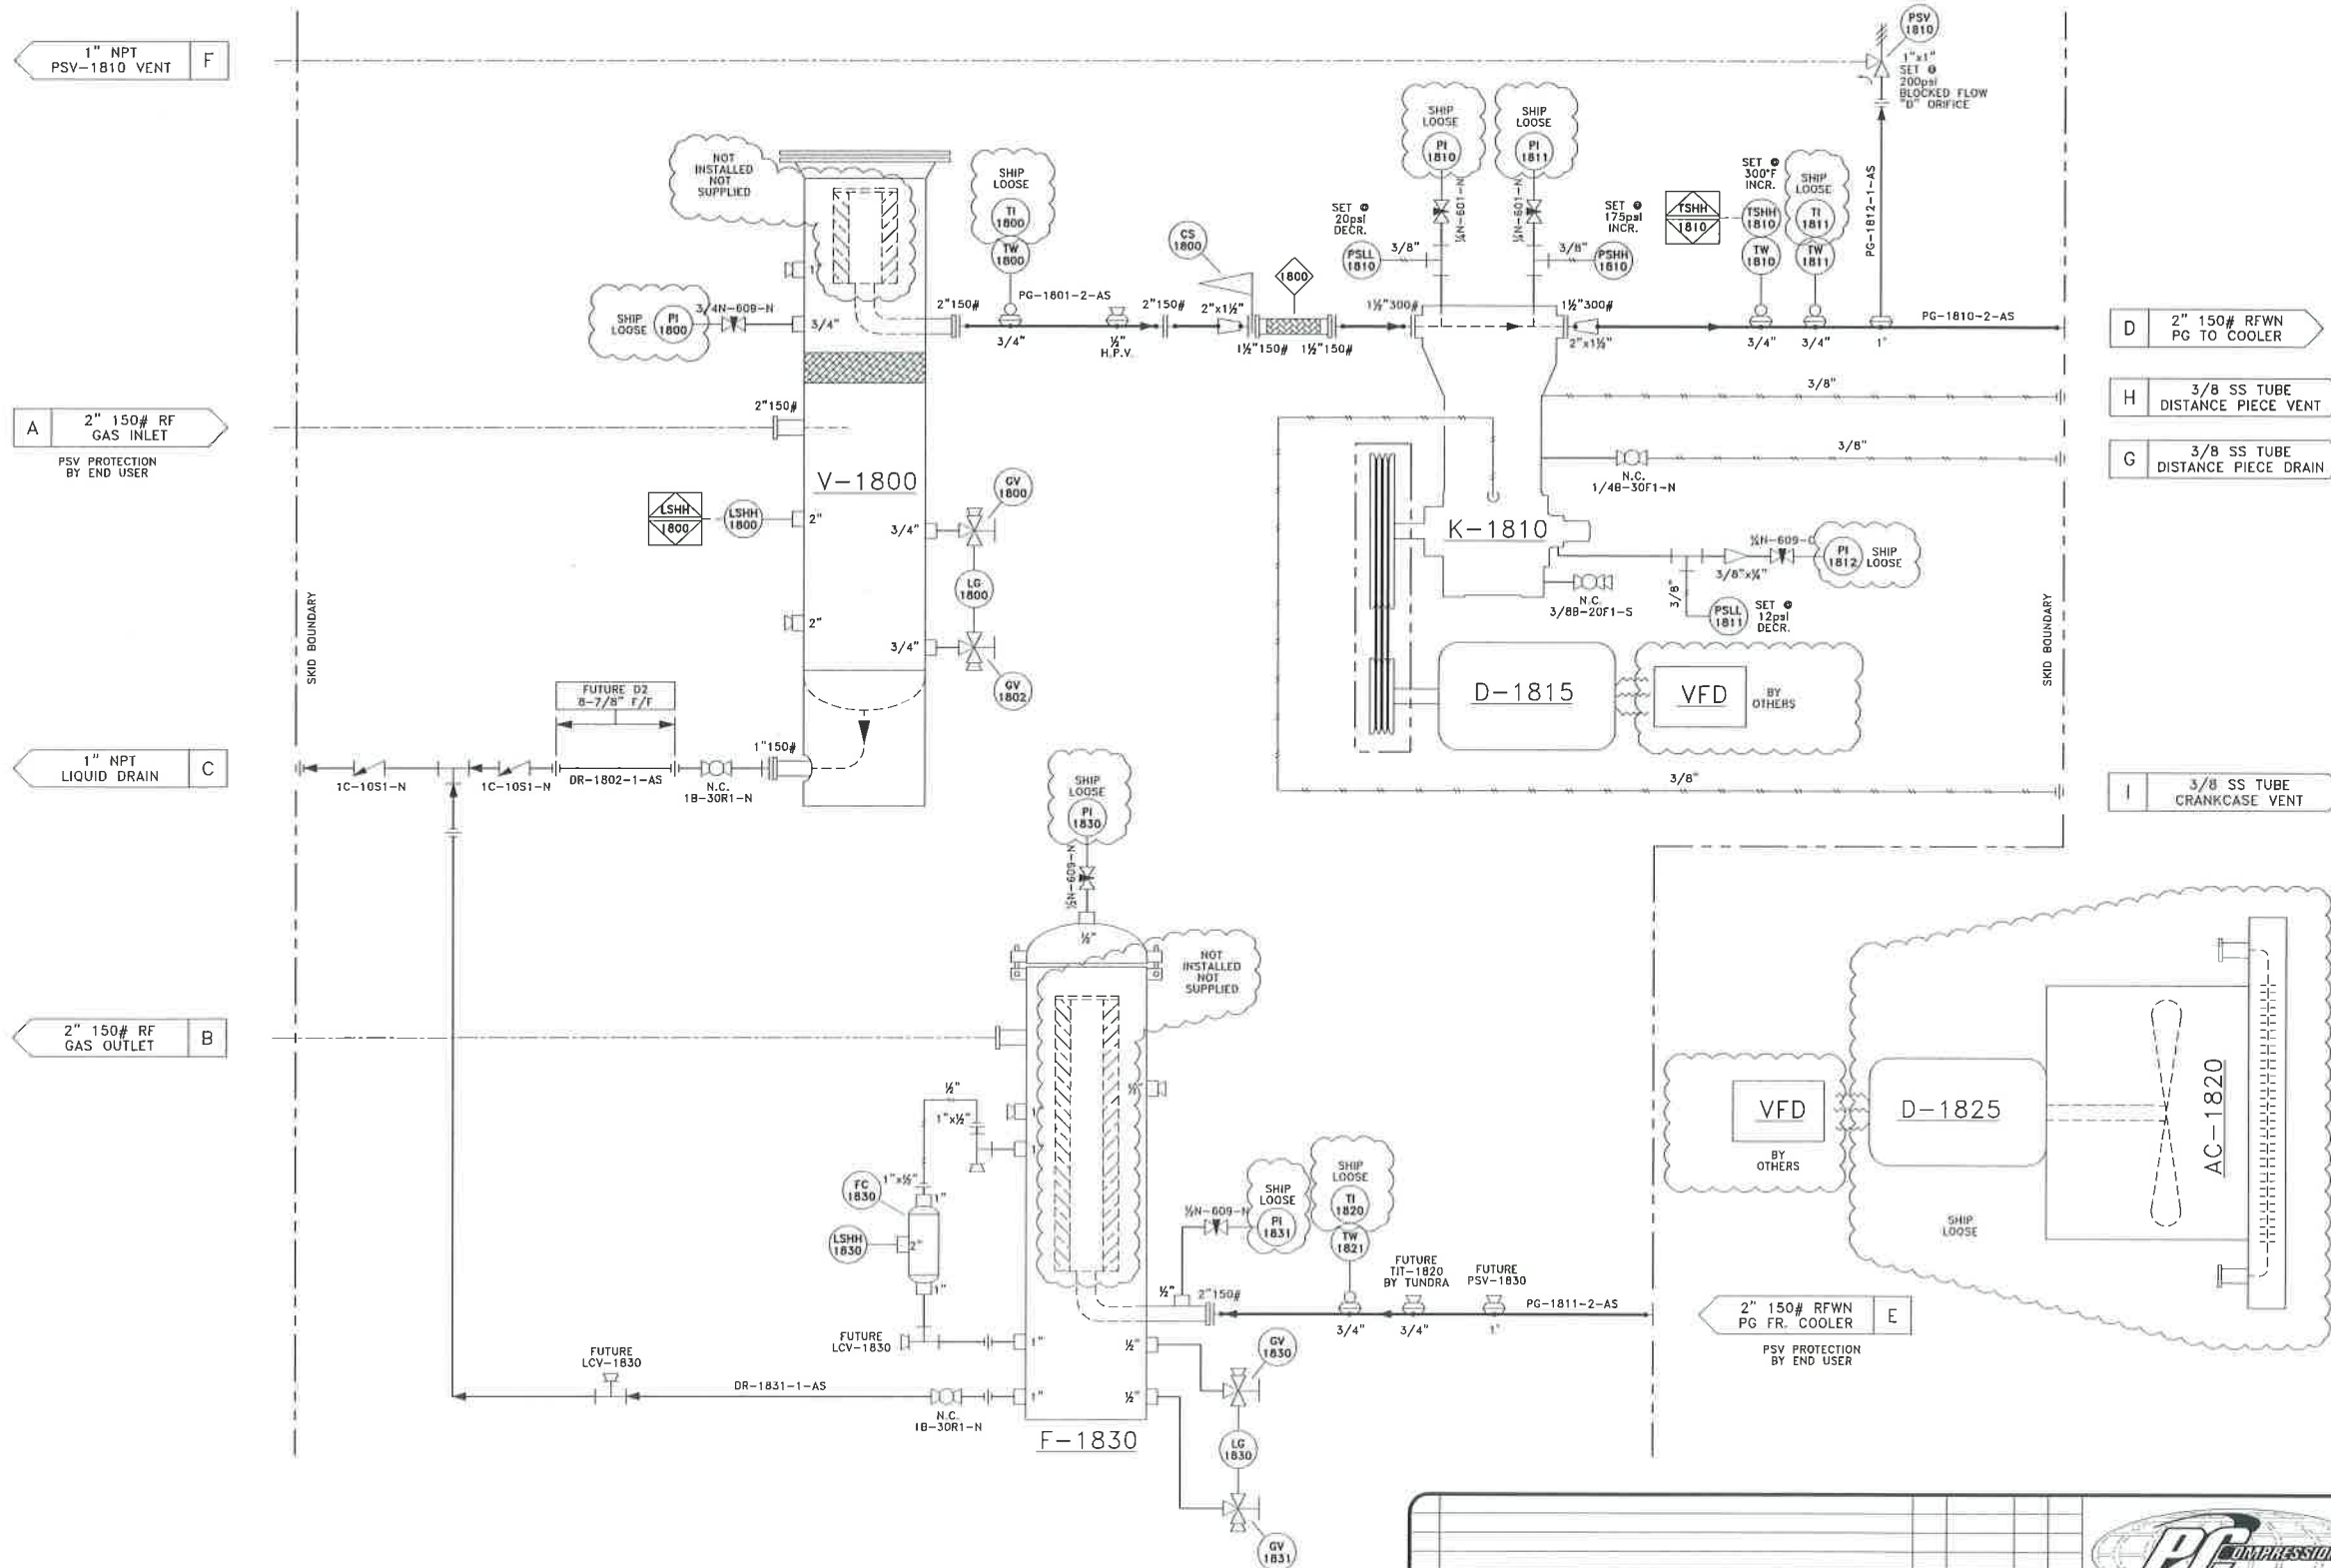

AS-BUILT DRAWING
NAME: *SDC*
NOV 27 2013

LSD: 13-14-08-29 W1M
AFE: 02013412FC
PO#: 1772R001

REV.	DESCRIPTION	BY	DATE	CHKD	APPD
2	AS BUILT	SDC	11-27-13		
1	REVISION TO ADD LEVEL CONTROL FLOAT CAGE	SDC	11-01-13	SDC	GDB
0	ISSUED FOR CONSTRUCTION	SDC	10-29-13	SDC	GDB
A	ISSUED FOR APPROVAL	SDC	10-09-13	SDC	GDB

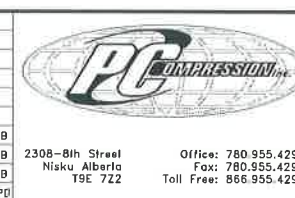

Drawn by: S.D.C.	FUEL GAS COMPRESSOR PKG BLACKMER HDS362C w/ 10HP ELECTRIC SKID MOUNTED, SOUR SERVICE				
Date: 10-04-13					
Checked by: <i>SDC</i>					
Approved by: <i>SDC</i>	Company: TUNDRA OIL & GAS LTD.				
Scale: N.T.S.	Quote/Ref. No.: Q-13047 R.1	JOB NO.: PC-516	Unit NO.: B-13059	Drawing NO.: PID-B13059-A-01	Rev.: 2

E:\Work\PC-516 B-13059 HDS362C w 10hpTundra Oil & Gas co Astor Engineering AB\PID-A-B13059 Rev 2 AB.dwg, 11/28/13 1:46:54 PM, scottlec, Property of PC Compression Inc, Duplication or Transmittal without written conse

A-GENERAL NOTES:

1. REFERENCE DRAWINGS:

PID-B13059-A-01	ISO-B13059-C-01	SKD-B13059-D-01
GA-B13059-B-01	ISO-B13059-C-02	SKD-B13059-D-02
GA-B13059-B-02	ISO-B13059-C-03	
GA-B13059-B-03	ISO-B13059-C-04	
GA-B13059-B-04	ISO-B13059-C-05	

B-DESIGN & MATERIAL NOTES:

- PROCESS PIPING CONSTRUCTED TO ASME B31.3-2012, NORMAL SERVICE
- SOUR SERVICE PACKAGE, 0.25% H2S NATURAL GAS
- SPEC 'AS' PIPING:

CORROSION ALLOWANCE: 0.0625"(1.5mm), UNLESS NOTED OTHERWISE
DESIGN: MAWP: 215psig @ 350°F (1482kPag @ 177°C)
MDMT: -20°F @ 215psig (-29°C @ 1482kPag)
LEAK TEST: 323psig (2227kPag) @ AMBIENT TEMPERATURE (>40°F)
w/ HYDROTEST. 15MIN HOLD TIME MIN..

PIPE/NIPPLES: NPT: ¼" TO ¾", 316SS, SCH.80 ONLY

NPT: ½" TO 1", A-106-B, SCH.160
BW: 1½" TO 2", A-106-B, SCH.80

FITTINGS: NPT: ¼" TO 1", cl.3000, A-105N/A-234-WPB
BW: 1½" TO 2", SCH.80, A-234-WPB

FLANGES: NPT: 1" 150# RFTHRD, A-105N
BW: 1½" TO 2" 150# RFWN, SCH.80, A-105N

VALVES: BW: 1½" 300# RFWN, SCH.80, A-105N
2B-1R4-N - 2" 150# RF, RP, KF, E2150-1922G21, NACE, CS, SHIP LOOSE

1B-30R1-N - 1" NPT 3000#, KF, K3R10TH30SZ, NACE, CS
3/8B-20F1-S - 3/8" NPT 2000#, MA STEWART, G2, NACE, SS
¼B-30F1-N - ¼" NPT 3000#, KF, K3100-81231N, LT, NACE, CS
1C-10S1-N - 1" NPT 1000WOG, WHEATLEY, 820-013100-231, NACE

¾N-609-N - ¾"x½" NPT MxF 6000# AG, H7VIS-46Q-SG, NACE
½N-609-N - ½" NPT MxF 6000# AG, H7VIS-44Q-SG, NACE
½N-601-N - ½" NPT FxF 6000# AG, H7VIS-40-SG, NACE
¼N-601-N - ¼" NPT FxF 6000# AG, H7VIS-2-SG, NACE
¼N-609-S - ¼" NPT MxF 6000# AG, H5RDC-22, NACE

STUDS: ALL SIZES, A-193-B7M

NUTS: ALL SIZES, A-194-2HM, HEAVY HEX HEAD

GASKETS: ALL SIZES, RF, 316SS SPIRAL WOUND, NON-ASBESTOS/GRAPHITE
FILLER

BUSHINGS: BUSHINGS ALLOWED ONLY IF BRANCH IS 2NPS SMALLER
& SWAGES: THAN RUN. CONNECTIONS TO EQUIPMENT (COMPRESSOR,

VESSELS, ETC.) OR IF THE LINE RATIO IS LESS THAN 2:1,
SWAGES ARE TO BE USED.

INST. TUBING: ¾" TO ½", 0.035"(20ga.) WALL, A-269-316SS

TUBE FITTINGS: ¾" TO ½", 316SS, HY-LOK

THREAD SEALANT: JETLUBE V2 OR EQUAL

C-MISCELLANEOUS NOTES:

- PACKAGE FOR USE WITH SOUR NATURAL GAS MAX. 0.25% H2S.
- EXTERIOR FINISH: COMMERCIAL SANDBLAST TO SSPC-SP6 (NACE#3)
FINISH: ONE (1) COAT OF CLOVERDALE 835 DTM
COLOUR: WARM GRAY

- BUILDING: N/A
- SKID INSULATION: NONE
- SHOP RUN TEST: ONE (1) HOUR MIN.

D-ELECTRICAL NOTES:

- AREA CLASSIFICATION: CLASS I ZONE I
- FULL PACKAGE CSA APPROVAL: AT INSTALL SITE BY END USER
- FES STUDY: N/A
- LOCAL PERMIT & INSPECTION: N/A
- ALL WIRING BY END USER

E-INSPECTION AND TESTING NOTES:

- RADIOGRAPHY: SPEC 'AS' 100% OF BUTTWELDS
- MAGNETIC PARTICLE: NONE
- UT: NONE
- PWHT: NONE
- HARDNESS TESTING: NONE
- LEAK TEST TO PRESSURES INDICATED ABOVE IN SECTION 'B'
- CUSTOMER HOLD POINTS:
 - SKID WELDING: TBA
 - B-PRESSURE: TBA
 - LEAK TESTS: TBA
 - FINAL INSPECTION / LOADOUT: TBA

F-OPERATING CONDITIONS:

- SUCTION PRESSURE: NEAR 103 to 172kPag (15 to 25psig)
- DISCHARGE PRESSURE: 551 to 1034kPag (80 to 150psig)
- INLET TEMPERATURE: 29°C (68°F)
- DISCHARGE TEMPERATURE: 49°C (120°F) AFTER COOLER @ 90°F AMBIENT
- COMPRESSOR OPERATING RANGE: 415 to 680 rpm
- FLUID SPECIFIC GRAVITY: PER GAS ANALYSIS, SOUR (0.25%) NATURAL GAS
(CONSULT WITH PC COMPRESSION INC. FOR OPERATION OUTSIDE THESE CONDITIONS.)

G-LUBRICATION:

- OIL TYPE: COMP122

H-SHUTDOWN SETTINGS (INITIAL):

PSLL-1810 = 138kPa (20psi) FALLING
PSLL-1811 = 83kPa (12psi) FALLING
PSHH-1810 = 1207kPa (175psi) RISING
TSHH-1810 = 149°C (300°F) RISING

I-BELT DRIVE:

- COMPRESSOR SHEAVE: FLYWHEEL, '3B' GROOVE 16.0" PD
- MOTOR SHEAVE: '3B' GROOVE 6.0" PD
- COMPRESSOR BUSHING: SK-1½" BORE
- MOTOR BUSHING: SD-1½" BORE
- BELTS: (3) Bx68

J-SHIP LOOSE:

- FIVE (5) 2B-1R4-N BALL VALVES
- TWO (2) 1B-30R1-N BALL VALVES
- ONE (1) ½N-601-N NEEDLE VALVE
- ONE (1) AC-1820 COOLER & MOTOR
- ONE (1) FISHER 627, 1" NPT, ¼" ORIFICE, 5-20psi, ALTA SOUR

AS-BUILT DRAWING
NAME: SDC

NOV 27 2013

LSD: 13-14-08-29 W1M
AFE: 02013412FC
PO#: 1772R001



						Drawn by: S.D.C.	FUEL GAS COMPRESSOR PKG. BLACKMER HDS362C w/ 10HP ELECTRIC SKID MOUNTED, SOUR SERVICE			
						Date: 10-04-13				
						Checked by: SDC				
						Approved by: GEB				
						Scale: N.T.S.	Company: TUNDRA OIL & GAS LTD.			
						Quote/Ref. NO.:	JOB NO.:	Unit NO.:	Drawing NO.:	Rev.:
						Q-13047 R.1	PC-516	B-13059	PID-B13059-A-02	2

2308-8th Street
Nisku, Alberta
T9E 7Z2

Office: 780.955.4292
Fax: 780.955.4294
Toll Free: 866.955.4292

2	AS BUILT	SDC	11-27-13		
1	REVISION TO ADD LEVEL CONTROL FLOAT CAGE	SDC	11-01-13	SDC	GDB
0	ISSUED FOR CONSTRUCTION	SDC	10-29-13	SDC	GDB
A	ISSUED FOR APPROVAL	SDC	10-09-13	SDC	GDB
REV.	DESCRIPTION	BY	DATE	CHKD	APPD

E:\Work\PC-516 B-13059 HDS362C w 10HP Tundra Oil & Gas co Asher Engineering AB\GA-B-813059 Rev 1 AB.dwg, 11/27/13 11:14:44 AM, scottcpc, Property of PC Compression Inc. Duplication or transmittal without written cons

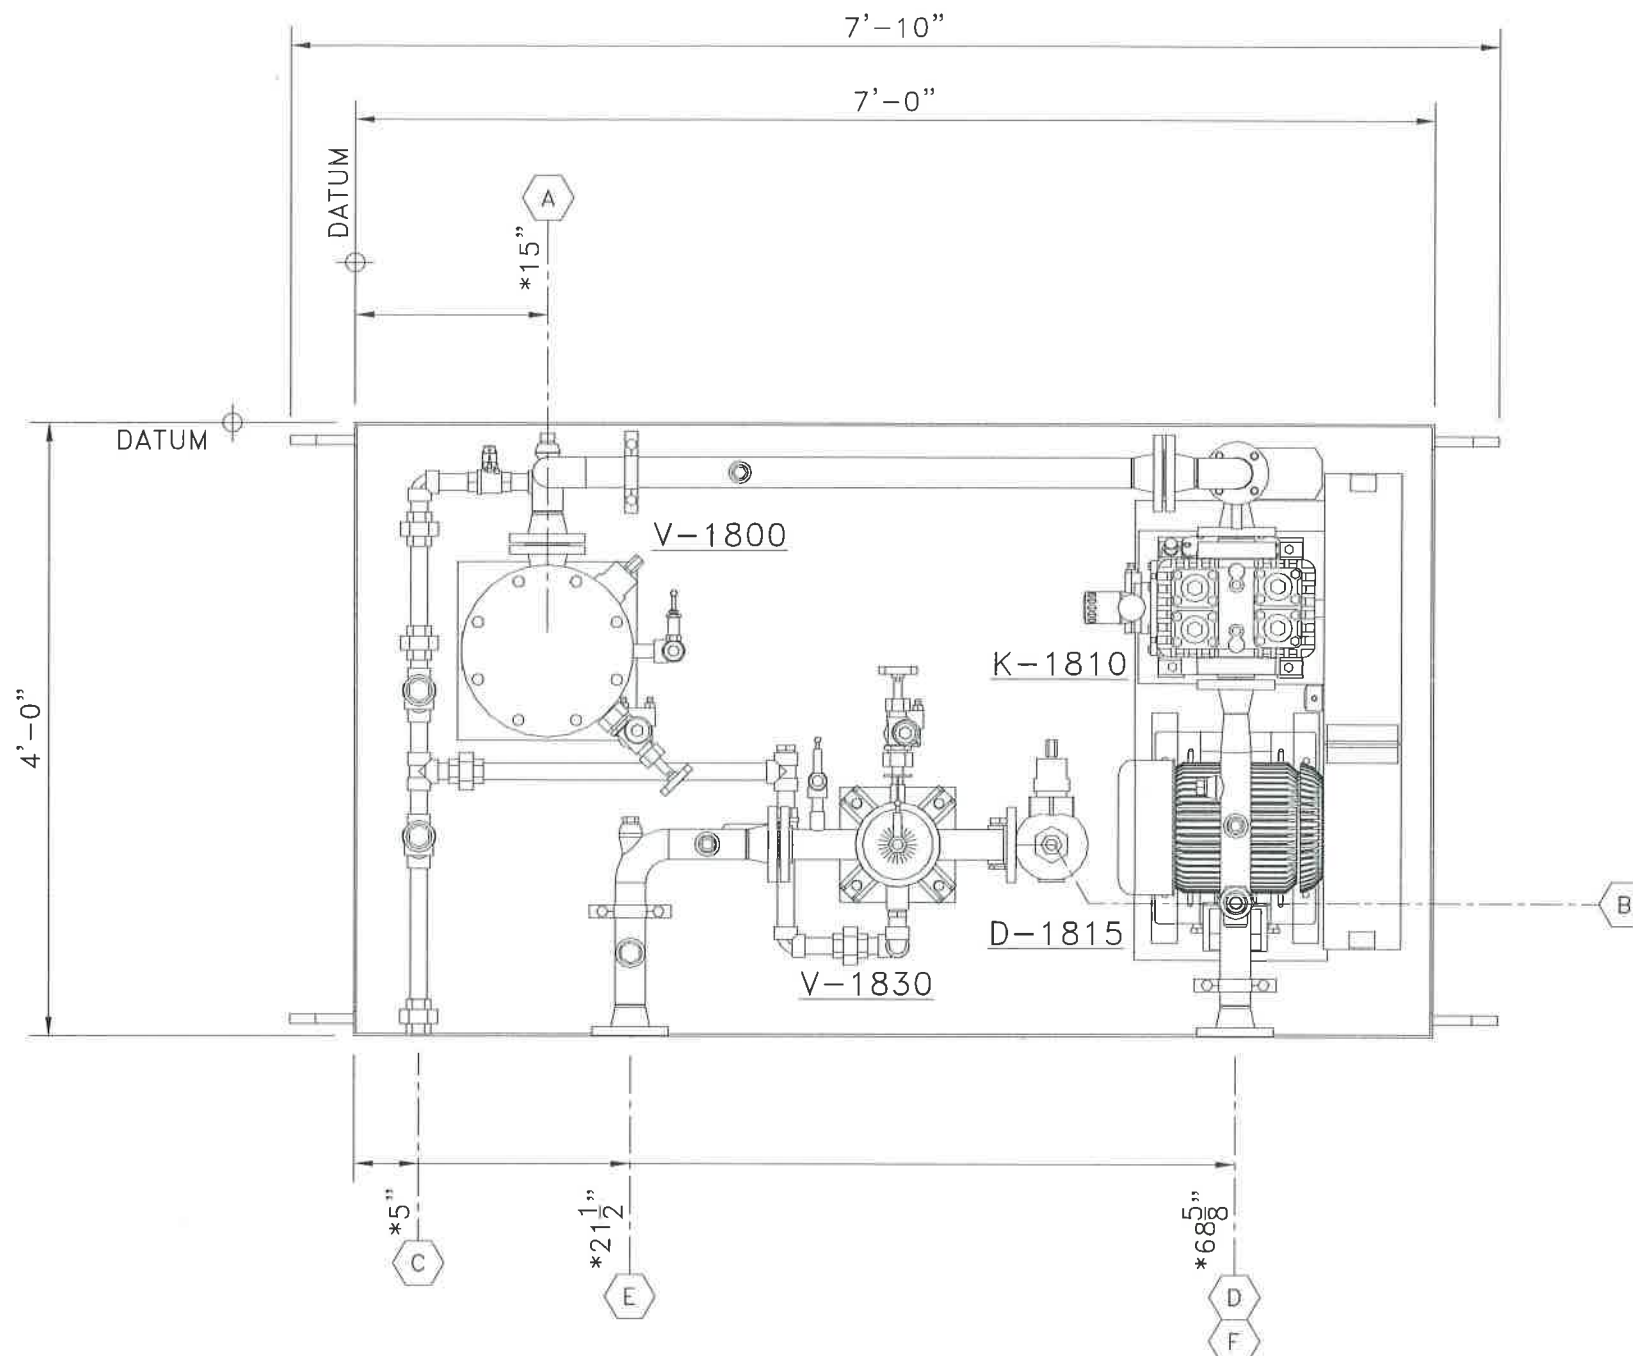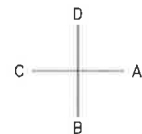

LAYOUT VIEW

SHIPPING INFO.

EST. DIM'S: 7'-10"Lx4'-0"Wx8'-0"H
EST. PKG. WEIGHT: 3,500 lbs

CUSTOMER CONNECTIONS

ITEM	DESCRIPTION	SIZE	*ELEVATION	*PROJ
A	GAS INLET	2" 150# RF	24 3/4" FTOS	FLUSH
B	GAS OUTLET	2" 150# RFWN	72 3/4" FTOS	FLUSH
C	LIQUID OUTLET	1" NPT	5 3/4" FTOS	FLUSH
D	COMP. TO COOLER	2" 150# RFWN	36 1/4" FTOS	FLUSH
E	COOLER TO V-1830	2" 150# RFWN	28 1/4" FTOS	FLUSH
F	PSV-1810 VENT	1" NPT	81 3/4" FTOS	N/A

CONNECTION NOTE:

— THESE CONNECTIONS (*) ARE PREASSEMBLY ONLY. THEY ARE TO BE USED FOR REFERENCE ONLY.

AS-BUILT DRAWING
NAME: *SAC*

NOV 27 2013

LSD: 13-14-08-29 W1M
AFE: 02013412FC
PO#: 1772R001



											Drawn by: S.D.C.		FUEL GAS COMPRESSOR PKG. BLACKMER HDS362C w/ 10HP ELECTRIC SKID MOUNTED, SOUR SERVICE				
											Date: 09-27-13						
											Checked by: 		Company: TUNDRA OIL & GAS LTD.				
											Approved by: 						
											Scale: 1:15		Quote/Ref. NO.: Q-13047 R.1				
													JOB NO.: PC-516				
													Unit NO.: B-13059				
													Drawing NO.: GA-R13059-B-01				
													Rev.: 1				

AS BUILT					SDC		11-27-13					
ISSUED FOR CONSTRUCTION					SDC		10-29-13		SDC		GDB	
ISSUED FOR APPROVAL					SDC		10-07-13		SDC		GDB	
DESCRIPTION					BY		DATE		CHKD		APPD	



2308-8th Street
Nisku Alberta
T9E 7Z2

Office: 780.955.4292
Fax: 780.955.4294
Toll Free: 866.955.4292

E:\Work\PC-516 B-13059 HDS362C w 10hpTundra Oil & Gas co Asher Engineering AB\GA-B-B13059 Rev 1 AB.dwg, 11/27/13 11:14:56 AM, scolltpe, Property of PC Compression Inc. Duplication or Transmittal without written cons

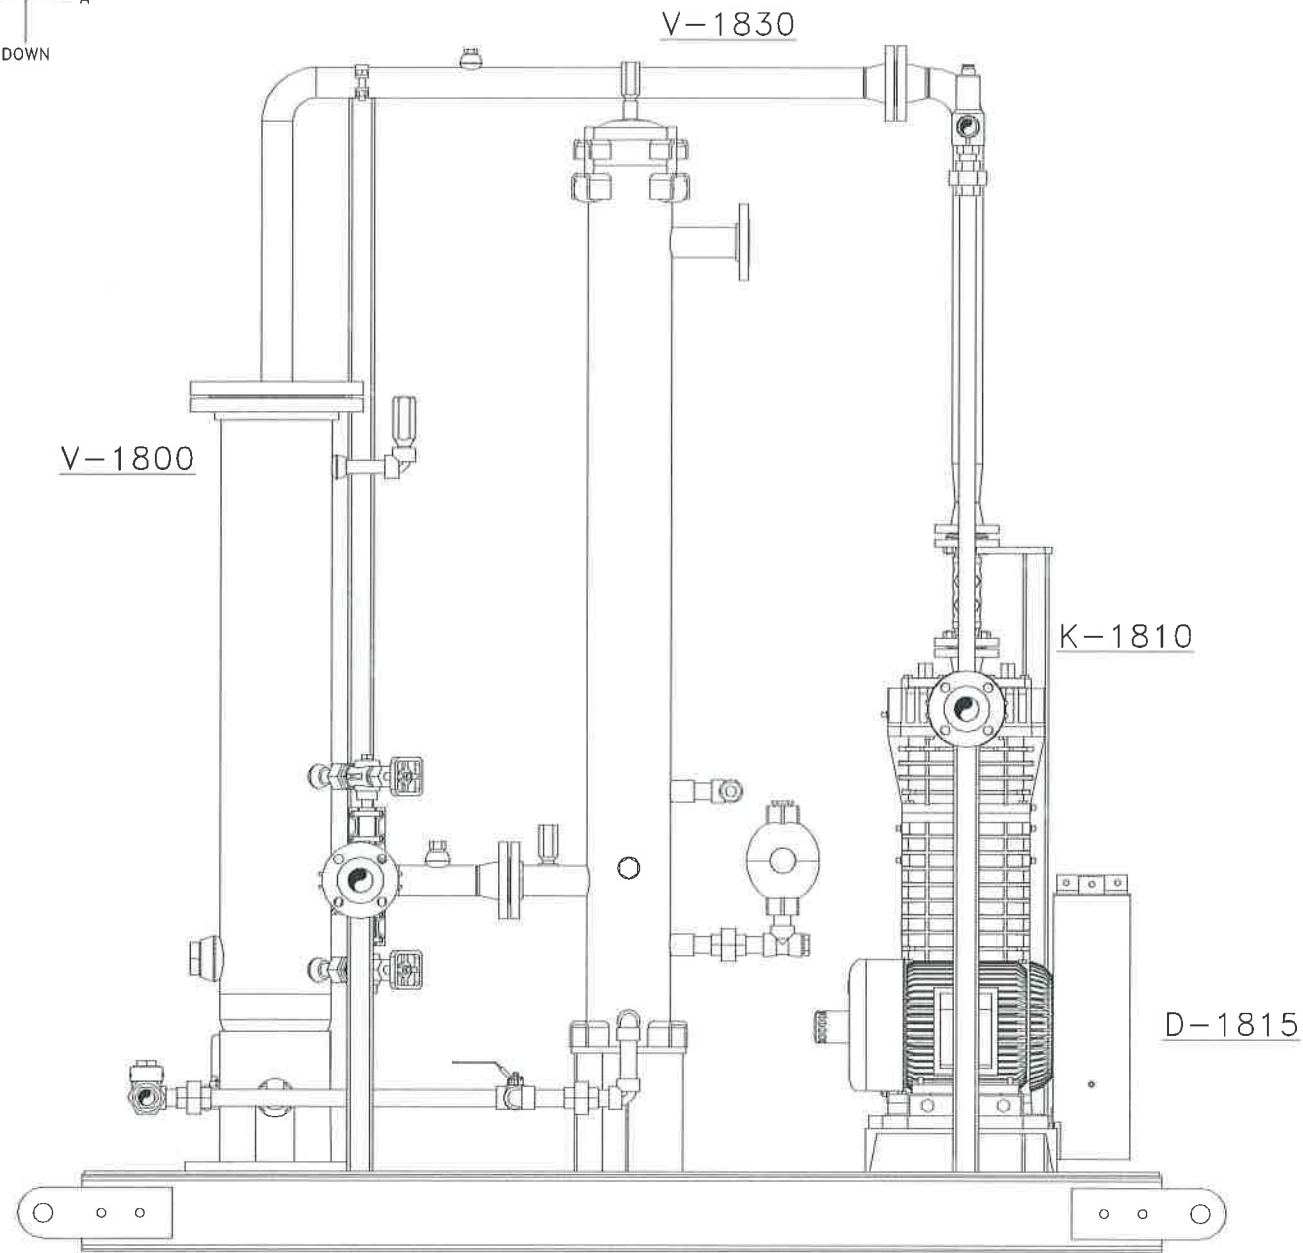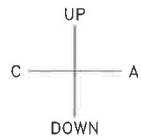

FRONT ELEVATION VIEW

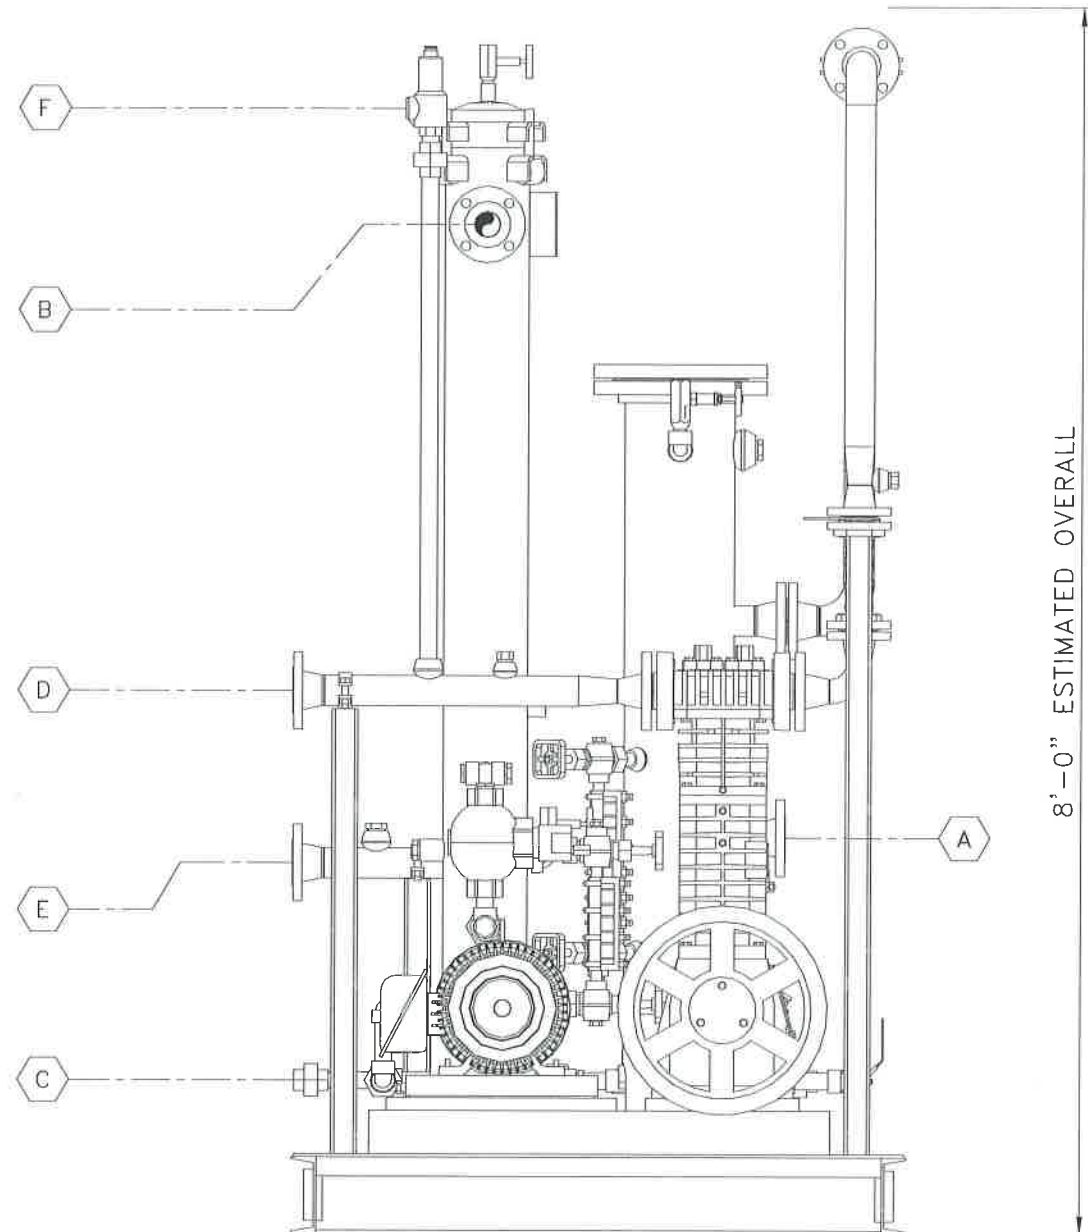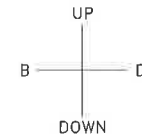

RIGHT SIDE ELEVATION VIEW

AS-BUILT DRAWING
NAME: *SDC*



NOV 27 2013

LSD: 13-14-08-29 W1M
AFE: 02013412FC
PO#: 1772R001



						Drawn by: S.D.C.		FUEL GAS COMPRESSOR PKG BLACKMER HDS362C w/ 10HP ELECTRIC SKID MOUNTED, SOUR SERVICE			
						Date: 09-27-13					
						Checked by: <i>SDC</i>					
						Approved by: <i>GDB</i>		Company: TUNDRA OIL & GAS LTD.			
				2306-8th Street Nisku, Alberta T9E 7Z2		Office: 780.955.4292 Fax: 780.955.4294 Toll Free: 866.955.4292		Quote/Ref. NO.:	JOB NO.:	Unit NO.:	Drawing NO.:
								Q-13047 R.1	PC-516	B-13059	GA-B13059-B-02
								Scale: 1:15			Rev.:
											1

REV.	DESCRIPTION	BY	DATE	CHKD	APPR
1	AS BUILT	SDC	11-27-13		
0	ISSUED FOR CONSTRUCTION	SDC	10-29-13	SDC	GDB
A	ISSUED FOR APPROVAL	SDC	10-07-13	SDC	GDB

E:\Work\PC-516 B-13059 HDS362C w 10hpTundra Oil & Gas co Aster Engineering AB\GA-B-813059 Rev 1 AB.dwg, 11/27/13 11:15:02 AM, scottape, Property of PC Compression Inc. Duplication or transmittal without written cons

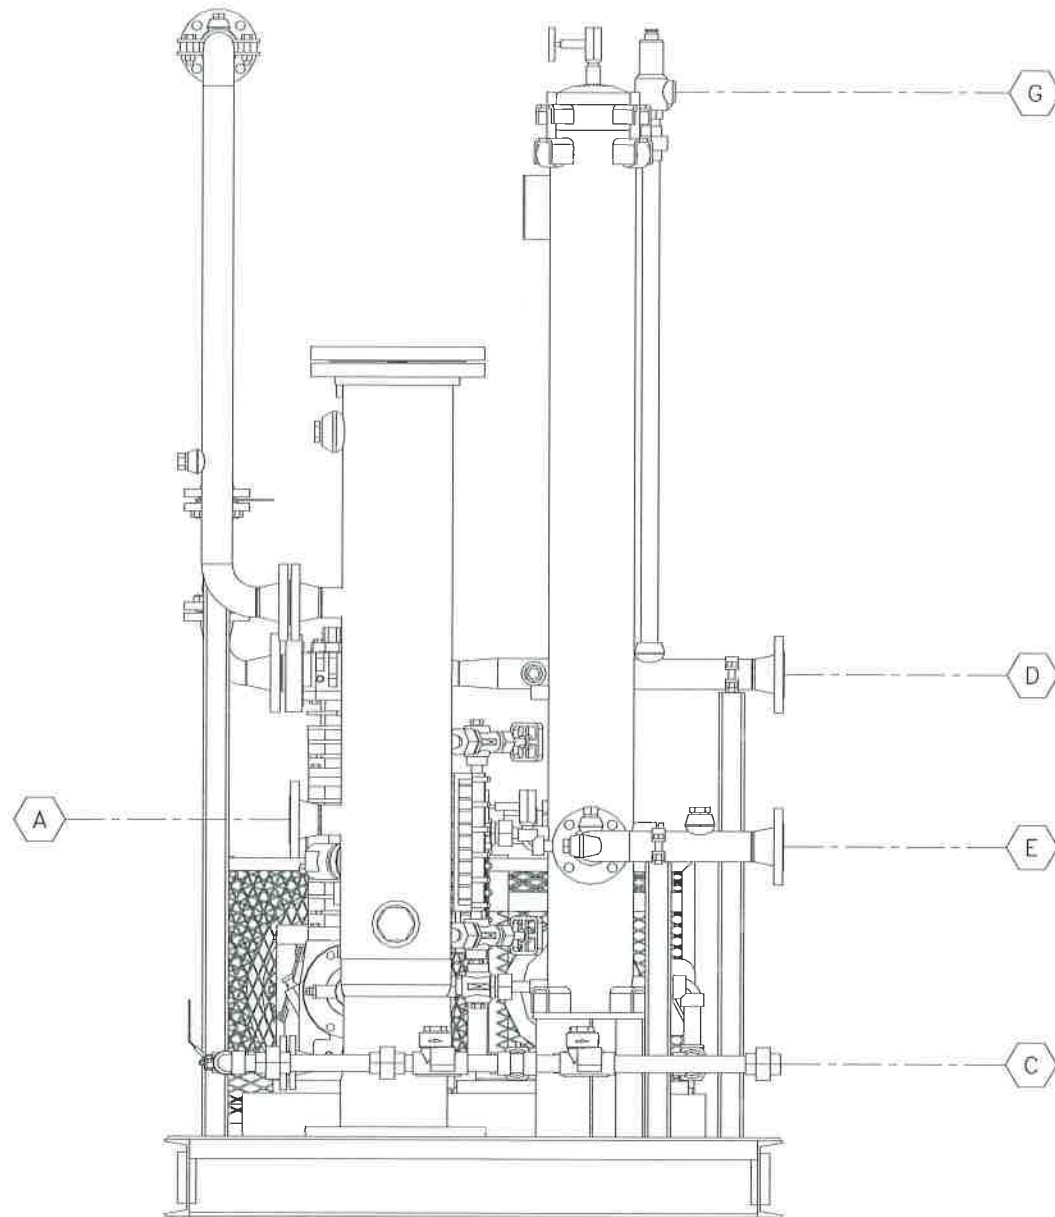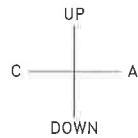

LEFT SIDE ELEVATION VIEW

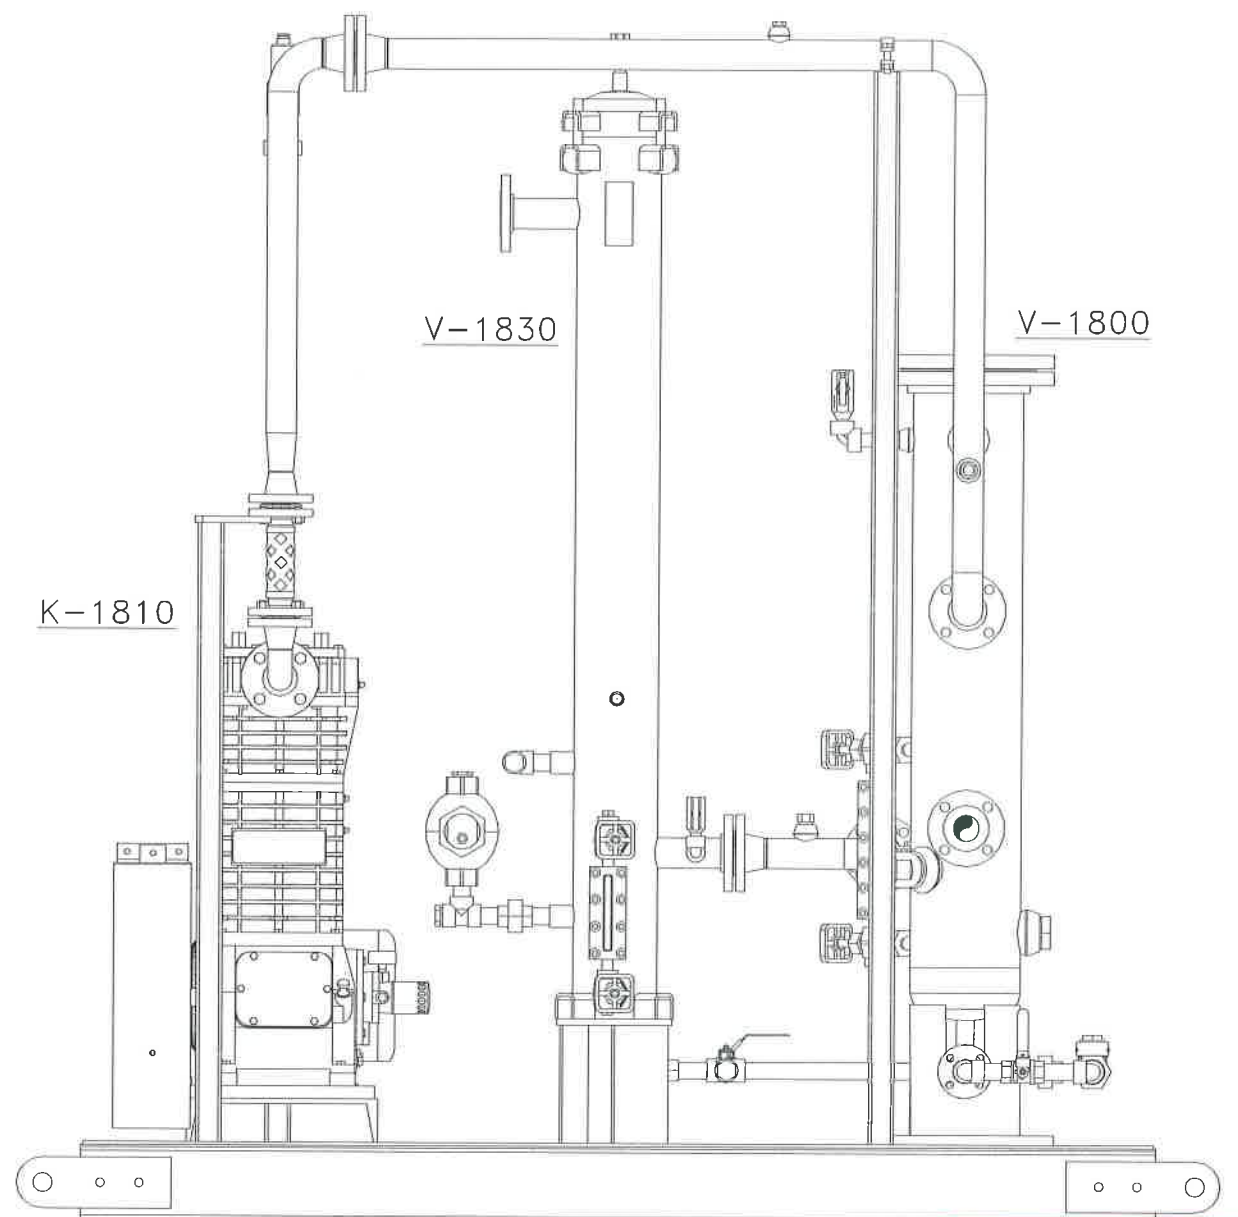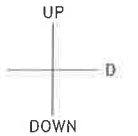

BACK ELEVATION VIEW

AS-BUILT DRAWING
NAME: *SDC*

NOV 27 2013





LSD: 13-14-08-29 W1M
AFE: 02013412FC
PO#: 1772R001

--	--	
2308-8th Street
Nisku Alberta
T9E 7Z2

Office: 780.955.4292
Fax: 780.955.4294
Toll Free: 866.955.4292

E:\Work\PC-516 B-13059 HDS362C w 10HP Tundra Oil & Gas co Aster Engineering AB\GA-B-813059 Rev 1 AB.dwg, 11/27/13 11:15:11 AM, scottape, Property of PC Compression Inc. Duplication or transmittal without written cons

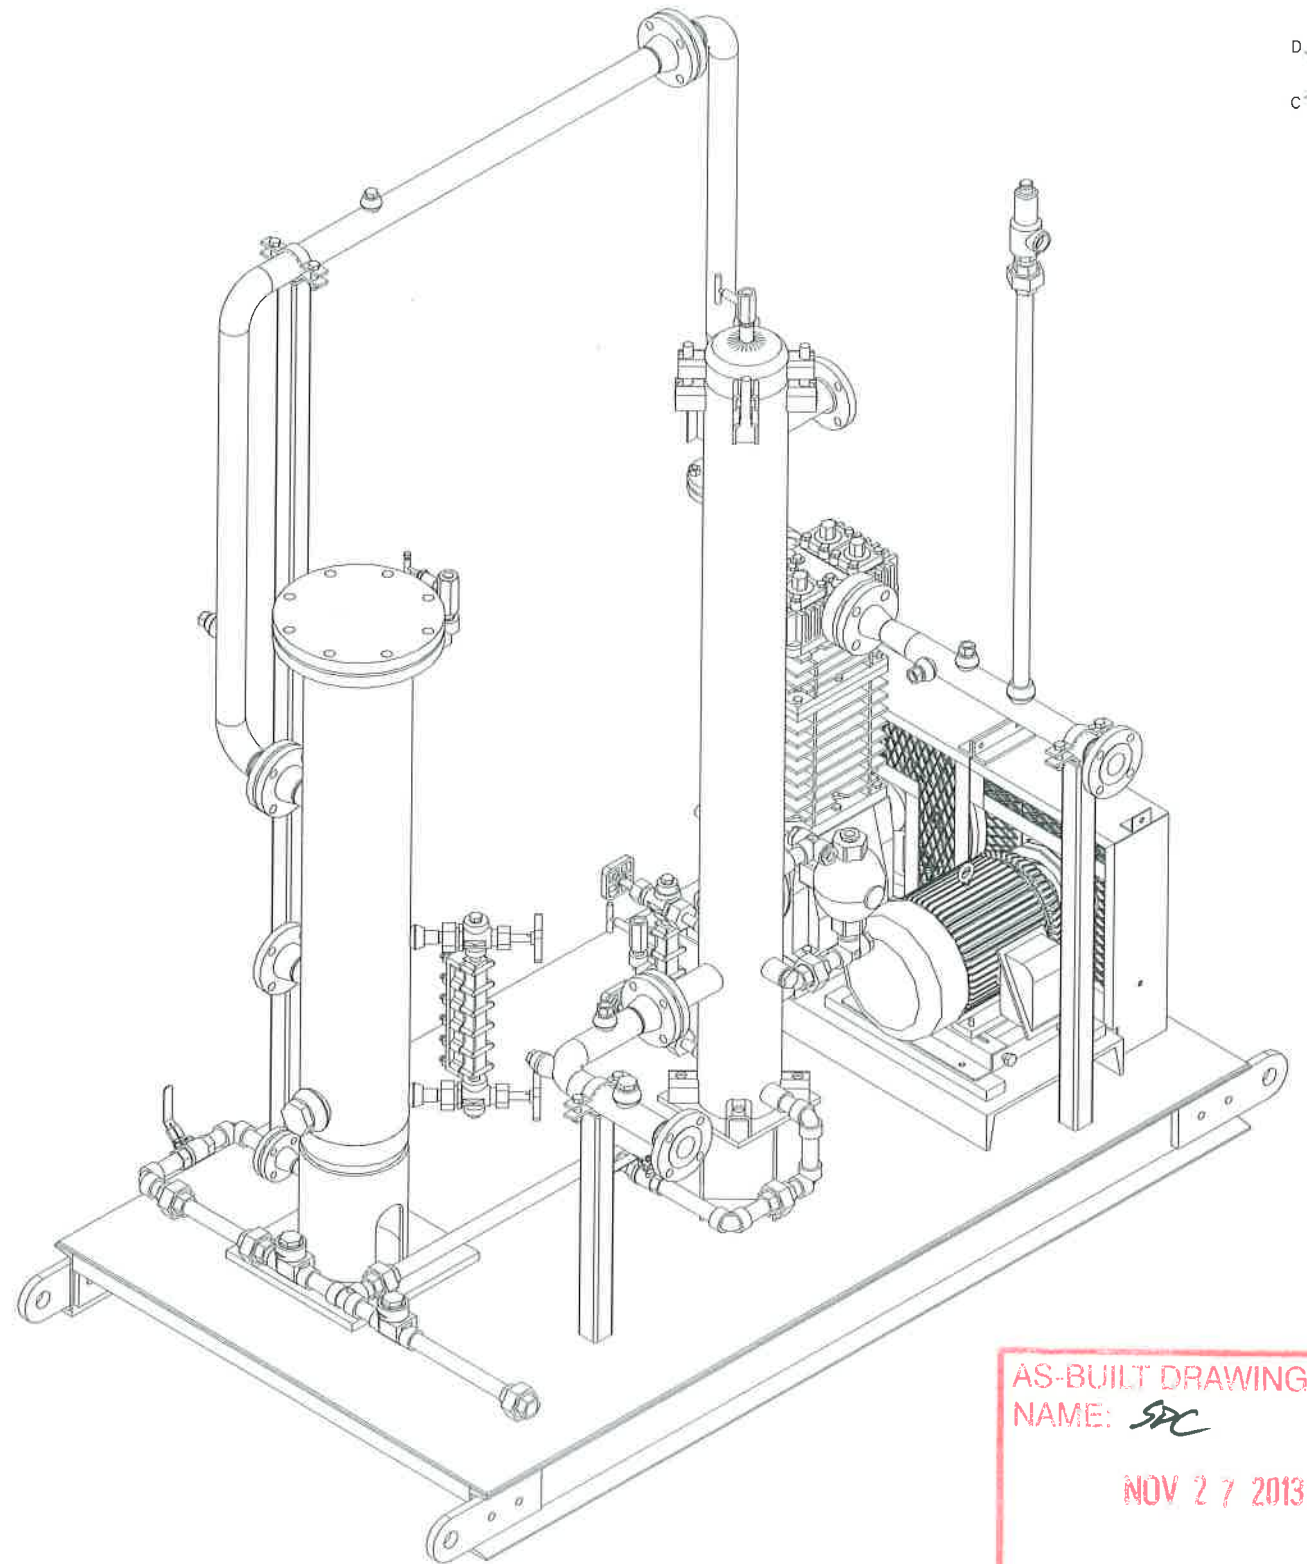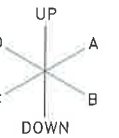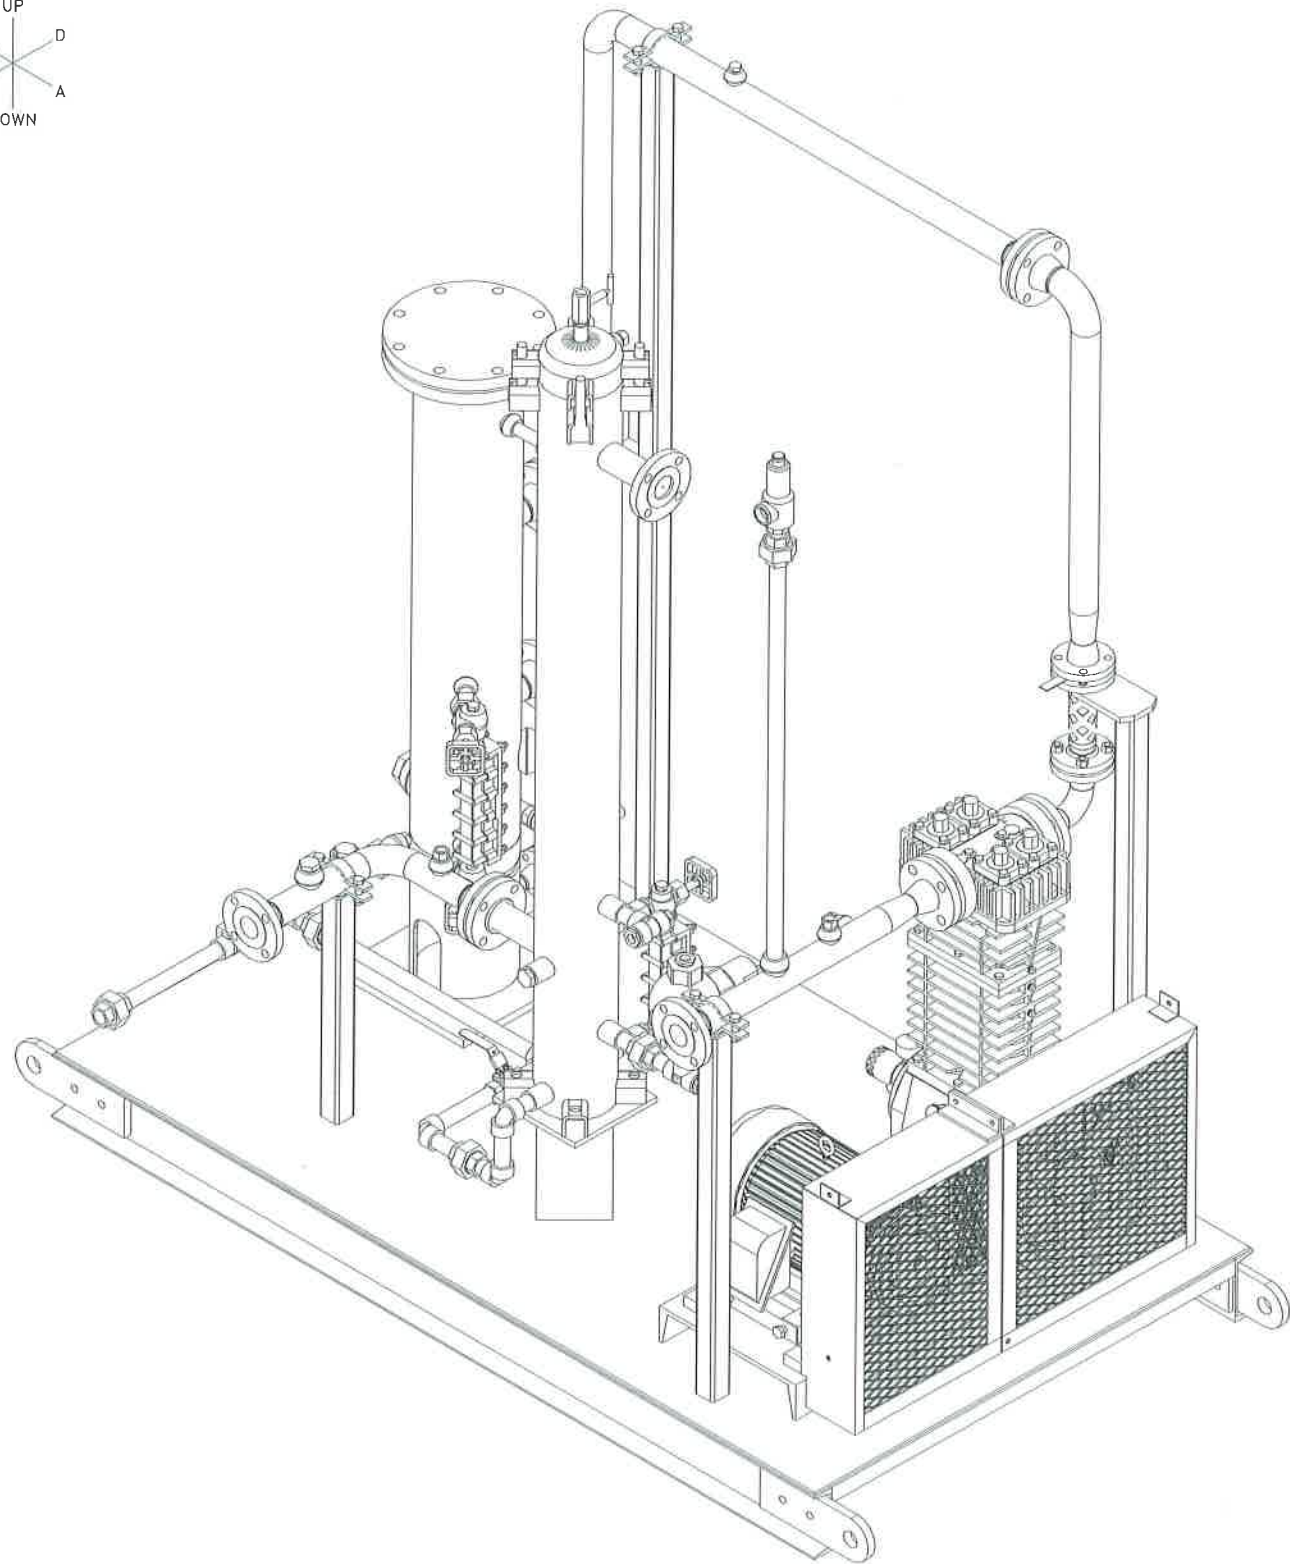
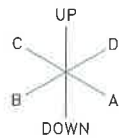


AS-BUILT DRAWING
NAME: *SJC*
NOV 27 2013

LSD: 13-14-08-29 W1M
AFE: 02013412FC
PO#: 1772R001

								Drawn by: S.D.C.		FUEL GAS COMPRESSOR PKG. BLACKMER HDS362C w/ 10HP ELECTRIC SKID MOUNTED, SOUR SERVICE													
				2308-8th Street Nisku Alberta T9E 7Z2				Date: 09-27-13 Checked by:  Approved by: 						Company: TUNDRA OIL & GAS LTD.									
1	AS BUILT	SDC	11-27-13					Office: 780.955.4292	Scale: 1:15				Quote/Ref. NO.: Q-13047 R.1		JOB NO.: PC-516		Unit NO.: B-13059		Drawing NO.: GA-B13059-B-04		Rev.: 1		
0	ISSUED FOR CONSTRUCTION	SDC	10-29-13	SDC	GDB			Fax: 780.955.4294					Toll Free: 866.955.4292										
A	ISSUED FOR APPROVAL	SDC	10-07-13	SDC	GDB																		
REV.	DESCRIPTION	BY	DATE	CHKD	APPD																		




E:\Work\PC-516 B-13059 HDS362C w 10HP Tundra Oil & Gas co Asher Engineering AB\GA-B-813059 Rev 1 AB.dwg, 11/27/13 10:53:40 AM, scallops, Property of PC Compression Inc. Duplication or transmittal without written cons

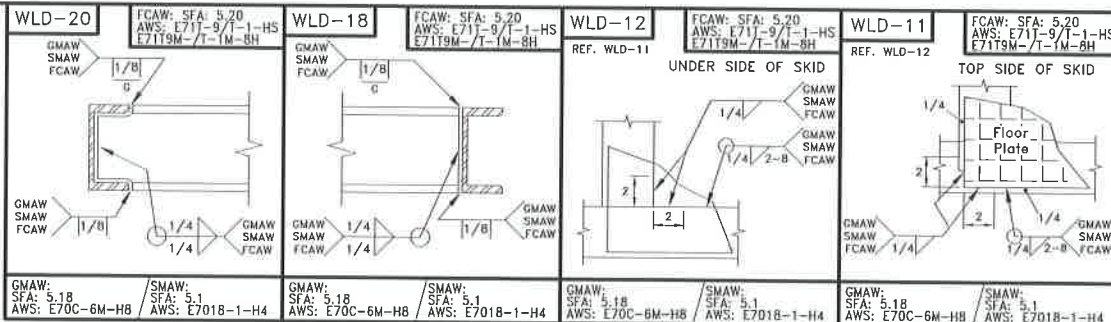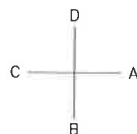

BILL of MATERIAL

MARK	Q'TY	DESCRIPTION	MATERIAL	WEIGHT
1	4	W6x15 x 3'-8" LG	A36/44W	220 lbs
2	2	C6x8.2 x 7'-0" LG	A36/44W	115 lbs
3	1	C6x8.2 x 3'-8" LG	A36/44W	30 lbs
4	2	C6x8.2 x 1'-0 1/2" LG C.O.E.	A36/44W	17 lbs
5	2	L1 1/2"x1 1/2"x1/4" x 3'-8" LG	A36/44W	17 lbs
6	4	FB 1/2"x4 x 8" LG	A36/44W	23 lbs
7	4	LIFT LUG LL-412-0.75	A36/44W	34 lbs
8	1	1/4" CHECKPLATE SEE DWG. D-02	SA-36	315 lbs
9	1	V-1800 BASE PLATE SEE DWG. D-02	A36/44W	57 lbs
10	1	V-1830 BASE STAND SEE DWG. D-02	A36/44W	24 lbs
11	1	MOTOR / COMP. FOUNDATION CHANNEL SEE DWG. D-02	SA-36	102 lbs
12	1	COMPRESSOR MOUNT PAD SEE DWG. D-02	A36/44W	61 lbs
13	1	MOTOR MOUNT PAD SEE DWG. D-02	A36/44W	35 lbs
TOTAL				1,050 lbs

WELDERS NOTE:
- 1/8" HAS BEEN TAKEN OFF OF CUT LENGTHS FOR WELD GAP PURPOSES
- ITEMS# 7 ARE BOLTED ON WITH 5/8" UNC(11TPI) x 2 1/2" LG GR. 8 BOLT, NUT AND LOCK WASHER.
- SEE DWG. SKD-B13059-D-02 FOR DETAILS.

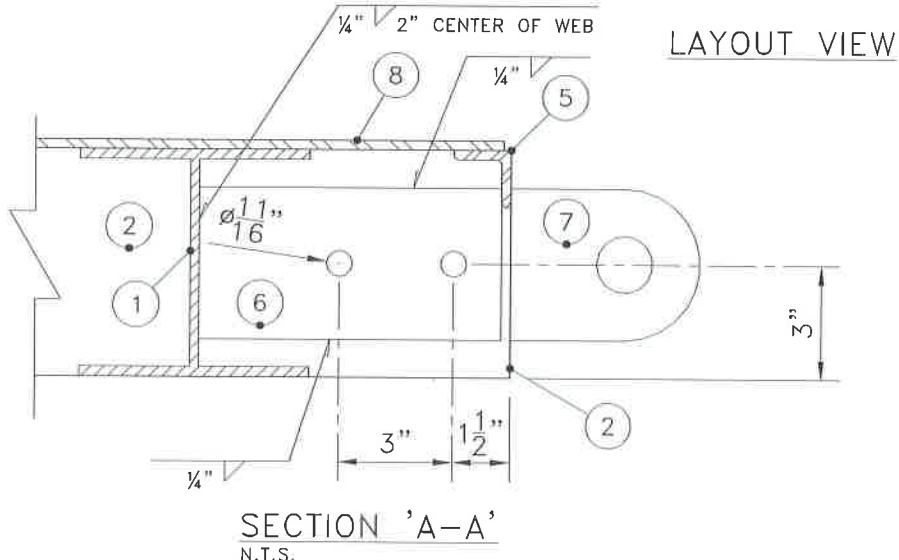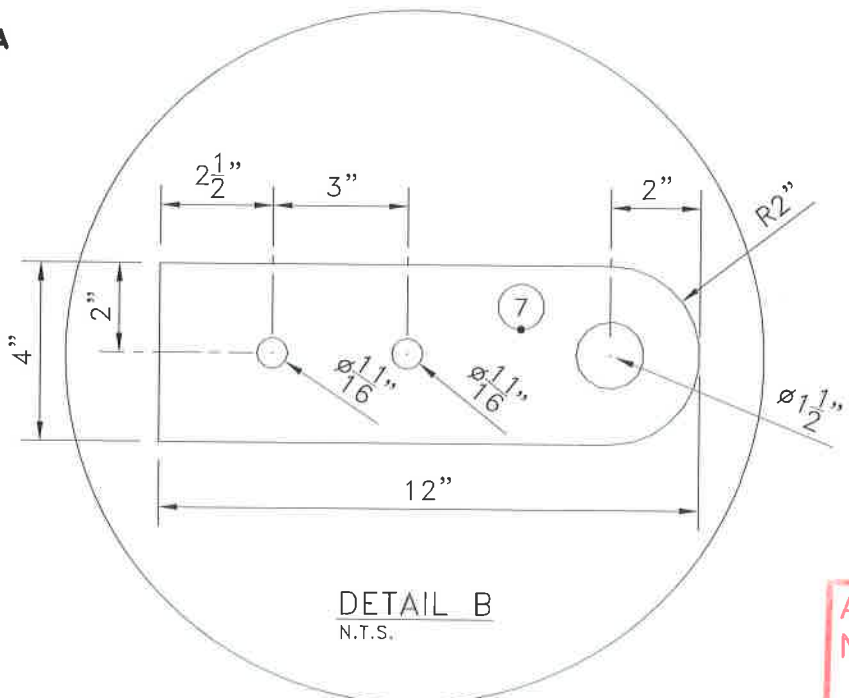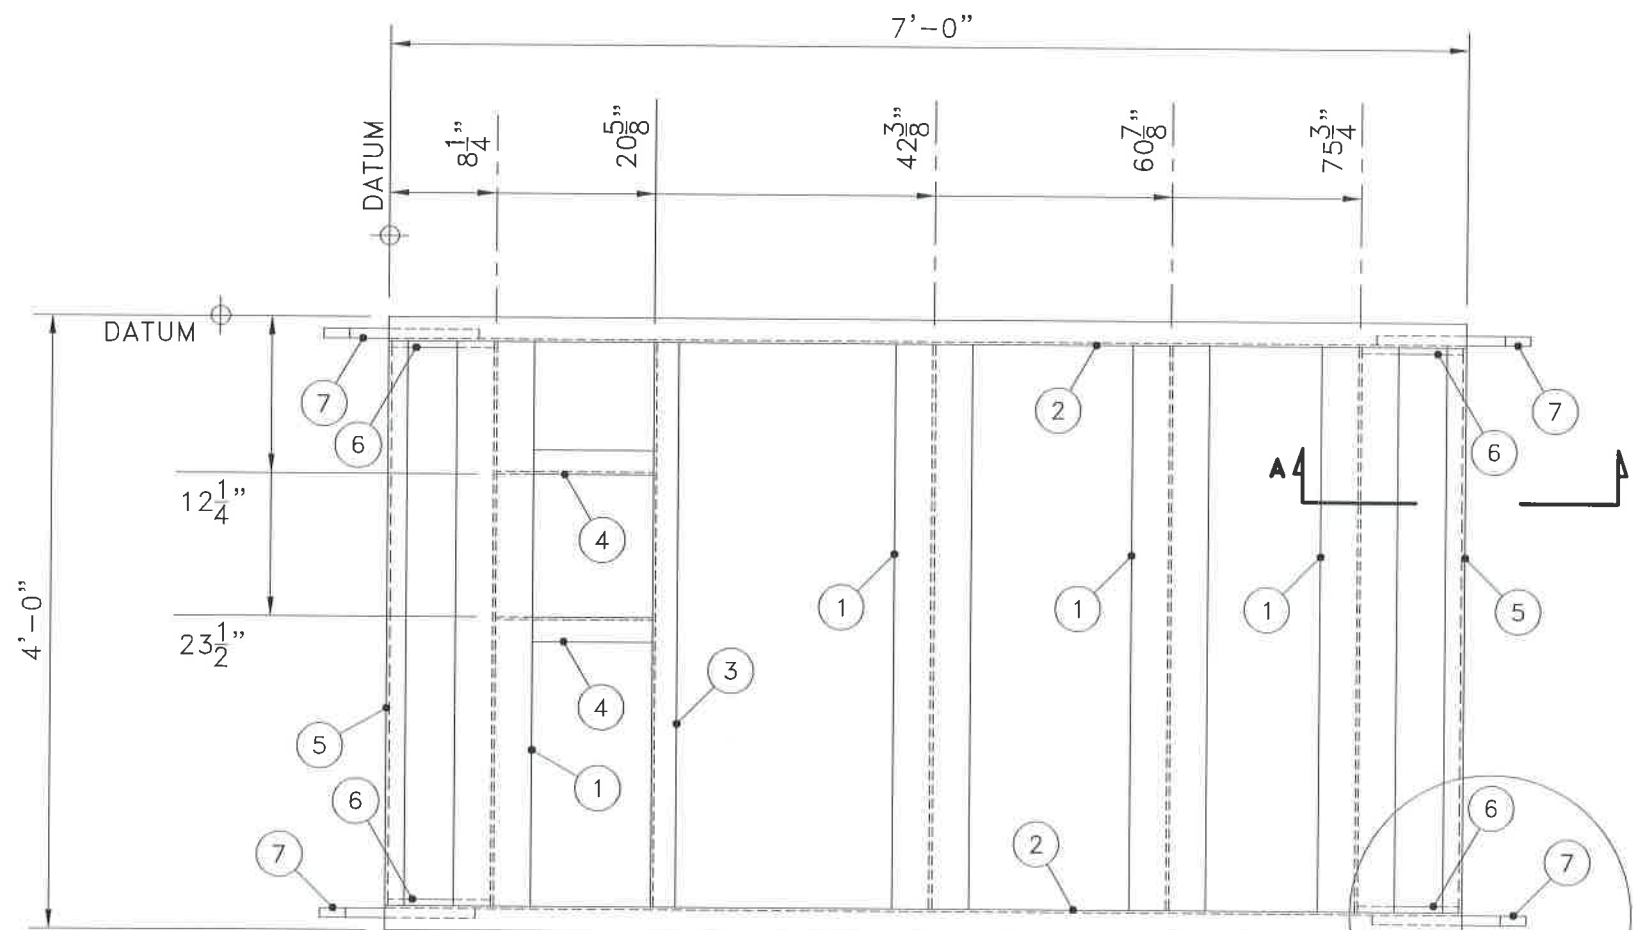

AS-BUILT DRAWING
NAME: *SDC*
NOV 27 2013

LSD: 13-14-08-29 W1M
AFE: 02013412FC
PO#: 1772R001


AS BUILT		SDC 11-27-13				Drawn by: S.D.C.		FUEL GAS COMPRESSOR PKG. BLACKMER HDS362C w/ 10HP ELECTRIC SKID MOUNTED, SOUR SERVICE					
ISSUED FOR CONSTRUCTION		SDC 10-29-13 SDC GDB				Date: 09-27-13							
ISSUED FOR APPROVAL		SDC 10-07-13 SDC GDB				Checked by: <i>SDC</i>							
REV.		DESCRIPTION		BY	DATE	CHKD	APPD	Scale: 1:15	Quote/Ref. NO.: Q-13047 R.1	JOB NO.: PC-516	Unit NO.: B-13059	Drawing NO.: SKD-B13059-D-01	Rev.: 1

2308-8th Street
Nisku Alberta
T9E 7Z2


Office: 780.955.4292
Fax: 780.955.4294
Toll Free: 866.955.4292

Company: TUNDRA OIL & GAS LTD.

E:\Work\PC-516 B-13059 HDS362C w 10HP Tundra Oil & Gas co Asher Engineering AB\GA-B-B13059 Rev 1 AB.dwg, 11/27/13 10:54:12 AM, scottcpc, Property of PC Compression Inc. Duplication or transmittal without written cons

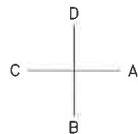


WLD-46

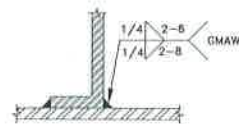


SFA: 5.18
AWS: E70C-6M-H8

WLD-5

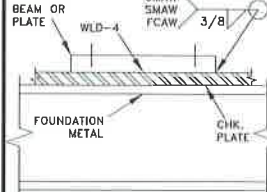

GMAW: SFA: 5.18
AWS: E70C-6M-H8

WLD-4

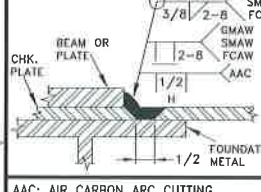

AAC: AIR CARBON ARC CUTTING



GMAW: SFA: 5.18
AWS: E70C-6M-H8

BILL of MATERIAL

MARK	Q'TY	DESCRIPTION	MATERIAL	WEIGHT
8	1	1/4" CHECKPLATE (6'-11 1/8"x3'-11 1/8"=28sqft)	SA-36	315 lbs
9	1	1" H.R. PLATE: 1'-2"x1'-2"=1.4sqft	A36/44W	57 lbs
10a	1	W6x15 x 0'-9 1/4" LG	A36/44W	12 lbs
10b	1	FB 1/2x10 CUT TO 0'-9"x0'-9"=0.6sqft	A36/44W	12 lbs
TOTAL ITEM# 10				24 lbs
11	1	C15x33.9 x 3'-0" LG	A36/44W	102 lbs
12a	1	FB1x12 x 1'-2 1/2" LG	A36/44W	49 lbs
12b	2	FB1x2 x 0'-11" LG	A36/44W	12 lbs
TOTAL ITEM# 12				61 lbs
13a	2	FB1x2 x 1'-6" LG	A36/44W	20 lbs
13b	1	215T MOTOR SLIDE BASE	C.S.	15 lbs
TOTAL ITEM# 13				35 lbs

WELDERS NOTE:

- 1/8" HAS BEEN TAKEN OFF OF CUT LENGTHS FOR WELD GAP PURPOSES
- WELD ITEM# 9 DIRECTLY TO CHANNEL SKID MEMBERS. THEN CUT OUT CHECKER PLATE ITEM# 8 TO FIT.
- WELD ITEMS# 10 AND 11 TO SKID USING WELD DETAILS WLD-4 AND WLD-5.
- WELD ITEMS # 12b, 13a AND 13b AT TIME OF PIPING ASSEMBLY.

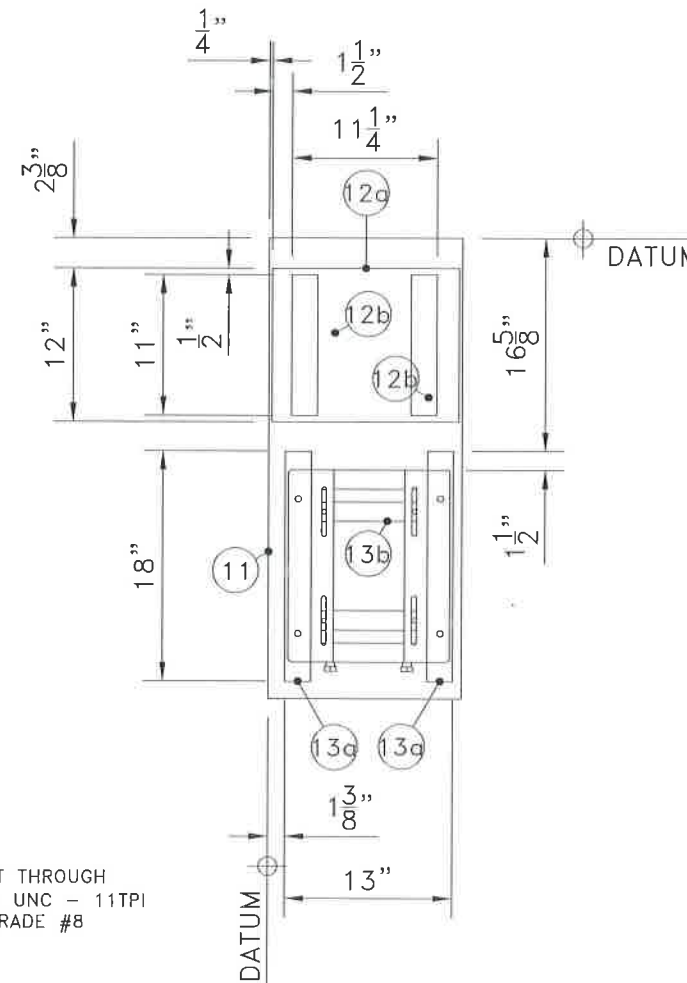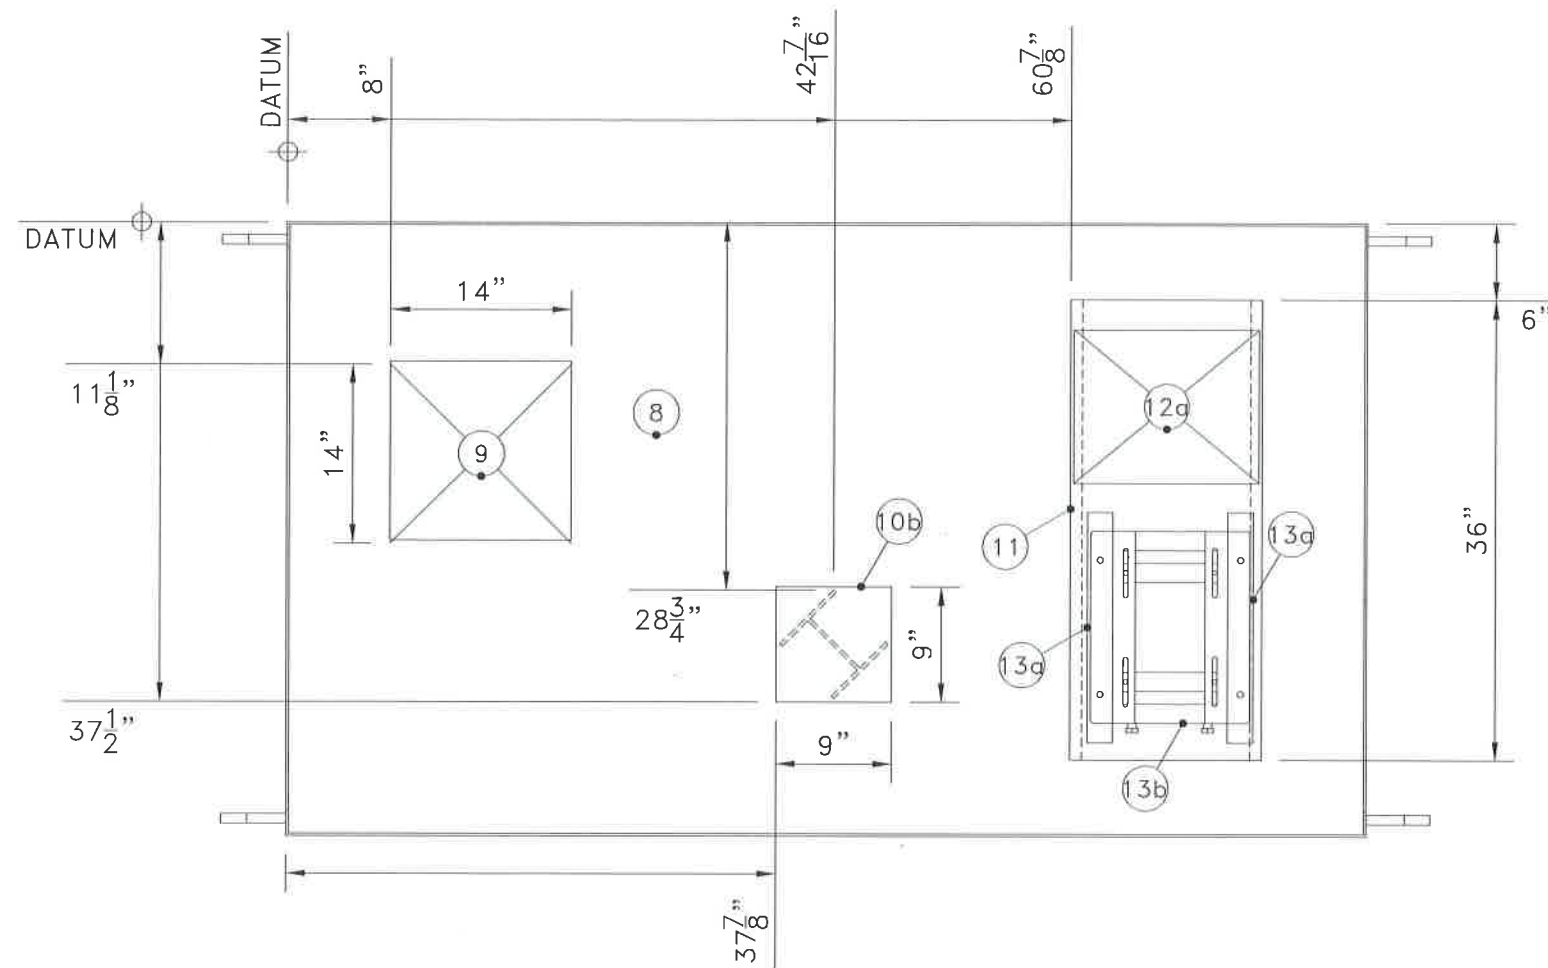

BOLT THROUGH
5/8" Ø UNC - 11TPI
GRADE #8

COMPRESSOR /
MOTOR SUB BASE
DETAIL

SIDE ELEVATION VIEW

AS-BUILT DRAWING
NAME: *SDC*

NOV 27 2013

LSD: 13-14-08-29 W1M
AFE: 02013412FC
PO#: 1772R001

REV.	DESCRIPTION	BY	DATE	CHKD	APPD
1	AS BUILT	SDC	11-27-13		
0	ISSUED FOR CONSTRUCTION	SDC	10-29-13	SDC	GDB
A	ISSUED FOR APPROVAL	SDC	10-07-13	SDC	GDB



2308-8th Street
Nisku Alberta
T9E 7Z2
Office: 780.955.4292
Fax: 780.955.4294
Toll Free: 866.955.4292

Drawn by:
S.D.C.
Date:
09-27-13
Checked by:
SDC
Approved by:
SDC
Scale:
1:15

FUEL GAS COMPRESSOR PKG.
BLACKMER HDS362C w/ 10HP ELECTRIC
SKID MOUNTED, SOUR SERVICE

Company:	TUNDRA OIL & GAS LTD.			
Quote/Ref. NO.:	JOB NO.:	Unit NO.:	Drawing NO.:	Rev.:
Q-13047 R.1	PC-516	B-13059	SKD-B13059-D-02	1