




FILE PATH: MAINDATA\CAD\ TANKS\A600-A699\A648-3

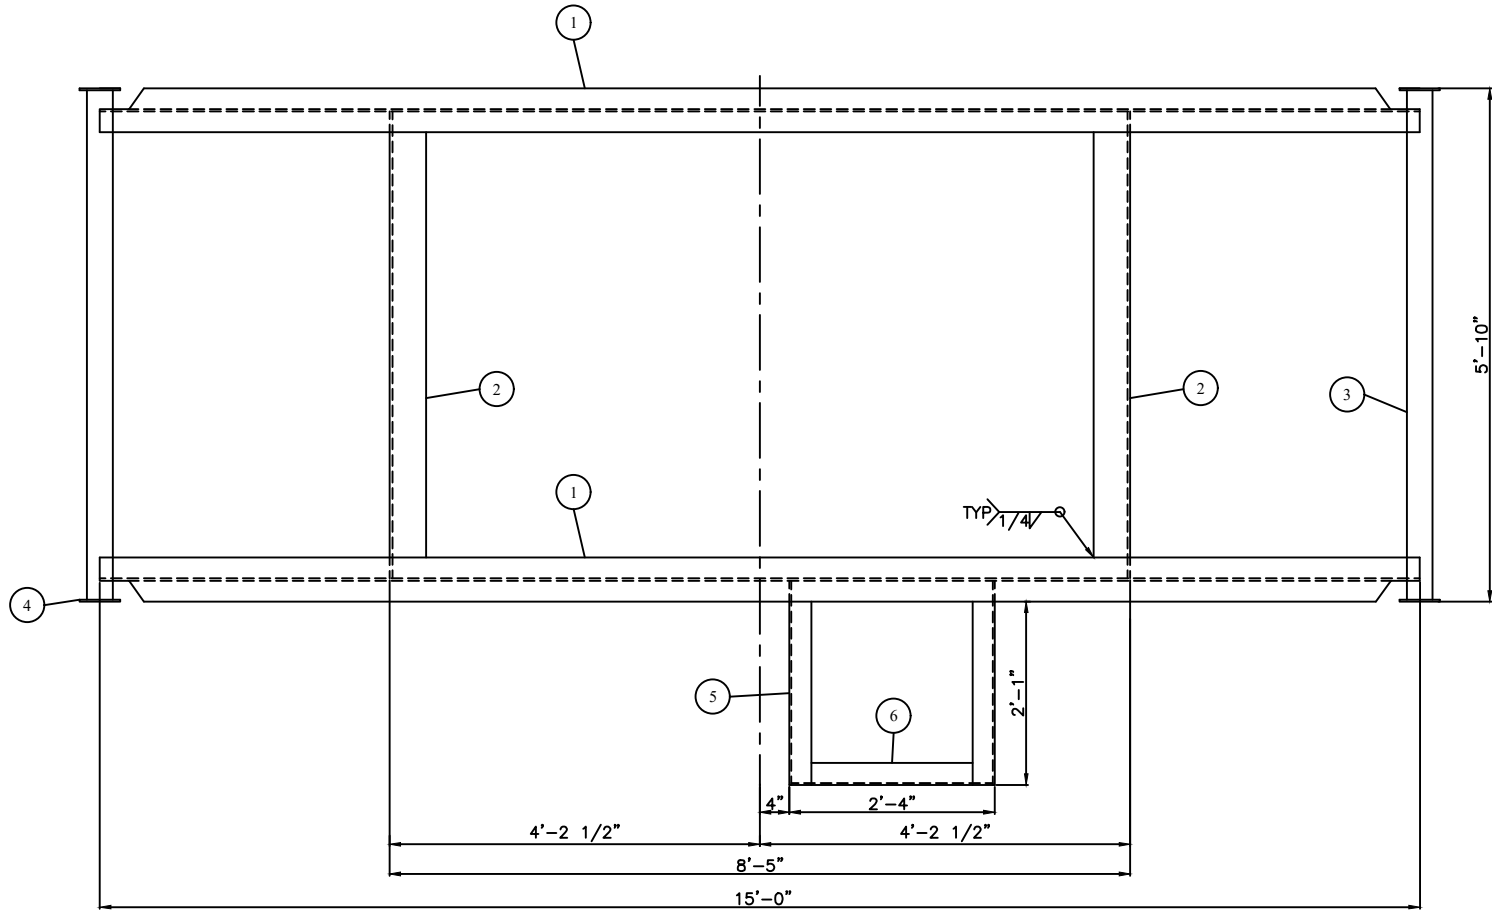

TOP VIEW

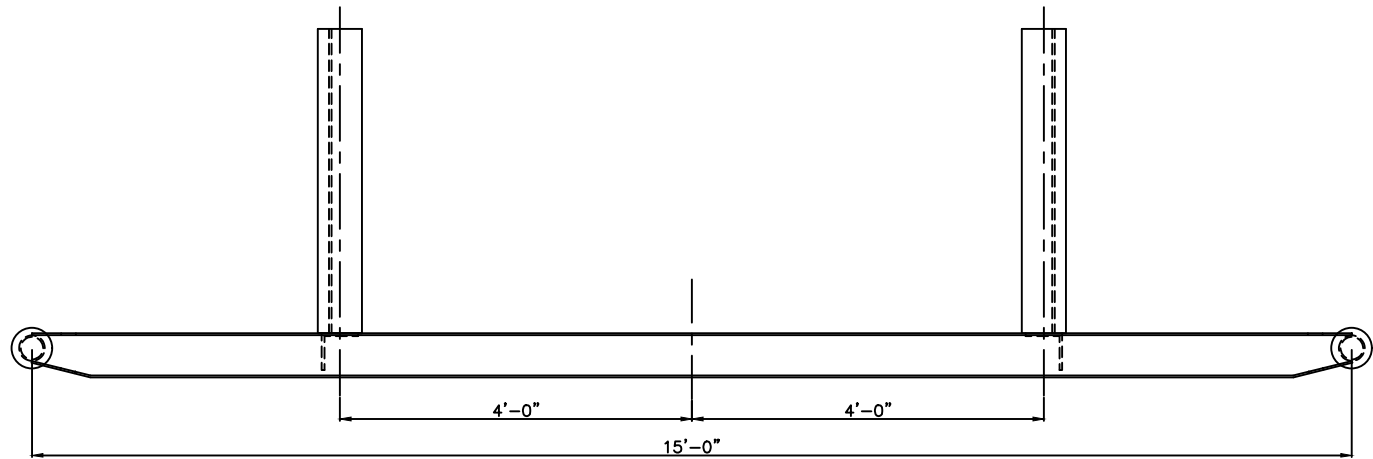

ELEVATION VIEW

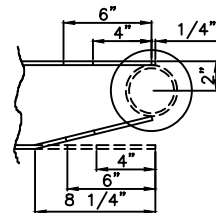

COPE DETAIL

BILL OF MATERIALS

ITEM	REQ'D	PART	DESCRIPTION	MATERIAL	WEIGHT
1	2	RUNNER	WF6@15# x 15'-0" LG (ROUGH CUT TO 180 1/2")	WF6@15#	485#
2	2	CROSSMEM	5" x 5" x 3/8" ANGLE x 5'-3 11/16" LG	SA-36	133#
3	2	PULL	3" STD PIPE x 5'-9 1/2" LG	SA-106-B	90#
4	4	PULLCAP	1/4" THK x 5 1/2" OD	SA-36	5#
5	2	SUPPORT	3" x 3" x 1/4" ANGLE x 2'-3 3/4" LG	SA-36	8#
6	1	SUPPORT	3" x 3" x 1/4" ANGLE x 2'-3 1/2" LG	SA-36	4#

GENERAL NOTES

1. PAINT: ONE (1) COAT INDUSTRIAL ENAMEL
2. ALL WELDING SHALL BE AS PER CSA W47.1-92 USING GAS METAL ARC WELDING WITH ER480S-6 FILLER METAL OR SUBMERGED METAL ARC WELDING WITH E48018-1 FILLER METAL
3. APPROXIMATE WEIGHT: 800 LBS

REV. NO.	DATE	REVISION	BY	APP'D
A	02/28/03	ISSUED FOR APPROVAL	DSG	
B	03/07/03	REVISED AS PER CLIENT REQUEST	DSG	
0	03/11/03	ISSUED FOR FABRICATION	DSG	
1	04/03/03	AS BUILT DRAWING	JMB	

BILTON

Welding & Manufacturing Ltd.

This drawing is property of BILTON WELDING & MANUFACTURING LTD. and is lent to the recipient for their confidential use only. In consideration of the loan of this drawing, the recipient promises and agrees that it shall not be used in any way detrimental to the interests of BILTON WELDING & MANUFACTURING LTD., that it shall be returned upon request, and that it shall not be reproduced, copied, lent, or otherwise disposed of, directly or indirectly, without the written consent of BILTON WELDING & MANUFACTURING LTD.

BOX 6106 3704 58 AVE. INNISFAIL, AB T0A 1G0 CANADA 403-227-7799 1-888-227-4923 FAX 227-7796				CONOCOPHILLIPS CANADA			
60 BBL SINGLE WALL ABOVE GROUND INCINERATOR TANK TAG: V-0701				SKID DETAILS			
DATE: 02/28/03		SHEET: 3 OF 3		JOB NO.:		SIZE	
SCALE: N.T.S.		DRAWN BY: DSG		A648		D	
PURCHASE ORDER: JH1-4932		LOCATION: 12-29-36-06 W5M		DRAWING NO.:		REV.	
APP'D BY:		CRN: N/A		A648-3		1	