

GENERAL NOTES


- QUALITY CONTROL PROGRAM NUMBER: AQP-1317(S)
- WELDING PROCEDURE REGISTRATION NUMBER: WP1970.2
- STEAM COIL DESIGNED TO ASME SECTION VIII, DIV. 1
DESIGN PRESSURE: 225 PSI @ 250°F/32°F
CORROSION: EXT: NIL
HYDROTEST: 338 PSI
IMPACTS EXEMPT PER UG-20(f)(1-5)
RADIOGRAPHY: 100% PER UW-11(a)
- SHELL AND HEAD MATERIAL: SA-516-70N
- FLANGE MATERIAL: SA-105-N
- PIPE MATERIAL: SA-106-B
- PLATE MATERIAL: SA-516-70N/SA-36
- BOLTING MATERIAL: SA-193-B7M/SA-194-2HM
- INTERNAL SANDBLAST: SSPC-SP10 (NEAR WHITE)
- INTERNAL COATING:
DEVCO 253 AS PER MANUFACTURER'S SPECIFICATION
DEVCO 111 AS PER MANUFACTURER'S SPEC'S (LOWER 1/3 OF VESSEL)
- EXTERNAL SANDBLAST: SSPC-SP3 (POWER TOOL)
- EXTERNAL COATING:
ALL AREAS: ONE COAT OF PRIMER (SUITABLE FOR 250°F)
NON-INSULATED AREAS: ONE COAT OF INDUSTRIAL ENAMEL (WARM GREY)
- INSULATION: 1 1/2" THK CALCIUM SILICATE INSULATION c/w 0.024" ALUMINUM CLADDING
- HARDNESS TESTING TO BE PERFORMED ON ONE LONG SEAM, ONE CIRC SEAM AND ONE CAT "C" WELD PER WELDER (200 BHN MAXIMUM)
- ALL BOLT HOLES TO STRADDLE CENTERLINE
- ALL OPENINGS TO BE COVERED PRIOR TO SHIPPING
- ALL OUTSIDE PROJECTIONS ARE TO BE MEASURED ALONG THE CENTERLINE OF THE NOZZLE
- ALL INSIDE PROJECTIONS ARE TO BE MEASURED ALONG THE SHORTSIDE OF THE NOZZLE
- FABRICATION TOLERANCE AS PER BWM DWG: TOL2002
- SEAL WELD ALL INTERNALS & 1/8" RADIUS FOR COATING
- VESSEL TO BE REGISTERED IN ALBERTA
- VESSEL TO BE SUPPLIED WITH U-STAMP
- VESSEL IS IN SOUR SERVICE
- SHIPPING DIMENSIONS: 7'-0" W x 8'-6" H x 14'-6" LG
- SHIPPING WEIGHT: 7,000 LBS
- SERIAL NUMBER: 14171

NOZZLE SCHEDULE


MARK	NO. REQ'D	DESCRIPTION	NPS	CLASS	TYPE	PROJECTION INSIDE OUTSIDE	WELD DETAIL	WELD A B C D	REPAD	BILL OF MATERIALS ITEM NUMBER
N1	1	VAPOR INLET	3	150	RFWN	1" 6"	1,5	1/4 - 3/16	-	13,14,15,16
N2	1	VAPOR OUTLET	6	150	RFWN	1" 8"	1,5	5/16 - 3/16	-	17,18,19
N3	1	LIQUID INLET	2	150	RFWN	1" 6"	1,5	1/4 - 3/16	-	20,21,22
N4	1	FUEL GAS	2	150	RFWN	1" 6"	1,3	1/4 -	-	20,21
N5	1	TRUCK-OUT	3	150	RFWN	15" 6"	1,2	1/4 -	-	13,23,24,25,26,27
N6	1	DRAIN	2	150	RFWN	FLUSH 6"	1,2	1/4 -	-	20,28
N7A/B	2	HEAT COIL	2	150	RFWN	6" 8"	1,3	1/4 -	-	29,30,38,39,40,41,42,43,44,45,46,47
N8A/B	2	INSTR. BRIDLE	2	150	RFWN	1" 6"	1,3	1/4 -	-	20,21
N9	1	TI	2	150	RFWN	1" 6"	1,3	1/4 -	-	20,21
N10	1	TC	2	150	RFWN	1" 6"	1,3	1/4 -	-	20,21
M1	1	MANWAY	20	150	RFWN	1" 8"	1,3	1/4 -	-	31,32,33,34,35,36,37

BILL OF MATERIALS


ITEM	REQ'D	PART	DESCRIPTION	MATERIAL	WEIGHT
1	1	SHELL	3/8" THK x 120" W, ROLL TO 72" ID (CIRC=19'-0 1/2" LG)	SA-516-70N	-
2	2	HEAD	3/8" THK (0.3130" MIN) x 72" ID 2:1 S.E.	SA-516-70N	-
3	2	SADDLE	8" x 1/4" THK x 7'-0 3/8" LG, ROLL TO 72 3/4" ID	SA-516-70N	-
4	4	SADDLE	6" x 3/8" THK x 3'-1 5/8" LG	SA-36	-
5	2	SADDLE	3/8" THK x 37 5/8" W x 63 1/4" LG (SEE DETAIL)	SA-36	-
6	2	SADDLE	6" x 1/2" THK x 5'-5" LG c/w HOLES OR SLOTS (SEE DETAIL)	SA-36	-
7	1	NAMEPLATE	6" x 8" NAMEPLATE BRACKET	SA-36	-
8	2	LIFT LUG	1/2" THK x 6" W x 9" LG (SEE DETAIL)	SA-36	-
9	1	GROUND LUG	2" x 1/4" THK x 6" LG c/w 9/16" DIA HOLE	SA-36	-
10	2	INSULATION RING	1" x 3/16" THK x 19'-10" LG, ROLL TO 6'-3 3/4" OD	SA-36	-
11	16	INSULATION RING	1 1/2" x 1/4" THK x 2 1/4" LG	SA-36	-
12	250	SqFt	INSULATION 1 1/2" THK CALCIUM SILICATE INSULATION c/w 0.024" ALUMINUM CLADDING	-	-
13	2	N1,N5	3" x CLASS 150 RFWN FLG SCH XH	SA-105-N	-
14	1	N1	REPAD: 3/8" THK x 15" OD, ROLLED TO 73 3/4" ID	SA-516-70N	-
15	1	N1	3" PIPE SCH XH x 4 3/4" LG (BOE,ROE)	SA-106-B	-
16	1	N1	3/8" THK DEFLECTOR PLATE	SA-516-70N	-
17	1	N2	6" x CLASS 150 RFWN FLG SCH XH	SA-105-N	-
18	1	N2	REPAD: 3/8" THK x 29" OD, ROLLED TO 73 3/4" ID	SA-516-70N	-
19	1	N2	6" PIPE SCH XH x 6" LG (BOE,ROE)	SA-106-B	-
20	7	N3,4,6,8,9,10	2" x CLASS 150 RFWN FLG SCH 160	SA-105-N	-
21	6	N3,4,6,8,9,10	2" PIPE SCH 160 x 4 7/8" LG (BOE,ROE)	SA-105-N	-
22	1	N3	REPAD: 3/8" THK x 12" OD, ROLLED TO 73 3/4" ID	SA-516-70N	-
23	1	N5	3" PIPE SCH XH x 1'-6 3/4" LG (BOE,COE)	SA-106-B	-
24	1	N5	VORTEX: 4" x 1/8" SS FLATBAR x 6" LG	SA-240-TP316	-
25	2	N5	VORTEX: 4" x 1/8" SS FLATBAR x 2 7/8" LG (SEE DETAIL)	SA-240-TP316	-
26	2	N5	VORTEX: 1" x 1/8" SS FLATBAR x 3" LG	SA-240-TP316	-
27	2	N5	VORTEX: 1/2" DIA x 1" LG BOLT c/w NUT	SS	-
28	1	N6	2" PIPE SCH 160 x 4 7/8" LG (BOE,COE)	SA-105-N	-
29	4	N7	2" x CLASS 150 RFWN FLG SCH XH (STAINLESS)	SA-182-F316	-
30	2	N7	2" PIPE SCH XH x 9 3/4" LG (BBE) (STAINLESS)	SA-312-TP316	-
31	1	M1	20" x CLASS 150 RFWN FLG SCH STD	SA-105-N	-
32	1	M1	20" x CLASS 150 RF BLIND FLG	SA-105-N	-
33	1	M1	20" x CLASS 150 RF FLEX GASKET	316SS	-
34	1	M1	20" x CLASS 150 DAVIT ARM	-	-
35	1	M1	20" PIPE SCH STD x 4 5/8" LG (BOE,ROE)	SA-106-B	-
36	20	M1	1 1/8" DIA x 6 1/4" LG STUD	SA-193-B7M	-
37	40	M1	1 1/8" DIA NUT	SA-194-2HM	-
38	4	N7	2" x CLASS 150 RFWN FLG SCH STD (STAINLESS)	SA-182-F316	-
39	3	N7	2" x CLASS 150 RF FLEX GASKET	304SS	-
40	4	N7	2" x 90° SR BW ELBOW SCH STD (STAINLESS)	SA-403-WP316	-
41	2	N7	2" PIPE SCH STD x 6'-2" LG (BBE) (STAINLESS)	SA-312-TP316	-
42	2	N7	2" PIPE SCH STD x 7 3/8" LG (BBE) (STAINLESS)	SA-312-TP316	-
43	12	N7	5/8" DIA x 3" LG STUD	SA-193-B8M	-
44	24	N7	5/8" DIA NUT	SA-194-8M	-
45	2	N7	2" x 3/8" THK FLATBAR x 9 1/4" LG (STAINLESS)	SA-240-TP316	-
46	2	N7	2" x 3/8" THK FLATBAR x 4" LG c/w HOLES FOR U-BOLT (STAINLESS)	SA-240-TP316	-
47	2	N7	2" PIPE U-BOLT (STAINLESS)	SS	-
48	1	INSULATION	1" PIPE SCH XH x 1 1/2" LG (CBE)	SA-106-B	-

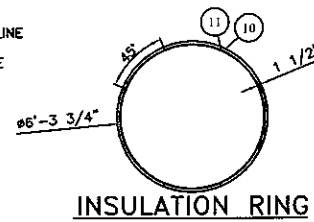


INSULATION RING

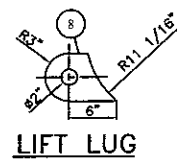


LIFT LUG

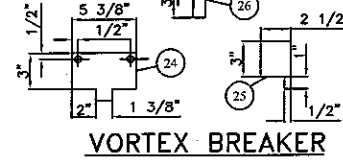


VORTEX BREAKER

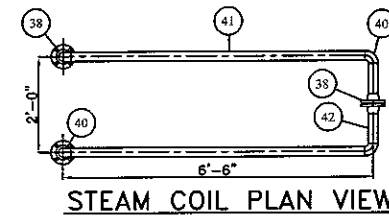


STEAM COIL PLAN VIEW

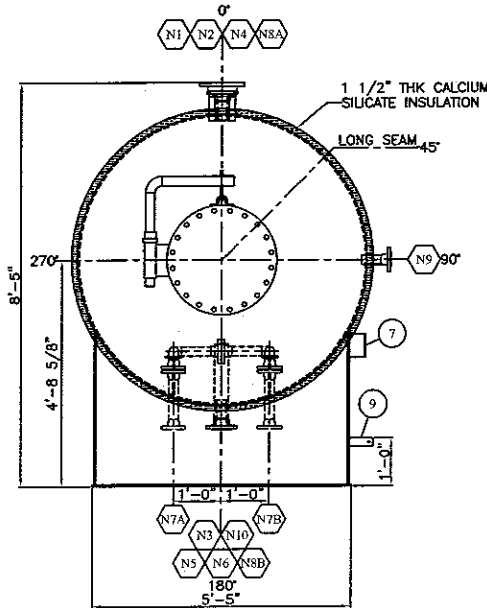


ORIENTATION VIEW A-A

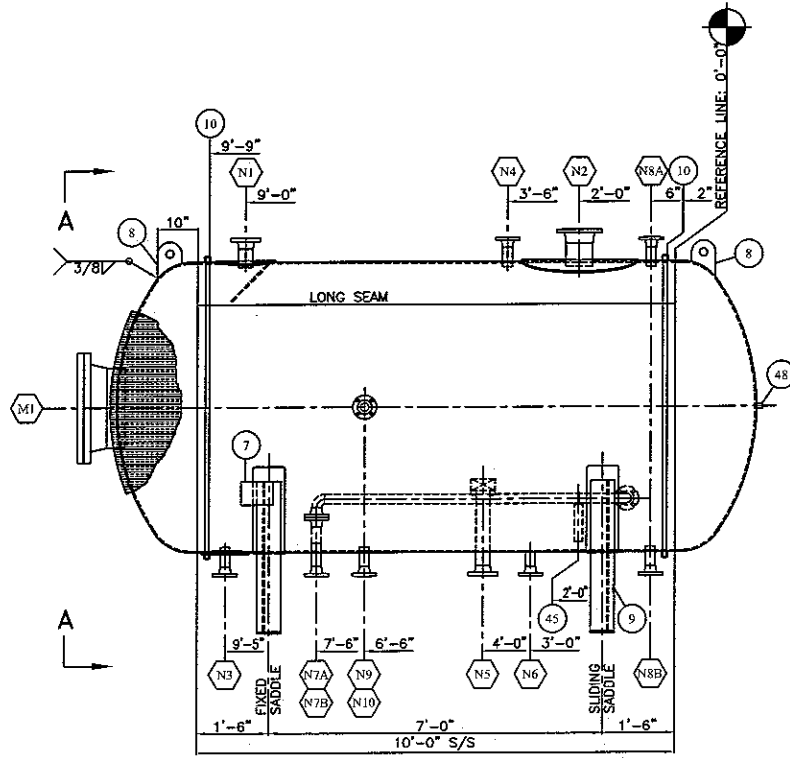

ELEVATION VIEW

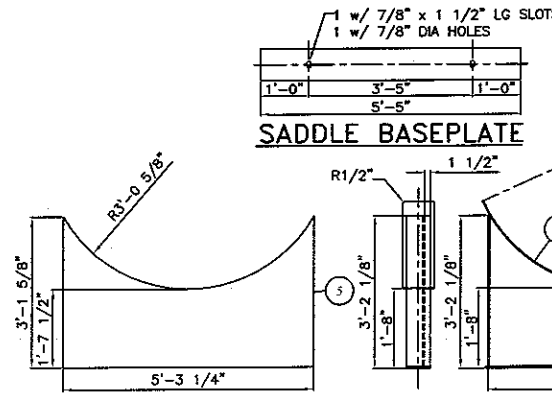


WEB PLATE DETAIL

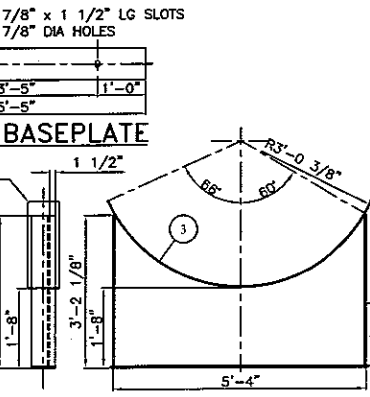


SADDLE DETAILS

WELD DETAIL NUMBER	REGISTERED WELDING PROCEDURE NUMBER	BACKWELD/GOUGE
1,2,3,4	BWM-1 (GMAW) HOT PASS FILL & CAP	N/A
5	BWM-1 (GMAW) BWM-3 (SAW)	N/A
6 & N7	BWM-12 (GMAW) BWM-18 (SMAW)	N/A

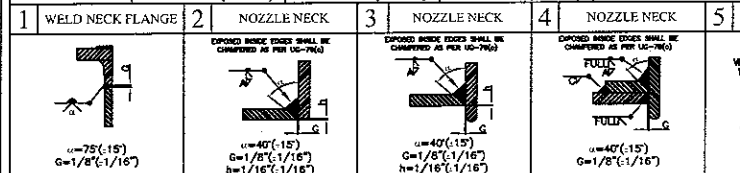

REV. NO.	DATE	REVISION	BY	APP'D
A	05/10/06	ISSUED FOR APPROVAL	DSG	
B	05/30/06	REVISED AS PER CLIENT REQUEST	DSG	
1	05/31/06	ISSUED FOR FABRICATION	DSG	JAM
2	06/12/06	REVISED N5 INSIDE PROJECTION	DSG	JAM
3	08/08/06	AS BUILT DRAWING	DSG	JAM

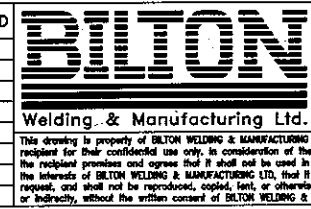

DESIGN SPECIFICATIONS

DESIGN & FABRICATE TO: 2004 ASME BOILER & PRESSURE VESSEL CODE SEC VIII, DIV. 1 2005 ADDENDA
DESIGN PRESSURE & TEMPERATURE: 50 PSI @ 250°F
MINIMUM DESIGN METAL TEMP: -20°F @ 50 PSI
IMPACT TESTS: EXEMPT AS PER UG-20(f)(1-5)
RADIOGRAPHY: 100% AS PER UW-11(a)
POST WELD HEAT TREATMENT: NONE AS PER UCS-56
HYDROSTATIC TEST PRESSURE: 75 PSIG PREHEAT: 150°F
CORROSION ALLOWANCE: 1/8" MAWP: 50 PSI @ 250°F
HEAD THK. MIN.: 0.3130" VOLUME: 347 CuFt, 9.9 Cum
WEIGHT EMPTY: 6,800 LBS WEIGHT FULL: 45,100 LBS

ALTASAS LTD

HORIZONTAL CO2 STILL COLUMN VENT DRUM - TAG: V-902
72" ID x 10'-0" S/S x 50 PSI MAWP
DATE: 05/09/06 SHEET: 1 OF 1
SCALE: N.T.S. JOB NO.: B780
DRAWN BY: DSG
PURCHASE ORDER: 06119C-4
LOCATION: PRINCESS GAS PLANT
CRN DWG: BWM-138-05 R2
CRN NUMBER: T1798.2
APP'D: JAM
REV. 2