



FILE PATH: \\MAINDATA\CAD\TANKS\B300-B399\B341-3

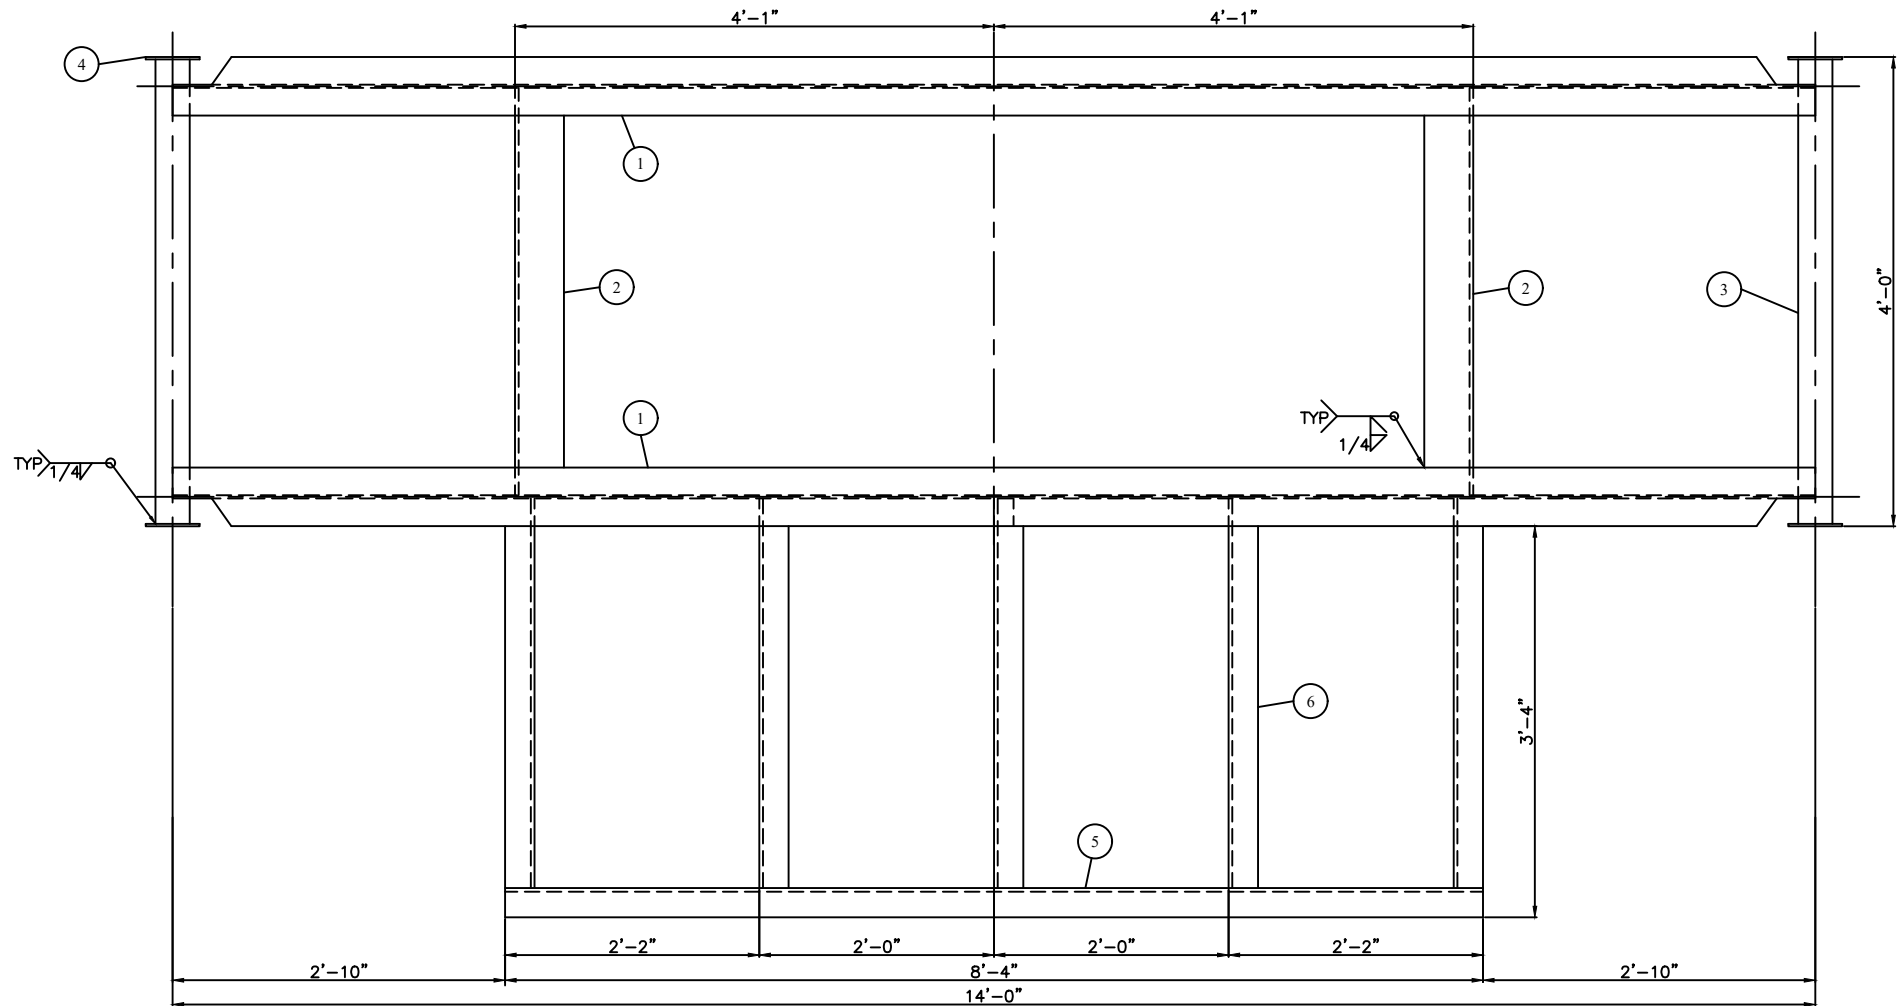

PLAN VIEW

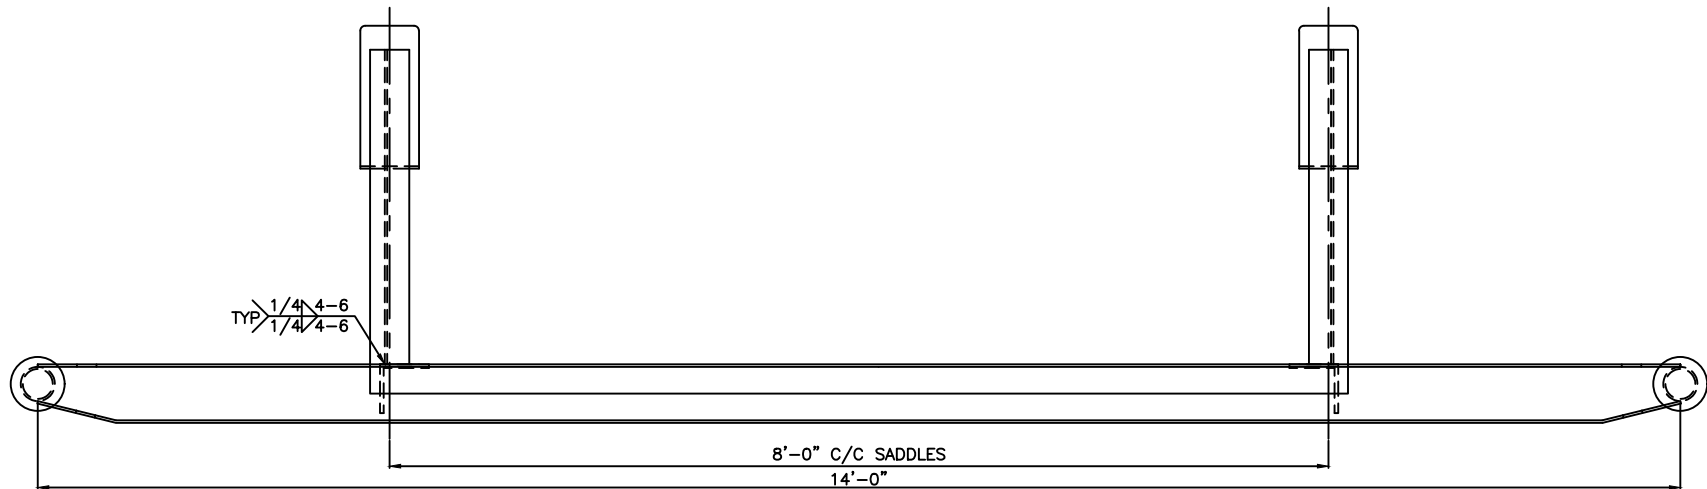


ELEVATION VIEW

BILL OF MATERIALS

ITEM	REQ'D	PART	DESCRIPTION	MATERIAL	WEIGHT
1	2	RUNNER	W6@15# x 14'-0" LG (ROUGH CUT TO 168 1/2")	SA-36	420#
2	2	CROSSMEM	5" x 5" x 3/8" ANGLE x 3'-5 5/8" LG	SA-36	100#
3	2	PULL	3" STD PIPE x 3'-11 1/2" LG	SA-106-B	68#
4	4	PULLCAP	1/4" THK x 5 1/2" OD	SA-36	5#
5	1	SUPPORT	3" x 3" x 3/8" ANGLE x 8'-4" LG	SA-36	60#
6	3	SUPPORT	3" x 3" x 3/8" ANGLE x 3'-3 3/4" LG (COPE TO SUIT)	SA-36	115#

GENERAL NOTES

1. ALL WELDS FULL PENETRATION 1/4" FILLET WELDS
2. PRIME: ONE (1) COAT PRIMER
3. PAINT: ONE (1) COAT INDUSTRIAL ENAMEL (WHITE)
4. APPROXIMATE WEIGHT: 800 LBS

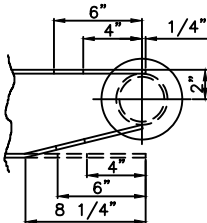

COPE DETAIL

REV. NO.	DATE	REVISION	BY	APP'D
A	01/17/05	ISSUED FOR APPROVAL	DSG	
0	01/21/05	ISSUED FOR FABRICATION	DSG	JAM
1	06/20/05	AS BUILT DRAWING	DSG	JAM

BILTON
Welding & Manufacturing Ltd.

This drawing is property of BILTON WELDING & MANUFACTURING LTD and is loaned to the recipient for their confidential use only. In consideration of the loan of this drawing, the recipient promises and agrees that it shall not be used in any way detrimental to the interests of BILTON WELDING & MANUFACTURING LTD, that it shall be returned upon request, and shall not be reproduced, copied, loaned, or otherwise disposed of, directly or indirectly, without the written consent of BILTON WELDING & MANUFACTURING LTD.

BOX 6106
5815 37 Street
INNISFAIL, AB
CANADA
403-227-7799
1-888-227-4923
FAX 227-7796

CONOCOPHILLIPS CANADA
25 BBL SINGLE WALL L.P. FLARE KNOCKOUT DRUM
SKID DETAILS

DATE: 01/17/05
SCALE: N.T.S.
DRAWN BY: DSG
PURCHASE ORDER: 4504478727
LOCATION: 06-03-62-12 W6M
APP'D BY: JAM

SHEET: 3 OF 4
JOB NO.:
B341
DRAWING NO.:
B341-3

SIZE
D
REV.
1