

Bill of Materials

Flanges	No.	Part Number	Qty.	Units	Description	Heat Number
	1	ORDER	1	EA	24" DIA., SCH STD., 150#, RFWN, ANSI B16.5 SA 105N (N1 - FLARE GAS INLET CONNECTION)	
	2	ORDER	4	EA	24" DIA., SCH STD., 150#, RFWN, ANSI B16.5 SA 105N (FLUE BREAK FLANGES)	
	3					
	4					
	5					
	6					
	7					
Weld Fittings	No.	Part Number	Qty.	Units	Description	Heat Number
	8	ORDER	1	EA	24" DIA., SCH STD., 45 DEGREE, SA 234 WPB WELD ELBOW (N1 - WASTE GAS INLET CONNECTION ELBOW)	
	9					
	10					
	11					
	12					
Concentric Reducer	No.	Part Number	Qty.	Units	Description	Heat Number
	14	XXX-XXXX	1	EA	16" DIA X 304L S.S. WELD IN TYPE, ROLLED (VELOCITY ARRESTOR)	
	15					
	16					
Gaskets	No.	Part Number	Qty.	Units	Description	Heat Number
	17	SNG-0019	2	EA	24" DIA X 1/8" THK, 150#, 316L S.S. FLEXI-CARB GASKET (FLUE BREAK FLANGE GASKET)	
	18					
	19					
	20					
Studs & Nuts	No.	Part Number	Qty.	Units	Description	Heat Number
	21	ORDER	40	EA	1-1/4" DIA. X 7" LONG SA193 B7M STUDS (FLUE BREAK FLANGE STUDS)	
	22	SNG-0085	80	EA	1-1/4" DIA. SA194 2HM NUTS (FLUE BREAK FLANGE NUTS)	
	23					
	24					
	25					
	26					
Pipe	No.	Part Number	Qty.	Units	Description	Heat Number
	27	PPE-0037	1	EA	24" DIA., SCH STD., SMLS, SA 106B PIPE X 13'-7" LONG (STUB LEG)	
	28	PPE-0037	1	EA	24" DIA., SCH STD., SMLS, SA 106B PIPE X 1' - 9 1/4" LONG (N1 - FLARE GAS INLET EXTENSION)	
	29	PPE-0037	1	EA	24" DIA., SCH STD., SMLS, SA 106B PIPE X 45'-9 1/4" LONG (BOTTOM STACK FLUE)	
	30	PPE-0037	1	EA	24" DIA., SCH STD., SMLS, SA 106B PIPE X 58'-11 7/8" LONG (MIDDLE STACK FLUE)	
	31	PPE-0037	1	EA	24" DIA., SCH STD., SMLS, SA 106B PIPE X 12'-9 7/8" LONG (UPPER STACK FLUE)	
	32	PPE-0024	1	EA	16" DIA., SCH STD., SMLS, SA 106B PIPE X 5'-0" LONG (LOWER TIP) PORTION	
	33	PPE-0216	1	EA	16" DIA., SCH STD., SMLS, 316L S.S. PIPE X 5'-0" LONG (UPPER TIP PORTION)	
	34	PPE-0060	4	EA	6" DIA., SCH 80, WELDED, SA 106B PIPE X 11 5/8" LONG (LIFTING TRUNNION EXTENSION)	
	35					
	36					
	37					
	38					
	39					
	40					
	41					
	42					
Plate	No.	Part Number	Qty.	Units	Description	Heat Number
	43	ORDER	1	EA	36" DIA. X 1 1/2" THK SA 36 CS PLATE (BASEPLATE)	
	44	ORDER	1	EA	36" DIA. X 1 1/2" THK SA 36 CS PLATE (MATING BASEPLATE)	
	45	ORDER	8	EA	9" X 5 3/4" X 3/4" THK SA 36 CS PLATE (BASEPLATE GUSSETS)	
	46	ORDER	6	EA	8" X 5" X 1" THK SA 36 CS PLATE, SEE DETAIL (GUYWIRE LUGS)	
	47	ORDER	2	EA	32" O.D. X 24 1/8" I.D. X 3/4" THK SA 36 CS PLATE, SEE DETAIL (GUYWIRE RING)	
	48	ORDER	4	EA	3/8" THK. SA 516-70N PLATE, SEE DETAIL (LIFTING TRUNNION REPADS)	
	49	ORDER	8	EA	3/4" THK. SA 516-70N PLATE, SEE DETAIL (LIFTING TRUNNION STOPS)	
	50	ORDER	4	EA	1" THK. SA 516-70N PLATE, SEE DETAIL (LIFTING TRUNNION EARS)	
	51	ORDER	4	EA	3/4" THK. SA 516-70N PLATE, SEE DETAIL (LIFTING TRUNNION ENDCAPS)	
	52	ORDER	8	EA	3/8" THK. SA 516-70N PLATE, SEE DETAIL (LIFTING TRUNNION EYE PADS)	

Plate	No.	Part Number	Qty.	Units	Description	Heat Number
	53	LZR-0239	1	EA	3" X 3" X 1/2" THK 304L S.S. PLATE (GROUNDING LUG)	
	54	FLS-0121	2	EA	2" WIDE X 6 1/2" LONG X 1/4" THK 304L S.S. PLATE (WASTE GAS STRIPPER)	
	55	FLS-0071	2	EA	12" X 9" X 3/8" THK 316L S.S. PLATE (PILOT WIND SHROUD)	
	56	FLS-0053	2	EA	3" X 6" X 3/16" THK SA 36 CS PLATE (GATE LOCK PLATE)	
	57	FLS-0064	4	EA	PILOT TRACKING JOINER, 2 1/2" X 1 5/8" X 5/8" THK SA 36 CS PLATE	
	58	BAR-0011	2	EA	3" WIDE X 2" LONG X 1/4" THK SA 36 CS FLATBAR (PULLEY EXTENSION)	
	59					
	60					
	61					
Misc. Parts	No.	Part Number	Qty.	Units	Description	Heat Number
	64	FLS-0067	2	EA	PILOT RETRACTING ENCLOSED S.S. PULLEY	
	65	FLS-0063	1	EA	5" LONG X 3" C-CHANNEL (NAMEPLATE BRACKET)	
	66	CONSUMABLE	1	EA	24" DIA., 150#, PLASTIC FLANGE COVER	
	67	FLS-0054	2	EA	GATE LOCK ASSEMBLY, COMPLETE TRACK GATE & GATE LOCK	
	68	FLS-0050	12	EA	PILOT TRACKING, COMPLETE ASSEMBLIES X 24' LONG	
	69	STM-0039	4	EA	3" X 3" X 14" LONG X 1/4" THK ANGLE IRON, A36/44W (PILOT J.B./WARNING LIGHT J.B. BRACKETS)	
	70	ELC-0554	3	EA	1 5/8" X 6" LONG, GALVANIZED UNISTRUT (JUNCTION BOX CABLING)	
	71					
	72					
Ship Loose Parts	No.	Part Number	Qty.	Units	Description	Heat Number
	74	ORDER	1	EA	INCANDESCENT DUAL WARNING LIGHTS-RED 120 VAC, C/W BRACKET, PHOTOELECTRIC CONTROLLER & TRANSFER RELAY	
	75	PLT-0023	2	EA	RETRACTABLE FUEL GAS PILOT MODEL TSI#6 & TMR SYSTEM 24 V.D.C	
	76	FLS-0133	2	EA	1/4" DIA. STAINLESS STEEL PILOT RETRACTING PULLEY CABLE X 275'-0" LONG	
	77	CLA-0106	4	EA	1/4" G450 GALVANIZED CROSBY CLIPS (FOR 1/4" WINCH CABLE)	
	78	MM-0107	2	EA	5/16" G209 GALVANIZED SCREW PIN SAFETY SHACKLE (PULL DOWN SAFETY SHACKLE)(NOT DEPICTED)	
	79	CLA-0107	2	EA	1/8" GALVANIZED CROSBY CLIPS (PULL DOWN CABLE CLIP)(NOT DEPICTED)	
	80	FLS-0134	2	EA	1/8" DIA. GALVANIZED PILOT PULL DOWN CABLE X 145'-0" LONG (NOT DEPICTED)	
	81	XXX-XXXX	2	EA	15:1 WORM GEAR WINCH - DRILL DRIVEN C/W MOUNTING BASE (SEE SEPERATE DETAIL DRAWING SET)	
	82	CUSTOM	1	EA	10" X 8" HOFFMAN NEMA 4, A1018 CHNF ELECTRICAL JUNCTION BOX FOR (2) 24 VDC PILOTS	
	83	CUSTOM	1	EA	10" X 8" HOFFMAN NEMA 4, A1018 CHNF ELECTRICAL JUNCTION BOX FOR L-860 WARNING LIGHTS-120 VAC	
	84	CUSTOM	1	EA	18" X 16" X 10" CONTROL BOX FOR (2) 24 VDC PILOTS-CLASS 1 DIV. 2(NOT DEPICTED)	
	85					
	86	ELC-0939	2	EA	#16-4 SOW ELECTRICAL CABLE X 140'-0" LONG (PILOTS)	
	87	REG-0020	2	EA	1/4" DIA. NPT BELLOFRAM T-50 REGULATOR	
	88	IND-0072	2	EA	1/4" DIA. NPT BRASS, MODEL #WJ4642, 0-30 PSI GAUGE	
	89	HYD-0193	2	EA	1/4" DIA. NPT TYPE 3 FLEXIBLE FUEL SUPPLY HOSE X 140'-0" LONG (PILOTS)	
	90	PLT-0047	30	EA	FUEL HOSE/CABLE GUIDES STAINLESS STEEL(NOT DEPICTED)	
	91	CLA-0114	64	EA	FUEL HOSE/CABLE CLAMPS(NOT DEPICTED)	
	92	HYD-0190	4	EA	1/4" FUEL HOSE ENDS (AEROQUIP #4411-4S)(NOT DEPICTED)	
	93	HYD-0016	4	EA	1/4" NPT FUEL HOSE ADAPTER (AEROQUIP #2021-4-4S)(NOT DEPICTED)	
	94	MM-0107	2	EA	5/16" G209 GALVANIZED SCREW PIN SAFETY SHACKLE FOR WINCH CABLE	
	95					
	96	CONSUMABLE	30	EA	PLASTIC ZIP TIES FOR FASTENING ELECTRICAL CABLE TO HOSE GUIDES	
	97	ORDER	3	EA	1/2" GALVANIZED 6X26 IRWC CABLE X 181'-0" LONG (UPPER GUYWIRES)(FLEMISHED ONE END)	
	98	ORDER	3	EA	1/2" GALVANIZED 6X26 IRWC CABLE X 146'-0" LONG (LOWER GUYWIRES)(FLEMISHED ONE END)	
	99	CLA-0105	18	EA	1/2" G450 GALVANIZED CROSBY CLIPS (UPPER & LOWER GUYWIRE CLIPS)	
	100	MM-0116	6	EA	1/2" G414 GALVANIZED HEAVY DUTY THIMBLESS (UPPER & LOWER GUYWIRE THIMBLES)	
	101	ORDER	6	EA	3/4" GALVANIZED SCREW PIN SAFETY SHACKLES, #G2130 (UPPER & LOWER GUYWIRE SHACKLES)	
	102	ORDER	6	EA	7/8" X 18" HG-228 JAW & JAW GALVANIZED (GUYWIRE TURNBUCKLES)	
	103	ELC-0939	1	EA	#16-4 SOW ELECTRICAL CABLE X 140'-0" LONG (WARNING LIGHTS)	
	104	ELC-1207	1	EA	PILOT MOUNTED WARNING LIGHTS BRACKET-COMPLETE	
	105					
	106					
	107					
	108					

NEED ELECTRICAL SCHEMATIC & WIRING DIAGRAMS 12/06/09

MASTER VENDOR PRINT

Coating & Preparation: 1.) STACK EXTERIOR; SANDBLAST; SSPC-SP6 (1.5 - 2.5 mils) PRIMER: CLOVERDALE PRIMER, (2-2.5 mils DFT) TOPCOAT: CLOVERDALE 200C, (2-2.5 mils DFT) D.O.T ORANGE & WHITE FINISH.	Ignition System: TORNADO RETRACTABLE FUEL GAS PILOT MODEL TSI#6 c/w AUTO RELITE SYSTEM TMR 24 V.D.C. (TWD)	Name of Plant: PIPESTONE COMPRESSOR STATION Lease: 13-34-70-09 W6M Approx. Weight: 17,201 LBS. Max. Horiz. Load At Base: 3,600 LBS. Max. Vert. Load At Base: 26,100 LBS. Net Overturning Moment: 82,000 FT.-LBS. Design Wind Pressure: 0.43 kPa Design Wind Velocity: 95.8 mph Gust Factor: 2.6 Weld Procedure: #1323.2 APEGGA Permit To Practice: #P10806 CWB Registration Number: TORNG1	Drawing Number: Encana-12511-BOM (1) Drawn By: AMG Checked By: EW Date Drawn: JUNE 6, 2012 Job Number: 12511 Quote Number: GEM0312 Tag Number: S-560 Design Code: NBC 2010 Exposure Factor: 1.52 Anchor Diameter (Base): Ø 1 1/4" Corrosion Allowance: 1/8"	Title: Ø16" x 145'-0" TALL GUYWIRE SUPPORTED FLARE STACK c/w Ø16" INLET CONNECTION Customer: ENCANA CORPORATION c/o GEMINI ENGINEERED SOLUTIONS LP P.O.#: G11124-100-1011 Salesperson: STEVE CAISSIE	Sheet 1 of 1  TORNADO COMBUSTION TECHNOLOGIES INC. 1-888-882-3882 Any Technical Data and the Designs Disclosed Herein are the Exclusive Property of Tornado Technologies Inc. and/or Contained the Proprietary Rights of Others and are not to be used or Disclosed to Others without the Written Consent of Tornado Technologies Inc.
General Notes: 1.) MTRS PROVIDED ON REQUEST AND RECEIPT OF ORDER. 2.) TORNADO STANDARD FOR PLUMBNESS TOLERANCE IS 1 INCH PER 100 FEET OF VERTICAL HEIGHT. 3.) BASE PLATE ANCHORS TO BE DOUBLE NUTTED. 4.) FOUNDATION TO BE DESIGNED BY A QUALIFIED ENGINEER.	Fabrication Tolerances * Fractional: Ø0" to Ø24" ±1/8" Greater than Ø24" ±1/4" Decimal: Ø0" to Ø24" ±1/8" Greater than Ø24" ±1/4" Angular: All ±2° *Unless otherwise stated	ISSUED FOR APPROVAL PURPOSES By Y M D			
Rev.	Description				

VENDOR DWG. CONTROL		
GEMINI CALGARY, ALBERTA		DATE JUN 07 2012
JOB No.	P.O. #	SUB #
G 1 1 1 2 4 . 1 0 0		1


☐ APPROVED FOR CONSTRUCTION
☒ APPROVED AS NOTED. MAKE CHANGES NOTED AND ISSUE FOR CONSTRUCTION
☐ NOT APPROVED. MAKE CHANGES NOTED AND RESUBMIT FOR APPROVAL
BY: Brent Robinson
DATE: 14 JUNE 2012
GEMINI

GEMINI				
Order	Discipline	To	Date	Initials
	Project Engineer		12/12/12	SA
	Mech Piping Eng		15 Jun 12	ES
	Mech Piping Design	Rob L	June 14	RL
	Civil Eng	T. Stein	12 June '12	TS
	Civil Design			
	Process	S N-A	14/June 12	RN
	Instru-mentation		12/6/12	Rm
	Electrical	JWF	12/06/09	JF
	Controls			
	Inspection / QA			
	Project Manager		14 June 12	BR
INTERDISCIPLINARY REVIEW				
☒ FOR APPROVAL ☐ FOR INFORMATION				
RETURN TO		DATE REQUIRED: JUN 14 2012		
☒ VENDOR				
☐ FILE				
☐				

MASTER VENDOR
JUN 14 2012

NOZZLE & COUPLING SCHEDULE

Mark No.	Qty.	Size	Material	Rating	Service	Projection Inside Outside	Welding Detail Number	Filet Weld Size A B C D	Description	Elevation	Orientation Angle
N1	1	Ø24" [406mm]	SA 105N	150#	FLARE GAS INLET CONNECTION	0"	30"	3/8"	R.F. WELD NECK	10'-0" [3,048mm]	180°
WELD DETAILS											
WELD DETAIL 1			WELD DETAIL 2			WELD DETAIL 3			WELD DETAIL 5		
Weld Procedure: TT-10			Weld Procedure: TT-1, TT-31			Weld Procedure: TT-1, TT-31			Weld Procedure: TT-1, TT-31		

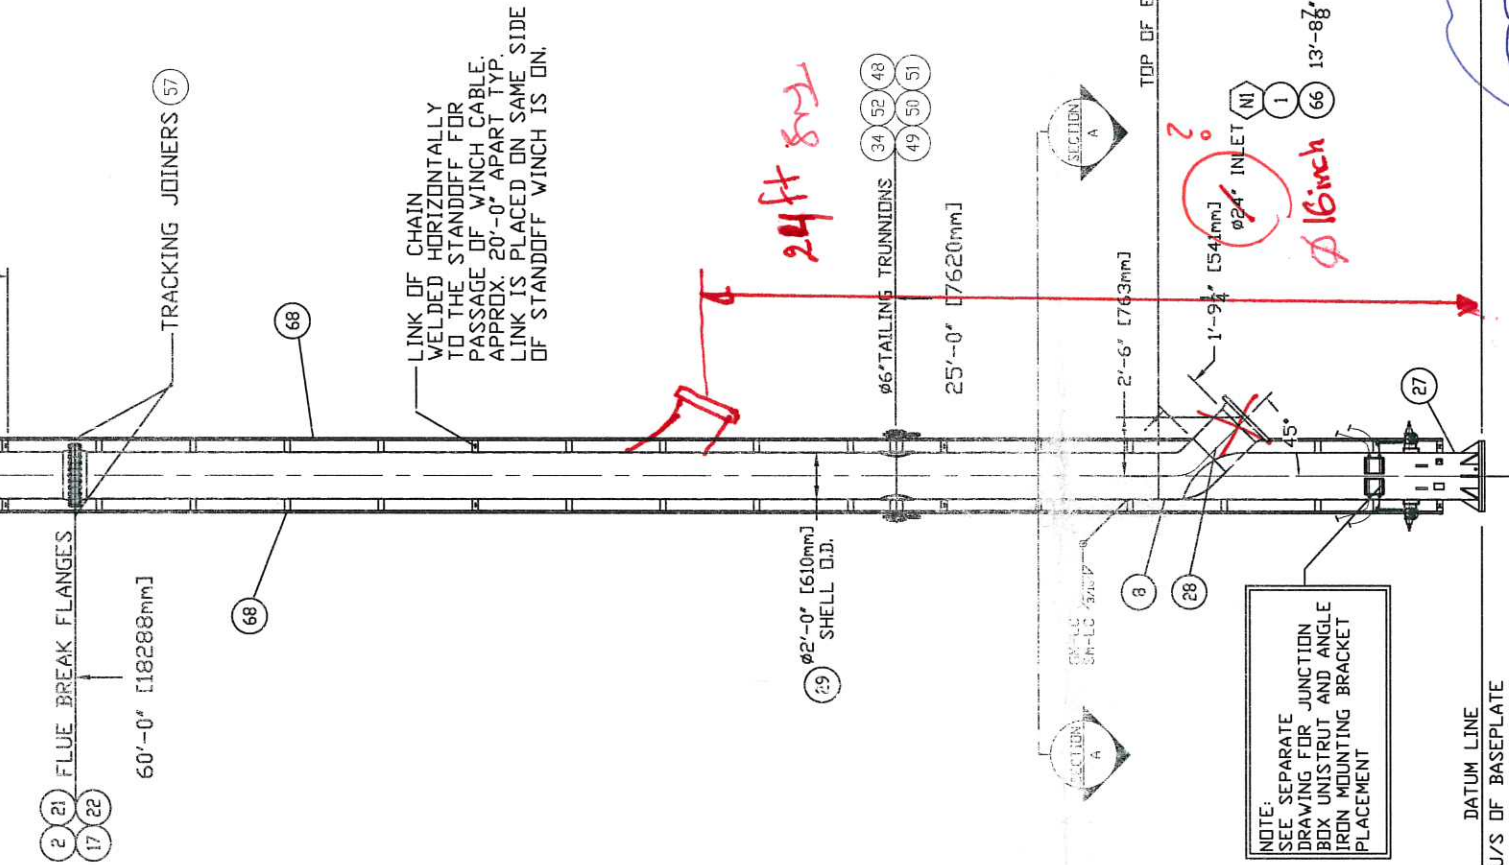

NDT Notes:

% Of Radiography For Butt Welds In Contact With Waste Gas:	10%
Hardness Testing:	YES
Magnetic Particle Testing on Fillet Welds At Inlet, Lifting Devices, Baseplate And Gussets:	YES
Ultra Sonic Testing:	NONE
Dye Penetrant:	NONE

NOTE:
ORIENTATION VIEW DEPICTS
TRUE ORIENTATION PLACEMENT
OF STACK COMPONENTS.

LINK OF CHAIN
WELDED HORIZONTALLY
TO THE STANDOFF FOR
PASSAGE OF WINCH CABLE.
APPROX. 20'-0" APART TYP.
LINK IS PLACED ON SAME SIDE
OF STANDOFF WINCH IS ON.

NOTE:
SEE SEPARATE
DRAWING FOR JUNCTION
BOX UNISTRUT AND ANGLE
IRON MOUNTING BRACKET
PLACEMENT

Coating & Preparation:		Ignition System:	
1.) STACK EXTERIOR; SANDBLAST: SSPC-SP6 (1.5 - 2.5 mils) PRIMER: CLOVERDALE PRIMER, (2-2.5 mils DFT) TOPCOAT: CLOVERDALE 200C, (2-2.5 mils DFT) D.D.T ORANGE & WHITE FINISH.		TORNADO RETRACTABLE FUEL GAS PILOT MODEL 151#6 AUTO RELITE SYSTEM TPMP 24 V.D.F. (TWO)	
General Notes:		Fabrication Tolerances *	
1.) MTRS PROVIDED ON REQUEST AND RECEIPT OF ORDER. 2.) TORNADO STANDARD FOR PLUMBNESS TOLERANCE IS 1 INCH PER 100 FEET OF VERTICAL HEIGHT. 3.) BASE PLATE ANCHORS TO BE DOUBLE NUTTED. 4.) FOUNDATION TO BE DESIGNED BY A QUALIFIED ENGINEER.		Fractional Ø0" to Ø24" ±1/8" Greater than Ø24" ±1/4"	
		Decimal: Ø0" to Ø24" ±1/8" Greater than Ø24" ±1/4"	
		Angular: All ±2°	
		*Unless otherwise stated	

Name of Plant:	PIPESTONE COMPRESSOR STATION
Lease:	13-34-70-09 W6M
Approx. Weight:	17,201 LBS.
Max. Horiz. Load At Base:	3,600 LBS.
Max. Vert. Load At Base:	26,100 LBS.
Net Overturning Moment:	82,000 FT.-LBS.
Design Wind Pressure:	0.43 kPa
Design Wind Velocity:	95.8 mph
Gust Factor:	2.6
Weld Procedure:	#13232
APECGA Permit To Practice:	#P10806
CWB Registration Number:	TORNG1

Drawing Number:	Encana-12511-GA (1)
Drawn By:	AMG
Checked By:	EW
Date Drawn:	JUNE 6, 2012
Job Number:	12511
Quote Number:	GEM0312
Tag Number:	
Design Code:	NBC 2010
Exposure Factor:	1.52
Anchor Diameter (Base):	Ø 1 1/4"
Corrosion Allowance:	1/8"


Title:	Ø16" x 145'-0" TALL GUYWIRE SUPPORTED FLARE STACK c/w Ø24" INLET CONNECTION
Customer:	ENCANA CORPORATION c/o GEMINI ENGINEERED SOLUTIONS LP
P.O.#:	G11124.100-1011
Salesperson:	STEVE CAISSIE

Sheet 1 of 5

MASTER VENDOR
PRINTLOWER SECTION
SCALE 1:1

How much clear space
is reqd. for laydown?
RKL

NOTE:
QUANTITIES OF TWO
FUEL GAS REGULATORS,
GAUGES, AND LENGTHS
OF FUEL HOSE SUPPLIED
BY TORNADO.

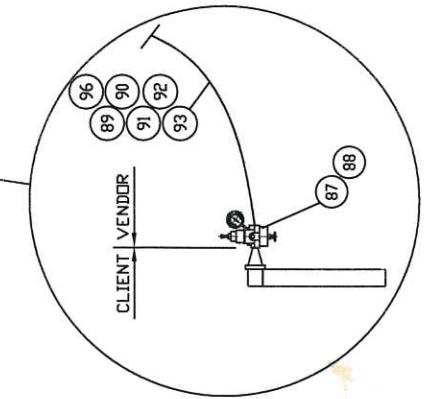BASE DETAIL
SCALE 4:1

RECEIVED
VENDOR
PRINT

VENDOR DWG. CONTROL		
GEMINI CALGARY, ALBERTA		DATE
		JUN 07 2012
JOB No.	P.O. #	SUB #
G11124.100		1

☐ APPROVED FOR CONSTRUCTION

☐ APPROVED AS NOTED. MAKE CHANGES NOTED AND ISSUE FOR CONSTRUCTION

☒ NOT APPROVED. MAKE CHANGES NOTED AND RESUBMIT FOR APPROVAL

BY: Brent Robinson

DATE: 14 Jun 12

GEMINI

GEMINI				
Order	Discipline	To	Date	Initials
	Project Engineer		June 14/12	BR
	Mech Piping Eng	E.S.	13 June 12	E.S.
	Mech Piping Design	Rob L	June 14	RLL
	Civil Eng	T. Stein	12 June 12	TS
	Civil Design			
	Process	S N-A	14 Jun 12	SN
	Instru-mentation		12/6/12	12 m
	Electrical	J F	12/6/12	JF
	Controls			
	Inspection / QA			
	Project Manager		14 Jun 12	BR

☒ FOR APPROVAL ☐ FOR INFORMATION

RETURN TO DATE REQUIRED JUN 14 2012


☒ VENDOR

☐ FILE

☐

INTERDISCIPLINARY REVIEW

**MASTER VENDOR
PRINT**

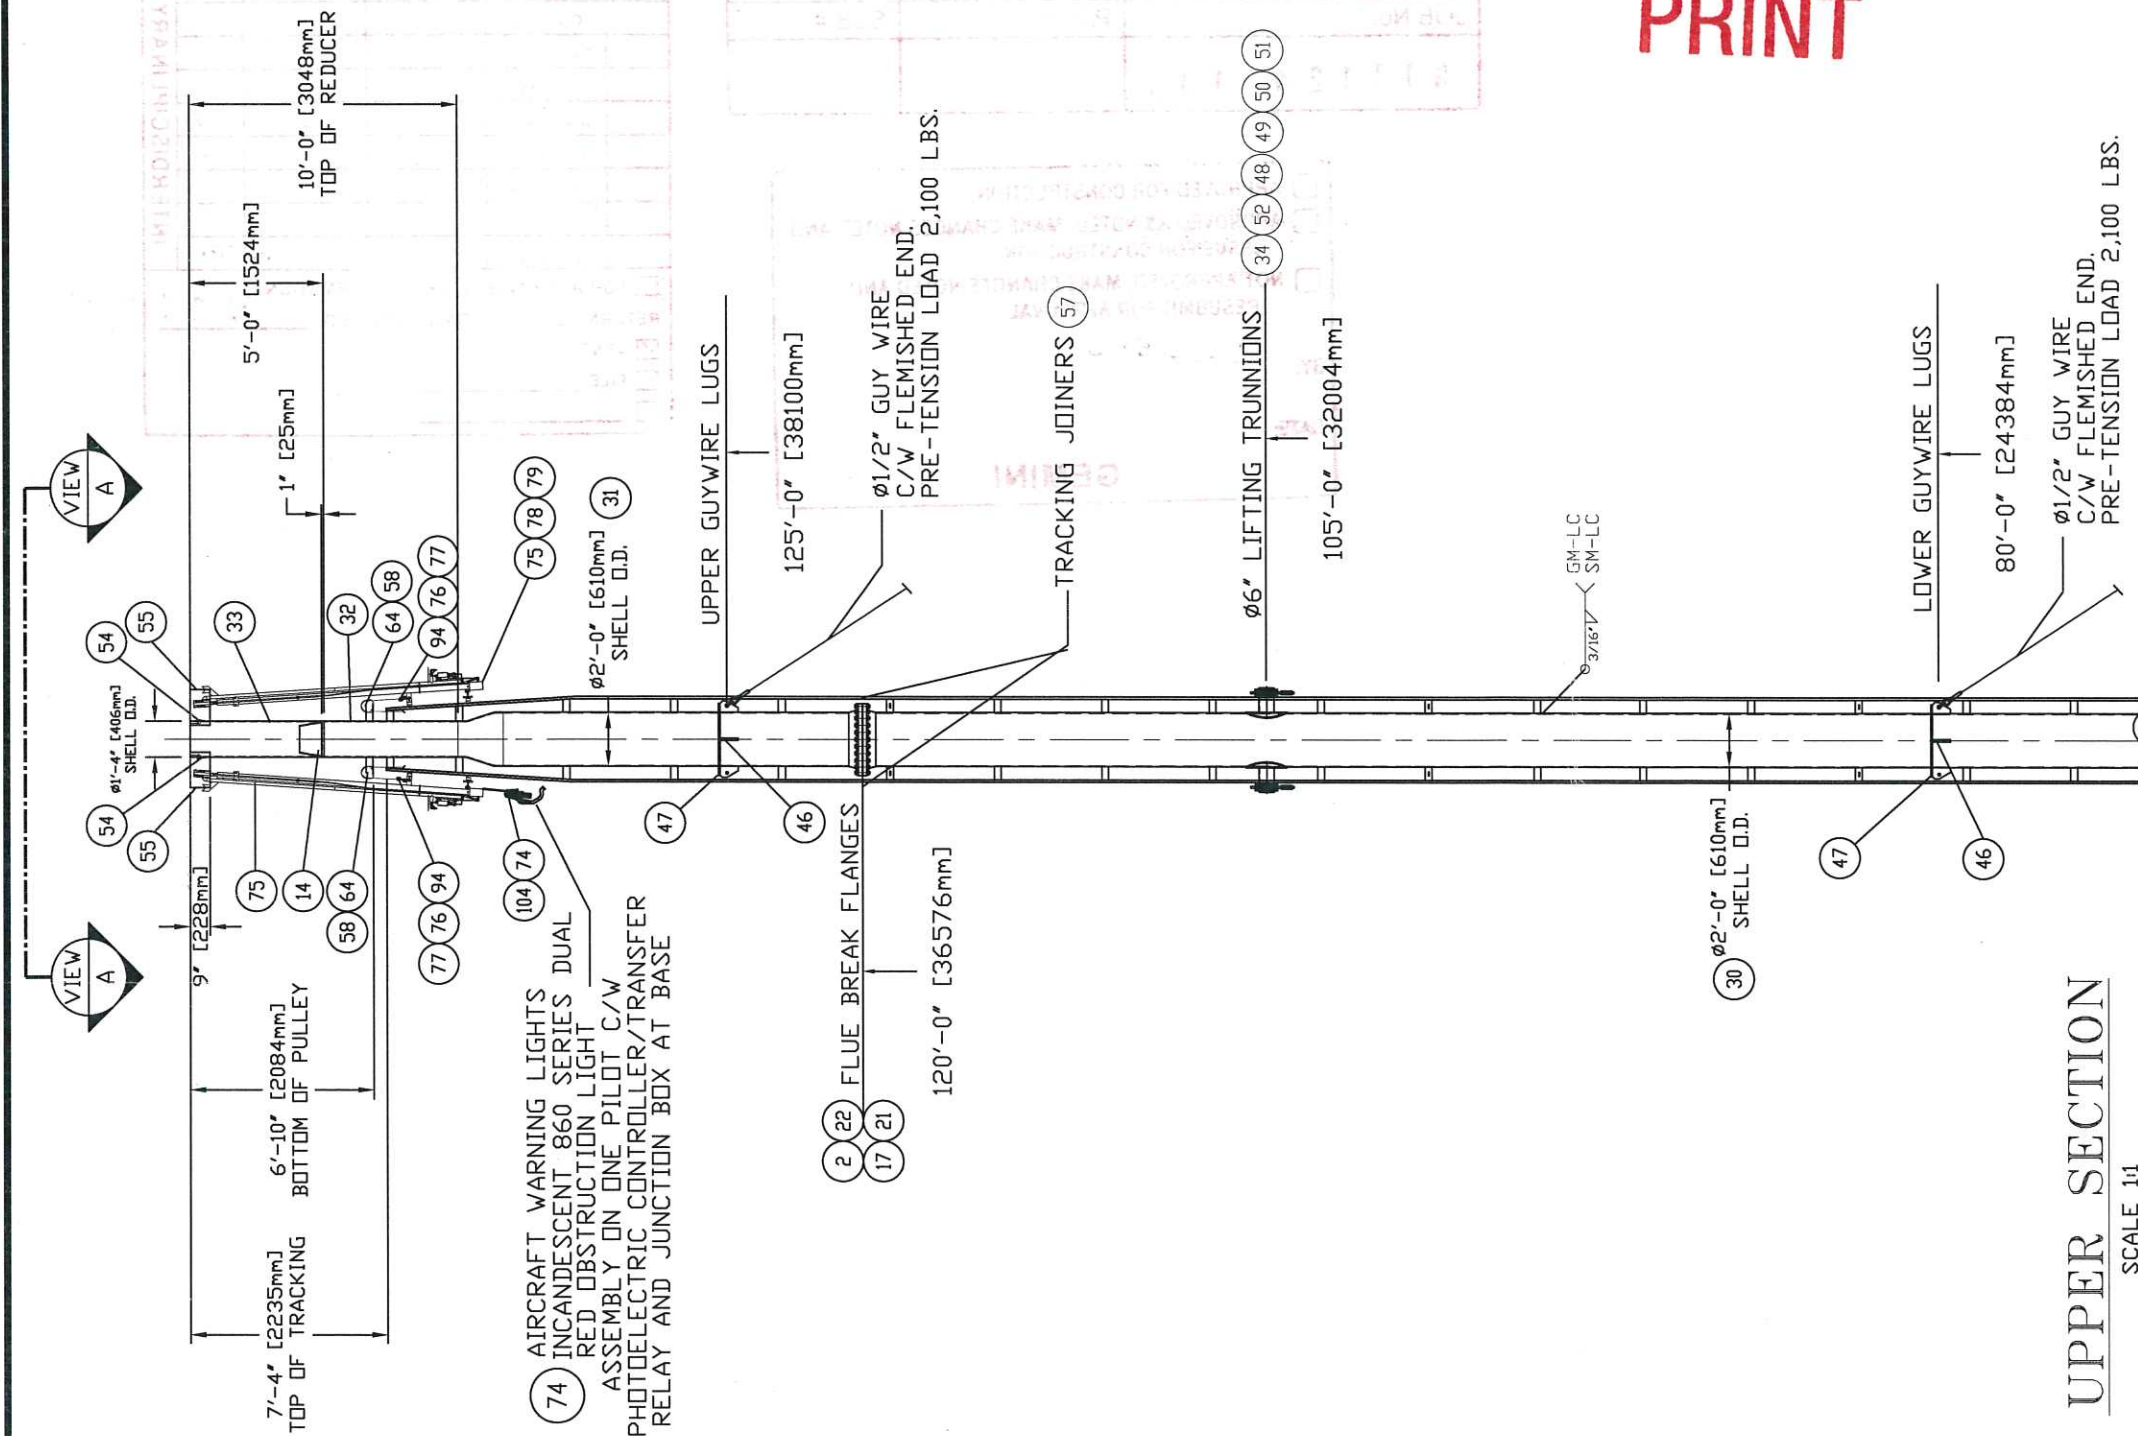


GUYWIRE LUG CONNECTION

ONE - 3/4" GALVANIZED SCREW PIN SAFETY SHACKLE
ONE - 1/2" 6 x 26 GALV. IRWC CABLE F.D.E.
(TYPICAL 3 SETS)

NOTE:
ORIENTATION VIEW DEPICTS
TRUE ORIENTATION PLACEMENT
OF STACK COMPONENTS.

GUYWIRE ANCHOR CONNECTION

ONE - 7/8" x 18" J & J TURNBUCKLE
ONE - 1/2" GALVANIZED HEAVY THIMBLE
THREE - 1/2" GALVANIZED CROSBY CLIPS
ONE - 1/2" 6 x 26 GALV. IRWC CABLE F.D.E.
(TYPICAL 3 SETS)

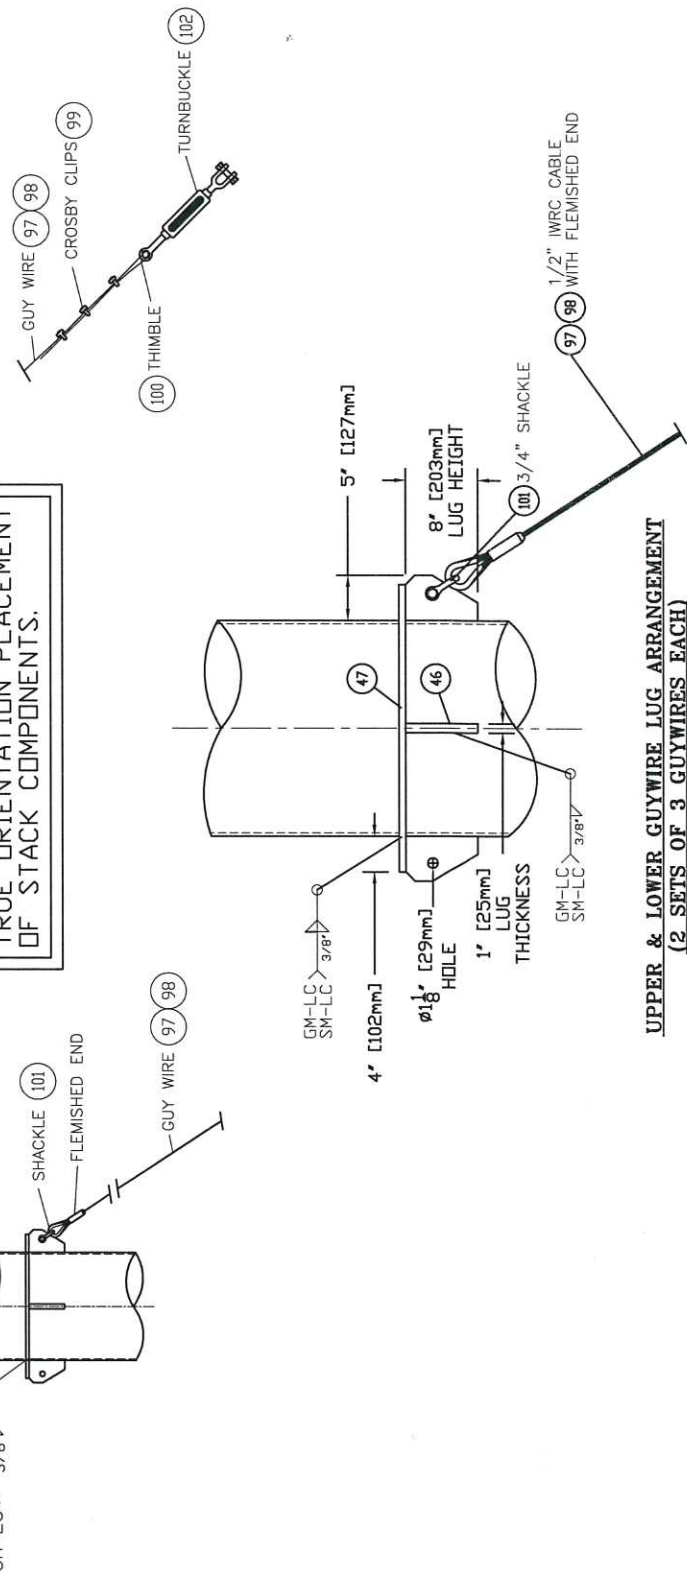

UPPER & LOWER GUYWIRE LUG ARRANGEMENT
(2 SETS OF 3 GUYWIRES EACH)

SCALE 4:1

O	ISSUED FOR APPROVAL PURPOSES	AMG	12	06	06
Rev.	Description	By	Y	M	D

Coating & Preparation: 1.) STACK EXTERIOR; SANDBLAST: SSPC-SP6 (1.5 - 2.5 mils) PRIMER: CLOVERDALE PRIMER, (2-2.5 mils DFT) TOPCOAT: CLOVERDALE 200C, (2-2.5 mils DFT) D.D.T ORANGE & WHITE FINISH.		Ignition System:	
		TORNADO RETRACTABLE FUEL GAS PILOT MODEL TSI#6 c/w AUTO RELITE SYSTEM TPMR 24 V.D.C. (TWO)	
General Notes:			Fabrication Tolerances *
1.) MTRS PROVIDED ON REQUEST AND RECEIPT OF ORDER. 2.) TORNADO STANDARD FOR PLUMBNESS TOLERANCE IS 1 INCH PER 100 FEET OF VERTICAL HEIGHT. 3.) BASE PLATE ANCHORS TO BE DOUBLE NUTTED. 4.) FOUNDATION TO BE DESIGNED BY A QUALIFIED ENGINEER.		Fractional: $\varnothing 0" \text{ to } \varnothing 24"$ $\pm 1/8"$ Greater than $\varnothing 24"$ $\pm 1/4"$	
		Decimal: $\varnothing 0" \text{ to } \varnothing 24"$ $\pm 1/8"$ Greater than $\varnothing 24"$ $\pm 1/4"$	
		Angular: All $\pm 2^\circ$	
		*Unless otherwise stated	

Name of Plant:	PIPESTONE COMPRESSOR STATION
Lease:	13-34-70-09 W6M
Approx. Weight:	17,201 LBS.
Max. Horiz. Load At Base:	3,600 LBS.
Max. Vert. Load At Base:	26,100 LBS.
Net Overturning Moment:	82,000 FT.-LBS.
Design Wind Pressure:	0.43 kPa
Design Wind Velocity:	95.8 mph
Gust Factor:	2.6
Weld Procedure:	#1323.2
APEGGA Permit To Practice:	#P10806
CWB Registration Number:	TDRNG1

Drawing Number:	Encana-12511-GA (2)
Drawn By:	AMG
Checked By:	EW
Date Drawn:	JUNE 6, 2012
Job Number:	12511
Quote Number:	GEM0312
Tag Number:	
Design Code:	NBC 2010
Exposure Factor:	1.52
Anchor Diameter, (Base):	Ø 1 1/4"
Corrosion Allowance:	1/8"

Title: ø16" x 145'-0" TALL GUYWIRE SUPPORTED FLARE STACK c/w ø24" INLET CONNECTION
Customer: ENCANA CORPORATION c/o GEMINI ENGINEERED SOLUTIONS LP
P.O.#: G11124.100-1011
Salesperson: STEVE CAISSIE

Sheet 2 of 5



**TORNADO COMBUSTION
TECHNOLOGIES INC.**
1-888-882-3882

Any Technical Data and the Designs Disclosed Herein are the Exclusive Property of Tornado Technologies Inc. and/or Contained the Proprietary Rights of Others and are not to be used or Disclosed to Others without the Written Consent of Tornado Technologies Inc.

MASTER VENDOR
PRINT

VENDOR DWG. CONTROL		
GEMINI CALGARY, ALBERTA		DATE JUN 07 2012
JOB No.	P.O. #	SUB #
G 11124.100		1


☒ APPROVED FOR CONSTRUCTION
☐ APPROVED AS NOTED. MAKE CHANGES NOTED AND ISSUE FOR CONSTRUCTION
☐ NOT APPROVED. MAKE CHANGES NOTED AND RESUBMIT FOR APPROVAL
BY: <u>Brent Robinson</u>
DATE: <u>14 JUNE 2012</u>
GEMINI

GEMINI				
Order	Discipline	To	Date	Initials
	Project Engineer		<u>12/07/12</u>	<u>SR</u>
	Mech Piping Eng		<u>13 June 12</u>	<u>F.S.</u>
	Mech Piping Design	<u>Rob L</u>	<u>June 14</u>	<u>RLL</u>
	Civil Eng	<u>T. Stein</u>	<u>12 June 12</u>	<u>TS</u>
	Civil Design			
	Process	<u>SN-A</u>	<u>14 June 12</u>	<u>SN</u>
	Instru-mentation		<u>12/6/12</u>	<u>Ry</u>
	Electrical	<u>JOF</u>	<u>12/06/09</u>	<u>JF</u>
	Controls			
	Inspection / QA			
	Project Manager		<u>14 JUNE 12</u>	<u>BR</u>


☒ FOR APPROVAL ☐ FOR INFORMATION
RETURN TO _____ DATE REQUIRED: JUN 14 2012
☒ VENDOR
☐ FILE
☐ _____

INTERDISCIPLINARY REVIEW

MASTER VENDOR PRINT

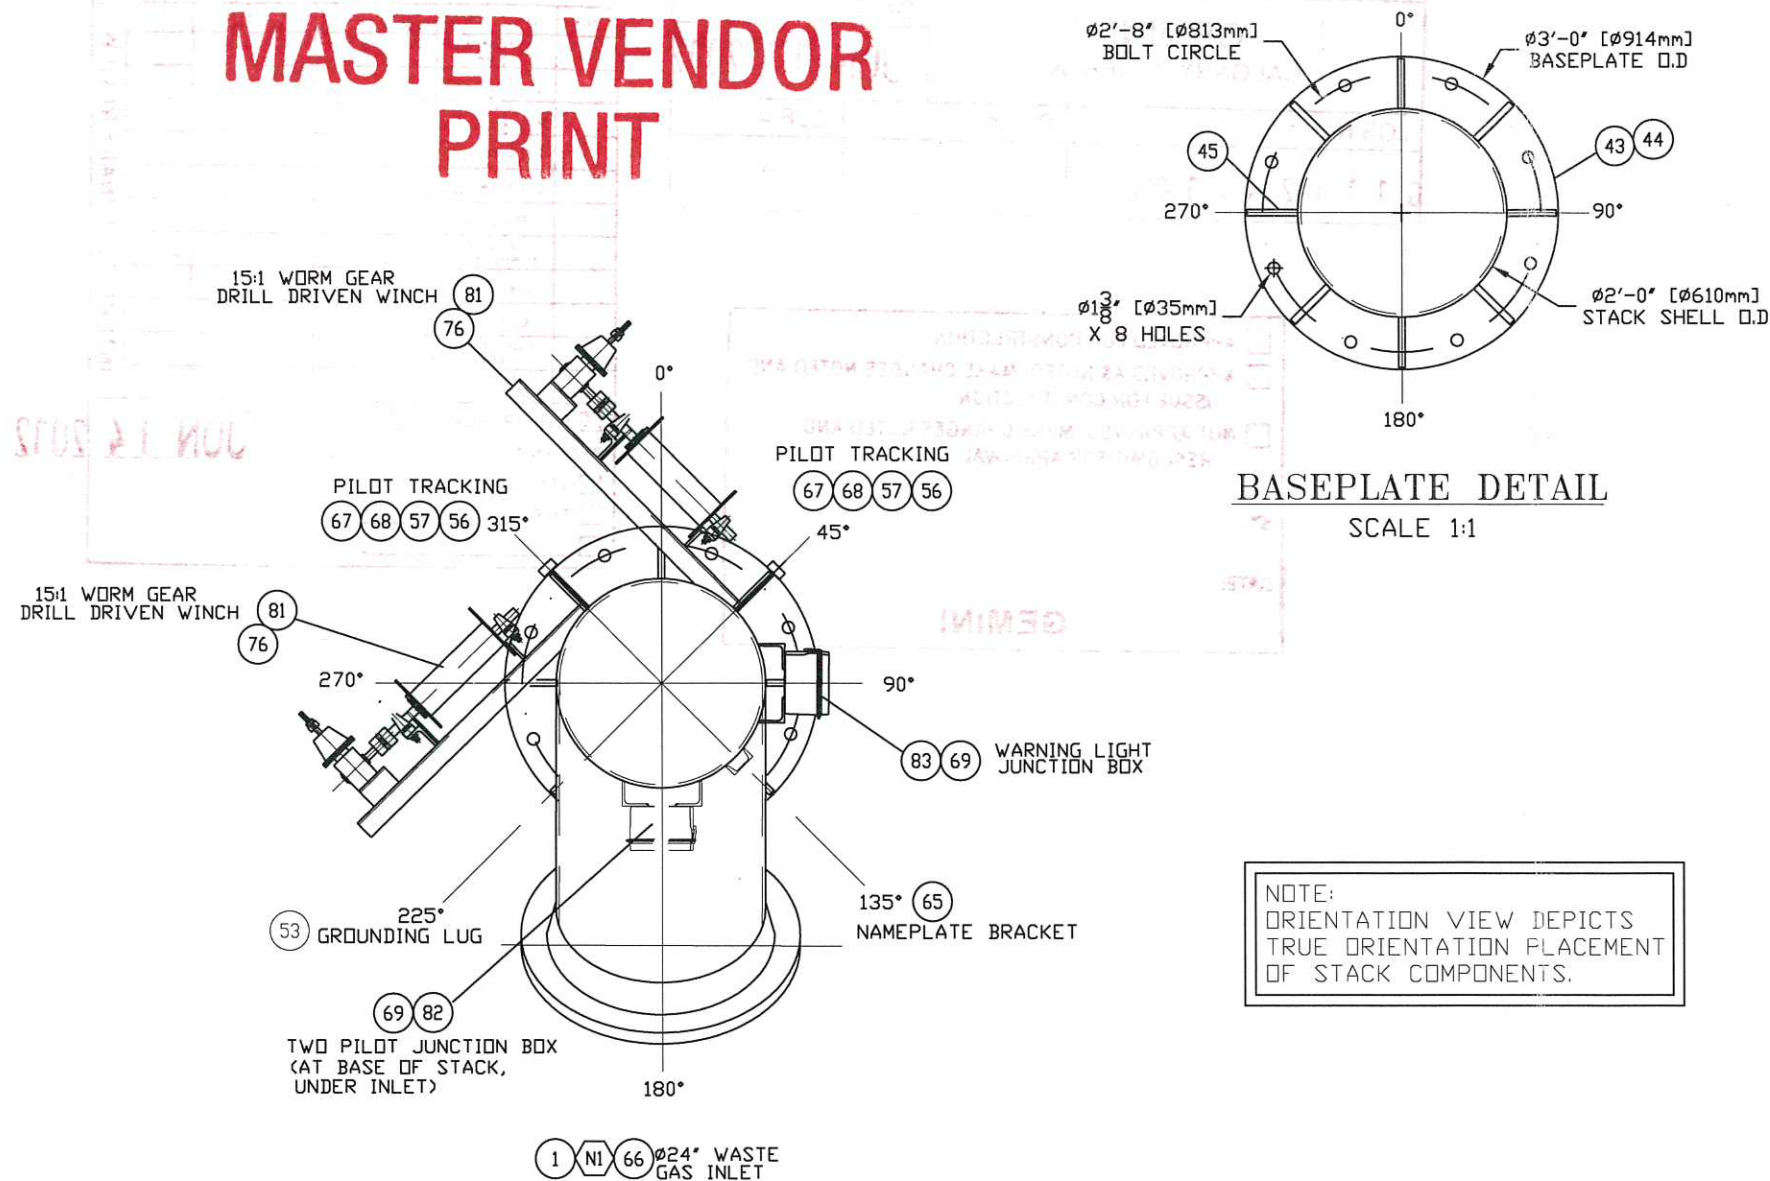

LIFT UP ↔ SHIP DOWN

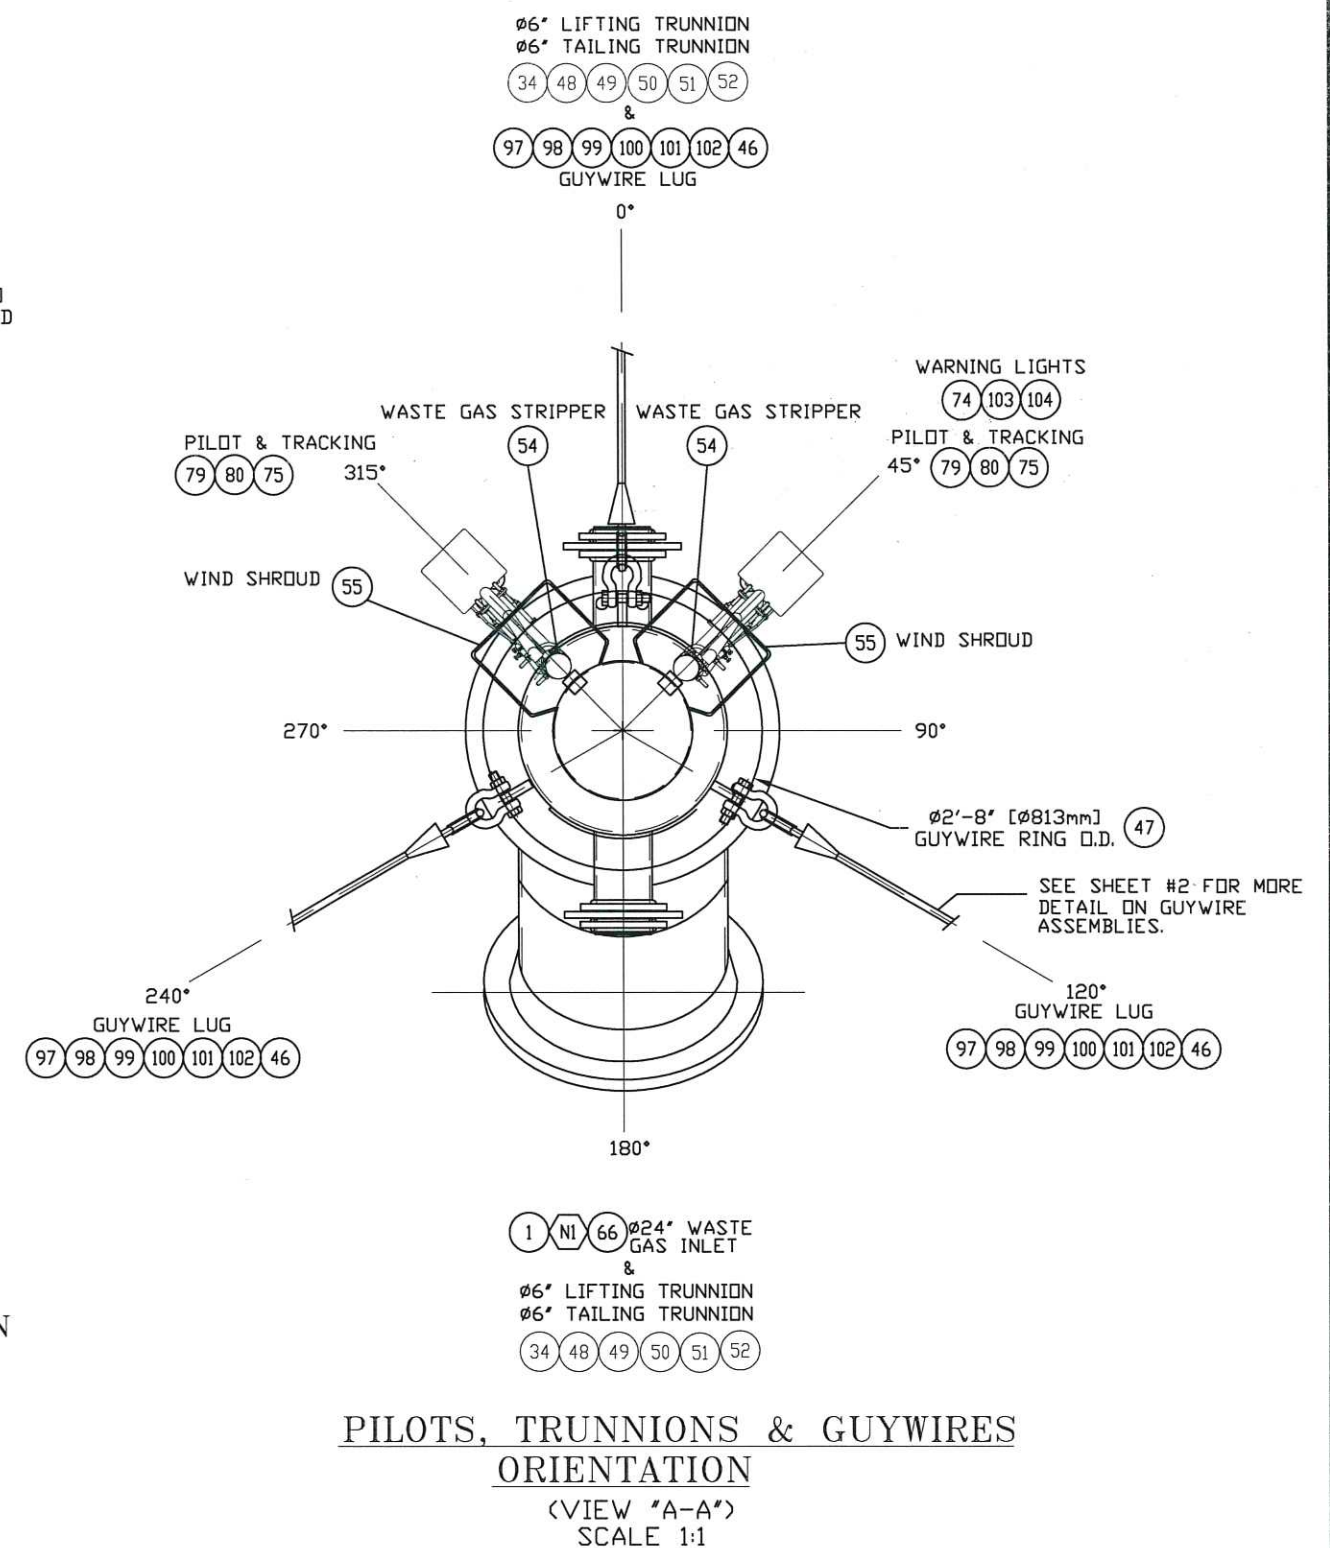

																																																																																																																																																																																																																																																																																																																																																																																																																																																																																																																																																																																																																																																																																																																																																																																																																																																																																																																																																																																																																																																																																																																																																																																																																																																																																																																																																																																																																					</
--	--	----

VENDOR DWG. CONTROL		
GEMINI CALGARY, ALBERTA		DATE
		JUN 07 2012
JOB No.	P.O. #	SUB #
G 11124.100		1




☒ APPROVED FOR CONSTRUCTION
☐ APPROVED AS NOTED. MAKE CHANGES NOTED AND ISSUE FOR CONSTRUCTION
☐ NOT APPROVED. MAKE CHANGES NOTED AND RESUBMIT FOR APPROVAL
BY: Brent Robinson
DATE: 14 June 2012
GEMINI

GEMINI				
Order	Discipline	To	Date	Initials
	Project Engineer		12 June 12	SM
	Mech Piping Eng		13 June 12	ES
	Mech Piping/Design	Rob C	June 14	RLC
	Civil Eng	T. Stein	12 June 12	TS
	Civil Design			
	Process	S N-A	14 June 12	Ruy
	Instru-mentation		12/6/12	RH
	Electrical	JWF	12/6/12	JF
	Controls			
	Inspection/QA			
	Project Manager		14 June 12	RP

INTERDISCIPLINARY REVIEW

☒ FOR APPROVAL	☐ FOR INFORMATION
RETURN TO	DATE REQUIRED: JUN 14 2012
☒ VENDOR	
☐ FILE	
☐	

MASTER VENDOR
PRINT

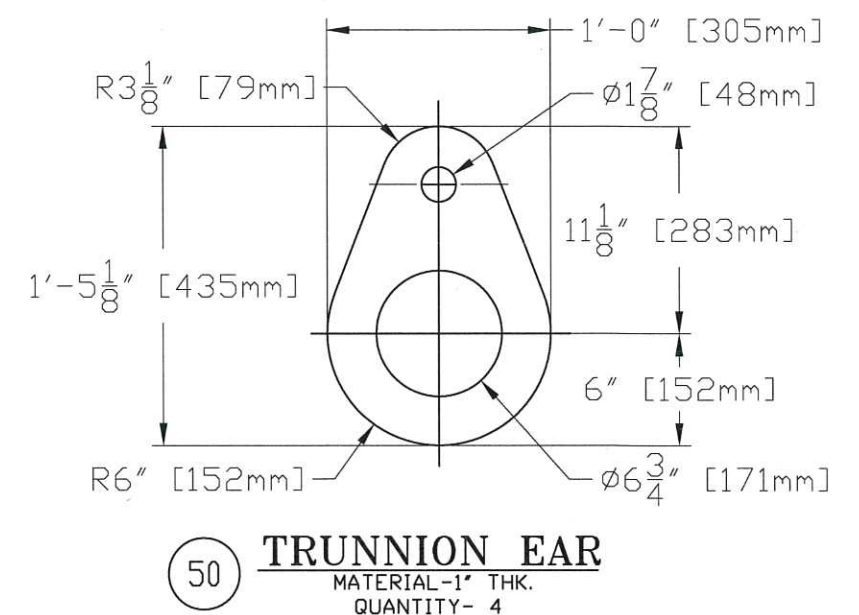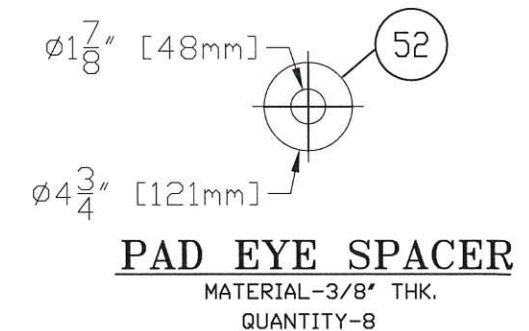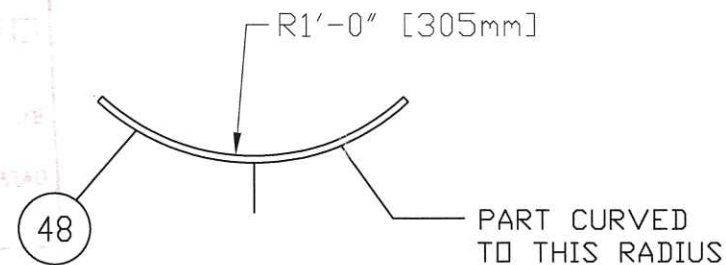[illegible]

MASTER VENDOR
PRINT

VENDOR DWG. CONTROL		
GEMINI CALGARY, ALBERTA		DATE JUN 07 2012
JOB No. G 11124.100	P.O. #	SUB # 1

☒ APPROVED FOR CONSTRUCTION
☐ APPROVED AS NOTED. MAKE CHANGES NOTED AND ISSUE FOR CONSTRUCTION
☐ NOT APPROVED. MAKE CHANGES NOTED AND RESUBMIT FOR APPROVAL
BY: <u>Brian Robinson</u>
DATE: <u>14 June 10</u>
GEMINI

GEMINI				
Order	Discipline	To	Date	Initials
	Project Engineer		<u>June 11</u>	<u>SR</u>
	Mech Piping Eng		<u>13 June 12</u>	<u>GS</u>
	Mech Piping/Design	<u>Rob L</u>	<u>June 14</u>	<u>RIC</u>
	Civil Eng	<u>T. Stein</u>	<u>12 June 12</u>	<u>TS</u>
	Civil Design			
	Process	<u>SN-A</u>	<u>14 June 12</u>	<u>SN</u>
	Instrumentation		<u>12/6/12</u>	<u>KM</u>
	Electrical	<u>JNF</u>	<u>12/06/09</u>	<u>JNF</u>
	Controls			
	Inspection / QA			
	Project Manager		<u>14 June 12</u>	<u>BR</u>

INTERDISCIPLINARY REVIEW


☒ FOR APPROVAL ☐ FOR INFORMATION
RETURN TO ☒ VENDOR ☐ FILE
DATE REQUIRED: JUN 14 2012

NOTE:

THE TRUNNION EAR MUST BE ABLE TO
ROTATE FREELY ON THE TRUNNION
EXTENSION.

- TWO TRUNNIONS ARE REQUIRED AT ANY ONE LIFTING/TAILING ELEVATION
- ATTACHMENT HAS BEEN DESIGNED TO ACCEPT A 1-1/2" NOMINAL SIZE CROSBY G209/G2130 SHACKLE AND VERTICAL SLINGS (SPREADER BEAM OR FRAME REQUIRED)
- THE LIFTING APPURTENANCE HAS BEEN DESIGNED TO TAKE ZERO (0) SIDE LOADING DUE TO USE OF A SPREADER BAR. PLEASE CONSULT TORNADO IF ADDITIONAL SIDE LOADING IS REQUIRED.

MASTER VENDOR PRINT

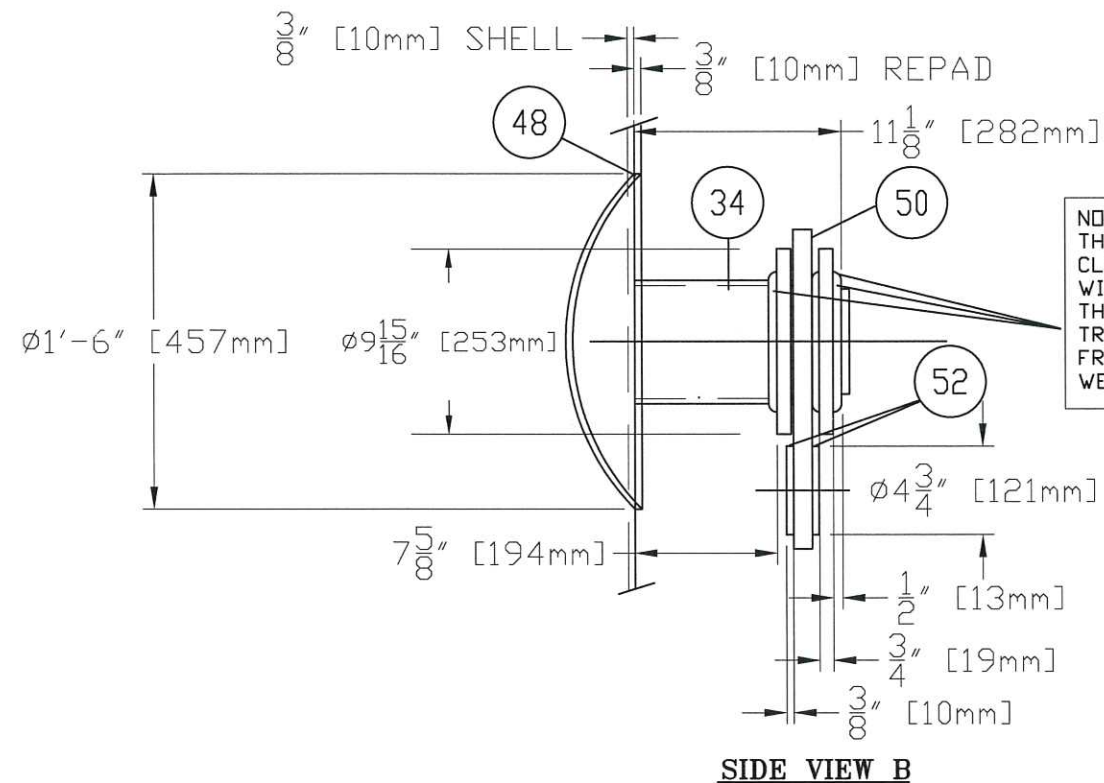

NOTE:
THE TRUNNION STOP
CLOSEST TO THE STACK
WILL BE WELDED ONLY ON
THE STACK SIDE. THE
TRUNNION STOP FURTHEST
FROM THE STACK MUST BE
WELDED ON BOTH SIDES.

[illegible]

RECEIVED AFTER VENDOR
PRINT

VENDOR DWG. CONTROL		
GEMINI CALGARY, ALBERTA		DATE JUN 07 2012
JOB No.	P.O. #	SUB #
G 11124.100		1

☒ APPROVED FOR CONSTRUCTION
☐ APPROVED AS NOTED. MAKE CHANGES NOTED AND
ISSUE FOR CONSTRUCTION
☐ NOT APPROVED. MAKE CHANGES NOTED AND
RESUBMIT FOR APPROVAL

BY: *BRAND ROBINSON*
DATE: 14 JUNE 2012

GEMINI

GEMINI				
Order	Discipline	To	Date	Initials
	Project Engineer		June 14/12	ER
	Mech Piping Eng		13 June 12	E.S.
	Mech Piping Design	Rob L	June 14	RLC
	Civil Eng	T. Stein	12 June 12	TS
	Civil Design			
	Process	S.N-A	14 June 12	SN
	Instru-mentation		12/6/12	RM
	Electrical	JF	14/6/12	JF
	Controls			
	Inspection / QA			
	Project Manager		14 June 12	BR

☒ FOR APPROVAL ☐ FOR INFORMATION
RETURN TO DATE REQUIRED: JUN 14 2012

☒ VENDOR
☐ FILE
☐

INTERDISCIPLINARY REVIEW