


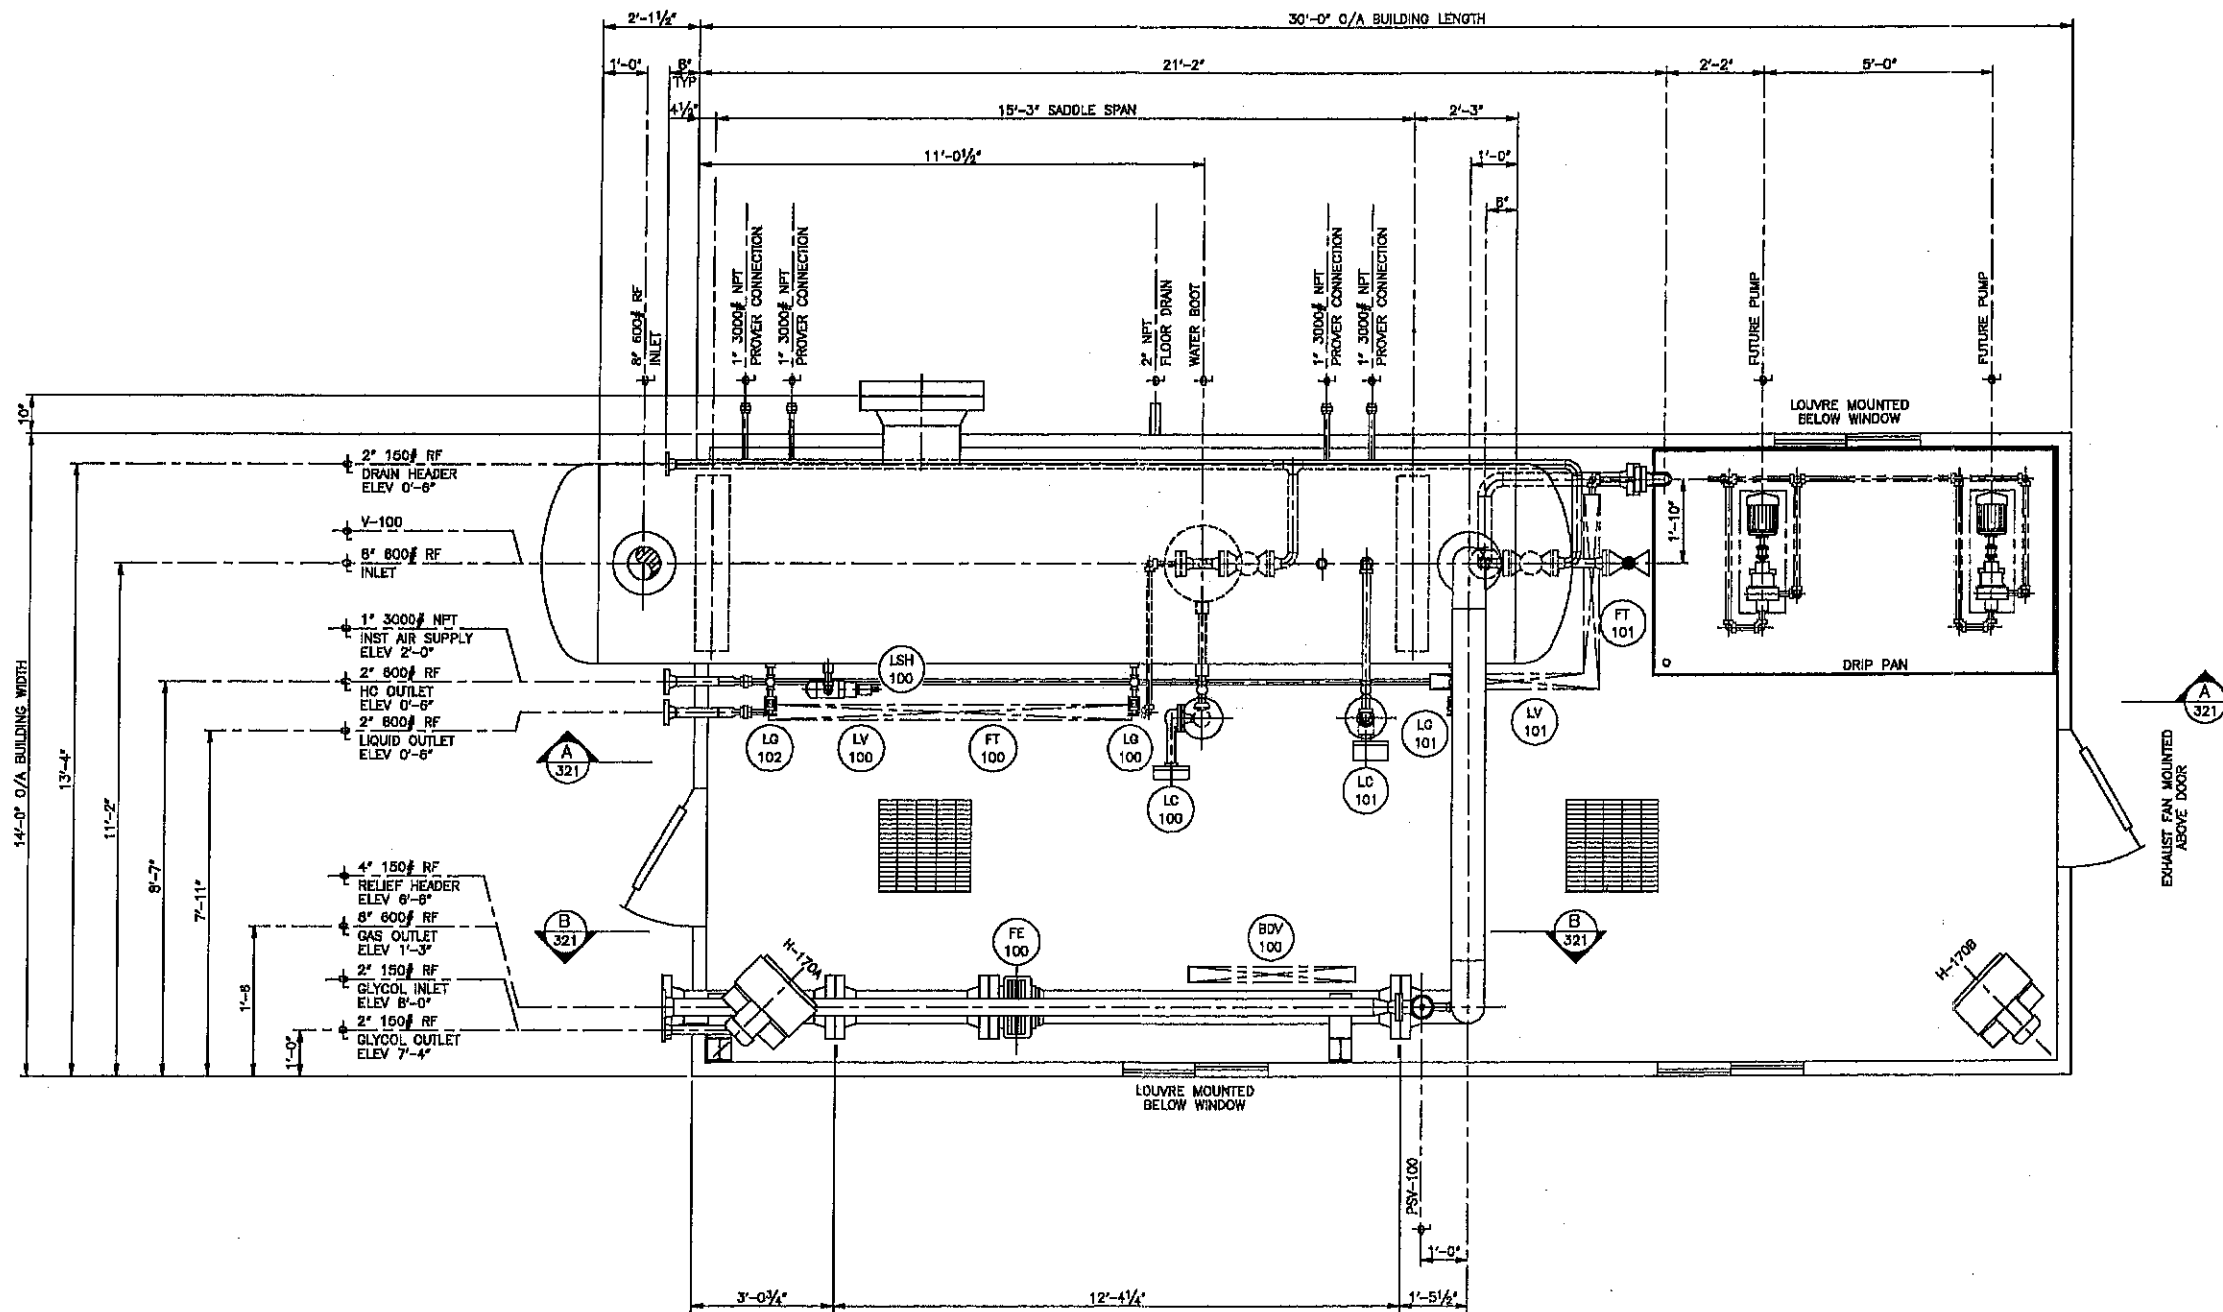

NOTES:

1. ALL PIPING MATERIAL, INSPECTION AND FINISHES TO BE AS PER INSTRUMENT LIST.
2. FINAL ROUTING OF ALL PIPING SMALLER THAN 2" TO BE DETERMINED BY SHOP.
3. ELEVATIONS SHOWN ARE FROM TOP OF CHECKER PLATE; REF. ELEV. 0'-00".
4. ESTIMATED WEIGHT: 55,000 lbs (25 000 kg).


NO.	REVISION	BY	CHKD.	DATE
2	AS-BUILT	D.S.		96/05/30
1	CHANGED GLYCOL OUTLET EL FROM 8'-8"	LG		96/02/28
0	ISSUED FOR CONSTRUCTION	LG		96/02/09
A	ISSUED FOR APPROVAL	LG		96/01/30

CUSTOMER REFERENCE	FA960014
 PRESSON MANUFACTURING LTD. ENGINEERING — DESIGN — FABRICATION	


CUSTOMER	ANDERSON OIL AND GAS INC.	JOB NO.	B5828-02
PROJECT	PUSKASKAU GAS PLANT LSD 03-26-74-01 W6M		
TITLE	HORIZONTAL INLET SEPARATOR PACKAGE GENERAL ARRANGEMENT		
DRAWN	LG	CHECKED	APPROVED
SCALE	1/2" = 1'-0"	DATE	96/01/30
DRAWING NUMBER	B5828-320		

H-170A/B
BUILDING HEATERS

--	--	
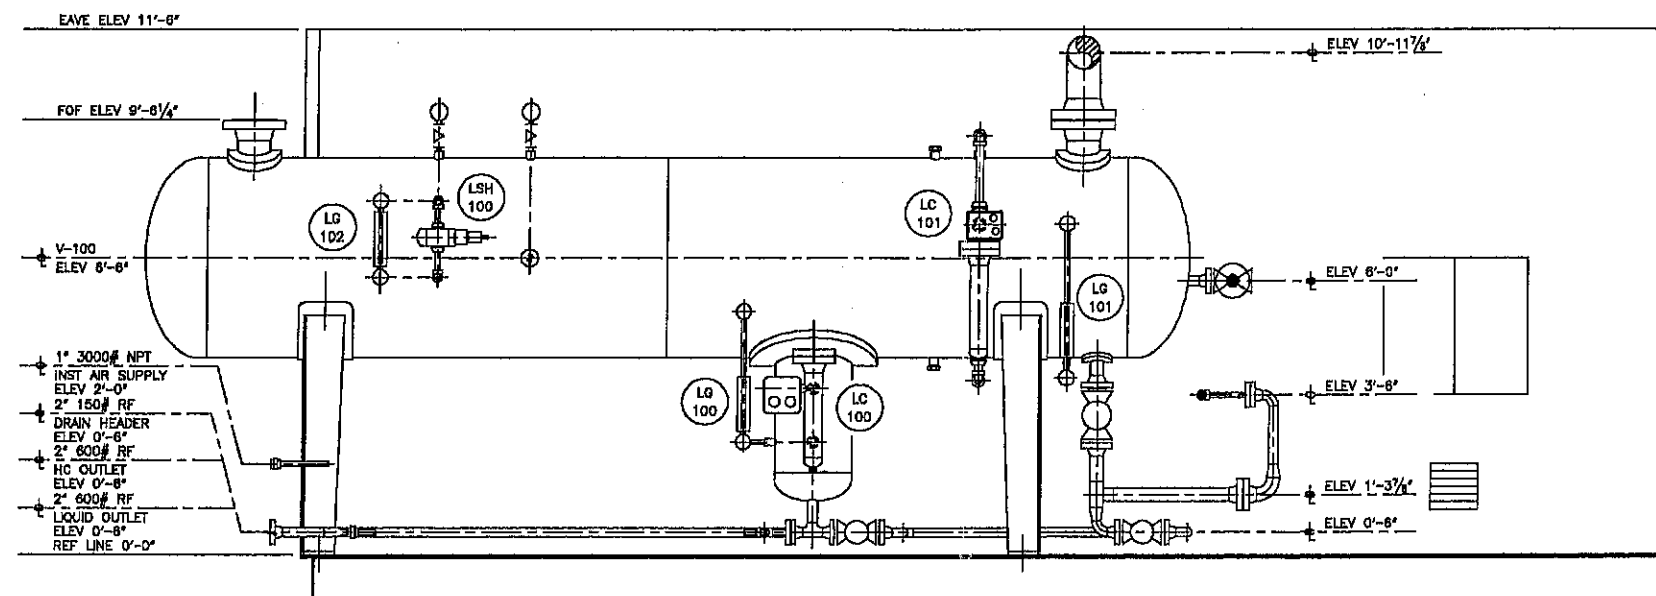

SECTION "A-A"

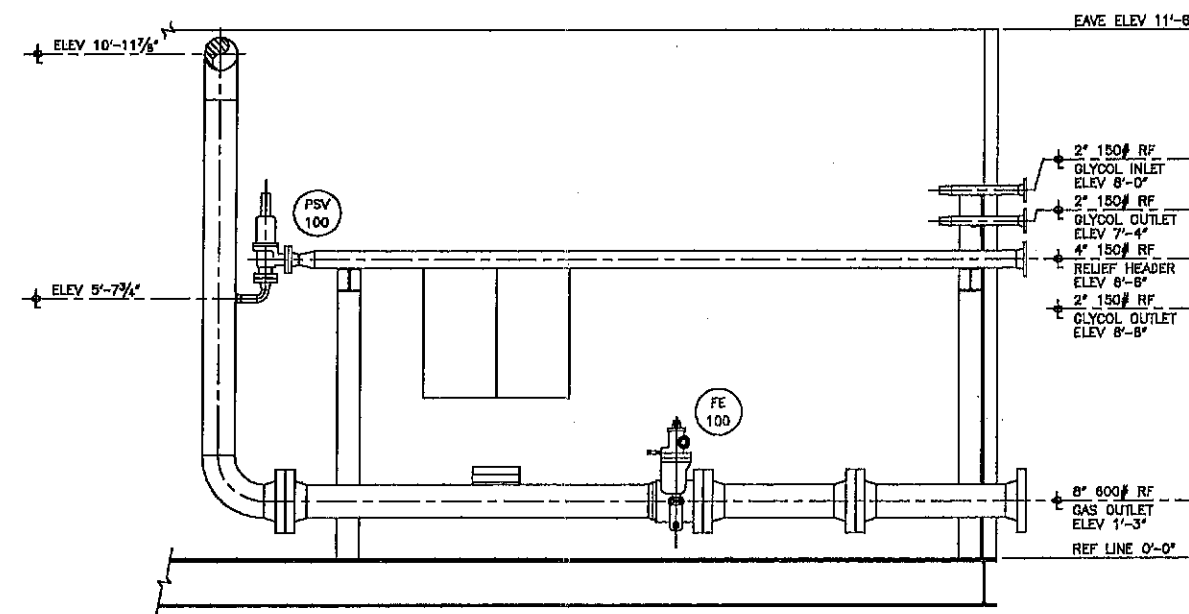

SECTION "B-B"

NOTES:

1. ALL PIPING MATERIAL, INSPECTION AND FINISHES TO BE AS PER INSTRUMENT LIST.
2. FINAL ROUTING OF ALL PIPING SMALLER THAN 2" TO BE DETERMINED BY SHOP.
3. ELEVATIONS SHOWN ARE FROM TOP OF CHECKER PLATE; REF. ELEV. 0'-00".

--	--	
PRESSON
MANUFACTURING LTD.
ENGINEERING — DESIGN — FABRICATION