


TPS DATE: NOV 15, 2001 TIME: 11:31 AM THE INFORMATION CONTAINED HEREIN IS THE CONFIDENTIAL PROPERTY OF TOROMONT PROCESS SYSTEMS AND IS NOT FOR PUBLICATION, AND NO PART THEREOF SHALL BE COPIED OR COMMUNICATED TO A THIRD PARTY WITHOUT AUTHORIZATION FROM TOROMONT PROCESS SYSTEMS

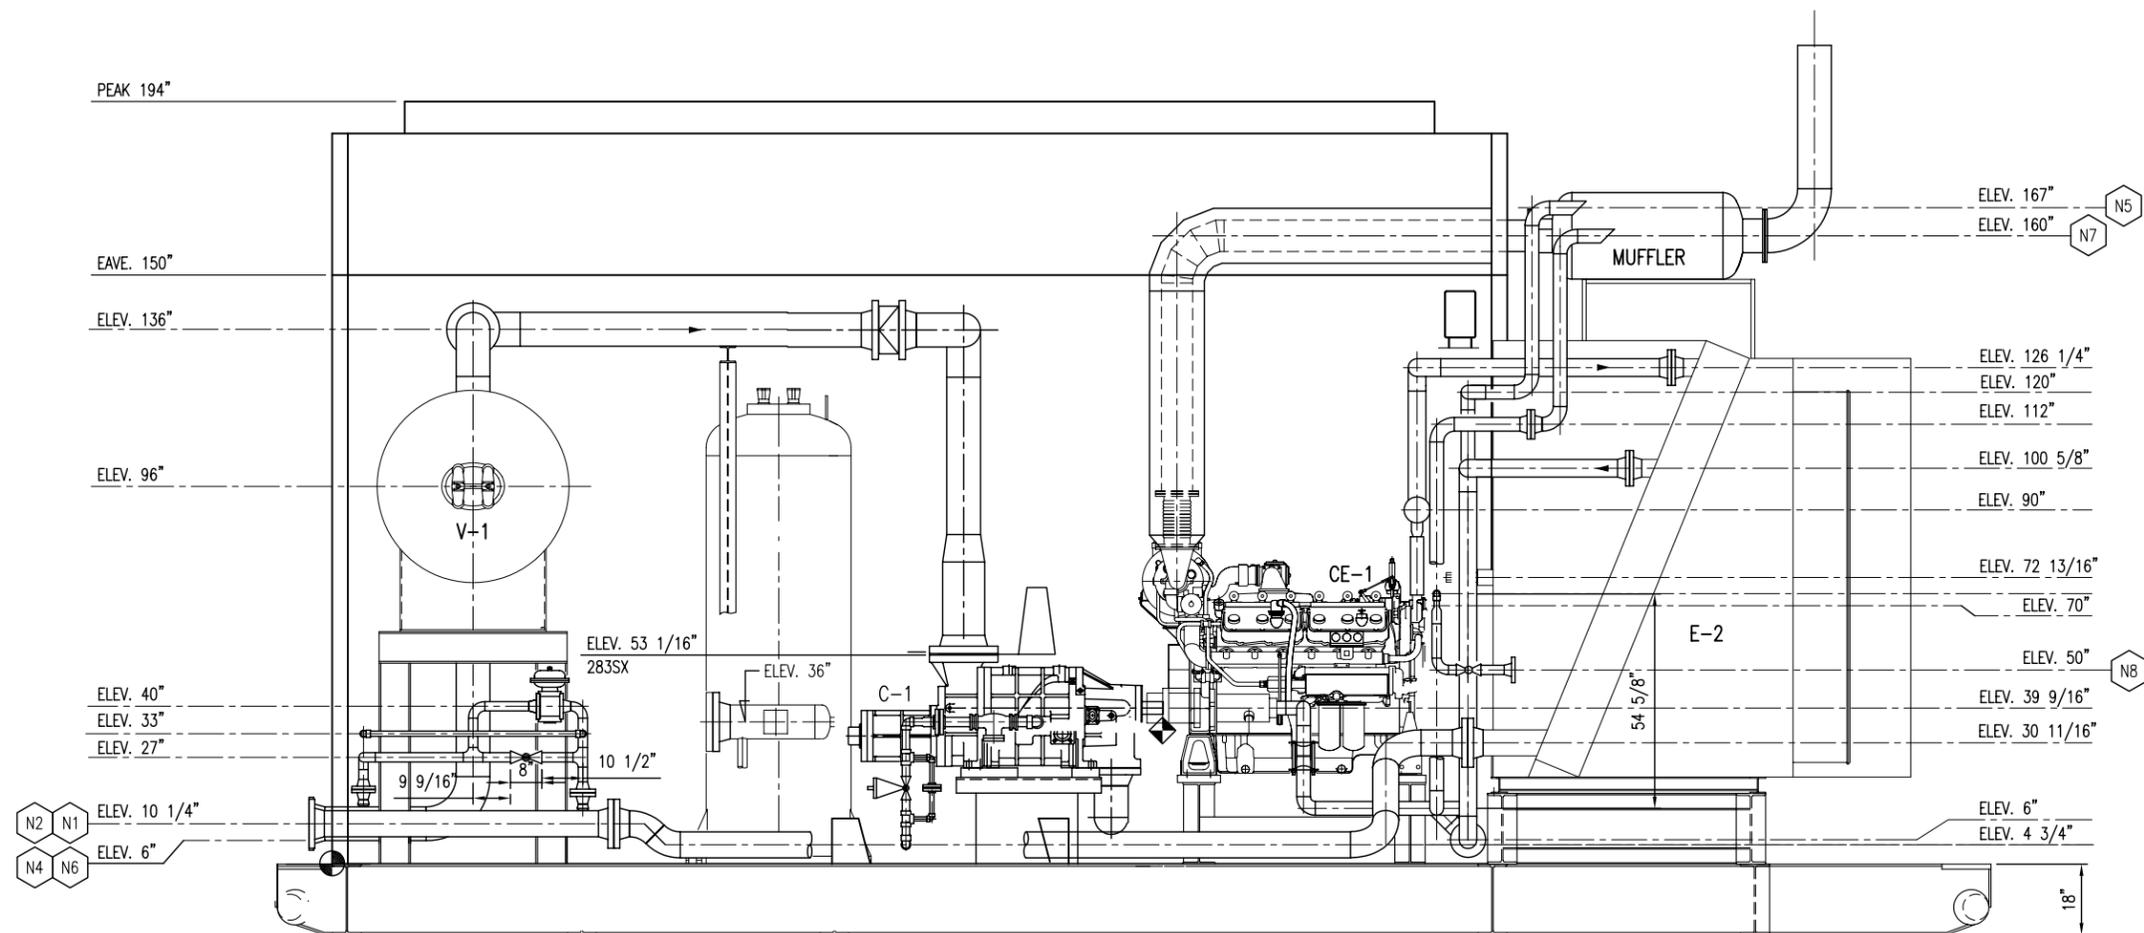

ELEVATION 'A-A'

REV.	DESCRIPTION	DATE	BY	APPR.
2	AS BUILT	OCT.31/01	PN	
1	ISSUED FOR CONSTRUCTION	SEPT.24/01	PN	

PERMIT TO PRACTICE STAMP

ENGINEER STAMP

DRAWN BY: P. NOBLE	DATE: SEPT. 24, 2001
CHKD. BY: R. CALBUREAN	SCALE: 1/2" : 1'-0"
APPR. BY: R. CALBUREAN	W.O. No: 10822201
CUST. PO No:	

TITLE:	ELEVATION
FOR:	ANDERSON EXPLORATION LTD DREAU 600 HP BOOSTER COMPRESSOR LSD: 1-15-78-21 W5M
DWG. No:	10822-201
SHEET No:	2 OF 3
REV:	2