


NOZZLE SCHEDULE				
MARK	SERVICE	SIZE	RATING	TYPE
N1	INLET	8"	150#	RFWN
N2	OUTLET	6"	300#	RFWN
N3	RELIEF HEADER	3"	150#	RFWN
N4	HYDROCARBON DRAIN	1"	3000#	NPT
N5	START GAS VENT	3"	-	-
N6	INSTRUMENT GAS VENT	1"	150#	RFWN
N7	FUEL GAS RELIEF HEADER	3"	150#	RFWN
N8	FUEL GAS SUPPLY	2"	300#	RFWN
N9	SWEET DRY GAS SUPPLY	1"	3000#	UNION
N10	HOT GLYCOL RETURN	2"	150#	RFWN
N11	HOT GLYCOL SUPPLY	2"	150#	RFWN

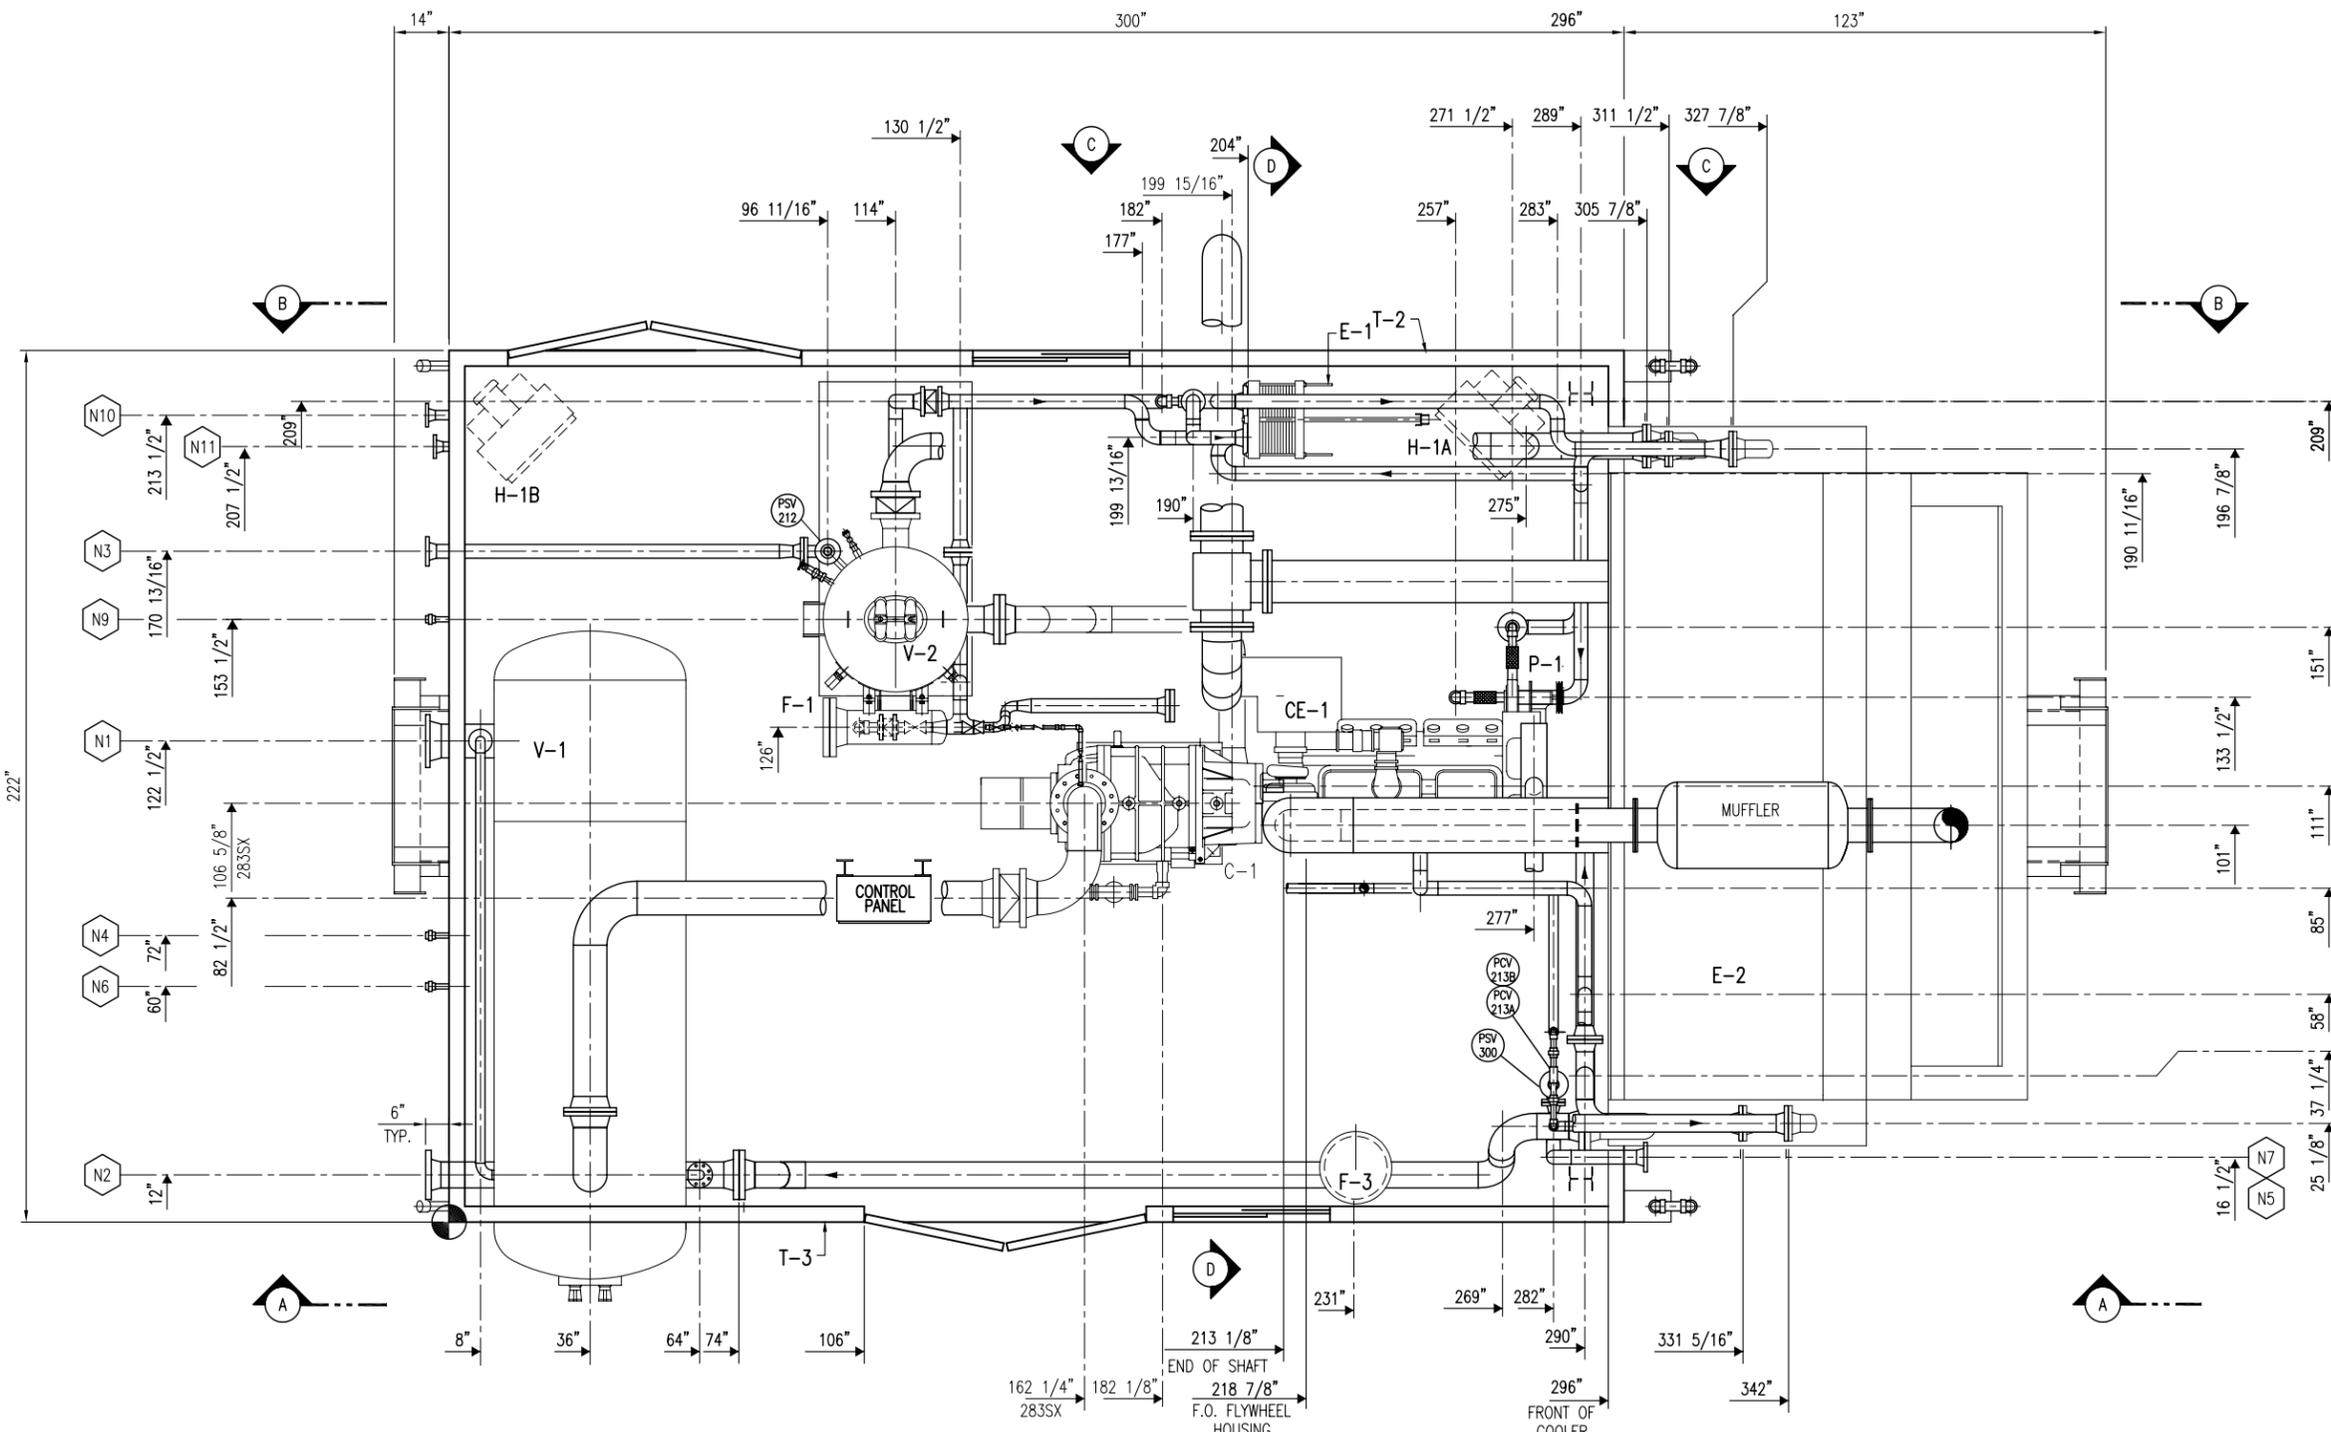

- GENERAL NOTES:**
- ALL TAIL DIMENSIONS FROM REFERENCE POINT.
  - SHIPPING LENGTH: 36'-5"  
SHIPPING WIDTH: 19'-9"  
SHIPPING HEIGHT: 17'-8"
  - SHIPPING WEIGHT: 86070 LBS (NO FLUIDS)
  - OPERATING WEIGHT: 88765 LBS (W/FLUIDS)
  - OVERALL SKID DEPTH: 1'-6 3/16"
  - NOZZLE ELEVATIONS ARE FROM CENTERLINE OF PIPE TO TOP OF CHECKER PLATE REFERENCE POINT.
  - CENTER OF GRAVITY:  
X FROM DATUM: 200"  
Y FROM DATUM: 117"  
Z FROM DATUM: 34"
- X Y  
X Y  
"Z" DIMENSION FROM TOP OF CHECKER PLATE

PLAN VIEW

REV.	DESCRIPTION	DATE	BY	APPR.
2	AS BUILT	OCT.31/01	PN	
1	ISSUED FOR CONSTRUCTION	SEPT.24/01	PN	

PERMIT TO PRACTICE STAMP

ENGINEER STAMP

**TOROMONT**  
TOROMONT PROCESS SYSTEMS

DRAWN BY: P. NOBLE  
DATE: SEPT. 24, 2001  
CHKD. BY: R. CALBUREAN  
SCALE: 1/2" = 1'-0"  
APPR. BY: R. CALBUREAN  
W.O. No: 10822201

TITLE: GENERAL ARRANGEMENT

FOR: ANDERSON EXPLORATION LTD  
DREAU  
600 HP BOOSTER COMPRESSOR  
LSD: 1-15-78-21 W5M

DWG. No: 10822-201  
SHEET No: 1 OF 3  
REV: 2

TPS DATE: NOV 15, 2001 TIME: 11:30 AM THE INFORMATION CONTAINED HEREIN IS THE CONFIDENTIAL PROPERTY OF TOROMONT PROCESS SYSTEMS AND IS NOT FOR PUBLICATION, AND NO PART THEREOF SHALL BE COPIED OR COMMUNICATED TO A THIRD PARTY WITHOUT AUTHORIZATION FROM TOROMONT PROCESS SYSTEMS