


THE INFORMATION CONTAINED HEREIN IS THE CONFIDENTIAL PROPERTY OF TOROMONT PROCESS SYSTEMS AND IS NOT FOR PUBLICATION, AND NO PART THEREOF SHALL BE COPIED OR COMMUNICATED TO A THIRD PARTY WITHOUT AUTHORIZATION FROM TOROMONT PROCESS SYSTEMS.

- F-2 FUEL GAS FILTER**  
 TYPE: HEADLINE  
 MODEL: 680-A-1"  
 SIZE: 4" OD X 12" S/F  
 MAWP: 230 PSIG @ 250 DEG.F  
 SHELL MATERIAL: ALUMINUM  
 HEAD MATERIAL: ALUMINUM  
 ELEMENT: 38-152-70C  
 WEIGHT: 10 LBS
- P-2 ENGINE PRE-LUBE PUMP**  
 MAKE: WILDEN  
 MODEL: M1/AYY2/BN/BN/ABN  
 INLET GAS PRESSURE: 100 PSIG MAX.  
 FLOW: 5 GPM @ 20 PSIG  
 FLUID: SAE-40 LUBE OIL  
 WEIGHT: 22 LBS
- CE-1 NATURAL GAS ENGINE**  
 TYPE: CATERPILLAR 3412TA  
 BORE: 5.4"  
 STROKE: 6"  
 DISPLACEMENT: 1649 CU.IN  
 COMPRESSION RATIO: 10 : 1  
 SPEED RANGE: 1400-1800 RPM  
 BHP (RATED): 600 HP @ 1800 RPM  
 WEIGHT: 4720 LBS.
- F-3 ENGINE AUXILIARY OIL FILTER**  
 MAKE: CATERPILLAR  
 MODEL#: 4P2781
- T-1A/B/C GLYCOL SURGE/OIL DAY TANK**  
 SIZE: 12" X 8" X 228 LG  
 T-1A VOL: 20 GALLONS  
 T-1B VOL: 23 GALLONS  
 T-1C VOL: 39 GALLONS
- P-1 GLYCOL CIRCULATION PUMP**  
 MAKE: PRICE  
 MODEL: CD150A1 1 1/2" X 2" X 5"  
 IMPELLER SIZE: FULL SIZED  
 PRESSURE: 45 FT. HEAD  
 FLOW: 164 GPM  
 FLUID: 50/50 GLYCOL  
 OPERATING SPEED: 3500 RPM  
 POWER DRAW: 3.5 HP  
 WEIGHT: 85 LBS
- E-2 COMPRESSOR AFTERCOOLER/OIL COOLER/GLYCOL COOLER**  
 TYPE: AIR-X-CHANGER  
 MODEL: 96 AEH  
 AFTERCOOLER COIL: MAWP: 350 PSI @ 300 DEG.F  
 MDMT: -20 DEG.F @ 350 PSIG  
 DUTY: 348100 BTU/HR  
 GLYCOL COIL: MAWP: 14 PSI @ 300 DEG.F  
 DUTY: 1955500 BTU/HR  
 GLYCOL COIL: MAWP: 14 PSI @ 300 DEG.F  
 DUTY: 1200400 BTU/HR  
 FAN: MOORE-33ED  
 FAN SPEED: 477 RPM  
 TOTAL AIR FLOW: 83149 SCFM  
 POWER DRAW: 22.5 HP  
 WEIGHT: 8774 LBS.

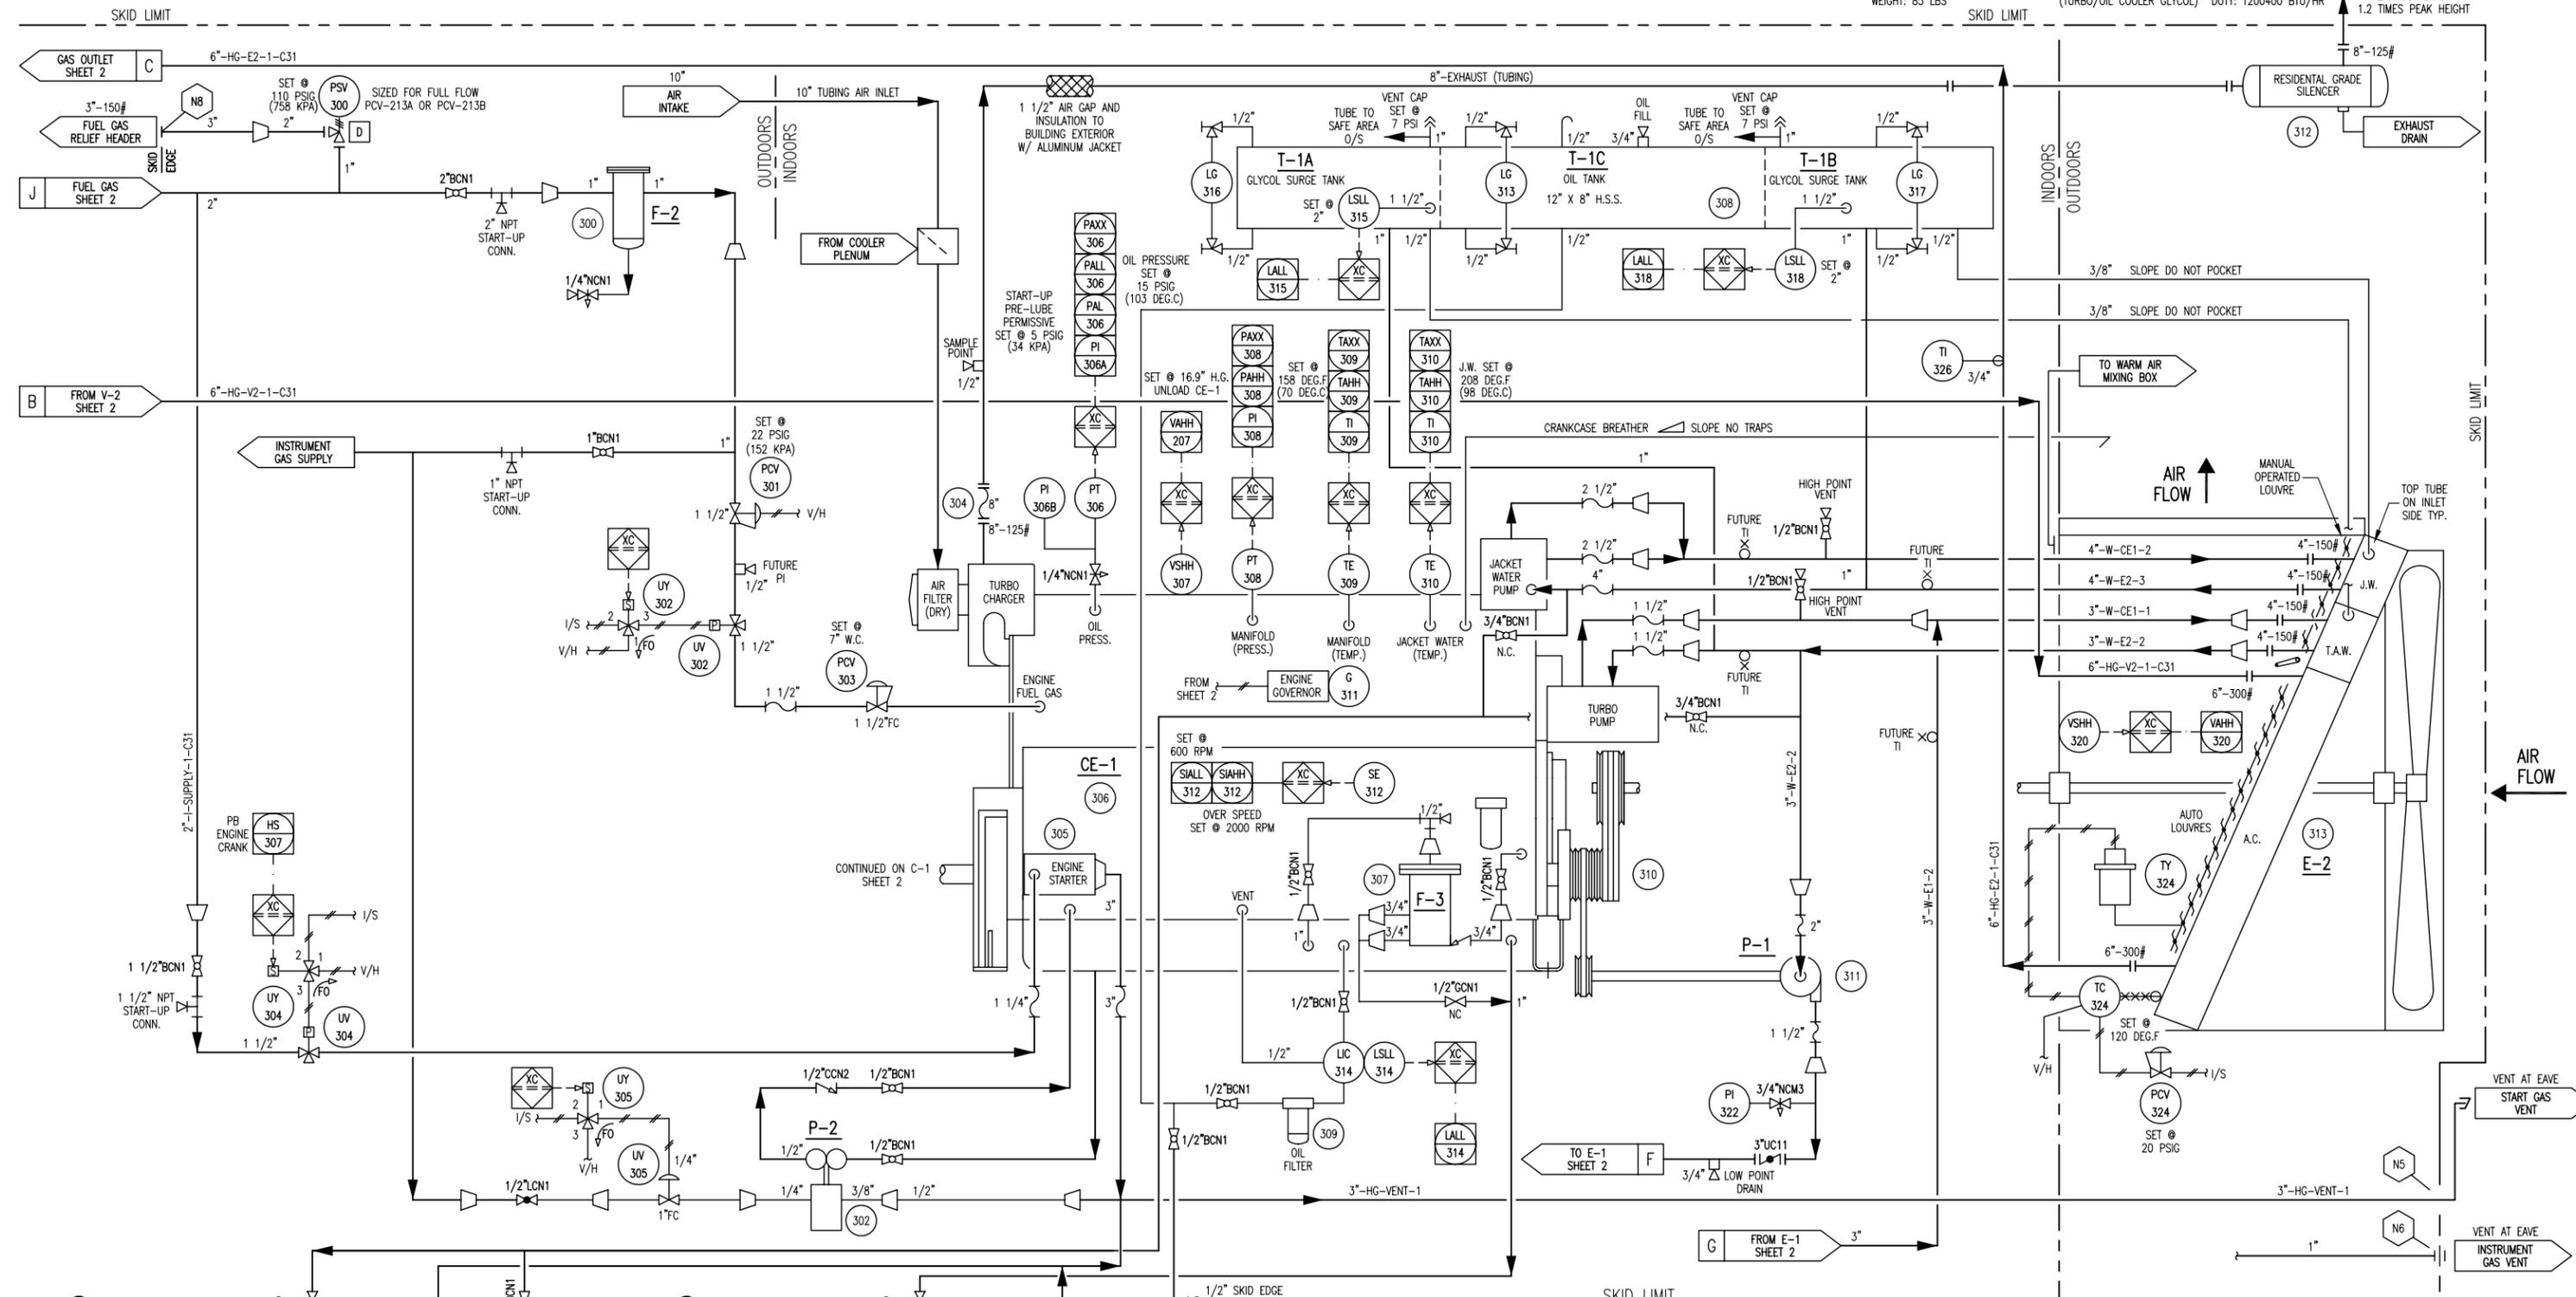

NEXT AVAILABLE TAG NUMBER: 334				TITLE: P & I FLOW DIAGRAM																					
DRAWN BY: P. NOBLE		DATE: SEPT. 4, 2001		FOR: ANDERSON EXPLORATION LTD.																					
CHKD. BY: R. CALBUREAN		SCALE: N/A		600 HP BOOSTER COMPRESSOR DREAU																					
APPR. BY: R. CALBUREAN		W.O. No: 10822101		LSD: 1-15-78-21 W5M																					
CUST. PO No:		DWG. No: 10822-101		SHEET No: 3 OF 4																					
<table border="1" style="width: 100%; border-collapse: collapse;"> <thead> <tr> <th>REV.</th> <th>DESCRIPTION</th> <th>DATE</th> <th>BY</th> <th>APPR.</th> </tr> </thead> <tbody> <tr> <td>3</td> <td>AS BUILT</td> <td>NOV.15/01</td> <td>PN</td> <td></td> </tr> <tr> <td>2</td> <td>ADDED TRANSFER PUMPS, WARM AIR MIXING BOX</td> <td>OCT 24/01</td> <td>PN</td> <td>RC</td> </tr> <tr> <td>1</td> <td>ISSUED FOR CONSTRUCTION</td> <td>SEPT.4/01</td> <td>PN</td> <td>RC</td> </tr> </tbody> </table>		REV.	DESCRIPTION	DATE	BY	APPR.	3	AS BUILT	NOV.15/01	PN		2	ADDED TRANSFER PUMPS, WARM AIR MIXING BOX	OCT 24/01	PN	RC	1	ISSUED FOR CONSTRUCTION	SEPT.4/01	PN	RC	PERMIT TO PRACTICE STAMP ENGINEER STAMP			
REV.	DESCRIPTION	DATE	BY	APPR.																					
3	AS BUILT	NOV.15/01	PN																						
2	ADDED TRANSFER PUMPS, WARM AIR MIXING BOX	OCT 24/01	PN	RC																					
1	ISSUED FOR CONSTRUCTION	SEPT.4/01	PN	RC																					

TPS DATE: NOV. 15, 2001 TIME: 11:28 AM