



TPS DATE: NOV 15, 2001 TIME: 11:32 AM THE INFORMATION CONTAINED HEREIN IS THE CONFIDENTIAL PROPERTY OF TOROMONT PROCESS SYSTEMS AND IS NOT FOR PUBLICATION, AND NO PART THEREOF SHALL BE COPIED OR COMMUNICATED TO A THIRD PARTY WITHOUT AUTHORIZATION FROM TOROMONT PROCESS SYSTEMS

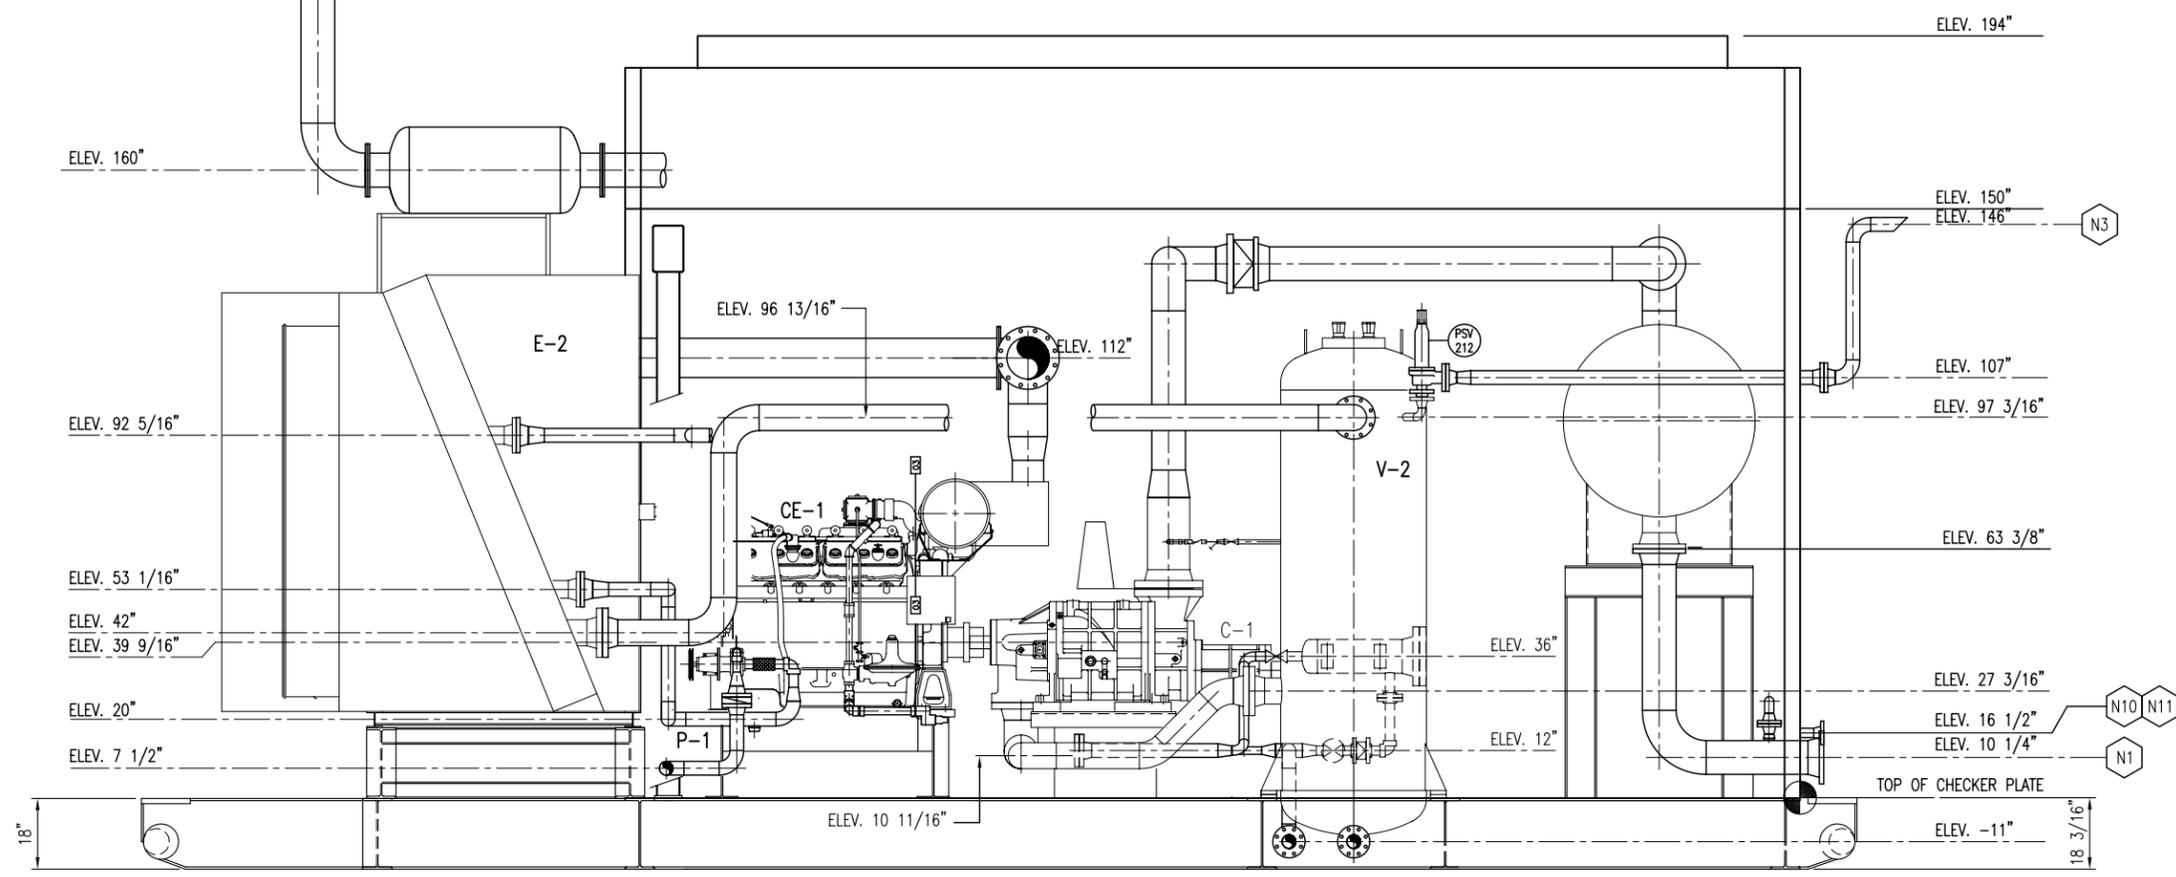

ELEVATION 'B-B'

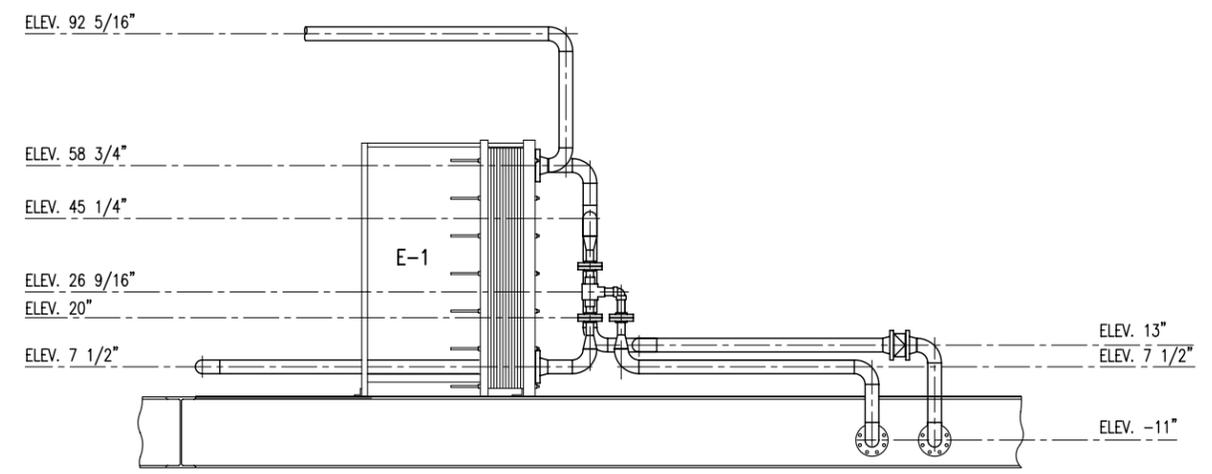

ELEVATION 'C-C'

REV.	DESCRIPTION	DATE	BY	APPR.
2	AS BUILT	OCT.31/01	PN	
1	ISSUED FOR CONSTRUCTION	SEPT.24/01	PN	

PERMIT TO PRACTICE STAMP

ENGINEER STAMP

<b>TOROMONT</b>		<b>TOROMONT PROCESS SYSTEMS</b>	
DRAWN BY: P. NOBLE	DATE: SEPT. 24, 2001	TITLE: ELEVATION	
CHKD. BY: R. CALBUREAN	SCALE: 1/2" : 1'-0"	FOR: ANDERSON EXPLORATION LTD DREAU 600 HP BOOSTER COMPRESSOR LSD: 1-15-78-21 W5M	
APPR. BY: R. CALBUREAN	W.O. No: 10822201	DWG. No: 10822-201	
CUST. PO No:		SHEET No: 3 OF 3	
		REV: 2	