


THIS DRAWING IS THE PROPERTY OF ASPIRE ENERGY RESOURCES LTD. IT MAY NOT BE REPRODUCED WITHOUT THE PERMISSION OF ASPIRE ENERGY RESOURCES LTD.

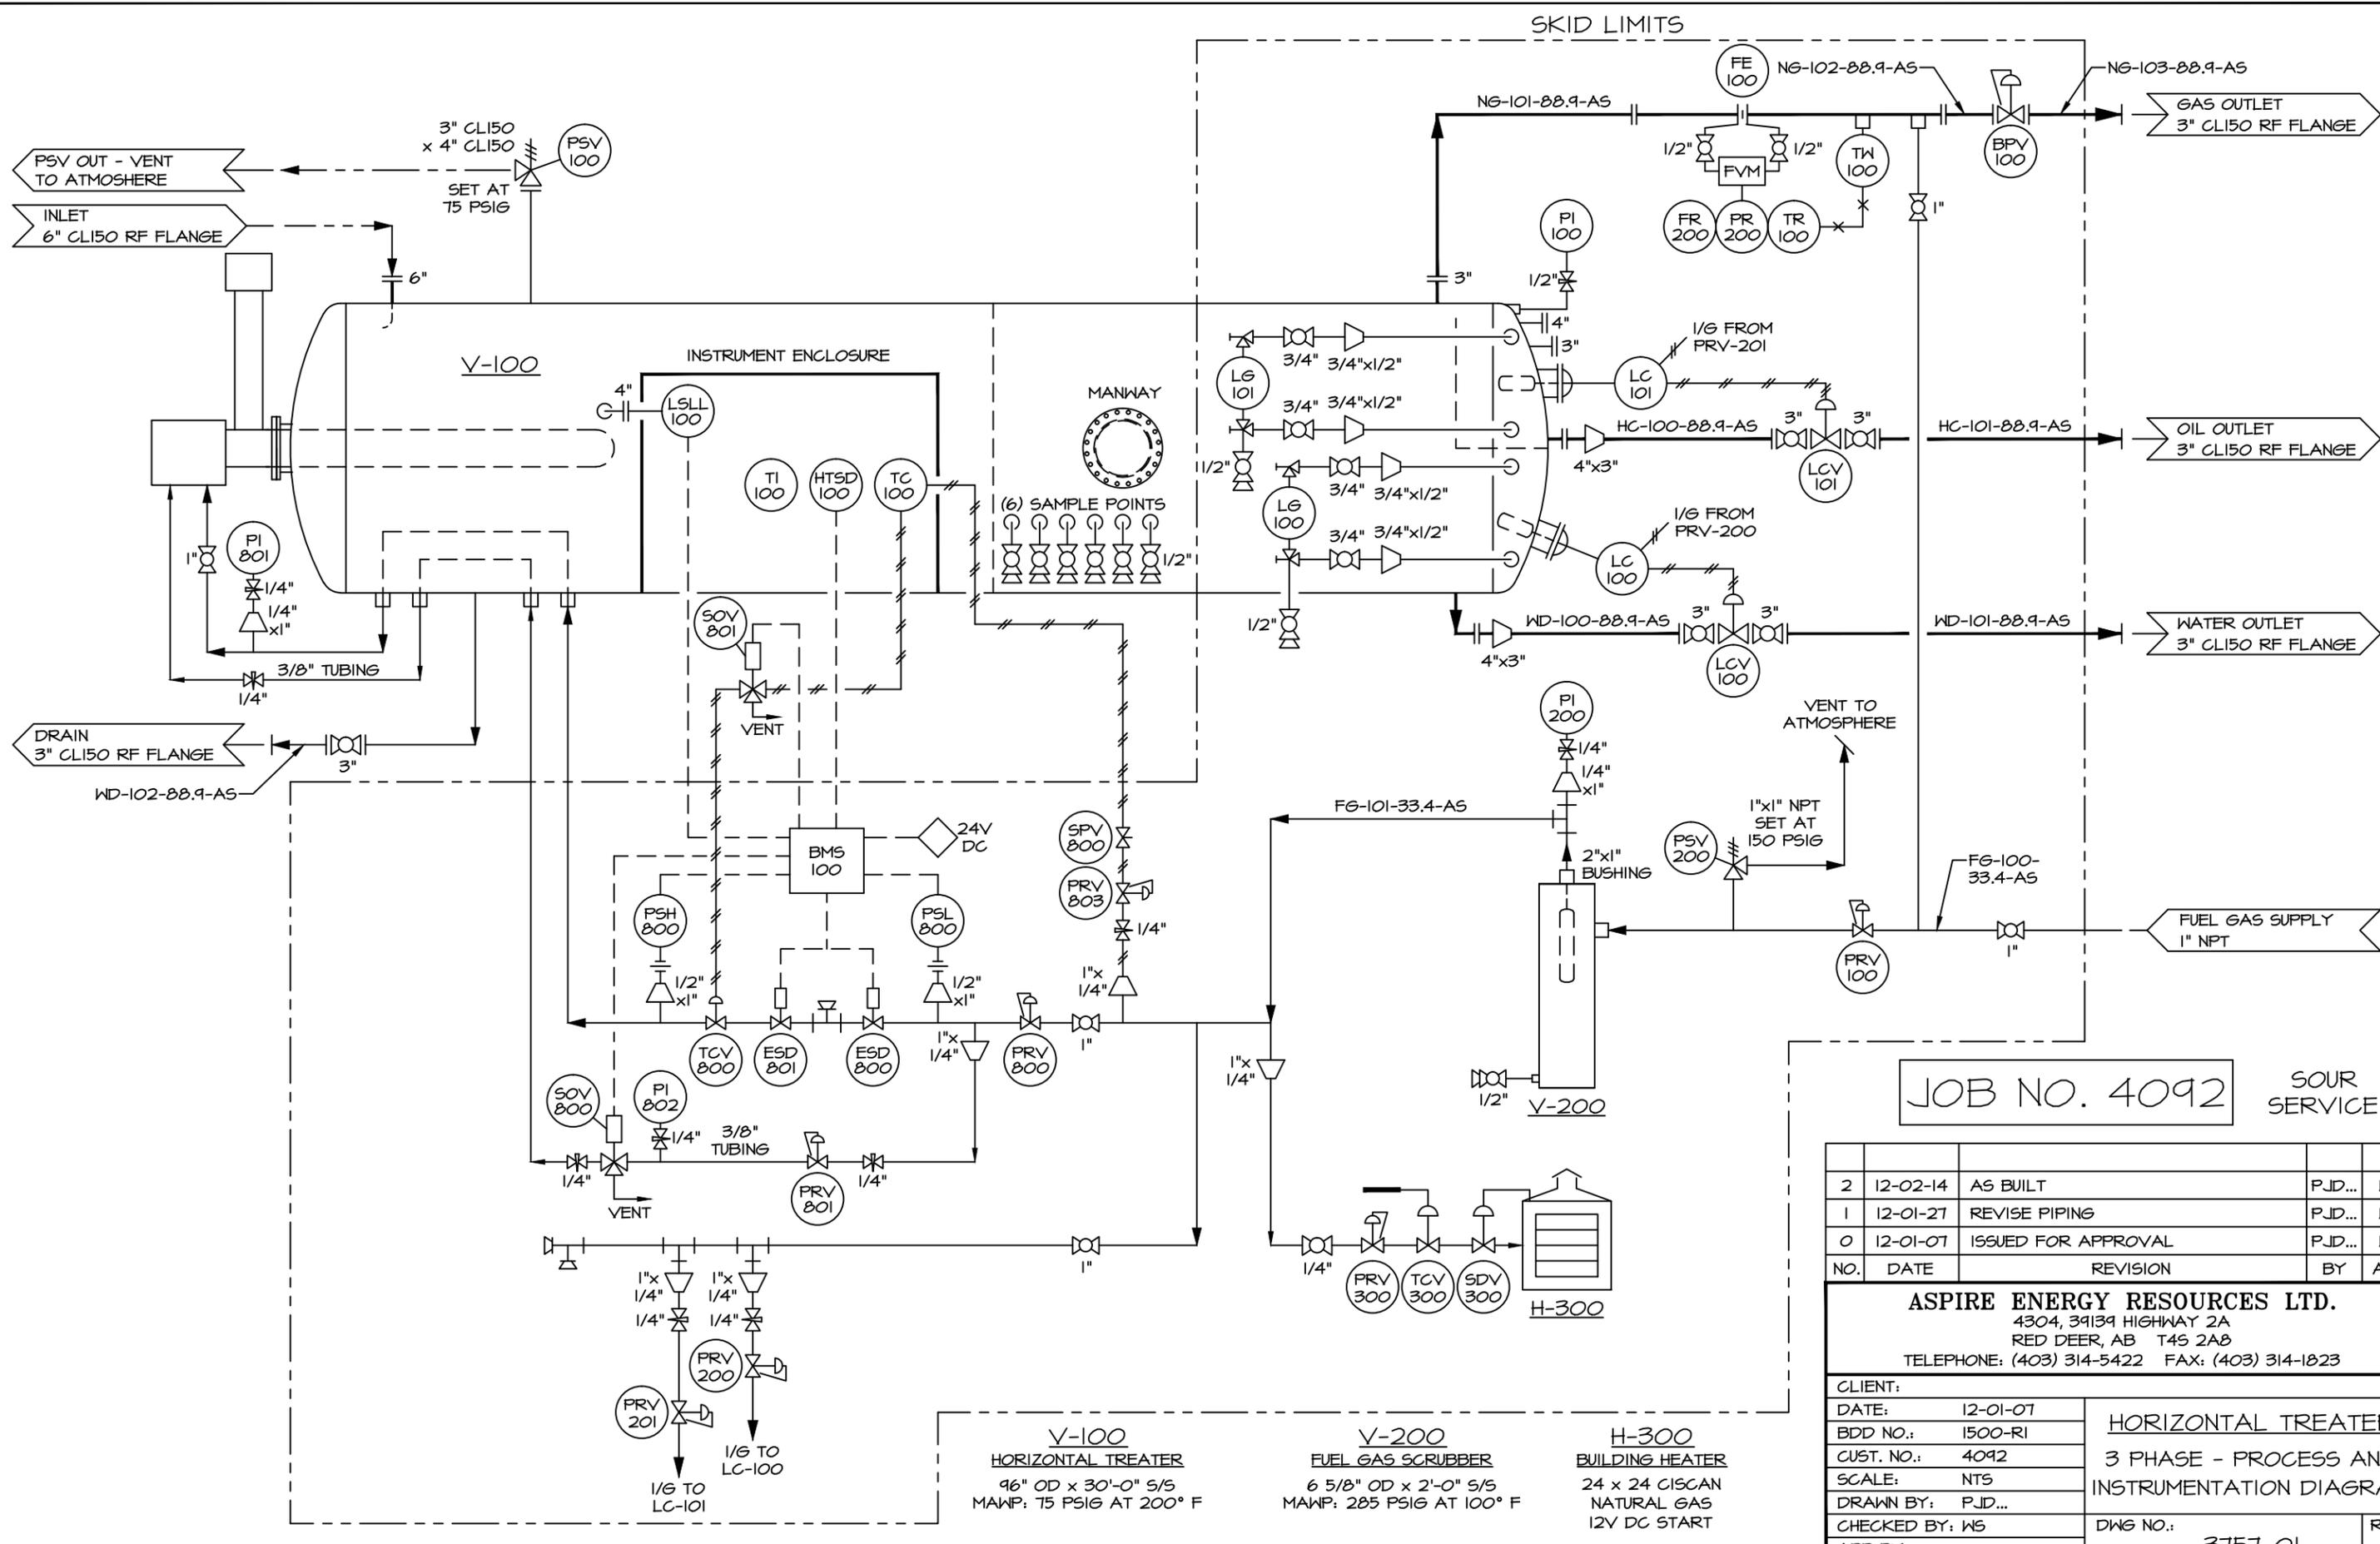

JOB NO. 4092 SOUR SERVICE

NO.	DATE	REVISION	BY	APP
2	12-02-14	AS BUILT	PJD...	WS
1	12-01-27	REVISE PIPING	PJD...	WS
0	12-01-07	ISSUED FOR APPROVAL	PJD...	WS

ASPIRE ENERGY RESOURCES LTD.
 4304, 39139 HIGHWAY 2A
 RED DEER, AB T4S 2A8
 TELEPHONE: (403) 314-5422 FAX: (403) 314-1823

CLIENT:	HORIZONTAL TREATER	
DATE:	12-01-07	3 PHASE - PROCESS AND INSTRUMENTATION DIAGRAM
BDD NO.:	1500-R1	
CUST. NO.:	4092	
SCALE:	NTS	
DRAWN BY:	PJD...	
CHECKED BY:	WS	DWG NO.:
APP BY:		3757-01
		REV.:
		2