


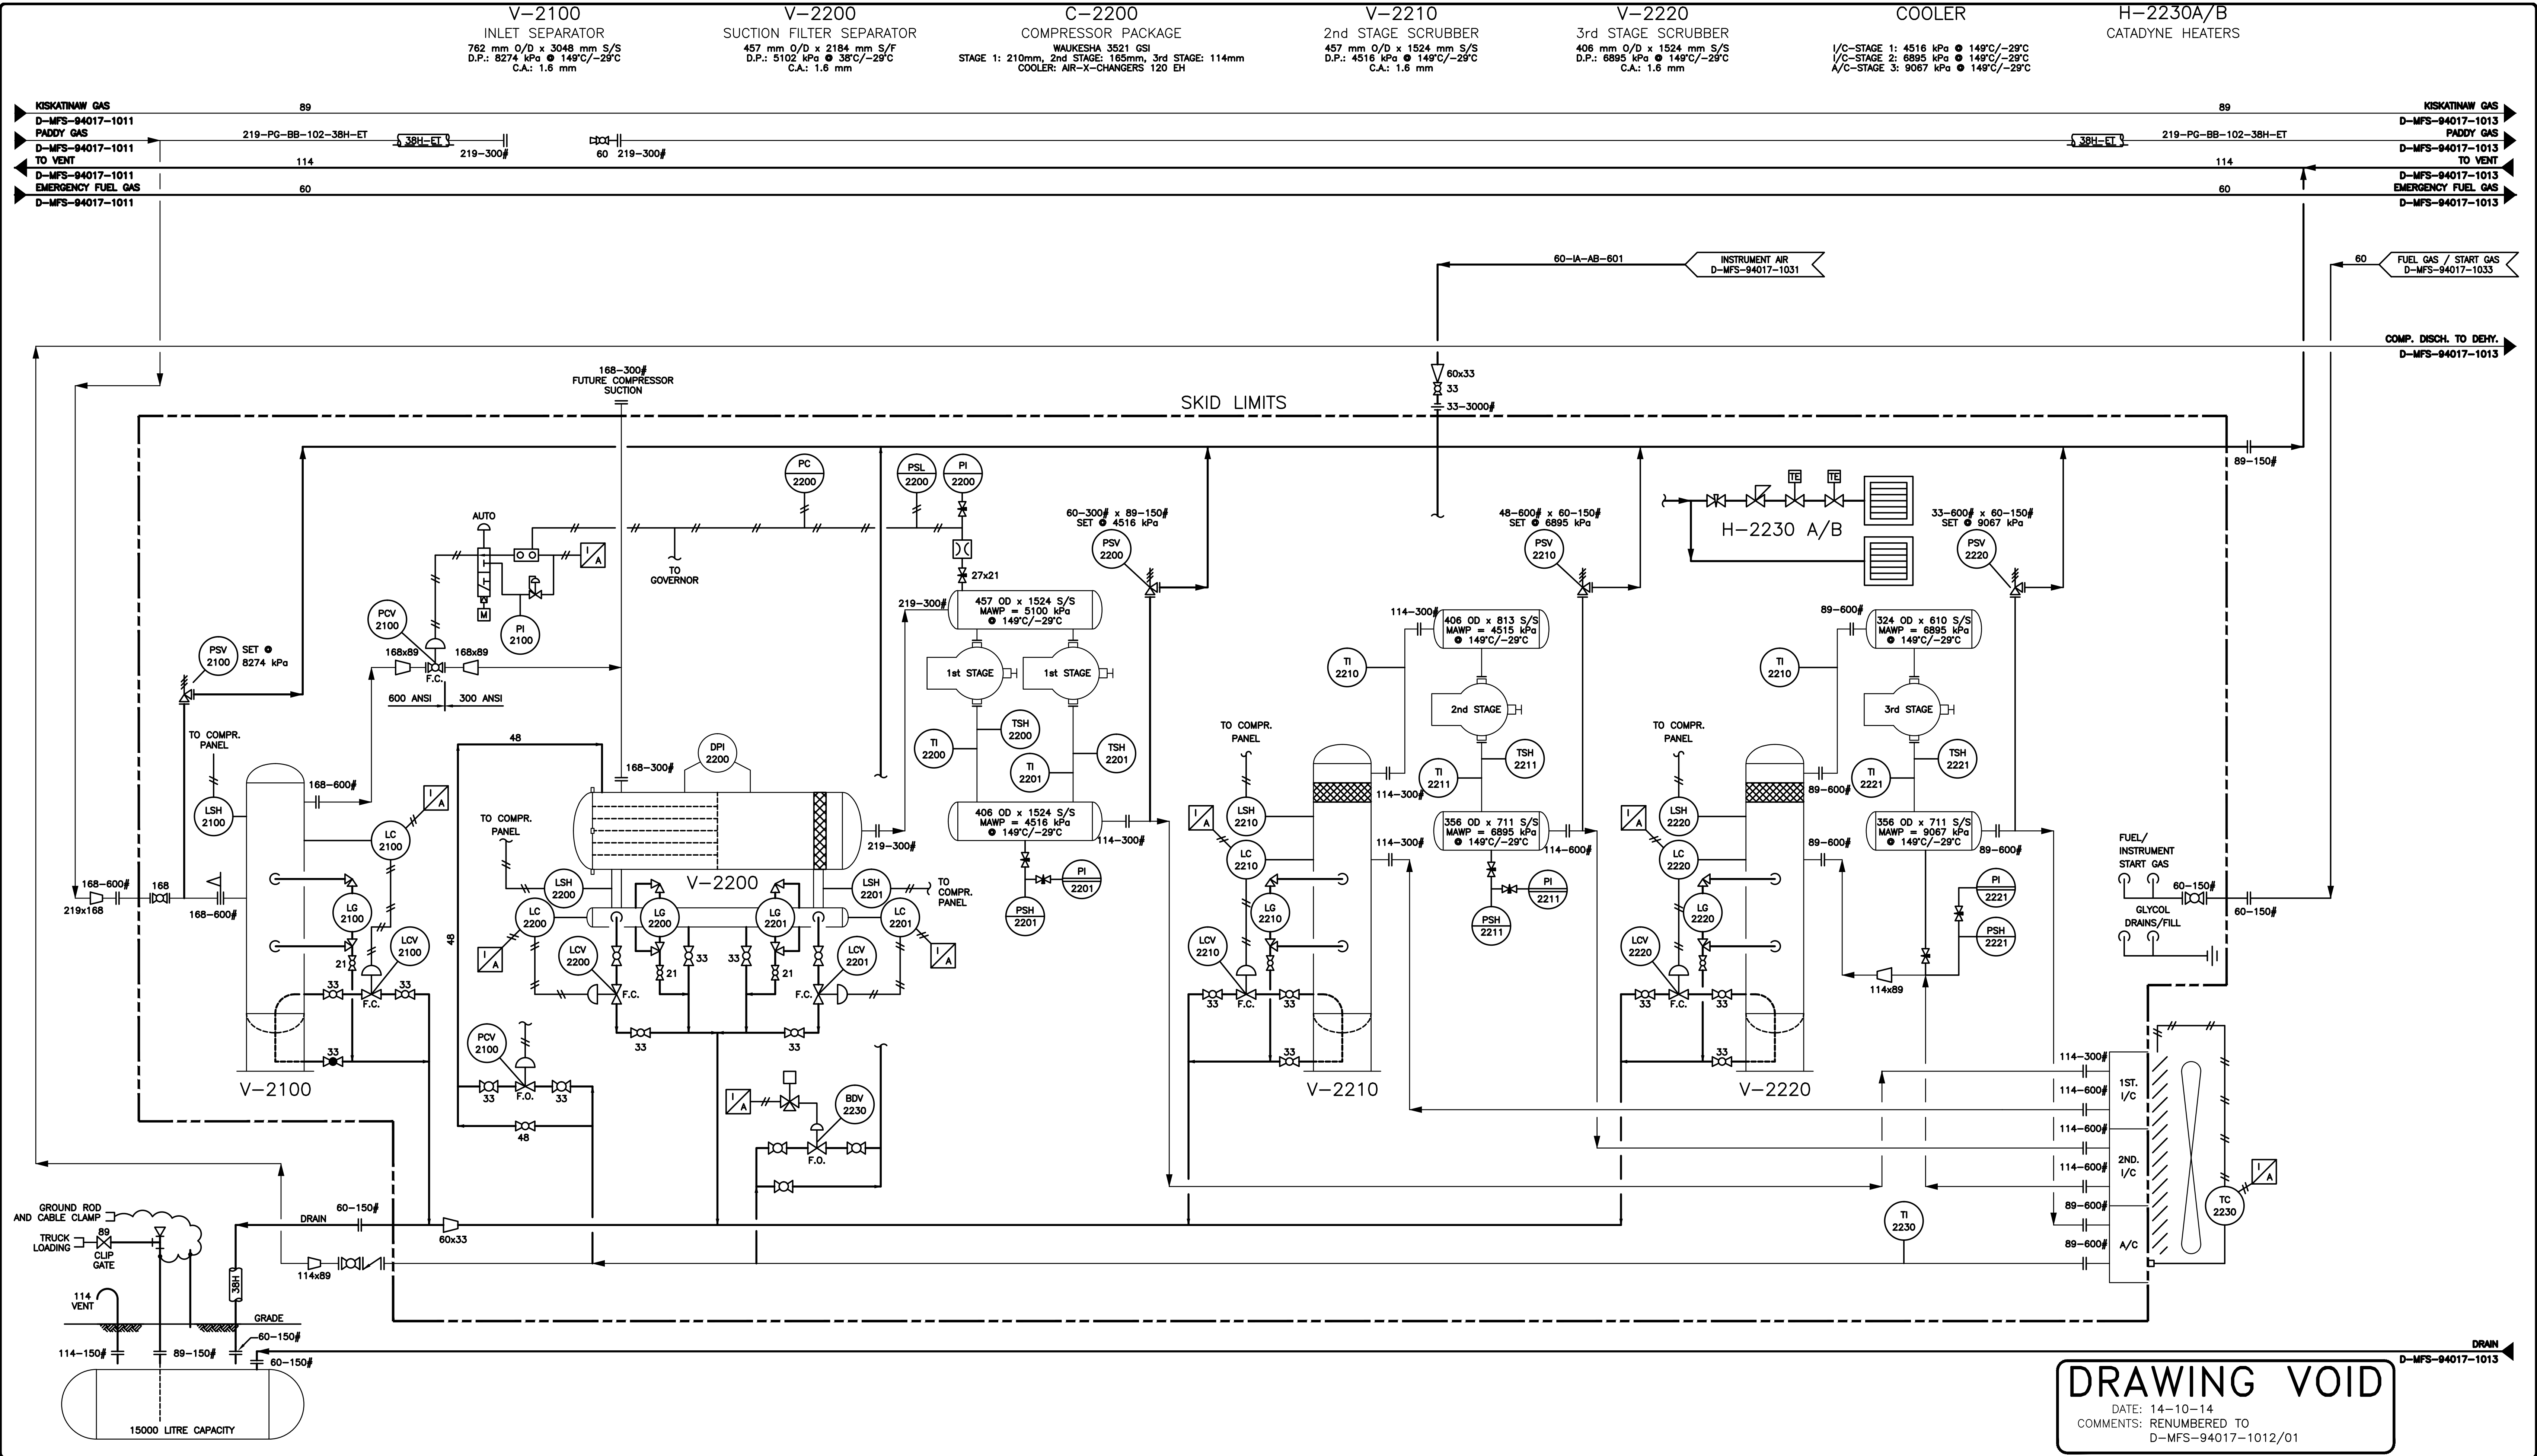


NOTES:

1. CLOUDED AREAS INDICATE NEW
PIPING AND/OR EQUIPMENT.

Q:\94017\MECHANICAL FLOW SHEETS\40171013.DWG
PLOTTED: NOV 10, 2004 2:18 PM

6	ISSUED VOID	O.N. 12327607	RAM	14-10-14		
5	REMOVED COMPRESSOR #2 - AS BUILT PER CLIENT SUPPLIED INFO		KLH	04-11-03		03325
4	PHASE 5 AS-BUILT		RS	97-07-07		
3	ISSUED FOR PHASE 5 CONSTRUCTION		DCC	97-04-15		
2	ISSUED FOR PHASE 5 TENDER		CDK	97-03-31		
1	PHASE 2 AS-BUILT		CDK	96-03-19		
0	ISSUED FOR PHASE 2 CONSTRUCTION		KMF	95-09-15		
B	ISSUED FOR PHASE 2 INFORMATION		KMF	95-09-01		
A	ISSUED FOR INFORMATION		KMF	95-02-28		
No.	Revision		By	Date	Chk.	Job

Prepared By:

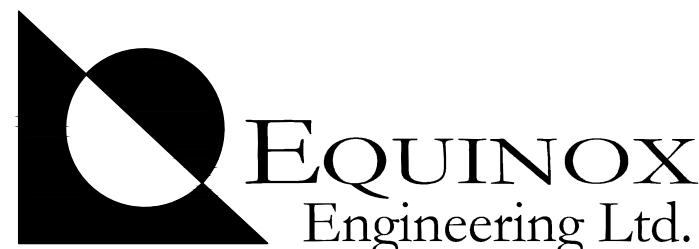

Prepared For:



FOURTH CREEK GAS PLANT

VOID - MECHANICAL FLOWSHEET
GLYCOL DEHYDRATOR #1
FOURTH CREEK

Drawn	Scale	Drawing Number	Rev.
KMF	NTS	D-MFS-94017-1012D/01	6