


BILL OF MATERIALS			
No.	PART No.	DESCRIPTION	QUANTITY
301	NPN	AIR DIVERTER BOX, TOROMONT ENERGY SYSTEMS INC., 20" FF, 20"LG x 20"W x 20"H, SA-36 (SEE STEP #651)	1
302	EXAIR6084	EDUCTOR, CRANKCASE, EXAIR, LINE VAC, 6084, 2" END CONNECTIONS, 0.375" NPT AIR CDNN., ALUMINUM	1
303	NPN	EXPANSION JOINT, MAGIC SPAN, EX-14-12-1/CAT, 14"-150# FF x CAT, 3606 CUSTOM CONN., 12" LG., SS	1
304	NPN	EXPANSION JOINT, MAGIC SPAN, 18"-150#, 17 1/2" LG., SS	2
305	NPN	MUFFLER, HOSPITAL GRADE, SIDE IN/END OUT, SUPPLIED BY PARAMOUNT RESOURCES LTD.	1
306	EXAIR9008	REGULATOR, PRESSURE, EXAIR, 9008, 1/4" NPT c/w PRESSURE GAUGE	1
307	M22CR-5	VALVE, BALL, MERIDIAN, M22CR-5, .5" FNPT, 2000 PSIG @ 150' F, ASTM A216 WCB, NACE, MR01-75	1
308	NPN	IGNITION, CATERPILLAR, ADEM III (c/w ENGINE)	1
309	88A608	VALVE, NEEDLE, CENTURY, 1/2" MALE x FEMALE, 180 DEG., 6000#	1
310	-	-	-
311	-	-	-
312	-	-	-
313	-	-	-
314	-	-	-
315	-	-	-

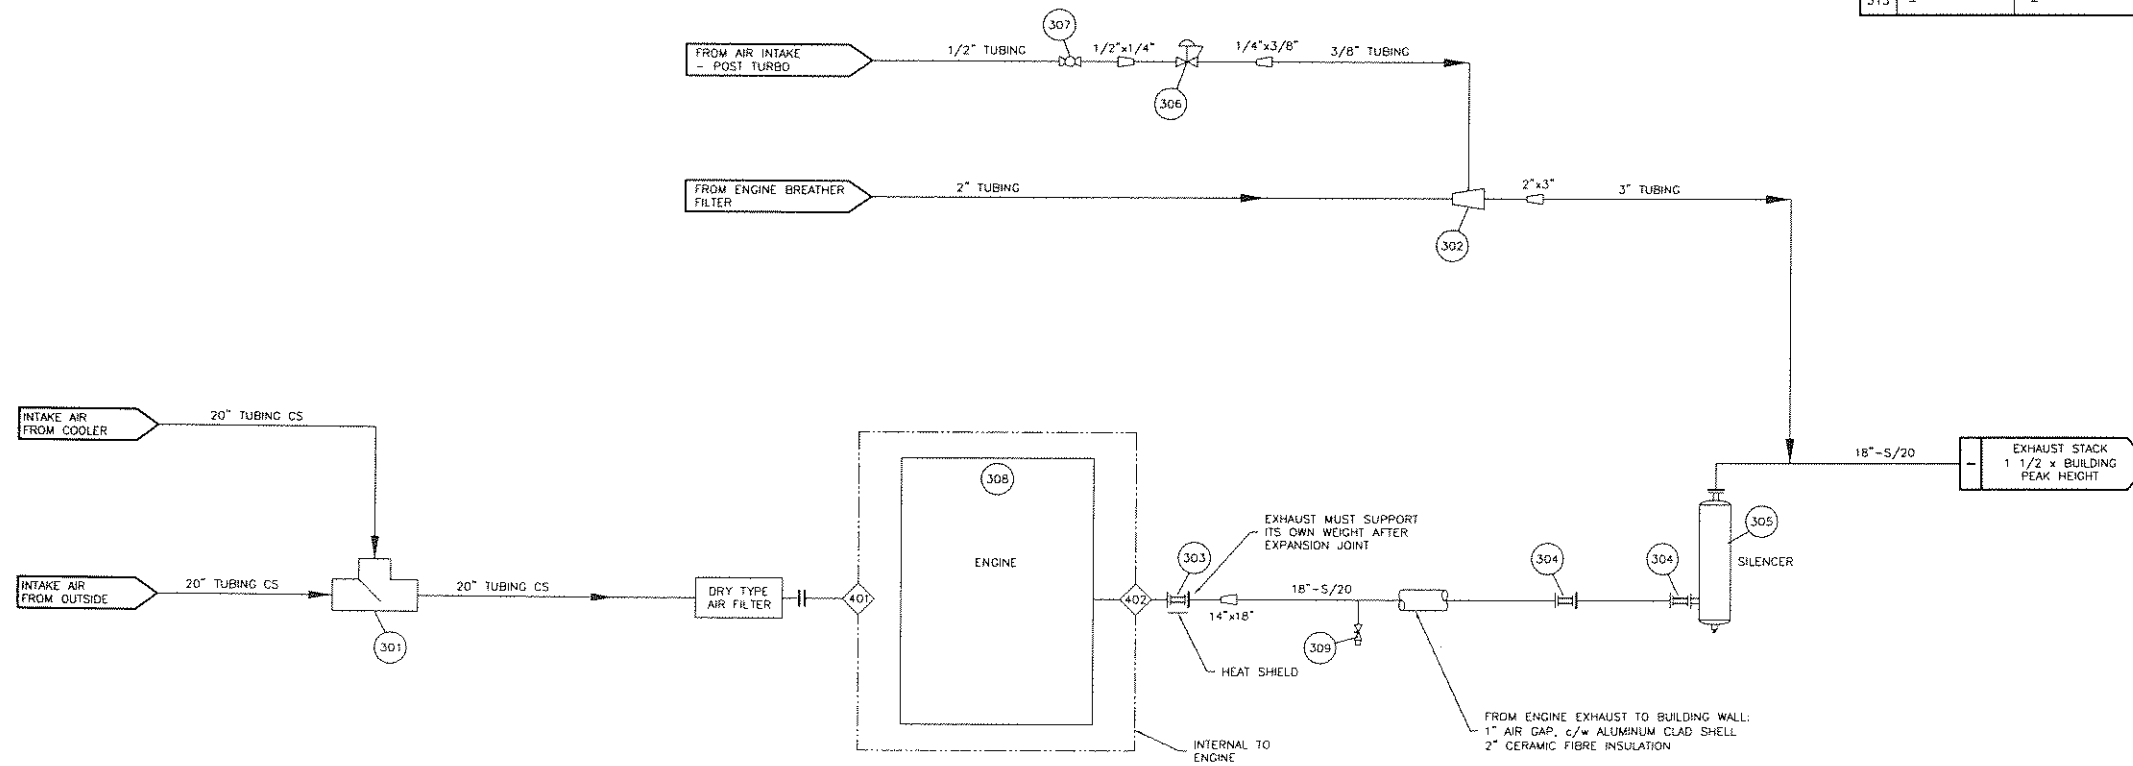

PROPRIETARY MATERIAL  
 NOT TO BE RE-PRODUCED OR DISTRIBUTED  
 WITHOUT THE PRIOR WRITTEN CONSENT OF  
 TOROMONT ENERGY SYSTEMS INC.

NOTES:

- FOR ALL OTHER NOTES & GENERAL INFORMATION SEE DWG. #PFLOW.
- SIGNAL TUBING IS 1/4".

SERVICE:	TUBING	FITTINGS
SWEET:	<input checked="" type="checkbox"/> PROCESS <input checked="" type="checkbox"/> UTILITY (CONTACTING PROCESS) <input checked="" type="checkbox"/> INSTRUMENT <input checked="" type="checkbox"/> FRAME INTERVALS	304 (SS) ZINC PLATED (S) 304 (SS) ZINC PLATED (S) 304 (SS) ZINC PLATED (S) 304 (SS) 304 (SS)
SOUR:	<input type="checkbox"/> PROCESS <input type="checkbox"/> UTILITY (CONTACTING PROCESS) <input type="checkbox"/> INSTRUMENT <input type="checkbox"/> FRAME INTERVALS	316 (SS) 316 (SS) 316 (SS) 316 (SS) 304 (SS) ZINC PLATED (S) 304 (SS) 304 (SS)

TOROMONT ENERGY SYSTEMS  
 JUN 02 2005  
 AS BUILT  
 PER \_\_\_\_\_

3	AS BUILT	05-30-05	BM
2	REVISE ITEM #305 DISCRPTION (SUPPLIED BY CUSTOMER)	03-22-05	BM
1	ISSUED FOR CONSTRUCTION	03-09-05	BM
0	ISSUED FOR APPROVAL	01-20-05	BM
No.	REVISION	DATE	BY
PROPRIETARY MATERIAL: NOT TO BE REPRODUCED OR DISTRIBUTED WITHOUT THE PRIOR WRITTEN CONSENT OF TOROMONT ENERGY SYSTEMS INC.			
		10121 - BARLOW TRAIL N.E. CALGARY ALBERTA CANADA	
TITLE: AIR & EXHAUST FLOW DIAGRAM CATERPILLAR G3606TAW-LE		CUSTOMER: PARAMOUNT RESOURCES LTD. DELTA SWEET GAS COMPRESSOR LSO: 7-15-32-18 WAM	
SCALE: NONE	DATE: 01-20-05	BY: BM	DATE RELEASED: 06/02/05 RELEASED BY: [Signature]
STEP # 530		UNIT # 31262 DRAWING NO.: 31262-AEFLW   REV. 3	