


NOT TO BE REPRODUCED OR DISTRIBUTED WITHOUT THE PRIOR WRITTEN CONSENT OF TOROMONT ENERGY SYSTEMS INC.

TOROMONT ENERGY SYSTEMS
 JUN 02 2005
 AS BUILT
 PER

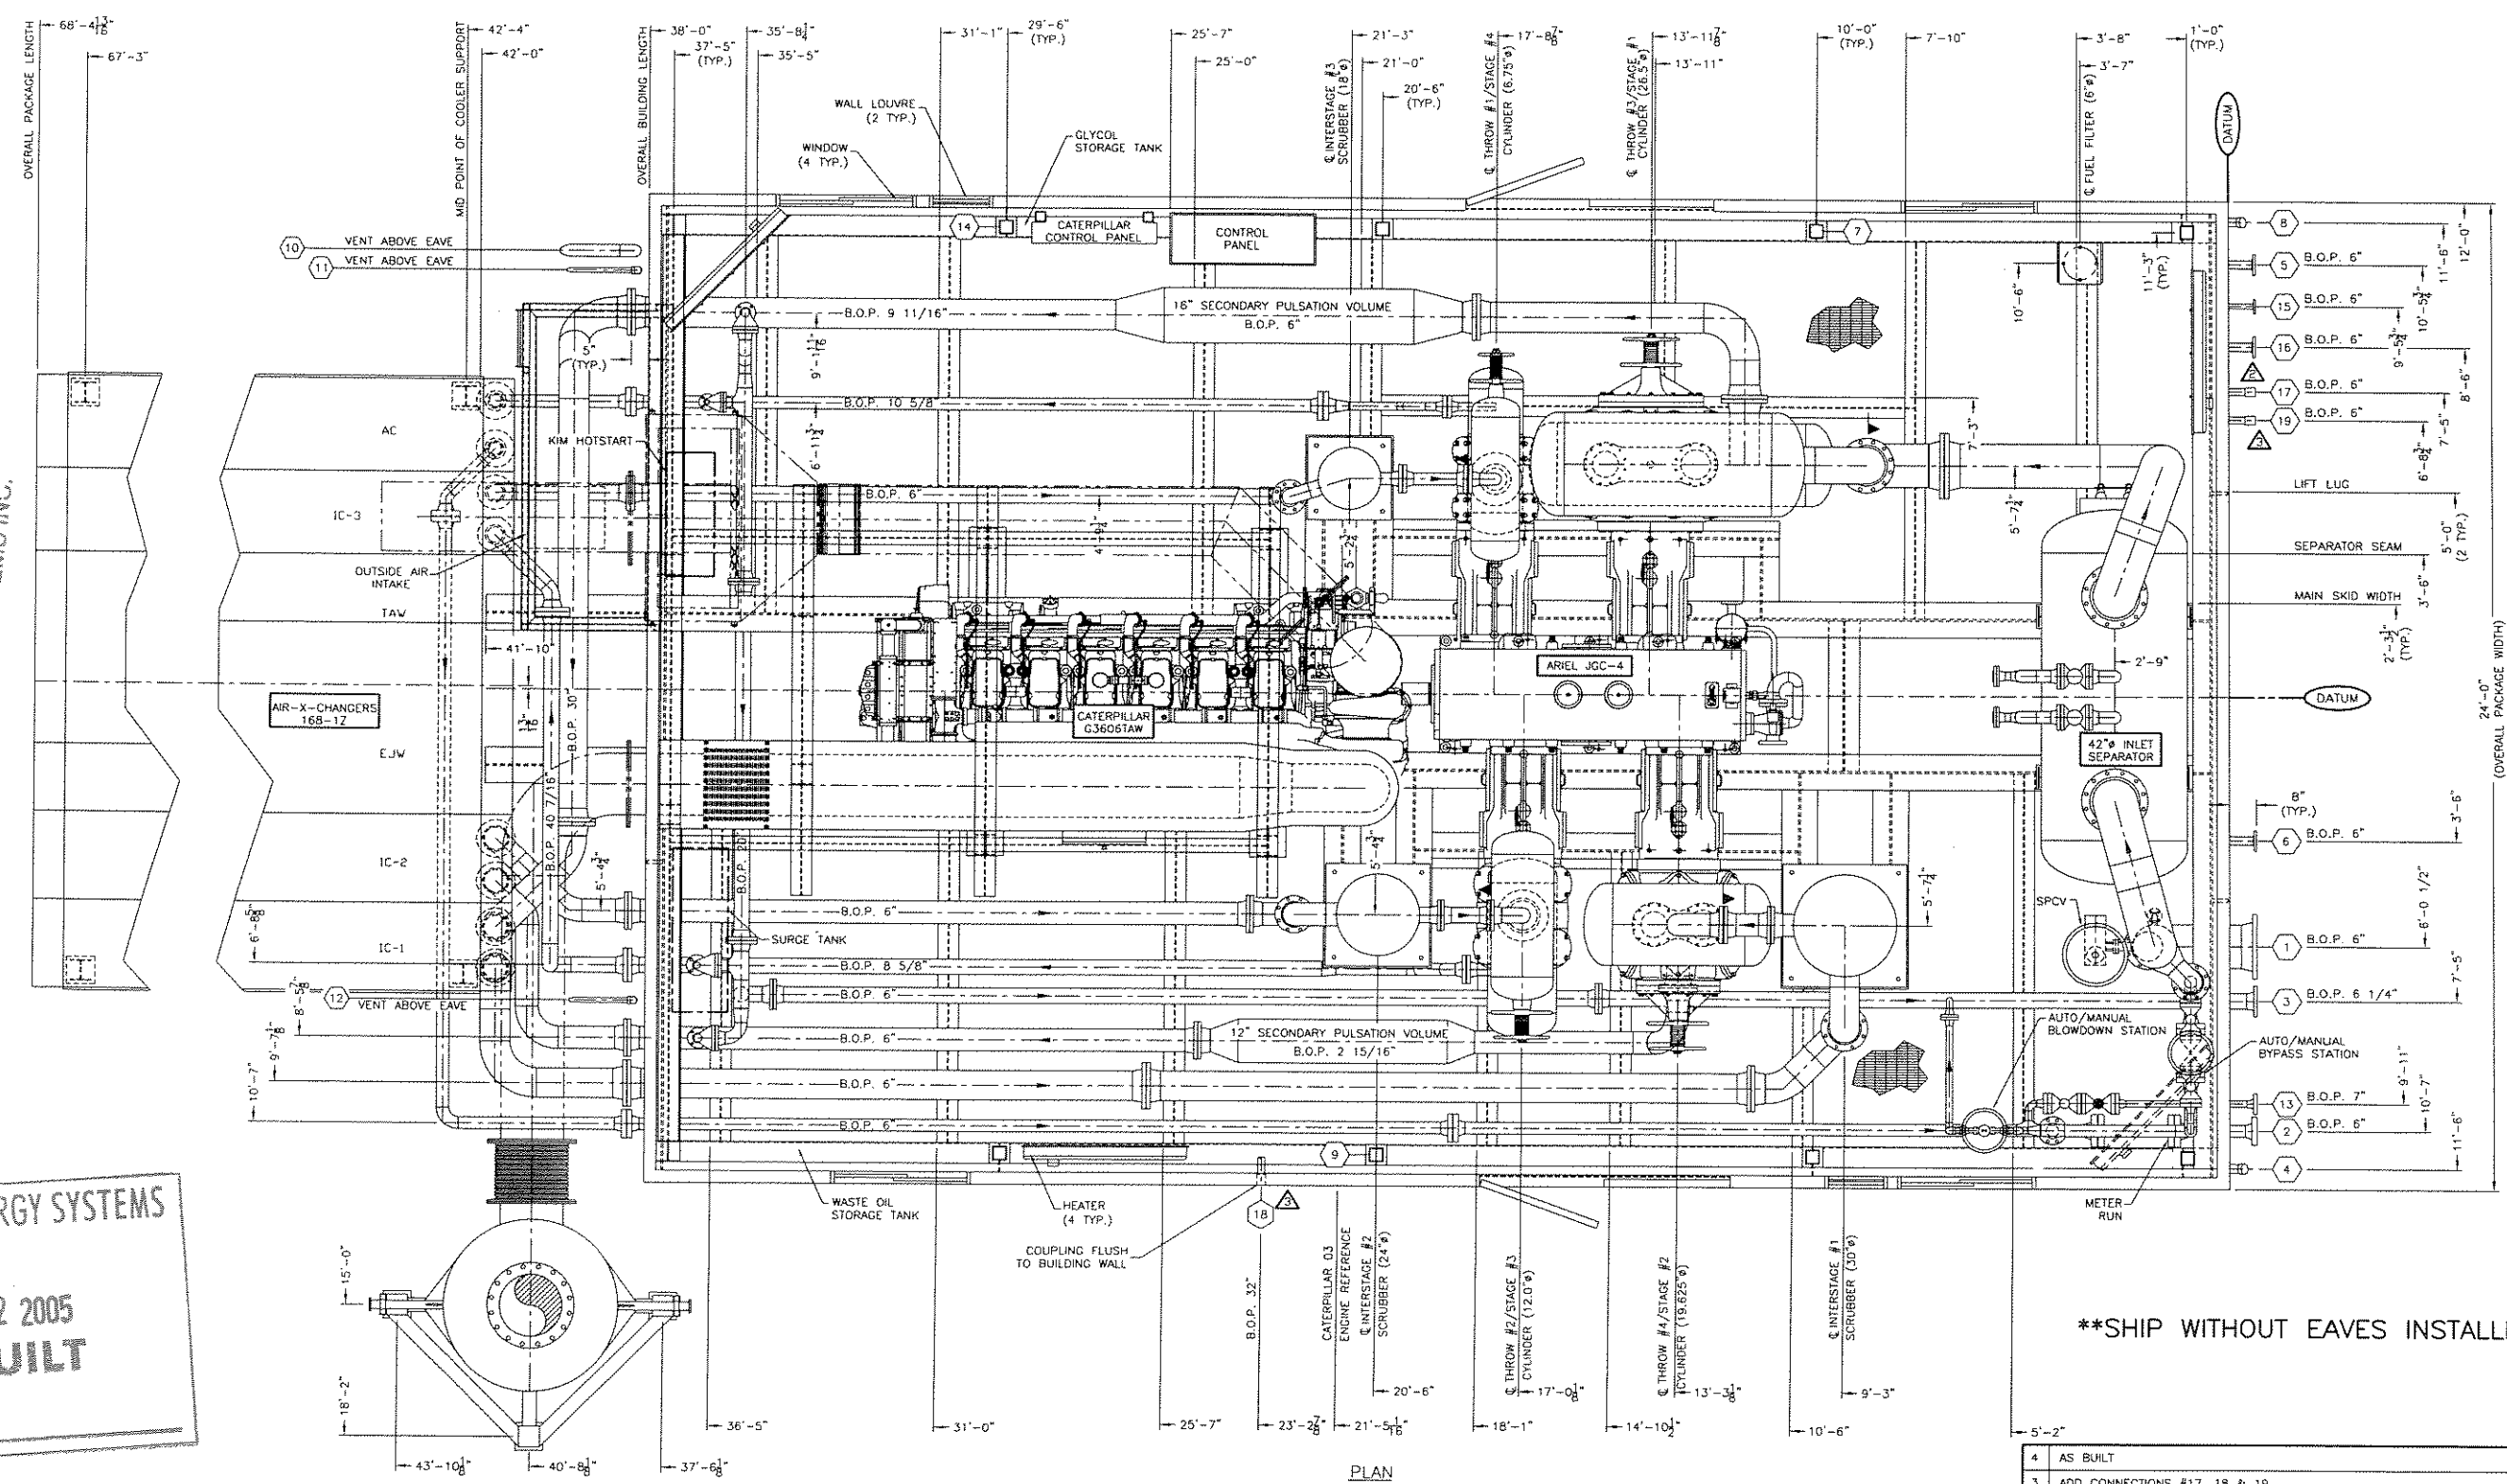

PLAN

SHIP WITHOUT EAVES INSTALLED

GENERAL SPECIFICATIONS	
OVERALL PACKAGE LENGTH	68'-4 13/16"
OVERALL PACKAGE WIDTH	24'-0"
OVERALL PACKAGE HEIGHT (14'-0" EAVE)	21'-0 3/4"
OVERALL PACKAGE WEIGHT (EST.)	260,300 lbs
GLYCOL STORAGE CAPACITY (U.S. GAL.)	515
WASTE OIL STORAGE CAPACITY (U.S. GAL.)	515
SOUR WASTE OIL STORAGE CAPACITY (U.S. GAL.)	N/A
LUBE OIL DAY TANK	<input type="checkbox"/> 56 U.S. GAL. <input type="checkbox"/> CRANE RAILS 156 U.S. GALLONS EACH
BRIDGE CRANE	<input type="checkbox"/> YES <input type="checkbox"/> NO <input type="checkbox"/> 2-TON <input type="checkbox"/> 3-TON <input type="checkbox"/> 5-TON
SEAL PAN	<input type="checkbox"/> YES <input type="checkbox"/> NO <input type="checkbox"/> FLAT <input type="checkbox"/> SLOPED
LOADING METHOD	<input type="checkbox"/> JACK & ROLL <input type="checkbox"/> LIVE ROLL <input type="checkbox"/> CRANE
PROCESS GAS	<input type="checkbox"/> SWEET <input type="checkbox"/> SOUR <input type="checkbox"/> ACID GAS PERCENT SOUR -- %H ₂ S

NOTES:
 1. ALL DIMENSIONS TAKEN FROM BOTTOM OF SKID.
 2. ALL OTHER NOTES FOUND ON DWG. #PLOW.
 3. ALL SKID EDGE CONNECTIONS CONSTRUCTED TO ±1/8" TOLERANCE.

CUSTOMER CONNECTIONS		
1	INITIAL SUCTION	12"-150# RFWN
2	FINAL DISCHARGE	3"-600# RFWN
3	HIGH PRESSURE VENT HEADER	4"-150# RFWN
4	WASTE OIL DRAIN	2"-3000# (NPT)
5	FUEL GAS INLET	2"-150# RF SCR'D
6	SCRUBBER DRAIN HEADER	2"-150# RF SCR'D
7	CYLINDER LUBE OIL FILL	1"-3000# (NPT)
8	GLYCOL TANK DRAIN	2"-3000# (NPT)
9	COMPRESSOR/ENGINE LUBE OIL FILL	1"-3000# (NPT)
10	LOW PRESSURE STARTER VENT HEADER	3"-PIPE (w/ BIRDSCREEN)
11	LOW PRESSURE PUMP VENT	1"-PIPE
12	LOW PRESSURE INSTRUMENT GAS VENT HEADER	1" PIPE
13	HIGH PRESSURE SUPPLY	1 1/2"-600# RFWN
14	DN SKID GLYCOL FILL	3/4" RUBBER HOSE
15	INSTRUMENT AIR SUPPLY	1"-150# RF SCR'D
16	STARTER AIR SUPPLY	2"-150# RF SCR'D
17	WASTE OIL INLET	1 1/2"-3000# (NPT)
18	WASTE OIL OUTLET	1 1/2"-3000# (NPT)
19	OFF SKID GLYCOL FILL	1 1/2"-3000# (NPT)

No.	REVISION	DATE	BY
4	AS BUILT	05-30-05	BM
3	ADD CONNECTIONS #17, 18 & 19	04-08-05	BM
2	ADD STARTER AIR SUPPLY CONNECTION	03-22-05	BM
1	ISSUED FOR CONSTRUCTION	02-28-05	BM
0	ISSUED FOR APPROVAL	01-31-05	BM

PROPRIETARY MATERIAL: NOT TO BE REPRODUCED OR DISTRIBUTED WITHOUT THE PRIOR WRITTEN CONSENT OF TOROMONT ENERGY SYSTEMS INC.

TOROMONT ENERGY SYSTEMS 10121 - BARLOW TRAIL N.E. CALGARY ALBERTA CANADA

TITLE: GENERAL ARRANGEMENT
 CATERPILLAR G3606TAW/ARIEL JGC4/4
 AIR-X-CHANGERS 168-12

CUSTOMER: PARAMOUNT RESOURCES LTD.
 DELTA SWEET GAS COMPRESSOR
 LSD: 7-15-32-18 W4M

SCALE: 1/2"=1'-0" DATE: 01-31-01 BY: BM DATE RELEASED: 02/02/05 RELEASED BY: [Signature]
 W.O. # N/A UNIT # 31262 DRAWING NO: 31262-GA REV. 4