

V-110
SUCTION SCRUBBER

Manufacturer: BROMLEY
Size: 762mm x 1,829mm S/S
(30" x 72" S/S)
Rated: 285psi @ 100°F
1/8" CA
CRN: R0451.2
Serial: 317340
(A) 503590

V-140
INLET GAS FILTER


Manufacturer: NAFCO
Model: 41030-M08D
Size: 219.1mm x 635mm S/S
(8" x 27 3/4" S/S)
Rated: 180psi @ 450°F
CRN: L7900.2
Serial: 568-UM

H-410
NATURAL GAS HEATER

Manufacturer: CIS-CAN
Size: 305mm x 610mm
(12" x 24")
12,000 btu/hr
12 Volt Start
Protection Grill
Serial: 232364

H-420
NATURAL GAS HEATER

Manufacturer: CIS-CAN
Size: 610mm x 610mm
(24" x 24")
24,000 btu/hr
12 Volt Start
Protection Grill
Serial: 222762

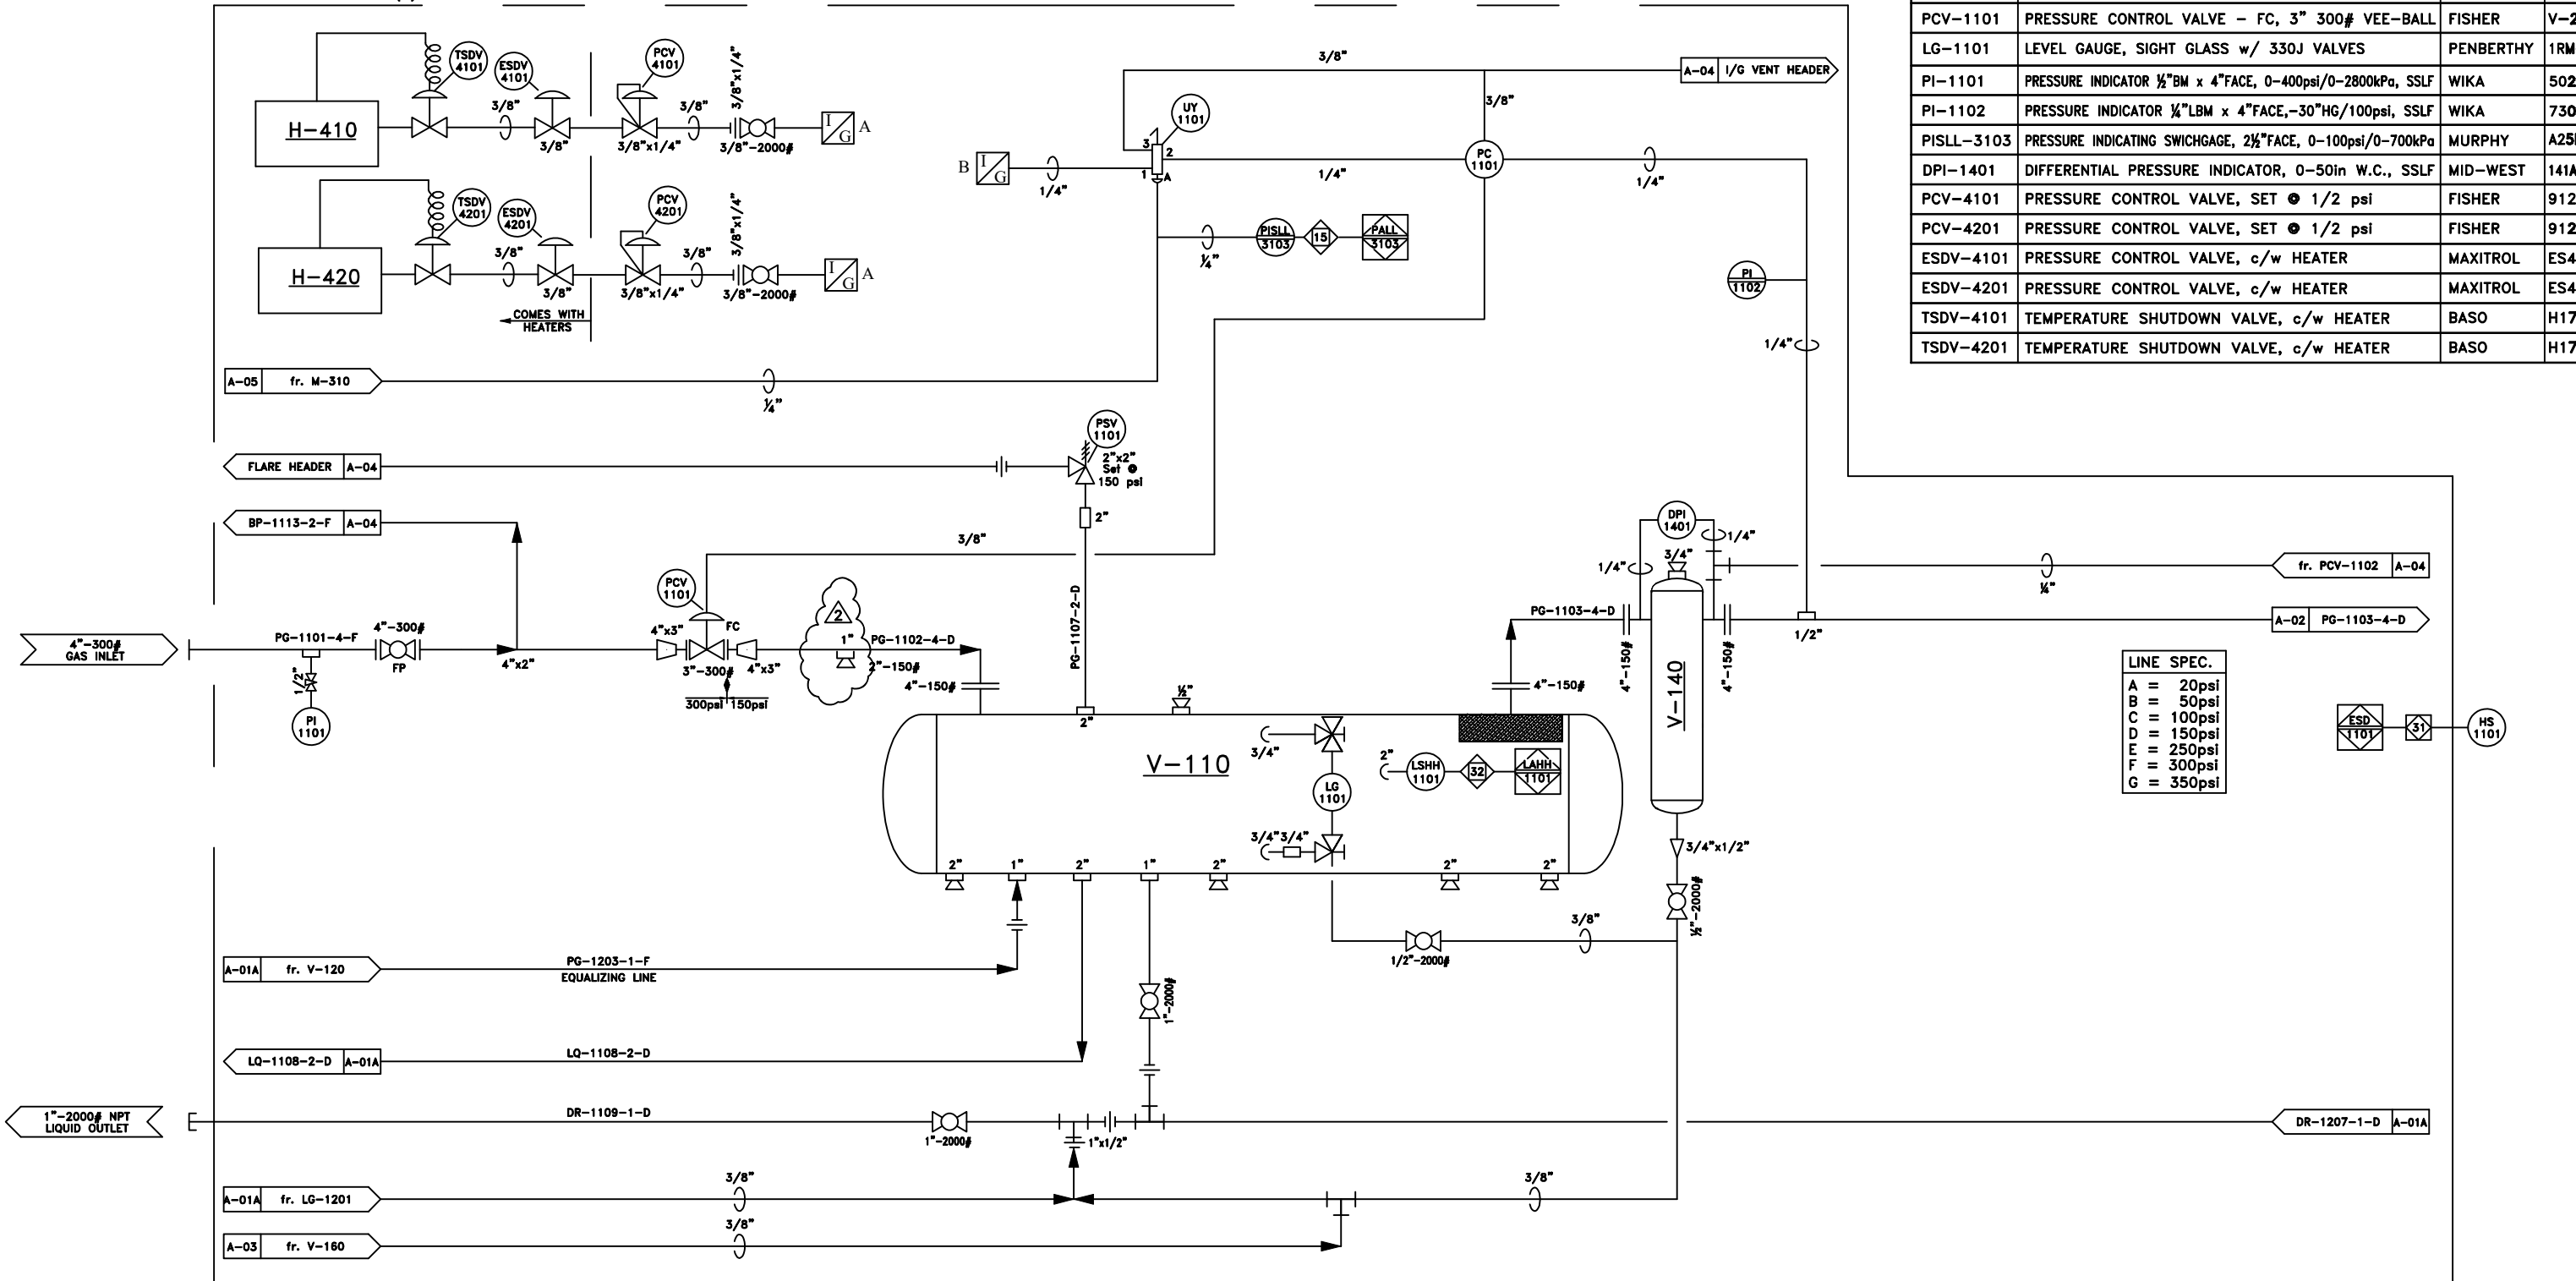

MATERIAL LIST

ITEM	DESCRIPTION	MAKE	MO
PSV-1101	PRESSURE SAFETY VALVE, 2"x2" NPT, SET @ 150 psig	MERCER	8143
HS-1101	EMERGENCY SHUTDOWN HAND SWITCH	TELEMECANIQUE	#VAL
LSHH-1101	LEVEL SHUTDOWN HIGH	MURPHY	L12
UY-1101	PRESSURE SWITCH	AMOT	405
PC-1101	PRESSURE CONTROLLER, SPRING RANGE SET @ 0-100 psig	FISHER	415
PCV-1101	PRESSURE CONTROL VALVE - FC, 3" 300# VEE-BALL	FISHER	V-2
LG-1101	LEVEL GAUGE, SIGHT GLASS w/ 330J VALVES	PENBERTHY	1RM
PI-1101	PRESSURE INDICATOR 1/2"BM x 4"FACE, 0-400psi/0-2800kPa, SSIF	WIKA	502
PI-1102	PRESSURE INDICATOR 1/4" LBM x 4"FACE, -30"HG/100psi, SSIF	WIKA	730
PISLL-3103	PRESSURE INDICATING SWITCHGAGE, 2 1/2"FACE, 0-100psi/0-700kPa	MURPHY	A25I
DPI-1401	DIFFERENTIAL PRESSURE INDICATOR, 0-50in W.C., SSIF	MID-WEST	141A
PCV-4101	PRESSURE CONTROL VALVE, SET @ 1/2 psi	FISHER	912
PCV-4201	PRESSURE CONTROL VALVE, SET @ 1/2 psi	FISHER	912
ESDV-4101	PRESSURE CONTROL VALVE, c/w HEATER	MAXITROL	ES4
ESDV-4201	PRESSURE CONTROL VALVE, c/w HEATER	MAXITROL	ES4
TSDV-4101	TEMPERATURE SHUTDOWN VALVE, c/w HEATER	BASO	H17
TSDV-4201	TEMPERATURE SHUTDOWN VALVE, c/w HEATER	BASO	H17

LINE TYPE LEGEND		PROCESS TUBING/ INSTRUMENT SUPPLY
MAIN PROCESS GAS		PNEUMATIC SIGNAL
SECONDARY PROCESS		HYDRAULIC SIGNAL
UTILITY PROCESS		ELECTRIC SIGNAL

REV.	DESCRIPTION	BY	DATE	CHKD	APPD
2	ISSUED FOR SC-1043-J1	JRB	04-02-04	CAD	ENG
1	AS BUILT	SLS	03-12-12	CAD	ENG
0	ISSUED FOR CONSTRUCTION	SLS	03-10-27	CAD	ENG

Jiro
ENERFLEX

5221-46th St. Stettler Alberta Phone: 403.742.5538
Box 1450, T0C 2L2 Fax: 403.742.5539

9000 SERIES COMPRESSOR
G.D. SSP w/ 3306 ATAAC ENGINE
TRAILER MOUNTED, SWEET SERVICE

COMPANY:		JIRO STOCK		JOB NO.:	
Drawn by:		Checked by:		Approved by:	
WST				DATE:	
				03-10-27	
				SCALE:	
				N.T.S.	
				DRAWING NO.:	
				CDL-90278-A-01	