

M-310
NATURAL GAS ENGINE

Manufacturer: CATERPILLAR
Model: 3306ATAAC
220hp / 195hp USABLE
Altronic CPU-95
Serial: 07Y08785

T-710
ENGINE OIL DAY TANK


Manufacturer: ENERFLEX COMPRESSION-STETTLER
Size: 20gal
Part: OS-37

C-520
ENGINE WATER JACKET

Manufacturer: GLOBAL HEAT TRANSFER
Size: 43"x41"x9"
Model: JIRO.01
Serial: 148

C-530
AIR to AIR COOLER

Manufacturer: GHT ALUMINUM
Model: MAC011T

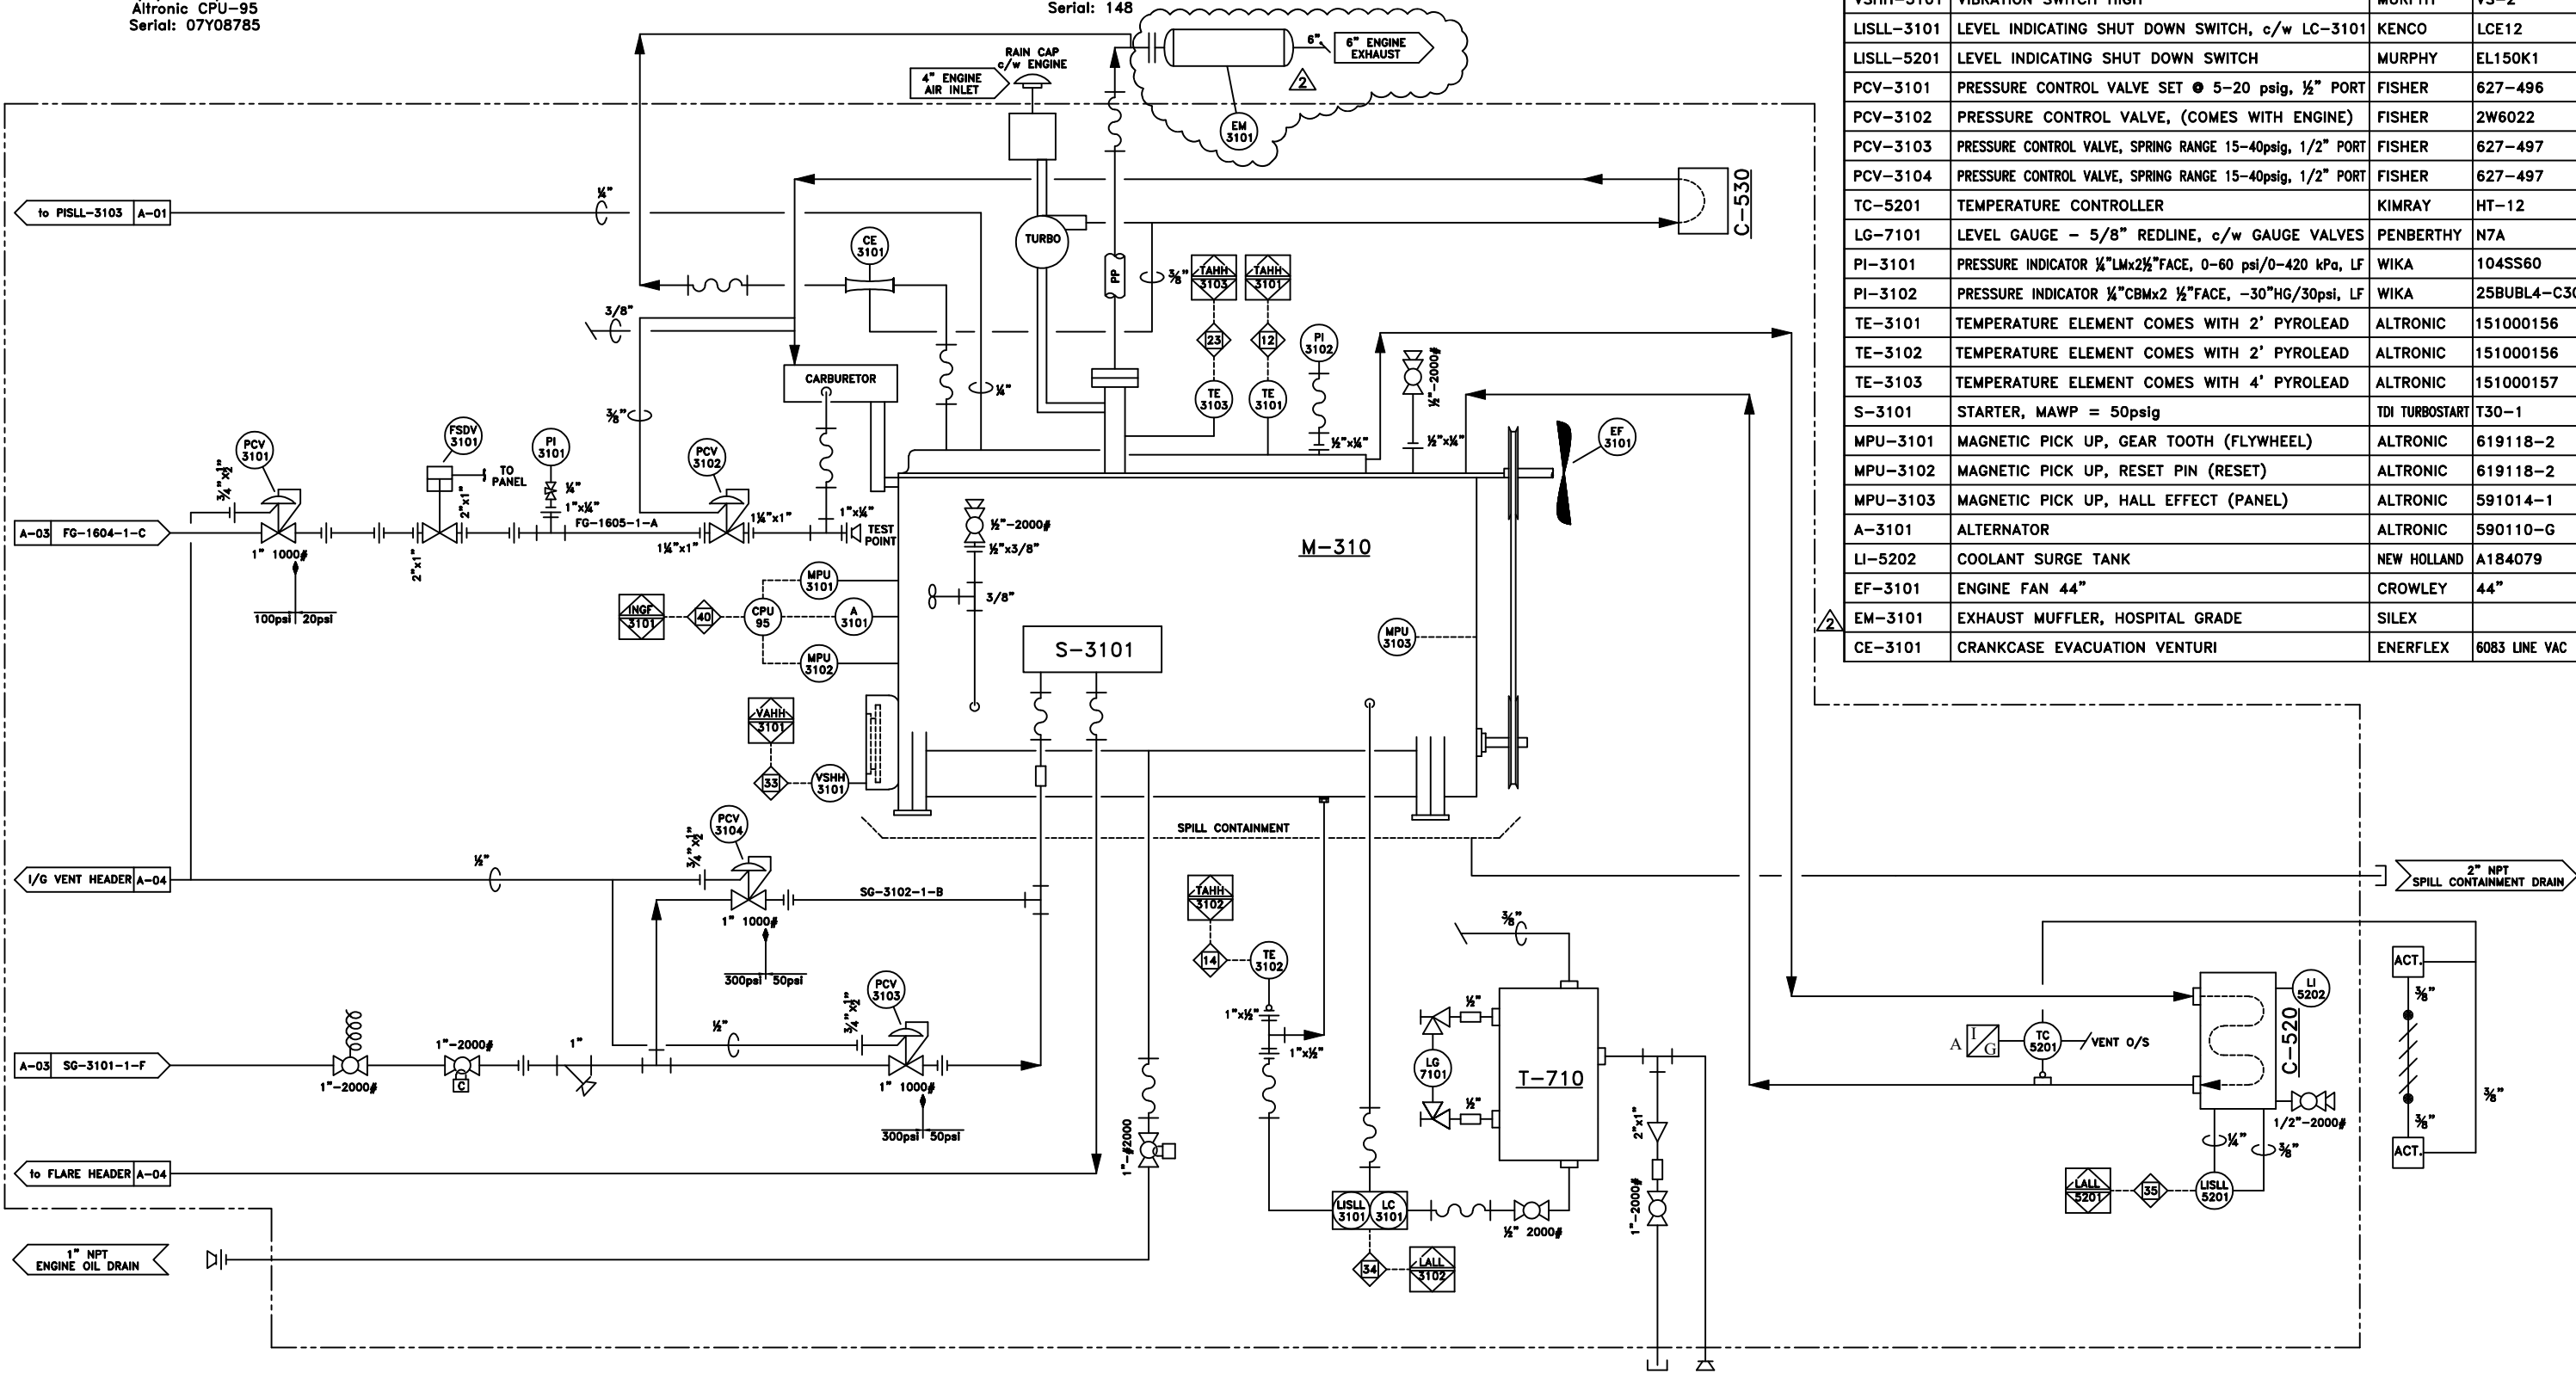

MATERIAL LIST

ITEM	DESCRIPTION	MAKE	MODEL
FSDV-3101	FUEL SHUT DOWN VALVE	MURPHY	M5081-C
VSHH-3101	VIBRATION SWITCH HIGH	MURPHY	VS-2
LISLL-3101	LEVEL INDICATING SHUT DOWN SWITCH, c/w LC-3101	KENCO	LCE12
LISLL-5201	LEVEL INDICATING SHUT DOWN SWITCH	MURPHY	EL150K1
PCV-3101	PRESSURE CONTROL VALVE SET @ 5-20 psig, 1/2" PORT	FISHER	627-496
PCV-3102	PRESSURE CONTROL VALVE, (COMES WITH ENGINE)	FISHER	2W6022
PCV-3103	PRESSURE CONTROL VALVE, SPRING RANGE 15-40psig, 1/2" PORT	FISHER	627-497
PCV-3104	PRESSURE CONTROL VALVE, SPRING RANGE 15-40psig, 1/2" PORT	FISHER	627-497
TC-5201	TEMPERATURE CONTROLLER	KIMRAY	HT-12
LG-7101	LEVEL GAUGE - 5/8" REDLINE, c/w GAUGE VALVES	PENBERTHY	N7A
PI-3101	PRESSURE INDICATOR 1/4"LMx2 1/2"FACE, 0-60 psi/0-420 kPa, LF	WIKA	104SS60
PI-3102	PRESSURE INDICATOR 1/4"CBMx2 1/2"FACE, -30"HG/30psi, LF	WIKA	25BUBL4-C30
TE-3101	TEMPERATURE ELEMENT COMES WITH 2' PYROLEAD	ALTRONIC	151000156
TE-3102	TEMPERATURE ELEMENT COMES WITH 2' PYROLEAD	ALTRONIC	151000156
TE-3103	TEMPERATURE ELEMENT COMES WITH 4' PYROLEAD	ALTRONIC	151000157
S-3101	STARTER, MAWP = 50psig	TDI TURBOSTART	T30-1
MPU-3101	MAGNETIC PICK UP, GEAR TOOTH (FLYWHEEL)	ALTRONIC	619118-2
MPU-3102	MAGNETIC PICK UP, RESET PIN (RESET)	ALTRONIC	619118-2
MPU-3103	MAGNETIC PICK UP, HALL EFFECT (PANEL)	ALTRONIC	591014-1
A-3101	ALTERNATOR	ALTRONIC	5901110-G
LI-5202	COOLANT SURGE TANK	NEW HOLLAND	A184079
EF-3101	ENGINE FAN 44"	CROWLEY	44"
EM-3101	EXHAUST MUFFLER, HOSPITAL GRADE	SILEX	
CE-3101	CRANKCASE EVACUATION VENTURI	ENERFLEX	6083 LINE VAC

LINE TYPE LEGEND		PROCESS TUBING/ INSTRUMENT SUPPLY
———	MAIN PROCESS GAS	——— PNEUMATIC SIGNAL
———	SECONDARY PROCESS	——— HYDRAULIC SIGNAL
———	UTILITY PROCESS	----- ELECTRIC SIGNAL

REV.	DESCRIPTION	BY	DATE	CHKD	APPD
2	ISSUED FOR SC-1043-J1	JRB	04-02-04	CAD	ENG
1	AS BUILT	SLS	03-12-12	CAD	ENG
0	ISSUED FOR CONSTRUCTION	SLS	03-10-27	CAD	ENG

Jiro
ENERFLEX

5221-46th St. Stettler Alberta Box 1450, T0C 2L2 Phone: 403.742.5538 Fax: 403.742.5539

9000 SERIES COMPRESSOR
G.D. SSP w/ 3306 ATAAC ENGINE
TRAILER MOUNTED, SWEET SERVICE

COMPANY: JIRO STOCK JOB NO.: 90278

Drawn by: WST Checked by: Approved by: DATE: 03-10-27 SCALE: N.T.S. DRAWING NO.: CDL-90278-A-05 REV.: 1