



**HEATLESS SERIES 15-75 SCFM  
TWIN TOWER DESICCANT AIR DRYER  
ELECTRICAL - CONTROL**


DRAWING NO. NW40-215-ECO REV G  
SCALE: N.T.S. SHEET 1 of 1

TOLERANCES UNLESS OTHERWISE SPECIFIED:  
FRACTIONS = ± 1/4"  
ANGLES = ± 3°  
INCHES = ± 1/2"  
FINISH = 250

THE SPECIFICATIONS AND DRAWINGS DISCLOSED HEREIN ARE THE SOLE PROPERTY OF NORTHWEST EQUIPMENT LTD. AND SHALL NOT BE COPIED OR USED AS THE BASIS FOR SALE OR MANUFACTURE WITHOUT EXPRESS WRITTEN PERMISSION.

REVISION STATUS				
LTR	ECO NO.	DESCRIPTION	DATE	APPROVED
G	0585	TITLEBLOCK/CUSTOMER ACCESS BLOCK UPDATED	7/18/2017	WA

TYPE 4 ENCLOSURE  
ALL WIRING IS 18 AWG UNLESS OTHERWISE INDICATED.

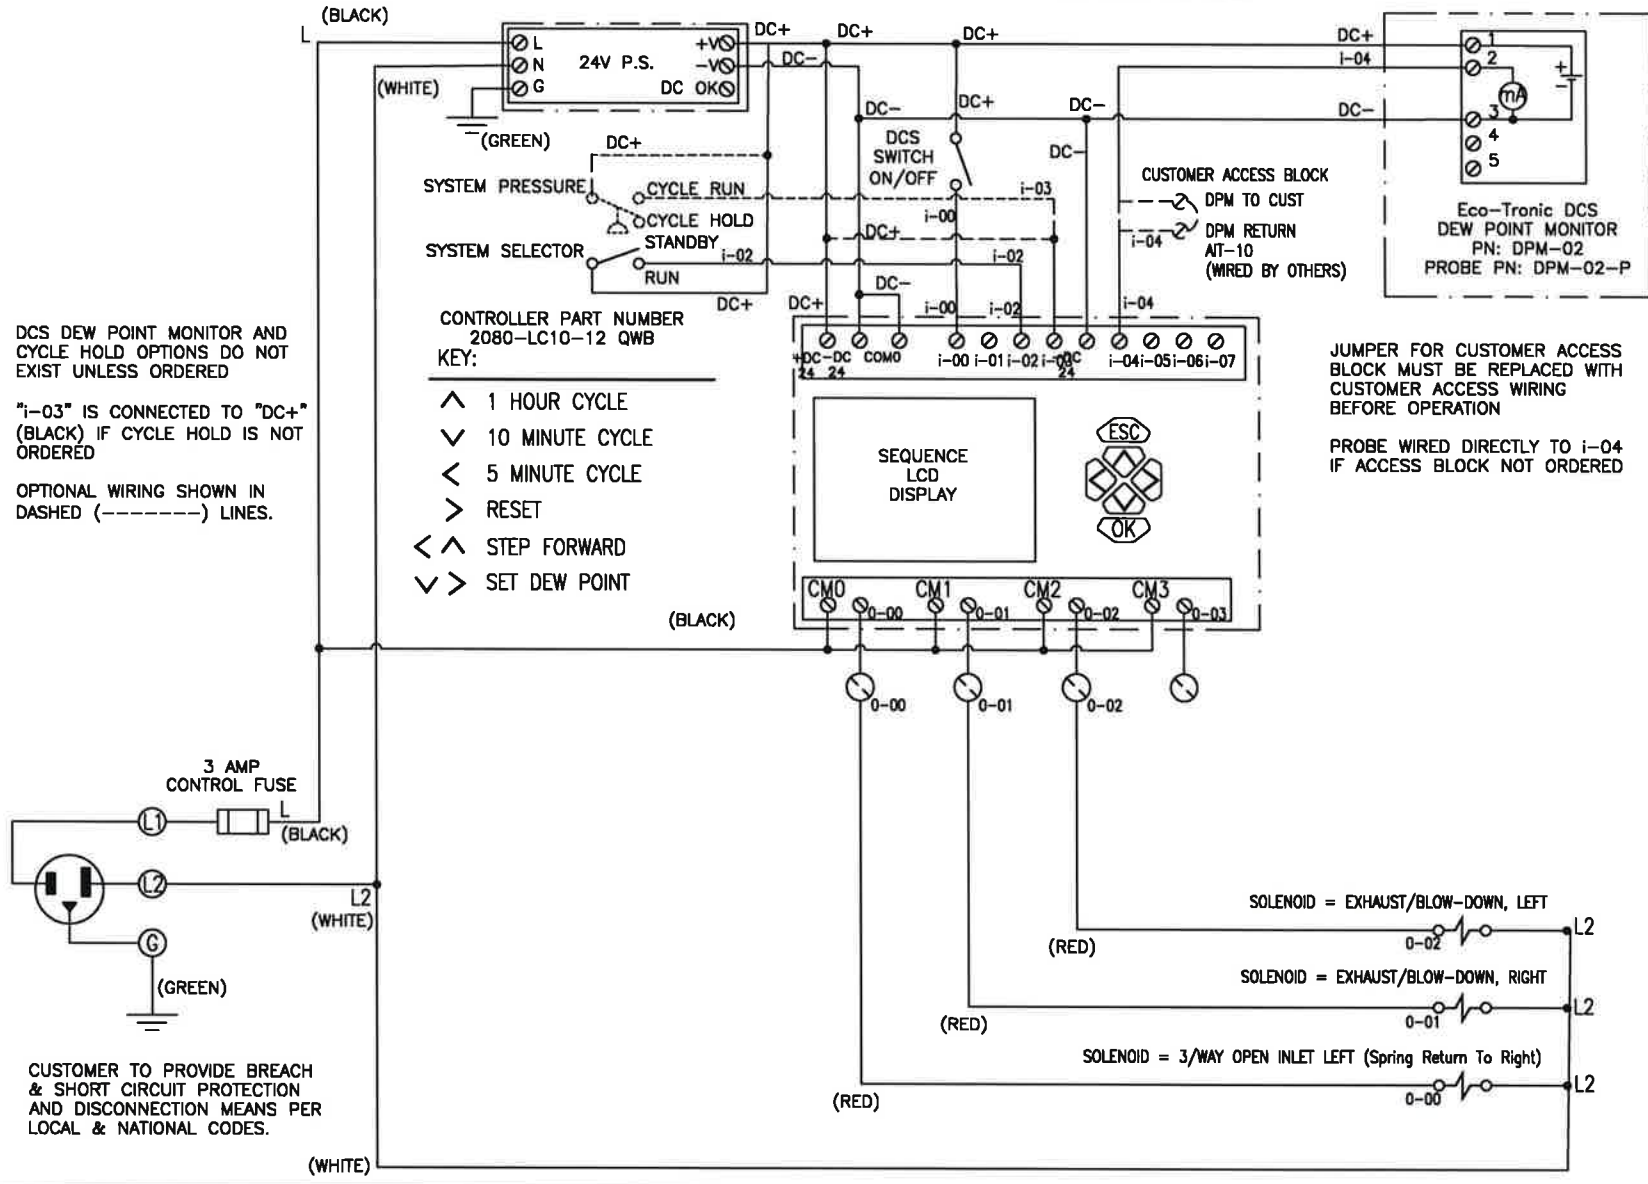

DCS DEW POINT MONITOR AND CYCLE HOLD OPTIONS DO NOT EXIST UNLESS ORDERED

"i-03" IS CONNECTED TO "DC+" (BLACK) IF CYCLE HOLD IS NOT ORDERED

OPTIONAL WIRING SHOWN IN DASHED (-----) LINES.

- CONTROLLER PART NUMBER 2080-LC10-12 QWB  
KEY:
- ^ 1 HOUR CYCLE
  - ✓ 10 MINUTE CYCLE
  - < 5 MINUTE CYCLE
  - > RESET
  - < ^ STEP FORWARD
  - ✓ > SET DEW POINT

JUMPER FOR CUSTOMER ACCESS BLOCK MUST BE REPLACED WITH CUSTOMER ACCESS WIRING BEFORE OPERATION

PROBE WIRED DIRECTLY TO i-04 IF ACCESS BLOCK NOT ORDERED

CUSTOMER TO PROVIDE BREACH & SHORT CIRCUIT PROTECTION AND DISCONNECTION MEANS PER LOCAL & NATIONAL CODES.

T.B. SCALE: 5 DIMSCALE: 1.88 PREVIOUS DWG#:

Document # V2553-191126-1011 Rev 0

- 1. Approved (Work May Proceed)
- 2. Approved with Comments - Work May Proceed (Revise and Resubmit)
- 3. Not Approved (Stop Work per Attached Instructions)
- 4. Information Only

AUTHORIZATION TO PROCEED DOES NOT WAIVE SUPPLIER'S RESPONSIBILITY OR LIABILITY UNDER THE CONTRACT / PURCHASE ORDER FOR COMPLIANCE WITH THE REQUIREMENTS OF THE DRAWINGS AND SPECIFICATIONS

*Signature* 19/11/21  
Signature YY/MM/DD

PROPAK SYSTEMS LTD - AIRDRIE, AB

PO #	Job #	191126
P482340	Doc #	V2553-191126-1011
Equip #	VDR:	C7-C27
	Rev:	0

REV	DESCRIPTION	DATE	DWN	CHK
0	ISSUED FOR APPROVAL	2019-10-28	HH	HAY



ELECTRICAL DIAGRAM			
NORTHWEST NW40-Y DRYER PANEL			
CLIENT	CENOVUS c/o PROPAK	SCALE	NTS
LOCATION	FOSTER CREEK WEST PADS SAP, AB	DWN BY	HH
LSD	TBA PO# P482340	DATE	2019-10-28
JOB	DWG	SHEET	REV
NW2165-RH	NW2165EL3	1 / 1	0