



Data Book

CLIENT: Husky Oil Operations Ltd.

AGENT: Bar Engineering

P.O#: 8401416112

FOREMOST WORK ORDER NO.: W03-066731

DESCRIPTION: 1,000 BBL Sales Tank Modifications

FOREMOST DOCUMENT NUMBER: W03-066731-DB_r0

REFERENCE DOCUMENT NUMBER: N/A

DOC REV		DOCUMENT #	PAGES	BY	APPD	DATE
0		W03-066731-DB	30	JM		June 18, 2020

DESIGN STANDARD				COMMENTS

Notes:

This document contains all documentation for S/N 028328-1 & 028328-3.



Data Book

Husky Oil Operations Ltd.
C/O Bar Engineering

Foremost Work Order: W03-066731

Location: Sandall Bottom Water De-Pressurization

P.O. #: 8401416112

1,000 BBL Sales Tank (Modification)

Serial Number: 028328-1 & 028328-3

Table of Contents


Section 1: Drafting/ Engineering

1. General Arrangement (Modification)
2. Anode Roller Support Details
3. Nozzle Detail (Modification)
4. Nozzle Spool Details (Modifications)

Section 2: Quality Control

1. Inspection and Test Plan
2. Penetrant Test Report – Roof Nozzles
3. Penetrant Test Report – Shell Nozzles
4. Repad Test Report
5. Insulation Report
6. Coating Report

STANDARD WELD DETAILS (N.T.S.)

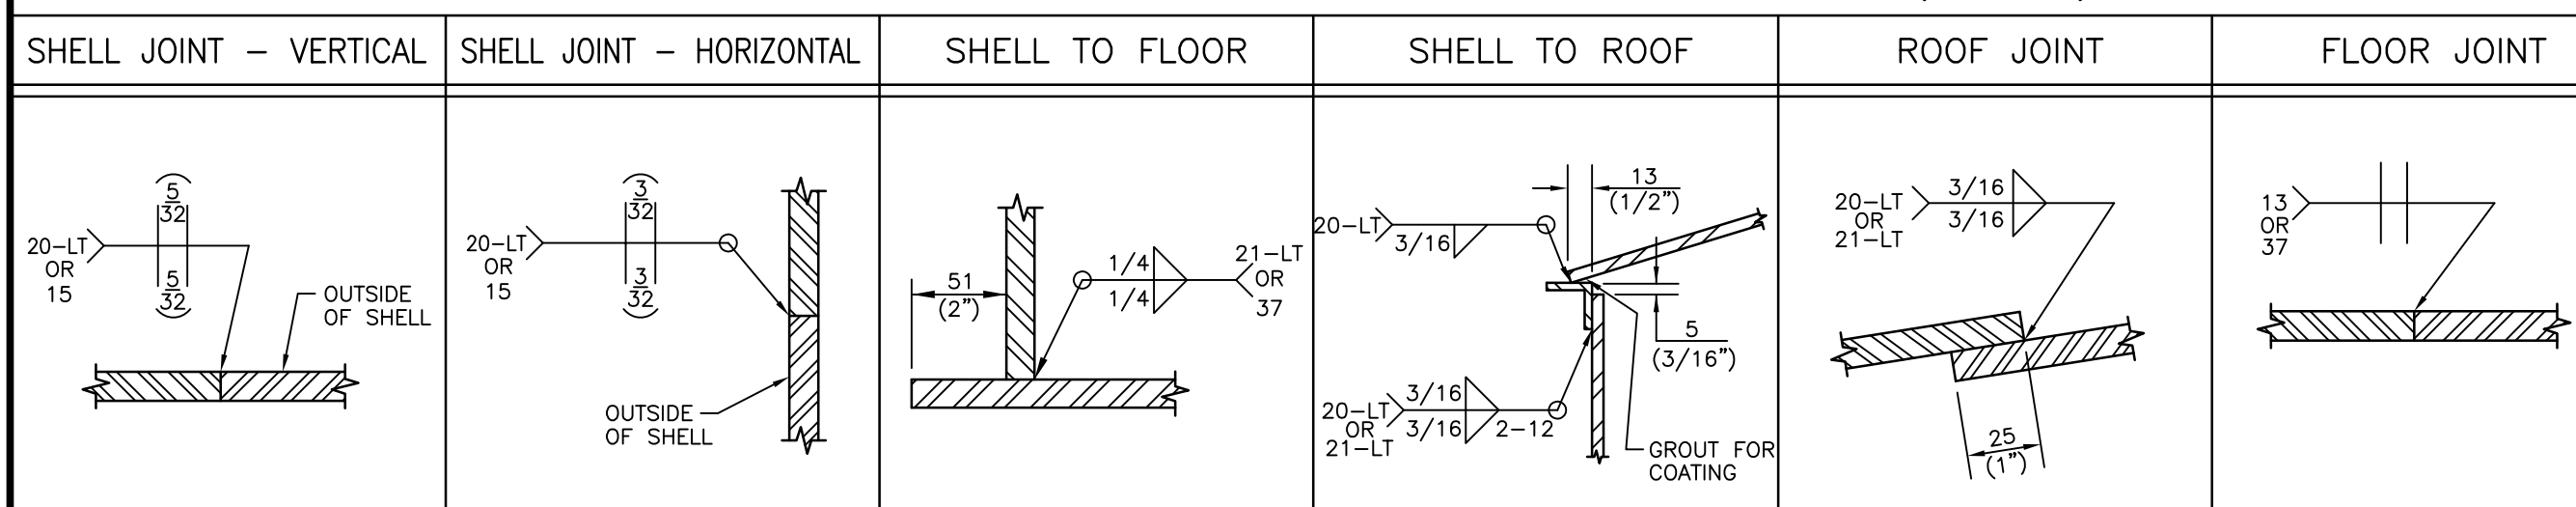

CUSTOMER SPECIFICATIONS

DESIGN CODE: API-650 MODIFIED
SERIAL NO: 028328-1 & 3
DESIGN PRESSURE: 12 oz. PRESS. / 0.4 oz. VAC.
DESIGN TEMPERATURE: -13°C(8.6°F) TO 93°C(200°F)
OPERATING TEMPERATURE: _____
SERVICE: _____
OPERATING LEVEL: _____
CORROSION ALLOWANCE: NONE
OTHER: _____

FINISHING

INTERNAL: SANDBLAST TANK SHELL, FLOOR & ROOF TO SSPC-SP5, APPLY 12-16mils DFT OF DEVOE 253HS, 2 COAT SYSTEM (OR EQUIVALENT). REMOVABLE INTERNAL PIPING TO BE UNCOATED C.S.
EXTERNAL: NONE
TESTING: AIR TEST AS PER API-650 7.3.7.1(a) TO 18.0 oz. (SPOT X-RAY, BY OTHERS)
FLOOR SEAMS TO BE VACUUM TESTED.
100% MAG. PARTICLE ON SHELL TO FLOOR EXTERNAL AND INTERNAL FILLET WELDS.
100% MAG. PARTICLE ON FIRETUBE FLANGE TO PIPE WELDS AND RANDOM SPOT X-RAY.
FIRETUBES TO BE HYDROTESTED AT 15 PSIG FOR 10 MINUTES.
AIR TEST ALL REPADS TO 15 PSIG.
INSULATION: 51(2") URETHANE SPRAY FOAM INSULATION TO ENTIRE TANK SHELL & ROOF. ADDITIONAL 3" OF INSULATION ON ROOF AND 1" DOWN FROM TOP OF SHELL. FINISH WITH 20-25 MILS DFT BLACK ELASTOMERIC SEALER.

- MODIFICATION SUMMARY
- ADDED N13 NOZZLE.
 - ADDED N14a,b NOZZLES.
 - ADDED N15 NOZZLE.
 - ADDED N16a-d NOZZLES.
 - ADDED N17 NOZZLE.
 - ADDED N18 NOZZLE.
 - ADDED INTERNAL RISER AND SUPPORTS TO N13 NOZZLE TO ELEVATION OF 6772mm.
 - ADDED ANODE SUPPORTS TO N16a-d NOZZLES.
 - ADDED ENARDO PVRV, MODEL# 950-3-1113-Z8.0/20.4-C-F
 - ADDED ENARDO EPRV, MODEL# 2020-21T-1-Z11.5-101
 - REMOVED OLD INTERNAL SAMPLE LINES AND INSTALLED NEW INTERNAL SAMPLE LINES C/W SUPPORTS FOR C3c-e
 - LOWERED ELEVATION OF N2 RISER TO 5300mm FROM 6483mm AND SWAPPED WITH N8 INTERNAL SPOOL.
 - CHANGED N9 FLANGES TO CLASS 300.
 - TURNED EXISTING N9 INTERNAL 90° ELBOW TO SIDEWAYS FOR CENTRIFUGAL MOTION.
 - AIR TESTED REPADS, LP OUTSIDE OF NOZZLE FLANGE TO PIPE WELD JOINT AND LP OUTSIDE OF NON REPADED NOZZLE/COUPLING TO SHELL WELD JOINTS.
 - REPAIRED INTERNAL COATING AND INSULATION USING SCAFFOLDING.
 - BLASTED ALL THE INTERNAL PIPING (INSIDE AND OUTSIDE OF SPOOLS) TO SSPC-SP5 AND APPLIED 12-16 mils DFT OF DEVOE 253.

TYP. SHELL COUPLING DETAIL
SCALE 1:10

SCALE 1:10

NOZZLE SCHEDULE

MK	NO	SIZE	SCH	RATE	TYPE	PROJECTION		REPAD		DESCRIPTION
						INT.	EXT.	YES	NO	
N2	1	219 8"	STD	CLASS 150	RFSO	203 8"	203 8"	✓		SPILL OVER OUTLET C/W INTERNAL RISER
N3	1	60 2"	STD	CLASS 150	RFSO	FLUSH	254 10"		✓	TANK LEVEL
N4	a	114 4"	XS	CLASS 150	RFSO	25 1"	356 1-2"		✓	DRAIN C/W GATE VALVE (IN VAULT)
N4	b	114 4"	XS	CLASS 150	RFSO	25 1"	203 8"	✓		STINGER
N5	1	89 3"	STD	CLASS 150	RFSO	AS SHOWN	152 6"	✓		WATER OUTLET C/W BALL VALVE BY OTHERS & DOWNCOMER (IN VAULT)
N6	1	89 3"	STD	CLASS 150	RFSO	AS SHOWN	152 6"	✓		OIL UNLOADING C/W BALL VALVE BY OTHERS, RISER & VORTEX BREAKER (IN VAULT)
N7	1	89 3"	STD	CLASS 150	RFSO	AS SHOWN	152 6"	✓		WATER OUTLET C/W DOWNCOMER (IN VAULT)
N8	1	219 8"	STD	CLASS 150	RFSO	203 8"	203 8"	✓		SPILL OVER INLET FROM PROD. TANK C/W INTERNAL DOWNCOMER & 90° ELBOW
N9	1	89 3"	XS	CLASS 3000	RFSO	152 6"	203 8"	✓		INLET C/W INTERNAL FLANGE & ELBOW TURNING SIDEWAY
N10	1	89 3"	STD	CLASS 150	RFSO	152 6"	203 8"	✓		FUTURE OIL OUTLET TO TRANSFER PUMP C/W RISER & VORTEX BREAKER
N11	1	114 4"	STD	CLASS 150	RFSO	152 6"	203 8"	✓		INCINERATOR C/W INTERNAL RISER (C.S.)
N12	1	114 4"	STD	CLASS 150	RFSO	25 1"	203 8"	✓		FG/BLANKET
C3	5	25 1"	-	CLASS 3000	FULL CPLG	HALF	HALF	✓		SAMPLE CONNECTIONS C/W SPRING LOADED BALL VALVES (IN VAULT)
C5	1	51 2"	-	CLASS 3000	S.S. FULL CPLG	HALF	HALF	✓		LEVEL INDICATOR (HAWKEYE - REDTAIL)
C5	2	32 1 1/4"	-	CLASS 3000	S.S. FULL CPLG	HALF	HALF	✓		FLOAT GUIDE WIRES
C6	2	19 3/4"	-	CLASS 3000	S.S. FULL CPLG	HALF	HALF	✓		TI (0°C - 100°C)
C7	1	25 1"	-	CLASS 3000	S.S. FULL CPLG	HALF	HALF	✓		TC C/W PLUG (FUTURE)
C8	1	19 3/4"	-	CLASS 3000	S.S. FULL CPLG	HALF	HALF	✓		TI (200°F - 1000°F) STACK
C10	1	19 3/4"	-	CLASS 3000	S.S. FULL CPLG	HALF	HALF	✓		STACK SPARE C/W PLUG
C11	1	19 3/4"	-	CLASS 3000	S.S. FULL CPLG	HALF	HALF	✓		BURNER MAINTENANCE C/W PLUG
T1	1	219 8" STD	-	FAB'D	25 1"	229 9"	229 9"	✓		THIEF HATCH c/w HAWKEYE (MARSH HAWK)
M1	1	610/219 2"x4"	-	FAB'D	25 1"	102 4"	102 4"	✓		SHELL MANWAY (SPLIT DOOR)
F1	1	254 10"	-	FAB'D	AS-SHOWN	152 6"	152 6"	✓		THROAT NOZZLE FOR 10" REMOVABLE FIRETUBE
N13	1	89 3"	XS	CLASS 150	RFSO	152 6"	203 8"	✓		SKIM NOZZLE C/W INTERNAL RISER (C.S.)
N14	9.b	2 114 4"	XS	CLASS 150	RFSO	25 1"	356 1-2"		✓	STINGER
N15	1	60 2"	XS	CLASS 150	RFSO	25 1"	203 8"		✓	LLSD
N16	4	114 4"	XS	CLASS 150	RFSO	25 1"	203 8"	✓		ANODE CONNECTION C/W SUPPORT
N17	1	89 3"	STD	CLASS 150	FFSO	25 1"	254 10"	✓		PVRV C/W ENARDO MODEL 950-3-1113-Z8.0/20.4-C-F
N18	1	508 20"	STD	CLASS 150	FFSO	25 1"	356 1-1/2"	✓		EPRV C/W ENARDO MODEL 2020-21T-1-Z11.5-101

MATERIAL LIST

MK	QTY	DESCRIPTION	MATERIAL	WT
1	2	FLOOR PLATE (HALF) 1/4" THK. x 15'-7 1/2" DIA. (G40.21-38W)	PRT-2425	1956
2	2	ROOF PLATE (HALF) 3/16" THK. x 15'-9 1/8" FLAT DIA. (G40.21-38W)	PRT-6996	1452
3	4	SHELL PLATE 1/4" THK. x 8'-0" x 47'-11 11/16" LG.	G40.21-38W	15674
4				
5				
6				
7	1	RUNAROUND ANGLE 2" x 2" x 3/16" x 48'-6 3/8" LG.	G40.21-44W	118
8	1	STACK 8" THIN WALL (NO DAMPER)	T-028328-B106	-
9	1	UPPER & LOWER LADDER (CWB STYLE)	PRT-6997 PRT-7002	404
10				
11	1	BURNER CONTROL BOX (2'-0" HIGH x 2'-6" LG. x 8" DEEP)	ALUMINUM	-
12	1	HAWKEYE REDTAIL LEVEL INDICATOR ASSY C/W GAUGE HEAD, METRIC BOARD, PVC FLOAT GUIDE WIRES, FLOOR CLIPS, CABLE TIGHTENERS & MISC. HARDWARE	REF. DWG. T-028328-B111	111
13	4	LIFTING LUG	PRT-4275	30
14	1	SERVICE LUG C/W REPAD	PRT-4276	10
15	1	SHELL MANWAY 2'-0" x 4'-0" C/W 1/4" SPLIT COVER	PRT-1221 PRT-1492	191
16	1	NAMEPLATE BRACKET C/W NAMEPLATE	PRT-2896	5
17	6	TANK HAULING PAD (1/4" - 6" DEEP)	REF. DWG. T-028328-A108	180
18	1	NOZZLE DETAIL	REF. DWG. T-028328-D102	390
19	1	FIRETUBE REMOVABLE U-TUBE 10" SCH STD. (EXTENDED LENGTH) 750,000 BTU/HR.	REF. DWG. T-028328-B106	1986
20	1	CHANNEL C4 x 5.4# x 7'-6 11/16" LG.	G40.21-44W	41
21	1	THIEF HATCH NOZZLE C/W HAWKEYE (MARSH HAWK)	REF. DWG. T-028328-A110	21
22	1	FIRETUBE HOLD-DOWN FOR 10" U-TUBE	PRT-6992	13
23	1	CHANNEL C4 x 5.4# x 15'-2 5/8" LG.	G40.21-44W	82
24	4	REPAD PLATE 1/4" THK. x 6" DIA.	G40.21-38W	4
25				
26				
27	1	INTERMEDIATE PLATFORM C/W SAFETY GATE	PRT-6999	229
28	3	HALF COUPLING 1/4" CL. 3000 F.S. SCR'D	SA-105	1
29	1	N2 NOZZLE & INTERNAL RISER DETAILS	REF. DWG. T-028328-A104	627
30				
31	1	ENVIRO-VAULT WALL/ROOF DETAILS (6' WIDE x 5' HIGH)	REF. DWG. T-028328-A109	759
32				
33	1	N11 NOZZLE & INTERNAL RISER DETAILS	REF. DWG. T-028328-B115	481
34	1	ENVIRO-VAULT DOOR DETAILS	REF. DWG. T-028328-C112	73
35	1	N8, N9 & N10 NOZZLE & INTERNAL RISER DETAILS	REF. DWG. T-028328-B105	312
36				
37	1	FULL COUPLING 1" CL. 3000 F.S. SCR'D	SA182-F316L S.S.	1
38	1	FULL COUPLING 2" CL. 3000 F.S. SCR'D	SA182-F316L S.S.	3
39	2	FULL COUPLING 1 1/4" CL. 3000 F.S. SCR'D	SA182-F316L S.S.	3
40				
41				
42	1	GROUNDING LUG	REF. DWG. T-028328-A114	3
43				
44	1	HEX PLUG 1" CL.3000 F.S. THR'D	SA-105	1
45	1	NOZZLE DETAIL (MODIFICATION)	REF. DWG. W03-066731-D102	1173
46	1	ANODE ROLLER SUPPORT DETAIL	REF. DWG. W03-066731-A103	60
47				
48				
49				
50				
51	1	CLIP GATE VALVE 2"	-	-
52	1	PIPE 2" SCH XS x 6" LG. SMLS TOE x 45° MITER	SA-106-B	2
53	2	TEMPERATURE GAUGE 4" FACE x 1'-0" LG. STEM x 1/2" NPT. CONN. (-20°C - 120°C) RANGE	-	1
54	1	SAFETY GATE	REF. DWG. T-028328-B113	11
55	4	TANK ROOF SAFETY HARNESS LUG (EXTENDED)	REF. DWG. T-028328-A116	8

*QTY'S ARE FOR ONE TANK - 2 REQ'D SUBTOTAL 21859 x 1.06 = 23171 lbs. TOTAL

19/05/20	AS-BUILT, CHANGED NOTE 15 IN MODIFICATION SUMMARY	RR	TZ
19/12/19	ISSUED FOR CONSTRUCTION	RR	TZ
09/12/19	ISSUED FOR CUSTOMER APPROVAL	RR	TZ

NO	DATE (d/m/y)	REVISIONS	BY	APPD
----	--------------	-----------	----	------


THIS DRAWING IS THE PROPERTY OF FOREMOST UNIVERSAL LP. AND IS TO BE USED ONLY IN CONNECTION WITH WORK BY FOREMOST UNIVERSAL LP. REPRODUCTION OR USE OF IN WHOLE OR IN PART FOR ANY OTHER PURPOSE IS EXPRESSLY FORBIDDEN.

FOREMOST

CLIENT: HUSKY OIL OPERATIONS LTD.
C/O BAR ENGINEERING
SANDALL BOTTOM WATER DE-PRESSURIZATION
P.O. # 8401416112

DWG TITLE: 1000 BBL SALES TANK - SOUR VERSION GENERAL ARRANGEMENT (MODIFICATION)			
SIZE: 4648mm I.D. x 9754mm HIGH (15'-3" I.D. x 32'-0" HIGH)	VOLUME: 159 CU. METERS (1000 Bbl)	DWG NO.: W03-066731-D101	SHEET NO. (REV. NO.): 1 of 1
SCALE: 1:30	DWN BY: R. RANASINGHE	DATE (d/m/y): 27/11/19	CHKD: GLB APPD: TZ 19/05/20 19/05/20

PROJECTS\W03-066731\W03-066731-D101

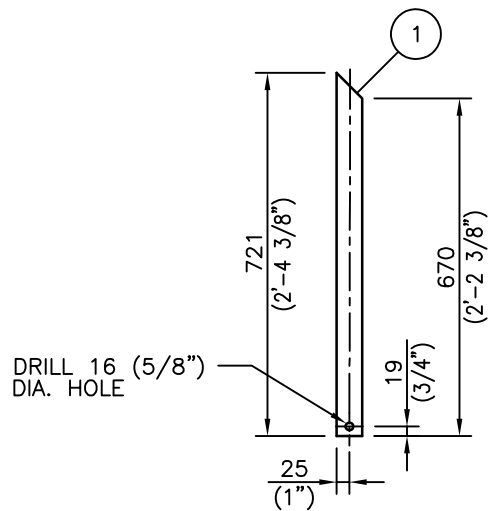


MK.#1 DETAIL

MATERIAL REQUIREMENTS						
M (MTR's):		NONE				
I (IMPACT TESTING):		NONE				
C (CHEMISTRY):		NONE				
MK	QTY	PART NO.	DESCRIPTION	CUT LENGTH	MAT'L	WT
1	2	2111	FLATBAR 1/4" THK. x 2" WIDE	721	SA479-316L S.S.	8
2	1	4190	ROLLER ASS'Y	-	WOOD	2
3	1	2521	REPAD PLATE 1/4" THK. x 9" DIA.	-	G40.21-38W	5
4						
5						


SUBTOTAL	15
x 1.06	
TOTAL (lbs.)	16

NOTES:

- ALL DIMENSIONS ARE IN S.I. AND IMPERIAL UNITS. DIMENSIONS IN BRACKETS ARE IMPERIAL HARD CONVERSIONS FOR SHOP REFERENCE ONLY.

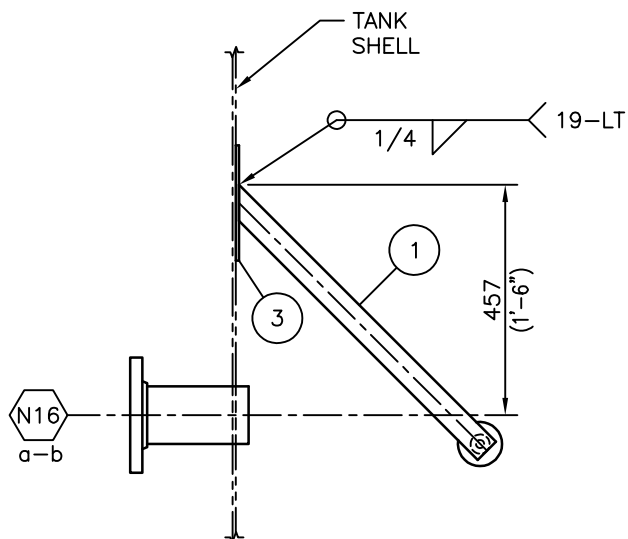


INSTALLATION DETAIL

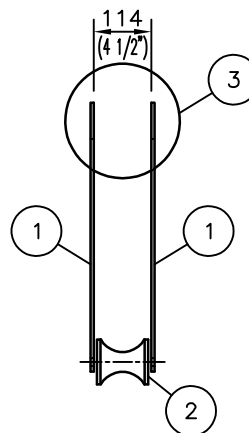

ROLLER ASSEMBLY

1	19/05/20	AS-BUILT, NO CHANGE	RR	TZ
0	19/12/19	ISSUED FOR CONSTRUCTION	RR	TZ
NO.	DATE (d/m/y)	REVISIONS	BY	APPD
THIS DRAWING IS THE PROPERTY OF FOREMOST UNIVERSAL LP AND IS TO BE USED ONLY IN CONJUNCTION WITH PERFORMANCE OF WORK BY FOREMOST UNIVERSAL LP. REPRODUCTION OR USE OF IN WHOLE OR IN PART FOR ANY OTHER PURPOSE IS EXPRESSLY FORBIDDEN.				
FOREMOST				
CLIENT		HUSKY OIL OPERATIONS LTD. C/O BAR ENGINEERING		
DWG TITLE		1000 BBL SALES TANK - SOUR VERSION ANODE ROLLER SUPPORT DETAILS		
NO. REQ'D 4 PER TANK (8 TOTAL)		WO. NO. 03-066731	LEG NO.	
SCALE 1:15	DWN BY R. RANASINGHE	DWG NO. W03-066731-A103	SHT NO. 1 OF 1	REV 1
DATE (d/m/y) 17/12/19	CHKD GLB 19/05/20	APPD TZ 19/05/20		

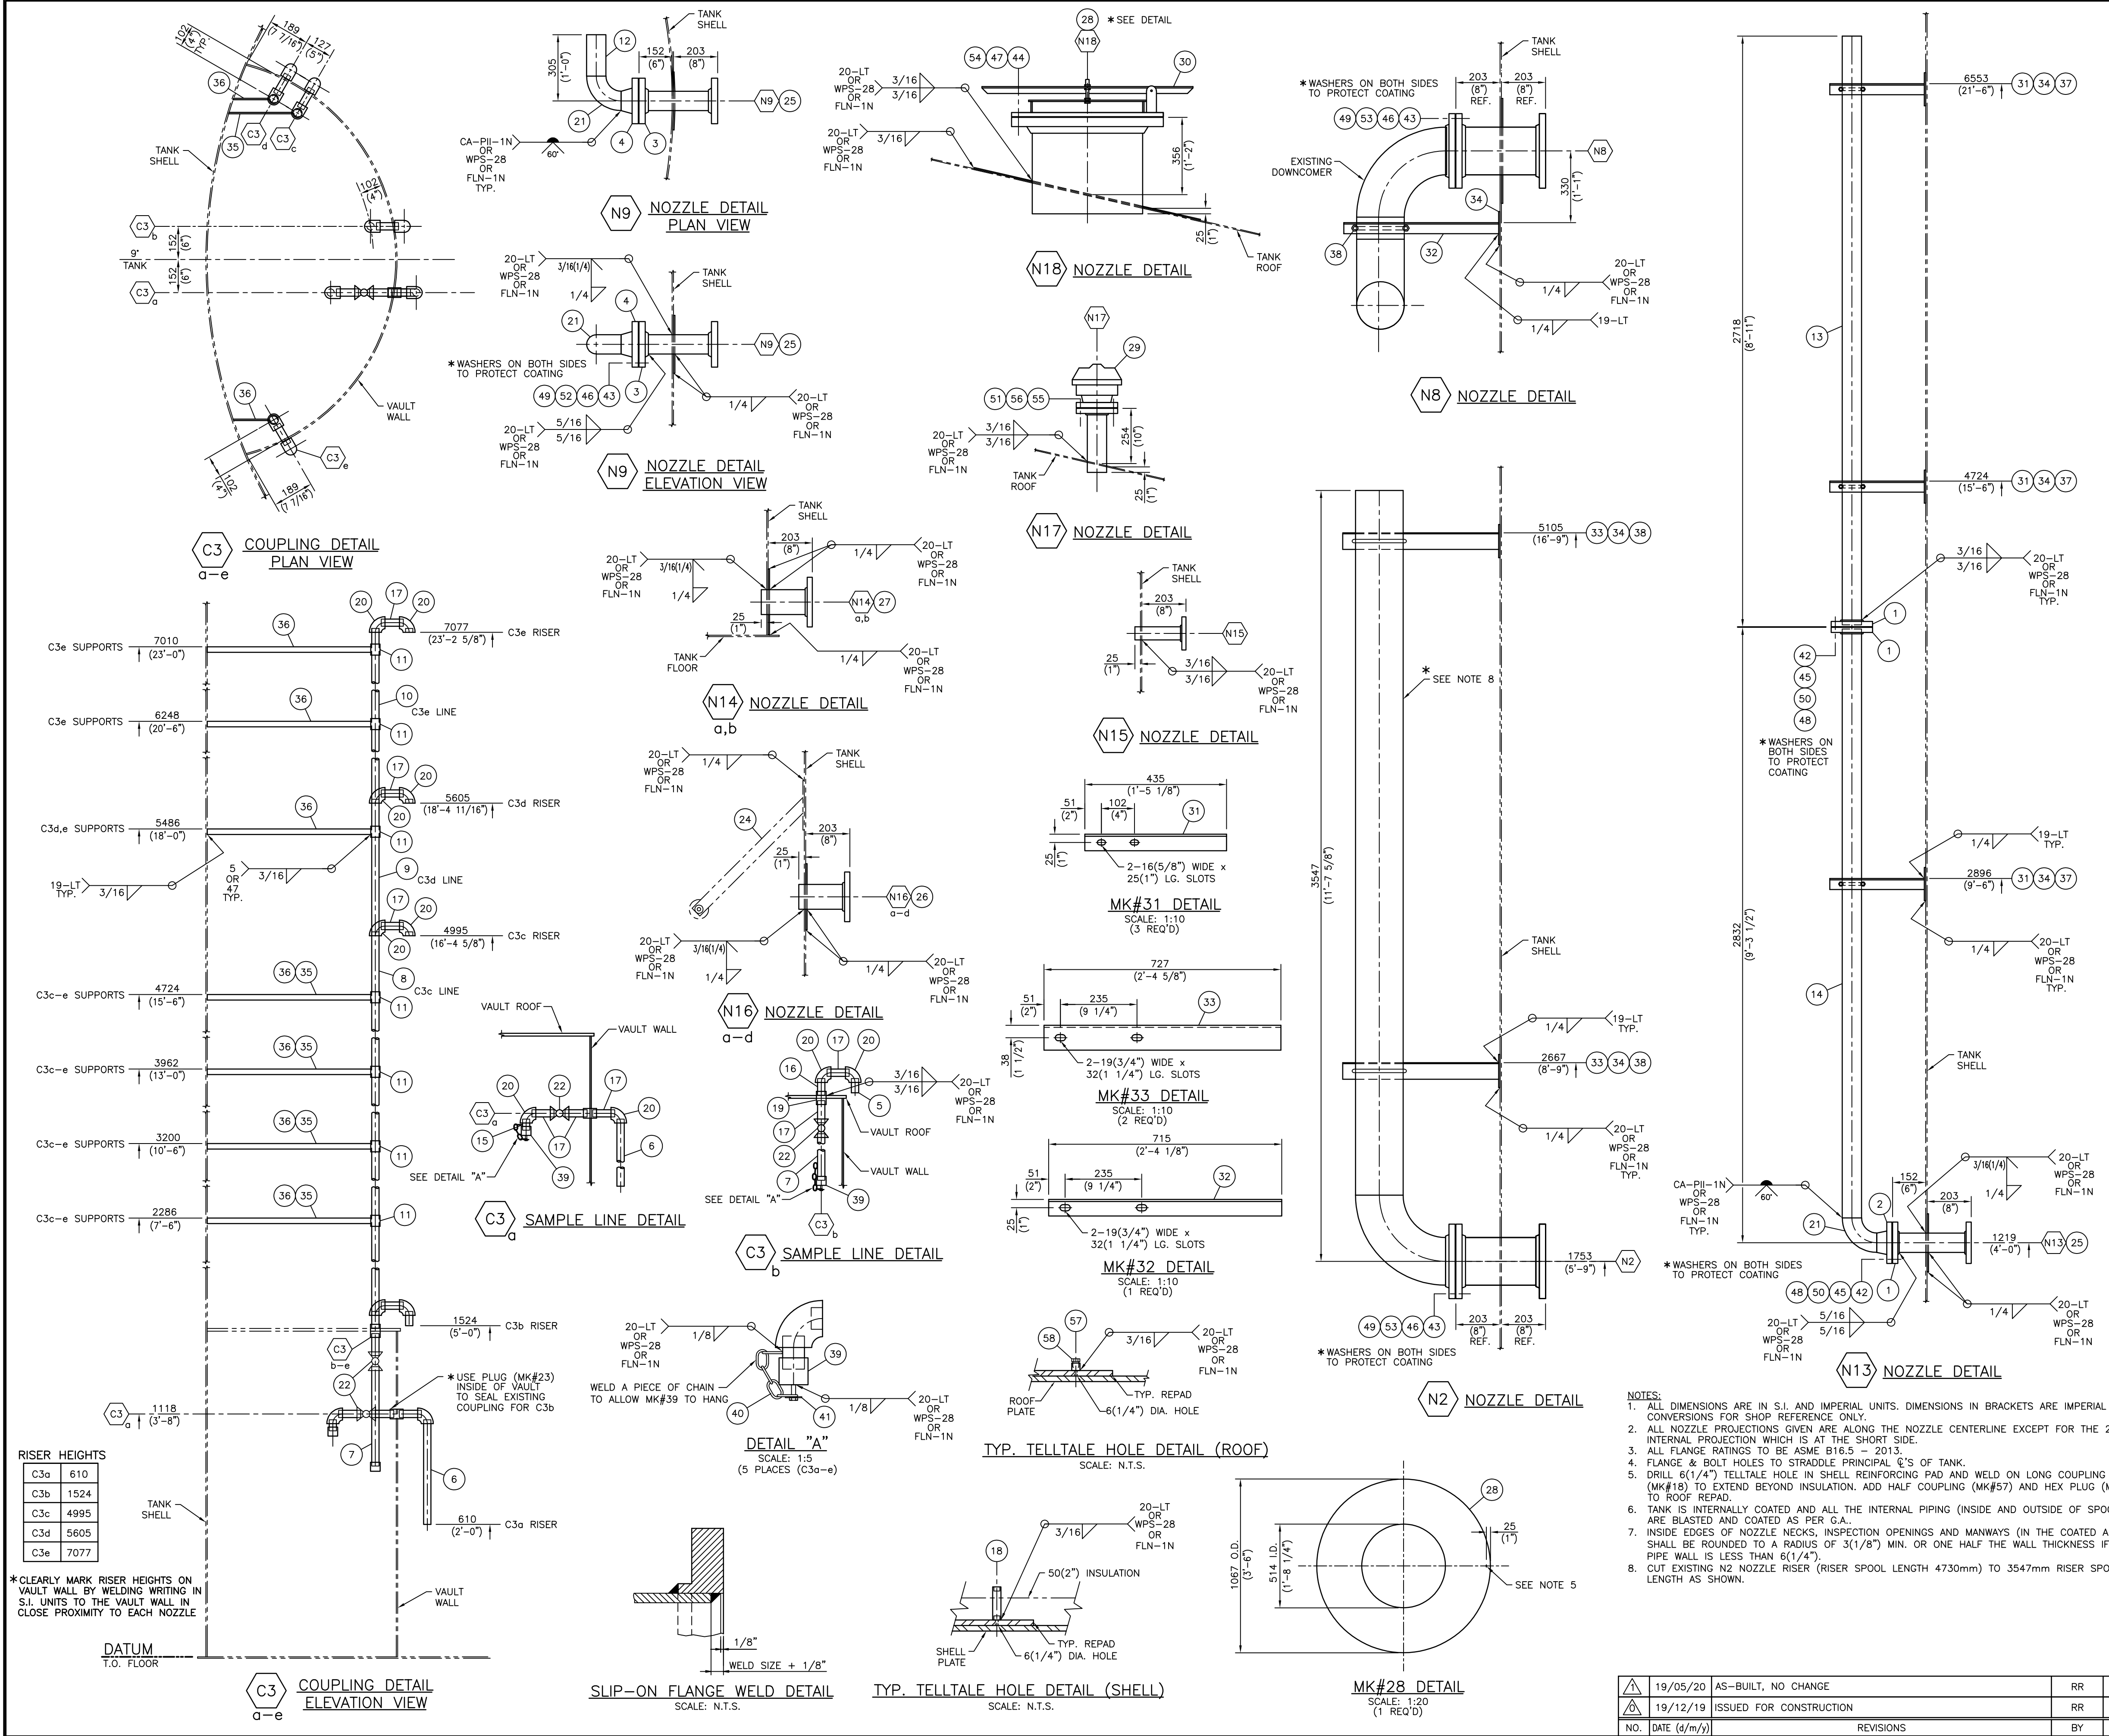

MATERIAL LIST									
MATERIAL REQUIREMENTS									
M (MTR's):	NONE								
I (IMPACT TESTING):	NONE								
C (CHEMISTRY):	NONE								
MK	QTY	PART NO.	DESCRIPTION	CUT LENGTH	MATERIAL	WT	MAT REQ		
1	3	1329	FLANGE 3" CLASS 150 RF50	—	SA-105N	27	—		
2	1	1122	FLANGE 3" CLASS 150 RFWN x SCH STD BORE	—	SA-105N	12	—		
3	1	9606	FLANGE 3" CLASS 300 RF50	—	SA-105N	13	—		
4	1	1435	FLANGE 3" CLASS 300 RFWN x SCH STD BORE	—	SA-105N	16	—		
5	1	2182	PIPE 1" SCH XS SMLS POE x TOE	65	SA-106-B	1	—		
6	1	2182	PIPE 1" SCH XS SMLS POE x TOE	481	SA-106-B	3	—		
7	4	2182	PIPE 1" SCH XS SMLS TBE	457	SA-106-B	13	—		
8	1	2182	PIPE 1" SCH XS SMLS TBE	3500	SA-106-B	25	—		
9	1	2182	PIPE 1" SCH XS SMLS TBE	4110	SA-106-B	29	—		
10	1	2182	PIPE 1" SCH XS SMLS TBE	5582	SA-106-B	40	—		
11	16	—	PIPE 1 1/4" SCH 40S "WELDED" PBE	51	SA312-TP316L SS	6	—		
12	1	2234	PIPE 3" SCH STD SMLS BOE x ROE	191	SA-106-B	5	—		
13	1	2234	PIPE 3" SCH STD SMLS POE x ROE	2710	SA-106-B	68	—		
14	1	2234	PIPE 3" SCH STD SMLS POE x BOE	2710	SA-106-B	68	—		
15	1	1164	NIPPLE 1" SCH XS x 2" LG. SMLS TBE	—	SA-106-B	1	—		
16	1	1327	NIPPLE 1" SCH XS x 3" LG. SMLS TBE	—	SA-106-B	1	—		
17	11	1250	NIPPLE 1" SCH XS x 4" LG. SMLS TBE	—	SA-106-B	8	—		
18	9	21510	LONG CPLG. 1/4" x 3000# F.S. SCR'D x 3" LG.	—	SA-105N	2	—		
19	1	1260	FULL CPLG. 1" 3000# F.S. SCR'D	—	SA-105N	1	—		
20	10	1879	ELBOW 1" 3000# x 90° F.S. SCR'D	—	SA-105N	4	—		
21	2	1593	ELBOW 3" SCH STD x 90° L.R.	—	SA-234-WPB	10	—		
22	5	6514	BALL VALVE 1" 2000# WOG RP CS	—	—	10	—		
23	1	1330	HEX PLUG 1" 3000# F.S. THR'D	—	SA-105N	1	—		
24	4	—	ANODE ROLLER SUPPORT DETAIL	—	—	—	—		
25	2	1586	REPAD PLATE 1/4" THK. - 3" SHELL NOZZLE	—	G40.21-38W	10	—		
26	4	1540	REPAD PLATE 1/4" THK. - 4" SHELL NOZZLE	—	G40.21-38W	28	—		
27	2	4393	DOGHOUSE REPAD PLATE 1/4" THK. - 4" SHELL NOZZLE	—	G40.21-38W	16	—		
28	1	3108	REPAD PLATE 3/16" THK. 1'-8 1/4" I.D. x 3'-6" O.D.	—	G40.21-38W	57	—		
29	1	—	ENARDO PVRG, MODEL # 950-3-1113-28.0/Z0.4-C-F	—	—	15	—		
30	1	—	ENARDO EPRV, MODEL # 2020-21T-1-Z11.5-1D1	—	—	30	—		
31	3	7023	ANGLE 2" x 2" x 1/4"	435	SA479-316L S.S.	23	—		
32	1	7023	ANGLE 2" x 2" x 1/4"	715	SA479-316L S.S.	8	—		
33	2	10833	ANGLE 3" x 3" x 1/4"	727	SA479-316L S.S.	24	—		
34	6	5948	REPAD PLATE 1/4" THK. x 6" DIA.	—	G40.21-38W	12	—		
35	4	10356	FLATBAR 1/4" x 1"	300	SA479-304L S.S.	3	—		
36	12	10356	FLATBAR 1/4" x 1"	170	SA479-304L S.S.	6	—		
37	3	1698	U-BOLT 1/2" x 3" NPS C/W NUTS	—	S.S.	6	—		
38	3	1681	U-BOLT 5/8" x 8" NPS C/W NUTS	—	S.S.	12	—		
39	5	2384	PIPE CAP 1" 3000# F.S. THR'D	—	SA-105N	5	—		
40	5	—	CHAIN LIGHT DUTY 3/16" x 6" LG.	—	GR.30 C.S.	2	—		
41	5	—	BOLT 1/4" DIA. x 1" LG. C/W FLAT WASHER	—	GR. 5	1	—		
42	8	1788	STUD 5/8" DIA. x 4 1/4" LG.	—	SA-193-BBM (316 S.S.)	2	—		
43	24	11517	STUD 3/4" DIA. x 5" LG.	—	SA-193-BBM (316 S.S.)	15	—		
44	20	—	STUD 1 1/8" DIA. x 7 1/4" LG.	—	SA-193-B7 (316 S.S.)	40	—		
45	16	1787	HEAVY HEX NUT 5/8" NOM.	—	SA-194-BM (316 S.S.)	1	—		
46	48	1851	HEAVY HEX NUT 3/4" NOM.	—	SA-194-BM (316 S.S.)	4	—		
47	40	1806	HEX NUT 1 1/8" NOM.	—	SA-194-2H	8	—		
48	16	1852	WASHER 5/8" NOM.	—	S.S.	1	—		
49	48	1709	WASHER 3/4" NOM.	—	S.S.	1	—		
50	2	11740	GASKET 3" CLASS 150 RF x 1/8" THK.	—	LINEBACKER	2	—		
51	1	—	GASKET 3" CLASS 150 FF x 1/8" THK.	—	LINEBACKER	1	—		
52	1	11766	GASKET 3" CLASS 300 RF x 1/8" THK.	—	LINEBACKER	1	—		
53	2	11743	GASKET 8" CLASS 150 RF x 1/8" THK.	—	LINEBACKER	2	—		
54	1	—	GASKET 20" CLASS 150 FF x 1/8" THK.	—	LINEBACKER	1	—		
55	4	1848	STUD 5/8" DIA. x 4 1/4" LG.	—	SA-193-B7	1	—		
56	8	1802	HEX NUT 5/8" NOM.	—	SA-194-2H	1	—		
57	1	1926	HALF CPLG. 1/4" 3000# F.S. SCR'D	—	SA-105N	1	—		
58	1	1288	HEX PLUG 1/4" 3000# F.S. THR'D	—	SA-105N	1	—		
						TOTAL	747		

THIS DRAWING IS THE PROPERTY OF FOREMOST UNIVERSAL LP AND IS TO BE USED ONLY IN CONJUNCTION WITH PERFORMANCE OF WORK BY FOREMOST UNIVERSAL LP. REPRODUCTION OR USE OF IN WHOLE OR IN PART FOR ANY OTHER PURPOSE IS EXPRESSLY FORBIDDEN.

FOREMOST


CLIENT
HUSKY OIL OPERATIONS LTD.
C/O BAR ENGINEERING
SANDALL BOTTOM WATER DE-PRESSURIZATION
P.O.# 8401416112

DWG TITLE
1000 BBL SALES TANK - SOUR VERSION
NOZZLE DETAIL (MODIFICATION)


NO. REQ'D 2	WO. NO. 03-066731	LEG. NO.
SCALE 1:15	DWN BY R. RANASINGHE	SHEET NO. REV. NO. 1 of 2
DATE (d/m/y) 11/12/19	CHKD 19/05/20	APPD 19/05/20
DWG NO. W03-066731-D102		

- NOTES:
- ALL DIMENSIONS ARE IN S.I. AND IMPERIAL UNITS. DIMENSIONS IN BRACKETS ARE IMPERIAL HARD CONVERSIONS FOR SHOP REFERENCE ONLY.
 - ALL NOZZLE PROJECTIONS GIVEN ARE ALONG THE NOZZLE CENTERLINE EXCEPT FOR THE 25(1") INTERNAL PROJECTION WHICH IS AT THE SHORT SIDE.
 - ALL FLANGE RATINGS TO BE ASME B16.5 - 2013.
 - FLANGE & BOLT HOLES TO STRADDLE PRINCIPAL C'S OF TANK.
 - DRILL 6(1/4") TELLTALE HOLE IN SHELL REINFORCING PAD AND WELD ON LONG COUPLING (MK#18) TO EXTEND BEYOND INSULATION. ADD HALF COUPLING (MK#57) AND HEX PLUG (MK#58) TO ROOF REPAD.
 - TANK IS INTERNALLY COATED AND ALL THE INTERNAL PIPING (INSIDE AND OUTSIDE OF SPOOLS) ARE BLASTED AND COATED AS PER G.A..
 - INSIDE EDGES OF NOZZLE NECKS, INSPECTION OPENINGS AND MANWAYS (IN THE COATED AREA) SHALL BE ROUNDED TO A RADIUS OF 3(1/8") MIN. OR ONE HALF THE WALL THICKNESS IF THE PIPE WALL IS LESS THAN 6(1/4").
 - CUT EXISTING N2 NOZZLER RISER (RISER SPOOL LENGTH 4730mm) TO 3547mm RISER SPOOL LENGTH AS SHOWN.

19/05/20	AS-BUILT, NO CHANGE	RR	TZ
19/12/19	ISSUED FOR CONSTRUCTION	RR	TZ
NO.	DATE (d/m/y)	REVISIONS	BY

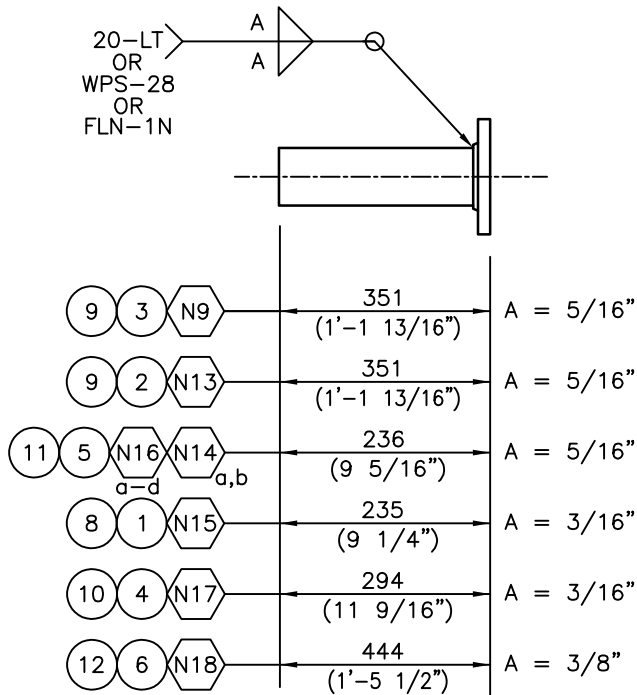

NOZZLE SPOOL DETAIL

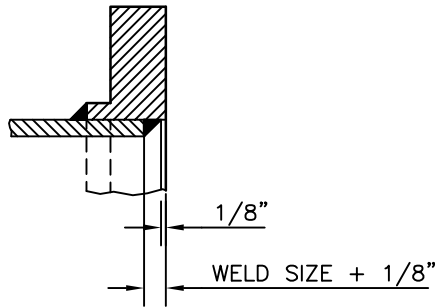

SLIP-ON FLANGE WELD DETAIL
N.T.S.

- NOTES:
1. ALL DIMENSIONS ARE IN S.I. AND IMPERIAL UNITS. DIMENSIONS IN BRACKETS ARE IMPERIAL HARD CONVERSIONS FOR SHOP REFERENCE ONLY.
 2. ALL FLANGE RATINGS TO BE ASME B16.5 - 2013.
 3. TAG SPOOLS WITH TANK # AND NOZZLE #.

MATERIAL REQUIREMENTS							
M (MTR's):		NONE					
I (IMPACT TESTING):		NONE					
C (CHEMISTRY):		NONE					
MK	QTY	PART NO.	DESCRIPTION	CUT LENGTH	MAT'L	WT	MAT REQ
1	1	1349	FLANGE 2" CLASS 150 RFSO	—	SA-105N	5	—
2	1	1329	FLANGE 3" CLASS 150 RFSO	—	SA-105N	9	—
3	1	9606	FLANGE 3" CLASS 300 RFSO	—	SA-105N	13	—
4	1	1322	FLANGE 3" CLASS 150 FFSO	—	SA-105N	9	—
5	6	1462	FLANGE 4" CLASS 150 RFSO	—	SA-105N	72	—
6	1	—	FLANGE 20" CLASS 150 FFSO	—	SA-105N	155	—
7							
8	1	2218	PIPE 2" SCH XS SMLS POE x ROE	227	SA-106-B	4	—
9	2	2237	PIPE 3" SCH XS SMLS PBE	340	SA-106-B	23	—
10	1	2234	PIPE 3" SCH STD SMLS POE x ROE	287	SA-106-B	7	—
11	6	2248	PIPE 4" SCH XS SMLS POE x ROE	225	SA-106-B	66	—
12	1	—	PIPE 20" SCH STD SMLS POE x ROE	431	SA-106-B	112	—
						SUBTOTAL	475
						x 1.06	
						TOTAL (lbs.)	504

	19/05/20	AS-BUILT, NO CHANGE	RR	TZ
	19/12/19	ISSUED FOR CONSTRUCTION	RR	TZ
NO.	DATE (d/m/y)	REVISIONS	BY	APPD

THIS DRAWING IS THE PROPERTY OF FOREMOST UNIVERSAL LP AND IS TO BE USED ONLY IN CONJUNCTION WITH PERFORMANCE OF WORK BY FOREMOST UNIVERSAL LP. REPRODUCTION OR USE OF IN WHOLE OR IN PART FOR ANY OTHER PURPOSE IS EXPRESSLY FORBIDDEN.

CLIENT HUSKY OIL OPERATIONS LTD. C/O BAR ENGINEERING				
DWG TITLE 1000 BBL SALES TANK – SOUR VERSION NOZZLE SPOOL DETAILS (MODIFICATION)				
NO. REQ'D 2		WO. NO. 03-066731		LEG NO.
SCALE 1:15		DWN BY R. RANASINGHE		SHT NO.
DATE (d/m/y) 17/12/19		CHKD GLB 19/05/20	APPD TZ 19/05/20	REV 1
		DWG NO. W03-066731-D102		2 OF 2



Storage Tank
Quality / Inspection & Test Plan
Revision 0

W.O.# W03-066731

Serial Number: 028328-1

Description: 1000BBL Sales Tank – Sour Mod's

Ref	Activity Description	QC Activity Required	Acceptance Criterion	Verifying Documents	Foremost Req	Duty	Foremost Approval and Date
A. Approvals							
1.	Drawing Approvals	- Confirm fabrication drawing approvals	API-650 / 12F	Issued for Construction Drawings	H D	QC / F	<i>Sw</i> Feb 24, 2020
B. Receipt Inspection							
1.	Nozzle Pipe	- Confirm thickness, material type, dimensions and quantities as per approved drawings	Approved Drawings	This ITP	H I	QC / F	<i>hl</i> Mar 5, 2020
C. In Process Inspection							
1.	Material cutting and beveling	- Monitor correct material per drawing and traceable to the work order number	Component drawing(s)	This ITP	I / V	F	<i>hl</i> Mar 5, 2020
2.	Nozzle Prefabrication	- Confirm correct size, rating, schedule and dimensions	Nozzle drawings	This ITP	I / V	F	<i>hl</i> Mar 5, 2020
3.	Nozzle Flange Condition	- Confirm gasket surface is free from damage	ASME B16.5	This ITP	I / V	F	<i>hl</i> Mar 5, 2020
4.	Nozzle Lay-out (Shell and Roof)	- Confirm correct orientation and elevation - Confirm correct nozzle size, rating, schedule and if repad req'd	General Arrangement & Nozzle drawings	This ITP	I / V	F	<i>hl</i> Mar 5, 2020
5.	Nozzle Fit-up	- Confirm flange face is two-holed, level & square to vessel - Confirm proper external & internal projection - Confirm repad dimensions - Confirm weld joint configuration and gap	General Arrangement & Nozzle drawings	This ITP	I / V	F	<i>hl</i> Mar 5, 2020

Legend:

Requirements: I – Inspect
W – Witness
H – Hold Point
D – Documents Required
V – Verify

Duty: QC – Quality Control
F – Foreman
P – Projects








Storage Tank
Quality / Inspection & Test Plan
Revision 0

W.O.# W03-066731

Serial Number: 028328-1

Description: 1000BBL Sales Tank – Sour Mod's

Ref	Activity Description	QC Activity Required	Acceptance Criterion	Verifying Documents	Foremost Req	Duty	Foremost Approval and Date
6.	Internal Piping and Attachments	- Confirm all internal piping is installed c/w appropriate studs, nuts and gaskets, and that all pipe support and flange nuts have been tightened. - Confirm internal attachments are in correct location/position	Component drawings	This ITP	I / V	F	 Mar 5, 2020
7.	Welding Visual Examination	- Verify weld profile, appearance, size, reinforcement and contours on all welds	Component drawings and Foremost's storage tank visual inspection criteria	This ITP	I / V	QC / F	 Mar 26, 2020
D. NDE							
D.1 Liquid Penetrant Examination							
1.	Nozzle Flange to Pipe Outside Welds and Nozzle Pipe / Coupling to Shell Outside Welds	- Perform PT on all nozzle pipe to flange outside welds and on all non repaded nozzle / coupling to shell outside welds	ASME Section VIII, Annex 8, Paragraphs 8-3, 8-4 and 8-5	NDE Reports and this ITP	I D	QC / F	 Mar 5, 2020
D.2 Air Testing							
1.	Nozzle Repads	- Ensure test gauge is of proper range and condition is acceptable for the test. - Ensure test gauge calibration is current - Air / soap test nozzle repads to 15 psi - Ensure test gauge serial number is recorded on the test report	Gauge must have been calibrated within one year of the test date and API-650 Paragraph 7.3.4	Test Gauge Calibration Records, Nozzle Repad Test Reports and this ITP	I D	QC / F	 Mar 26, 2020
E. Final Inspection and Release for Coating & Insulation Repairs							
1.	Mechanical Walk Through and Release for Air Test	- Ensure tank is complete and as per the construction drawings. - Confirm all welds have been marked with welder I.D. symbols. - Confirm all internal and external welds are in accordance with Code requirements - Confirm all required NDE has been completed.	Approved for construction drawings	This ITP	H I D	QC / F	 Mar 26, 2020

Legend:

Requirements: I – Inspect
W – Witness
H – Hold Point
D – Documents Required
V – Verify

Duty: QC – Quality Control
F – Foreman
P – Projects



Storage Tank
Quality / Inspection & Test Plan
Revision 0

W.O.# W03-066731

Serial Number: 028328-1

Description: 1000BBL Sales Tank – Sour Mod's

Ref	Activity Description	QC Activity Required	Acceptance Criterion	Verifying Documents	Foremost Req	Duty	Foremost Approval and Date
G. Internal Coating (Foremost)							
1.	Test Equipment Calibration	- Confirm testing equipment is calibrated and acceptable for use	Calibration Records	This ITP	V	QC/F	BM Mar 27-20
2.	Internal Blast Profile Achieved (As Per Drawings)	- Confirm internal blast profile is in accordance with Coating Manufacturer's	Approved Drawings	Surface Preparation Section of Coating Report and this ITP	D	F	BM Mar 27-20
3.	Verify Coating Material (As Per Drawings)	- Confirm coating material is as per Client requirements	Approved Drawings and	Applied Coating Section of Coating Report and this ITP	D	F	BM Mar 27-20
4.	First Internal Coat Inspection (As Per Drawings)	- Visually inspect coating for defects, measure and record DFT.	Manufacturer's Recommendations	Applied Coating Section of Coating Report and this ITP	D	F	BM Apr. 1-20
5.	Second Internal Coat Inspection (if applicable) (As Per Drawings)	- Visually inspect coating for defects, measure and record DFT.	Manufacturer's Recommendations	Applied Coating Section of Coating Report and this ITP	D	F	N/A
6.	Final Coating Inspection	- Visually inspect coating for defects, measure and record final DFT.	Manufacturer's Recommendations	Applied Coating Section of Coating Report and this ITP	D	F	BM Apr. 1-20
7.	Holiday Testing	- Examine the entire coated surface for defects using a wet sponge type holiday detector/ or high voltage	Holiday Free	Holiday Testing Section of Coating Report and this ITP	D	F	BM Apr. 1-20
I. Insulation							
1.	Foam Urethane Thickness (As Per Drawings)	- Ensure urethane insulation thickness is no less that specified on the drawings	Approved Drawings	This ITP	V	F	BM Apr. 2-20
2.	Sealer Coverage (As Per Drawings)	- Ensure sealer coverage is even and no urethane is exposed	No Exposed Insulation	This ITP	V	F	BM Apr. 2-20

Legend:

Requirements: I – Inspect
W – Witness
H – Hold Point
D – Documents Required
V – Verify

Duty: QC – Quality Control
F – Foreman
P – Projects





Storage Tank
Quality / Inspection & Test Plan
Revision 0

W.O.# W03-066731

Serial Number: 028328-1

Description: 1000BBL Sales Tank – Sour Mod's

Ref	Activity Description	QC Activity Required	Acceptance Criterion	Verifying Documents	Foremost Req	Duty	Foremost Approval and Date
3.	Final Insulation Inspection	<ul style="list-style-type: none"> - Ensure all masking tape and poly has been removed - Ensure even trimming around appurtenances - Ensure all openings are accounted for (shell and roof couplings) 	Industry Standards	This ITP	V	F	Bm April 3-20
J. Preparation for Shipment							
1.	Preparation for Shipment	<ul style="list-style-type: none"> - Ensure tank internal has been swept and free of debris - Ensure all enviro vault internal / external piping, applicable valves and riser labeling have been installed - Ensure all accessories have been installed on and in the tank in accordance with the approved drawings - Ensure burner flange, stack, couplings and all nozzles have appropriate blinds, shipping covers or plugs installed 	Approved Drawings	This ITP	H I	QC / P	 Apr 6, 2020
K. Documentation							
1.	Document Review and Retention	<ul style="list-style-type: none"> - Confirm all documents required for the turnover package have been checked for accuracy and completeness - Ensure data package is scanned and saved electronically by tank serial number 	Approved Drawings Project Specifications	Approved Data Package	H I D	QC	 Apr 6, 2020

Legend:

Requirements: I – Inspect
 W – Witness
 H – Hold Point
 D – Documents Required
 V – Verify

Duty: QC – Quality Control
 F – Foreman
 P – Projects



Storage Tank
Quality / Inspection & Test Plan
Revision 0

W.O.# W03-066731

Serial Number: 028328-3

Description: 1000BBL Sales Tank – Sour Mod's

Ref	Activity Description	QC Activity Required	Acceptance Criterion	Verifying Documents	Foremost Req	Duty	Foremost Approval and Date
A. Approvals							
1.	Drawing Approvals	- Confirm fabrication drawing approvals	API-650 / 12F	Issued for Construction Drawings	H D	QC / F	<i>DL</i> Feb 24, 2020
B. Receipt Inspection							
1.	Nozzle Pipe	- Confirm thickness, material type, dimensions and quantities as per approved drawings	Approved Drawings	This ITP	H I	QC / F	<i>DL</i> Mar 5, 2020
C. In Process Inspection							
1.	Material cutting and beveling	- Monitor correct material per drawing and traceable to the work order number	Component drawing(s)	This ITP	I / V	F	<i>DL</i> Mar 5, 2020
2.	Nozzle Prefabrication	- Confirm correct size, rating, schedule and dimensions	Nozzle drawings	This ITP	I / V	F	<i>DL</i> Mar 5, 2020
3.	Nozzle Flange Condition	- Confirm gasket surface is free from damage	ASME B16.5	This ITP	I / V	F	<i>DL</i> Mar 5, 2020
4.	Nozzle Lay-out (Shell and Roof)	- Confirm correct orientation and elevation - Confirm correct nozzle size, rating, schedule and if repad req'd	General Arrangement & Nozzle drawings	This ITP	I / V	F	<i>DL</i> Mar 5, 2020
5.	Nozzle Fit-up	- Confirm flange face is two-holed, level & square to vessel - Confirm proper external & internal projection - Confirm repad dimensions - Confirm weld joint configuration and gap	General Arrangement & Nozzle drawings	This ITP	I / V	F	<i>DL</i> Mar 5, 2020

Legend:

Requirements: I – Inspect
W – Witness
H – Hold Point
D – Documents Required
V – Verify

Duty: QC – Quality Control
F – Foreman
P – Projects








Storage Tank
Quality / Inspection & Test Plan
Revision 0

W.O.# W03-066731

Serial Number: 028328-3

Description: 1000BBL Sales Tank – Sour Mod's

Ref	Activity Description	QC Activity Required	Acceptance Criterion	Verifying Documents	Foremost Req	Duty	Foremost Approval and Date
6.	Internal Piping and Attachments	- Confirm all internal piping is installed c/w appropriate studs, nuts and gaskets, and that all pipe support and flange nuts have been tightened. - Confirm internal attachments are in correct location/position	Component drawings	This ITP	I / V	F	 Mar 5, 2020
7.	Welding Visual Examination	- Verify weld profile, appearance, size, reinforcement and contours on all welds	Component drawings and Foremost's storage tank visual inspection criteria	This ITP	I / V	QC / F	 Mar 31, 2020
D. NDE							
D.1 Liquid Penetrant Examination							
1.	Nozzle Flange to Pipe Outside Welds and Nozzle Pipe / Coupling to Shell Outside Welds	- Perform PT on all nozzle pipe to flange outside welds and on all non repaded nozzle / coupling to shell outside welds	ASME Section VIII, Annex 8, Paragraphs 8-3, 8-4 and 8-5	NDE Reports and this ITP	I D	QC / F	 Mar 5, 2020
D.2 Air Testing							
1.	Nozzle Repads	- Ensure test gauge is of proper range and condition is acceptable for the test. - Ensure test gauge calibration is current - Air / soap test nozzle repads to 15 psi - Ensure test gauge serial number is recorded on the test report	Gauge must have been calibrated within one year of the test date and API-650 Paragraph 7.3.4	Test Gauge Calibration Records, Nozzle Repad Test Reports and this ITP	I D	QC / F	 Mar 31, 2020
E. Final Inspection and Release for Coating & Insulation Repairs							
1.	Mechanical Walk Through and Release for Air Test	- Ensure tank is complete and as per the construction drawings. - Confirm all welds have been marked with welder I.D. symbols. - Confirm all internal and external welds are in accordance with Code requirements - Confirm all required NDE has been completed.	Approved for construction drawings	This ITP	H I D	QC / F	 Mar 31, 2020

Legend:

Requirements: I – Inspect
W – Witness
H – Hold Point
D – Documents Required
V – Verify

Duty: QC – Quality Control
F – Foreman
P – Projects



Storage Tank
Quality / Inspection & Test Plan
Revision 0

W.O.# W03-066731

Serial Number: 028328-3

Description: 1000BBL Sales Tank – Sour Mod's

Ref	Activity Description	QC Activity Required	Acceptance Criterion	Verifying Documents	Foremost Req	Duty	Foremost Approval and Date
G. Internal Coating (Foremost)							
1.	Test Equipment Calibration	- Confirm testing equipment is calibrated and acceptable for use	Calibration Records	This ITP	V	QC/F	Bm Apr. 1-20
2.	Internal Blast Profile Achieved (As Per Drawings)	- Confirm internal blast profile is in accordance with Coating Manufacturer's	Approved Drawings	Surface Preparation Section of Coating Report and this ITP	D	F	Bm Apr. 2-20
3.	Verify Coating Material (As Per Drawings)	- Confirm coating material is as per Client requirements	Approved Drawings and	Applied Coating Section of Coating Report and this ITP	D	F	Bm Apr. 1-20
4.	First Internal Coat Inspection (As Per Drawings)	- Visually inspect coating for defects, measure and record DFT.	Manufacturer's Recommendations	Applied Coating Section of Coating Report and this ITP	D	F	Bm Apr. 3-20
5.	Second Internal Coat Inspection (if applicable) (As Per Drawings)	- Visually inspect coating for defects, measure and record DFT.	Manufacturer's Recommendations	Applied Coating Section of Coating Report and this ITP	D	F	N/A
6.	Final Coating Inspection	- Visually inspect coating for defects, measure and record final DFT.	Manufacturer's Recommendations	Applied Coating Section of Coating Report and this ITP	D	F	Bm Apr. 3-20
7.	Holiday Testing	- Examine the entire coated surface for defects using a wet sponge type holiday detector/ or high voltage	Holiday Free	Holiday Testing Section of Coating Report and this ITP	D	F	Bm Apr. 3-20
I. Insulation							
1.	Foam Urethane Thickness (As Per Drawings)	- Ensure urethane insulation thickness is no less that specified on the drawings	Approved Drawings	This ITP	V	F	Bm Apr. 6-20
2.	Sealer Coverage (As Per Drawings)	- Ensure sealer coverage is even and no urethane is exposed	No Exposed Insulation	This ITP	V	F	Bm Apr. 6-20

Legend:

Requirements: I – Inspect
W – Witness
H – Hold Point
D – Documents Required
V – Verify

Duty: QC – Quality Control
F – Foreman
P – Projects





Storage Tank
Quality / Inspection & Test Plan
Revision 0

W.O.# W03-066731

Serial Number: 028328-3

Description: 1000BBL Sales Tank – Sour Mod's

Ref	Activity Description	QC Activity Required	Acceptance Criterion	Verifying Documents	Foremost Req	Duty	Foremost Approval and Date
3.	Final Insulation Inspection	<ul style="list-style-type: none"> - Ensure all masking tape and poly has been removed - Ensure even trimming around appurtenances - Ensure all openings are accounted for (shell and roof couplings) 	Industry Standards	This ITP	V	F	BM Apr. 6 - 20
J. Preparation for Shipment							
1.	Preparation for Shipment	<ul style="list-style-type: none"> - Ensure tank internal has been swept and free of debris - Ensure all enviro vault internal / external piping, applicable valves and riser labeling have been installed - Ensure all accessories have been installed on and in the tank in accordance with the approved drawings - Ensure burner flange, stack, couplings and all nozzles have appropriate blinds, shipping covers or plugs installed 	Approved Drawings	This ITP	H I	QC / P	 Apr 6, 2020
K. Documentation							
1.	Document Review and Retention	<ul style="list-style-type: none"> - Confirm all documents required for the turnover package have been checked for accuracy and completeness - Ensure data package is scanned and saved electronically by tank serial number 	Approved Drawings Project Specifications	Approved Data Package	H I D	QC	 Apr 6, 2020

Legend:

Requirements: I – Inspect
W – Witness
H – Hold Point
D – Documents Required
V – Verify

Duty: QC – Quality Control
F – Foreman
P – Projects



Penetrant Test Report

Foremost Job #: W03-066731		Tag Name: 1000BBL Sales Tank - Sour Mods	
Client: Husky Oil		Tag #: N/A	
Location: FLW		Tank Serial #: 028328-1	
Job Coordinator: Braden Musyj		Site Supervisor: Dustin Henning	
Location of Test:			
Floor to Shell Seam: N/A		Horizontal Seam: N/A	
Non-Repadded Nozzles: X		Vertical Seam: N/A	
Other: External flange to pipe nozzle welds			
Testing Instructions:			
Penetrant to be Used: See below		Dwell Time: 4 Hours min.	
Ambient Conditions: Shop		Ambient Temperature: Shop	
Additional Requirements: Penetrant to be used is diesel or other suitable penetrant			
Nozzles tested: N18 nozzle flange to pipe welds; N17 nozzle flange to pipe welds and nozzle to shell weld.			
Pre-Test Inspection:			
Item to be tested to be visually checked for completion prior to testing.			
Supervisor Sign-Off		Quality Control Sign-Off	
Print: <i>Derek Pendree</i>		Print:	
Sign: <i>D. Pendree</i>		Sign:	
Date: <i>MAY 5/2020</i>		Date:	
Comments:			
Test Record:			
Penetrant Used: Lubriplate Penetrating Oil		Date of Test:	
Dwell Time: 4 hours		Time of Test:	
Result: <i>Good</i>			
Ambient Conditions:		Ambient Temperature: <i>Shop</i>	
Comments:			
Sign-Off			
Foremost Representative		Client Representative	
Print: <i>Derek Pendree</i>		Print:	
Sign: <i>D. Pendree</i>		Sign:	
Date: <i>MAY 5/2020</i>		Date:	



Penetrant Test Report

Foremost Job #: W03-066731	Tag Name: 1000BBL Sales Tank - Sour Mods
Client: Husky Oil	Tag #: N/A
Location: FLW	Tank Serial #: 028328-3
Job Coordinator: Braden Musyj	Site Supervisor: Dustin Henning
Location of Test:	
Floor to Shell Seam: N/A	Horizontal Seam: N/A
Non-Repadded Nozzles: X	Vertical Seam: N/A
Other: External flange to pipe nozzle welds	
Testing Instructions:	
Penetrant to be Used: See below	Dwell Time: 4 Hours min.
Ambient Conditions: Shop	Ambient Temperature: Shop
Additional Requirements: Penetrant to be used is diesel or other suitable penetrant	
Nozzles tested: N18 nozzle flange to pipe welds; N17 nozzle flange to pipe welds and nozzle to shell weld.	
Pre-Test Inspection:	
Item to be tested to be visually checked for completion prior to testing.	
Supervisor Sign-Off	Quality Control Sign-Off
Print:	Print: Ben Reed
Sign:	Sign:
Date:	Date: Mar 31, 2020
Comments:	
Test Record:	
Penetrant Used: Lubriplate Penetrating Oil	Date of Test: Mar 31, 2020
Dwell Time: 4 hours	Time of Test: 10:00 am
Result: Pass	
Ambient Conditions: Shop	Ambient Temperature: Shop
Comments: No leaks found	
Sign-Off	
Foremost Representative	Client Representative
Print: Ben Reed	Print:
Sign:	Sign:
Date: Mar 31, 2020	Date:






Penetrant Test Report

Foremost Job #: W03-066731	Tag Name: 1000BBL Sales Tank - Sour Mods
Client: Husky Oil	Tag #: N/A
Location: FLW	Tank Serial #: 028328-1
Job Coordinator: Braden Musyj	Site Supervisor: Dustin Henning
Location of Test:	
Floor to Shell Seam: N/A	Horizontal Seam: N/A
Non-Repadded Nozzles: X	Vertical Seam: N/A
Other: External flange to pipe nozzle welds	
Testing Instructions:	
Penetrant to be Used: See below	Dwell Time: 4 Hours min.
Ambient Conditions: Shop	Ambient Temperature: Shop
Additional Requirements: Penetrant to be used is diesel or other suitable penetrant	
Nozzles tested: N14a & b, N13, N16a-d, N9 - nozzle flange to pipe welds; N15 nozzle flange to pipe welds and nozzle to shell weld.	
Pre-Test Inspection:	
Item to be tested to be visually checked for completion prior to testing.	
Supervisor Sign-Off	Quality Control Sign-Off
Print: Derek Pendree	Print: Danton Weston
Sign:	Sign:
Date: Mar 5, 2020	Date: Mar 5, 2020
Comments:	
Test Record:	
Penetrant Used: Lubriplate Penetrating Oil	Date of Test: Mar 5, 2020
Dwell Time: 4 hours	Time of Test: 7:30am - 11:30am
Result: Pass, no evidence of wicking	
Ambient Conditions: In shop	Ambient Temperature: 15°C
Comments:	
Sign-Off	
Foremost Representative	Client Representative
Print: Danton Weston	Print:
Sign:	Sign:
Date: Mar 5, 2020	Date:



Penetrant Test Report

Foremost Job #: W03-066731		Tag Name: 1000BBL Sales Tank - Sour Mods	
Client: Husky Oil		Tag #: N/A	
Location: FLW		Tank Serial #: 028328-3	
Job Coordinator: Braden Musyj		Site Supervisor: Dustin Henning	
Location of Test:			
Floor to Shell Seam: N/A		Horizontal Seam: N/A	
Non-Repadded Nozzles: X		Vertical Seam: N/A	
Other: External flange to pipe nozzle welds			
Testing Instructions:			
Penetrant to be Used: See below		Dwell Time: 4 Hours min.	
Ambient Conditions: Shop		Ambient Temperature: Shop	
Additional Requirements: Penetrant to be used is diesel or other suitable penetrant			
Nozzles tested: N14a & b, N13, N16a-d, N9 - nozzle flange to pipe welds; N15 nozzle flange to pipe welds and nozzle to shell weld.			
Pre-Test Inspection:			
Item to be tested to be visually checked for completion prior to testing.			
Supervisor Sign-Off		Quality Control Sign-Off	
Print: Derek Pendree		Print: Danton Weston	
Sign: 		Sign: 	
Date: Mar 4, 2020		Date: Mar 4, 2020	
Comments:			
Test Record:			
Penetrant Used: Lubriplate Penetrating Oil		Date of Test: Mar 4, 2020	
Dwell Time: 4 hours		Time of Test: 9:45am - 2:00pm	
Result: Pass, no evidence of wicking			
Ambient Conditions: In shop		Ambient Temperature: 15°C	
Comments:			
Sign-Off			
Foremost Representative		Client Representative	
Print: Danton Weston		Print:	
Sign: 		Sign:	
Date: Mar 4, 2020		Date:	

Foremost Job #: W03-066731						Tag Name: 1000BBL Sales Tank - Sour Mod					
Client: Husky Oil						Tag #: N/A					
Location FLW						Tank Serial #: 028328-1					
Job Coordinator: Braden Musyj						Site Supervisor: Dustin Henning					
Location of Test											
Shell Nozzles: X						Roof Nozzles: X					
Other:											
Testing Instructions:											
Test Pressure: 15psi						Hold Time: Duration					
Testing Medium: Air / Soap Solution						Test Medium Temperature: >0°C					
Pressurizing Unit Used: Compressor w/ regulator						Ambient Temperature: >0°C					
Additional Requirements:											
Pre-Test Inspection:											
Nozzles to be visually inspected prior to testing.											
Supervisor Sign-Off						Quality Control Sign-Off					
Print: Derek Pendree						Print: Danton Weston					
Sign: [Signature]						Sign: [Signature]					
Date: Mar 5, 2020						Date: Mar 5, 2020					
Comments:											
Test Record:											
Nozzle #:	Size:	Pressure:	Result:	Initial:	Nozzle #:	Size:	Pressure:	Result:	Initial:		
N9	3" XS	15psi	Pass	[Signature]							
N13	3" XS	15psi	Pass	[Signature]							
N14a	4" XS	15psi	Pass	[Signature]							
N14b	4" XS	15psi	Pass	[Signature]							
N16a	4" XS	15psi	Pass	[Signature]							
N16b	4" XS	15psi	Pass	[Signature]							
N16c	4" XS	15psi	Pass	[Signature]							
N16d	4" XS	15psi	Pass	[Signature]							
N18	20" STD	15psi									
						Test Gauge Serial #: ED55684					
Sign-Off											
Foremost Representative						Client Representative					
Print: Derek Pendree						Print:					
Sign:						Sign:					
Date:						Date:					

Foremost Job #: W03-066731						Tag Name: 1000BBL Sales Tank - Sour Mod							
Client: Husky Oil						Tag #: N/A							
Location FLW						Tank Serial #: 028328-3							
Job Coordinator: Braden Musyj						Site Supervisor: Dustin Henning							
Location of Test													
Shell Nozzles:						X	Roof Nozzles:						X
Other:													
Testing Instructions:													
Test Pressure: 15psi						Hold Time: Duration							
Testing Medium: Air / Soap Solution						Test Medium Temperature: >0°C							
Pressurizing Unit Used: Compressor w/ regulator						Ambient Temperature: >0°C							
Additional Requirements:													
Pre-Test Inspection:													
Nozzles to be visually inspected prior to testing.													
Supervisor Sign-Off						Quality Control Sign-Off							
Print: Derek Pendree						Print: Danton Weston							
Sign: [Signature]						Sign: [Signature]							
Date: Mar 5, 2020						Date: Mar 5, 2020							
Comments:													
Test Record:													
Nozzle #:	Size:	Pressure:	Result:	Initial:	Nozzle #:	Size:	Pressure:	Result:	Initial:				
N9	3" XS	15psi	Pass	[Signature]									
N13	3" XS	15psi	Pass	[Signature]									
N14a	4" XS	15psi	Pass	[Signature]									
N14b	4" XS	15psi	Pass	[Signature]									
N16a	4" XS	15psi	Pass	[Signature]									
N16b	4" XS	15psi	Pass	[Signature]									
N16c	4" XS	15psi	Pass	[Signature]									
N16d	4" XS	15psi	Pass	[Signature]									
N18	20" STD	15psi											
					Test Gauge Serial #: ED55684								
Sign-Off													
Foremost Representative					Client Representative								
Print: Derek Pendree					Print:								
Sign: [Signature]					Sign:								
Date: MAR 5/2020					Date:								



Insulating Report

FIF-QMR-68

Foremost Job #:	W03-066731-1	Tag Name:	1000 bbl
Client:	Husky	Tag #:	
Location:	FLW	Tank Serial #:	028328-1
Job Coordinator:	Braden M.	Site Supervisor:	Dustin H.

Insulating

Chemical

Strokes	84	Res Batch#		Amount	12	Kgs
Thickness	Patch	Iso batch#		Amount	13	Kgs

Temperature

Hose	105	Prepping	Barry	Time	1
ISO	110	Prepping	Allen	Time	1
Resin	110	Prepping	Cody	Time	1
Tank	80				
AMB	80	Applicator	Cody	Time	1.5
Humidity	25%	Helper	Sasha	Time	1.5
Pressure	1600				

Sealing

Product	PSC 1050	Applicator	Jim	Time	1
Paint Name	Tankcoat	Helper	Allen	Time	1
Batch #					
Color	Black				
Amount	5 gals				

Q.C./Foreman Signature 

3rd Party Signature

Comments



Insulating Report

FIF-QMR-68

Foremost Job #:	W03-066731-2	Tag Name:	1000 bbl
Client:	Husky	Tag #:	
Location:	FLW	Tank Serial #:	028328-3
Job Coordinator:	Braden M.	Site Supervisor:	Dustin H.

Insulating


Chemical

Strokes	92	Res Batch#		Amount	13	Kgs
Thickness	Patch	Iso batch#		Amount	14	Kgs

Temperature

Hose	105	Prepping	Barry	Time	1.5
ISO	110	Prepping	Allen	Time	1.5
Resin	110	Prepping		Time	
Tank	80				
AMB	80	Applicator	Barry	Time	1.5
Humidity	25%	Helper	Allen	Time	1.5
Pressure	1600				

Sealing

Product	PSC 1050	Applicator	Jim	Time	1	
Paint Name	Tankcoat	Helper	Allen	Time	1	
Batch #						
Color	Black					
Amount	5 gals					
Q.C./Foreman Signature						
3rd Party Signature						
Comments						

ABRASIVE BLASTING DATA

Foremost Job #:	403-066731-1	Tank Name:	100661
Client:	Husky	Tag #:	
Location:	FLW	Tank Serial #:	028328+1
Job Coordinator:	Bradley M.	Site Supervisor:	Dustin Henning
Date:	Mar 27/20		
Blasted Area:	Nozzles + clips internal.		

STEEL CONTAMINANT TESTING:

SCAT Test Location:	Nitrate Levels:	Chloride Levels:	Sulphate Levels:	PH:

ENVIRONMENTAL DATA:

START TIME	AMIENT TEMP.	RELATIVE HUMIDITY	DEW POINT	STEEL TEMP.
9Am	-5°C	59%	-11.8°C	-4°C
END TIME	AMIENT TEMP.	RELATIVE HUMIDITY	DEW POINT	STEEL TEMP.

SPECIFICATION STANDARD:

TYPE AND GRADE OF ABRASIVE:

Internal:	Sp5	Starblast
External:		

Abrasive Checked for Cleanliness: ☐ Yes ☒ No

Surface Conforms to SP 0178: ☒ Yes ☐ No

BLOTTER TESTING:

Time:	8Am	Clean and Dry:	<input checked="" type="checkbox"/> Yes <input type="checkbox"/> No
Time:		Clean and Dry:	<input type="checkbox"/> Yes <input type="checkbox"/> No
Time:		Clean and Dry:	<input type="checkbox"/> Yes <input type="checkbox"/> No
Time:		Clean and Dry:	<input type="checkbox"/> Yes <input type="checkbox"/> No

ANCHOR PROFILE MEASUREMENTS:

LOCATION / NOZZLE:	ANCHOR PROFILE:			DATE & TIME:	VERIFIED BY:
internal shell	3.1	3.0	3.3		

TESTEX TAPE:

--	--	--

SIGN-OFF:

FOREMOST REPRESENTATIVE:		CLIENT REPRESENTATIVE:	
Print:	Jim German	Print:	
Sign:	[Signature]	Sign:	
Date:	April 1/20	Date:	



COATING DATA					
Foremost Job #: <u>W03-066731-1</u>		Tank Name: <u>1000 bbl.</u>			
Client: <u>Hu5ky</u>		Tag #:			
Location: <u>FLW</u>		Tank Serial #: <u>028328-1</u>			
Job Coordinator: <u>Braden M</u>		Site Supervisor: <u>Dustin Henning</u>			
Date: <u>Mar 30/20</u>					
Application Area: <u>Repairs (nozzles; clips)</u>					
PRODUCT INFORMATION:					
Coat #:	Product Description:	Batch #:	Application Method:	Colour:	
<u>1</u>	<u>Devco 253 HS A</u>	<u>06999AH</u>	<u>airless spray</u>	<u>green/blue</u>	
	<u>B VA4135UA</u>				
ENVIRONMENTAL DATA:					
START TIME	AMIENT TEMP.	RELATIVE HUMIDITY	DEW POINT	STEEL TEMP.	
<u>10:30AM</u>	<u>26°C</u>	<u>11.5%</u>	<u>-6.2°C</u>	<u>27.5°C</u>	
END TIME	AMIENT TEMP.	RELATIVE HUMIDITY	DEW POINT	STEEL TEMP.	
COATING THICKNESS MEASUREMENTS:					
Coat #:	WFT Avg.:	DFT Avg.:	DFT Min.:	DFT Max.:	Defects:
<u>1</u>	<u>15</u>	<u>13.5</u>	<u>9</u>	<u>19</u>	
COMMENTS:					
SIGN-OFF:					
Foremost Representative:			Client Representative:		
Print: <u>Juan German</u>			Print:		
Sign: <u>[Signature]</u>			Sign:		
Date: <u>April 1/20</u>			Date:		

COATING DATA

Foremost Job #: 403-066731-1		Tank Name: 1000 bbl.			
Client: Husky		Tag #:			
Location: FLW		Tank Serial #: 02832871			
Job Coordinator: Braden m		Site Supervisor: Dustin Henning			
Date: Mar 30:31 / 20					
Application Area: nozzles internal					
PRODUCT INFORMATION:					
Coat #:	Product Description:	Batch #:	Application Method:	Colour:	
1	Duane 253HS A	469949uH	roller	green	
	B	VA4135uH			
2	Duane 253HS A	469949uH	roller.	green	
	B	VA4135uH			
ENVIRONMENTAL DATA:					
START TIME	AMIENT TEMP.	RELATIVE HUMIDITY	DEW POINT	STEEL TEMP.	
① 9am	25°C	11.4%	-7.3°C	24°C	
END TIME	AMIENT TEMP.	RELATIVE HUMIDITY	DEW POINT	STEEL TEMP.	
② 8am	23°C	12.1%	-7.7°C	24°C	
COATING THICKNESS MEASUREMENTS:					
Coat #:	WFT Avg.:	DFT Avg.:	DFT Min.:	DFT Max.:	Defects:
1	9	6.5	4.1	8.2	
2	8	14	9	18	
COMMENTS:					
SIGN-OFF:					
Foremost Representative:			Client Representative:		
Print: Jim German			Print:		
Sign: [Signature]			Sign:		
Date: April 1/20			Date:		

COATING DATA

Foremost Job #: <u>W03-066731-1</u>		Tank Name: <u>1000 bbl.</u>	
Client: <u>Husky</u>		Tag #:	
Location: <u>FLW</u>		Tank Serial #: <u>0283281</u>	
Job Coordinator: <u>Braden M.</u>		Site Supervisor: <u>Dustin Henning</u>	
Date: <u>Mar 31/20</u>			
Application Area: <u>Floor + 1' of shell</u>			

PRODUCT INFORMATION:				
Coat #:	Product Description:	Batch #:	Application Method:	Colour:
<u>1</u>	<u>Devco III</u>	<u>A V68255UH</u> <u>B A10493UH</u>	<u>airless spray</u>	<u>grey</u>

ENVIRONMENTAL DATA:				
START TIME	AMIENT TEMP.	RELATIVE HUMIDITY	DEW POINT	STEEL TEMP.
<u>1pm</u>	<u>24°C</u>	<u>12.1%</u>	<u>-7.1°C</u>	<u>26°C</u>
END TIME	AMIENT TEMP.	RELATIVE HUMIDITY	DEW POINT	STEEL TEMP.

COATING THICKNESS MEASUREMENTS:					
Coat #:	WFT Avg.:	DFT Avg.:	DFT Min.:	DFT Max.:	Defects:
<u>1</u>	<u>15</u>	<u>14</u>	<u>10</u>	<u>18</u>	

COMMENTS:
<u>Floor and 1 ft. of shell was sweep blasted and coated with III.</u>

SIGN-OFF:	
Foremost Representative:	Client Representative:
Print: <u>Jim German</u>	Print:
Sign: <u>[Signature]</u>	Sign:
Date: <u>April 1/20</u>	Date:

ABRASIVE BLASTING DATA

Foremost Job #:	403-066731-2				Tank Name:	1000 bbl.			
Client:	Husky				Tag #:				
Location:	FLW				Tank Serial #:	028320-3			
Job Coordinator:	Brandon M.				Site Supervisor:	Dustin Henning			
Date:	April 1/20								
Blasted Area:	Nozzles + clips.								
STEEL CONTAMINANT TESTING:									
SCAT Test Location:	Nitrate Levels:	Chloride Levels:	Sulphate Levels:	PH:					
ENVIRONMENTAL DATA:									
START TIME	AMIENT TEMP.	RELATIVE HUMIDITY	DEW POINT	STEEL TEMP.					
1pm	-16°C	71%	-20°C	-12°C					
END TIME	AMIENT TEMP.	RELATIVE HUMIDITY	DEW POINT	STEEL TEMP.					
4pm	-17°C	69%	-21.3°C	-12.9°C					
SPECIFICATION STANDARD:					TYPE AND GRADE OF ABRASIVE:				
Internal:	Sp5								
External:									

Abrasive Checked for Cleanliness: ☐ Yes ☒ No
 Surface Conforms to SP 0178: ☒ Yes ☐ No


BLOTTER TESTING:

Time: 11Am	Clean and Dry:	<input checked="" type="checkbox"/> Yes	<input type="checkbox"/> No
Time:	Clean and Dry:	<input type="checkbox"/> Yes	<input type="checkbox"/> No
Time:	Clean and Dry:	<input type="checkbox"/> Yes	<input type="checkbox"/> No
Time:	Clean and Dry:	<input type="checkbox"/> Yes	<input type="checkbox"/> No

ANCHOR PROFILE MEASUREMENTS:

LOCATION / NOZZLE:	ANCHOR PROFILE:	DATE & TIME:	VERIFIED BY:
internal	3.7 3.6 3.4	April 2/20 8Am	SD

TESTEX TAPE:

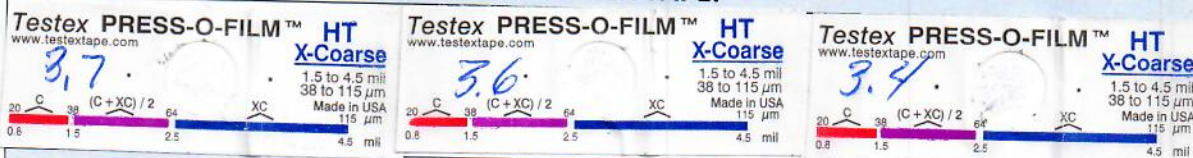

SIGN-OFF:

FOREMOST REPRESENTATIVE:		CLIENT REPRESENTATIVE:	
Print: Jim Gorman		Print:	
Sign: [Signature]		Sign:	
Date: April 2/20		Date:	

COATING DATA

Foremost Job #:	403-066731-2	Tank Name:	1000 bbl
Client:	Husky	Tag #:	
Location:	FL W	Tank Serial #:	028328-13
Job Coordinator:	Graden M.	Site Supervisor:	Dustin Henning
Date:	April 23/20		
Application Area:	NOZZLES internal		

PRODUCT INFORMATION:

Coat #:	Product Description:	Batch #:	Application Method:	Colour:
1	Devco 253 Hs		Roller	green
	A 469949AH			
	B VA4135AH			
2	Devco 253 Hs		Roller	green
	A 469949AH			
	B VA4135AH			

ENVIRONMENTAL DATA:

START TIME	AMIENT TEMP.	RELATIVE HUMIDITY	DEW POINT	STEEL TEMP.
11Am	24°C	11.2%	-8.1°C	26°C
END TIME	AMIENT TEMP.	RELATIVE HUMIDITY	DEW POINT	STEEL TEMP.
9Am	25°C	11	-7.5°C	27°C

COATING THICKNESS MEASUREMENTS:

Coat #:	WFT Avg.:	DFT Avg.:	DFT Min.:	DFT Max.:	Defects:
1	8	6	4	10	
2	8	13.2	9	18.4	

COMMENTS:

SIGN-OFF:

Foremost Representative:		Client Representative:	
Print:	Jim Gorman	Print:	
Sign:	[Signature]	Sign:	
Date:	April 6/20	Date:	



FIF-QMR-71

HOLIDAY TESTING

Foremost Job #:	403-066731-2	Tank Name:	1000 bbl.
Client:	Husky	Tag #:	
Location:	FLW	Tank Serial #:	028328-3
Job Coordinator:	Braden M.	Site Supervisor:	Dustin Henning
HOLIDAY TESTING EQUIPMENT:			
Inspection Equipment Used:	2v Linker	Voltage Used:	67.5
Serial Number:	28090	Make / Model:	Linker + Razor
Calibration Date:	Feb 14/20		m1
TESTING:			
Specification:	SP0 183	Date & Time:	April 6/20
Area Tested:	Shell	No. of Holidays:	2
Area Tested:	nozzles int	No. of Holidays:	0
Area Tested:	Floor	No. of Holidays:	4
Area Tested:		No. of Holidays:	
Area Tested:		No. of Holidays:	
Cause of Holiday(s):	shell - welds Floor - pin hole; welds.		
COMMENTS:			
SIGN-OFF:			
Foremost Representative:		Client Representative:	
Print:	Jim Germain	Print:	
Sign:	[Signature]	Sign:	
Date:	April 7/20	Date:	