

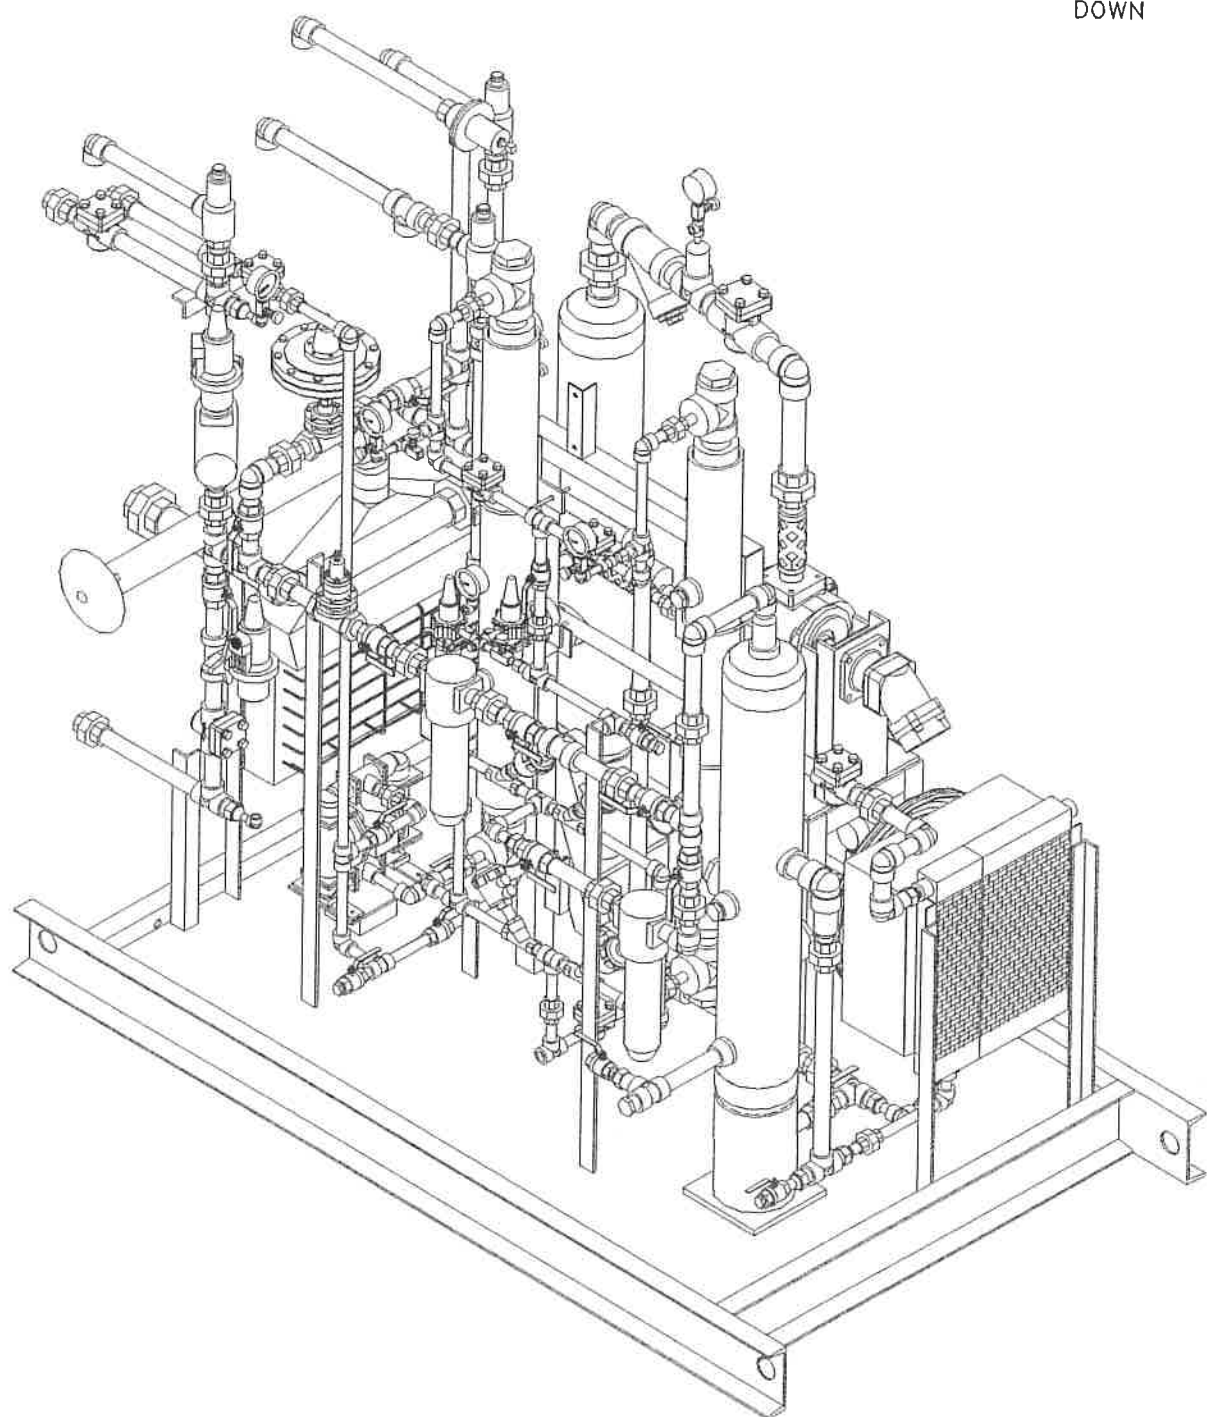
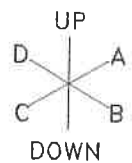


F:\PC Compression\Drafting\Work-Internal\1-795 RCAA-0705B HUSKY NK60 AB\B-GA-RCAA0705B AB.dwg, ISOMETRIC VIEWS 1, 7/24/2007 9:21:29 AM, scottopc, This drawing is the Property of PC Compression Inc. It may not be dup

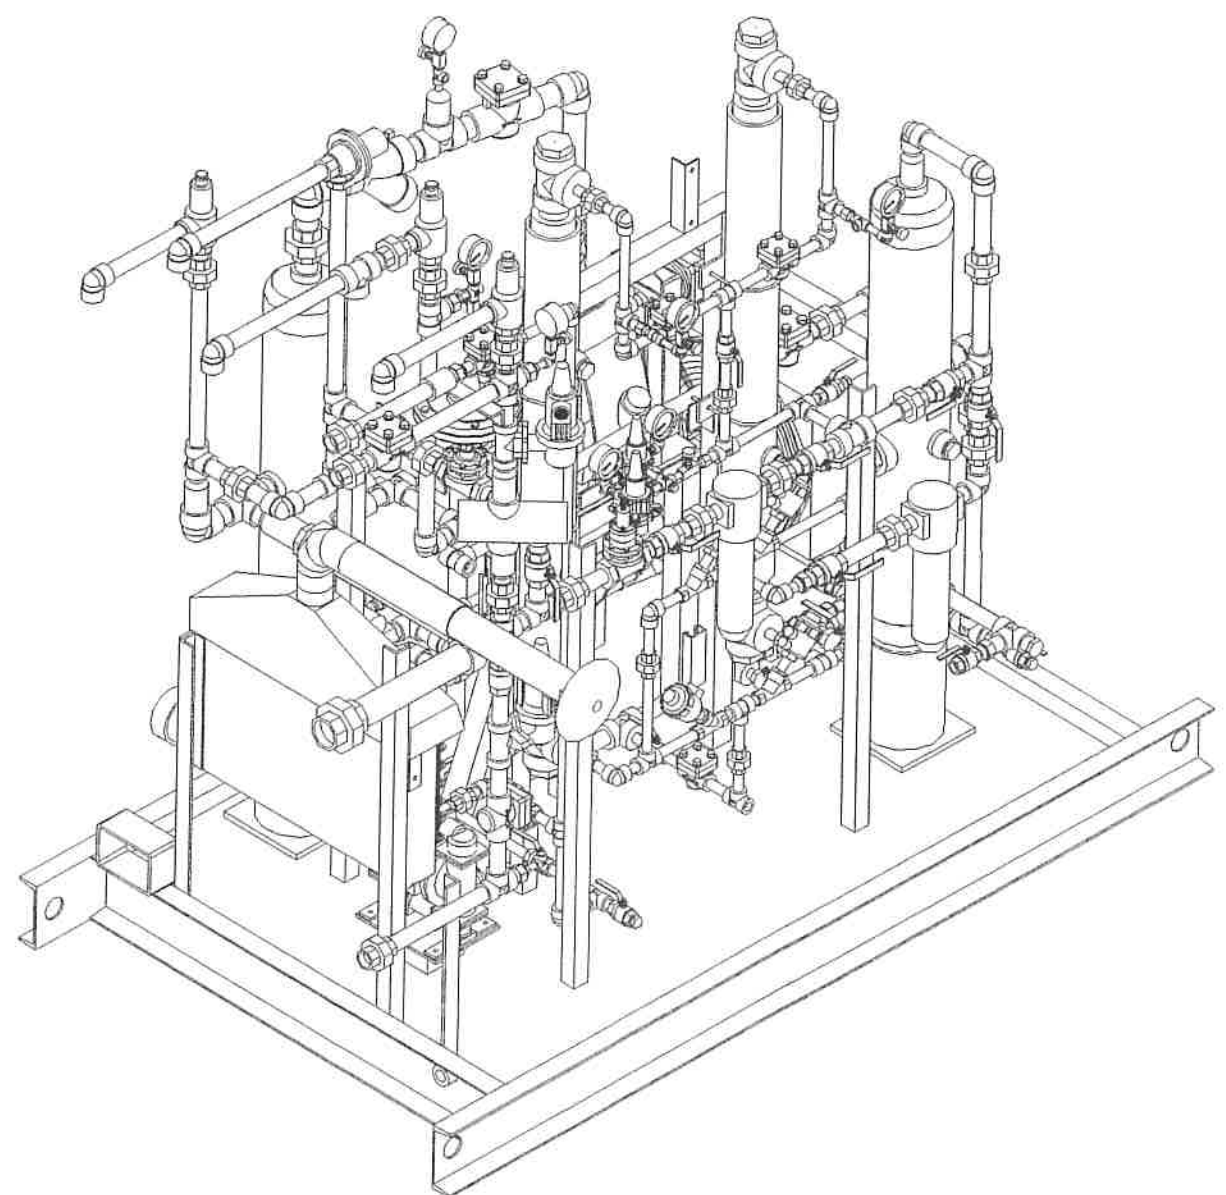

'CB' ISOMETRIC VIEW
SCALE 1:15

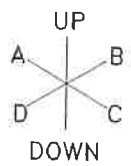

'DC' ISOMETRIC VIEW
SCALE 1:15

 2308-Bth Street Nisku, Alberta T8E 7Z2				Office: 780.955.4282 Fax: 780.935.4284 Toll Free: 866.955.4292				Drawn by: S.D.C. Date: 07-18-06 Checked by: S.D.C. Approved by: BA		ROTORCOMP w/ AA DRYING NK60 w/ SUNFAB M012WH-B4KU SKID MOUNTED, SWEET SERVICE			
AS BUILT ISSUED FOR CONSTRUCTION DESCRIPTION				SDC 07-24-07 SDC 05-29-07 BY DATE CHKD APPD		Company: HUSKY OIL OPERATIONS LTD		Unit NO.: RCAA-0705B		Drawing NO.: GA-RCAA0705B-B-03		Rev.: 1	