
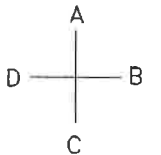


P:\PC Compression\Drafting\Work-Internal\1-795 RCAA-07058 HUSKY NK60 AB\B-GA-RCAA07058 AB.dwg, PLAN VIEW, 7/24/2007 9:21:07 AM, scallops, This drawing is the Property of PC Compression Inc. It may not be duplicated

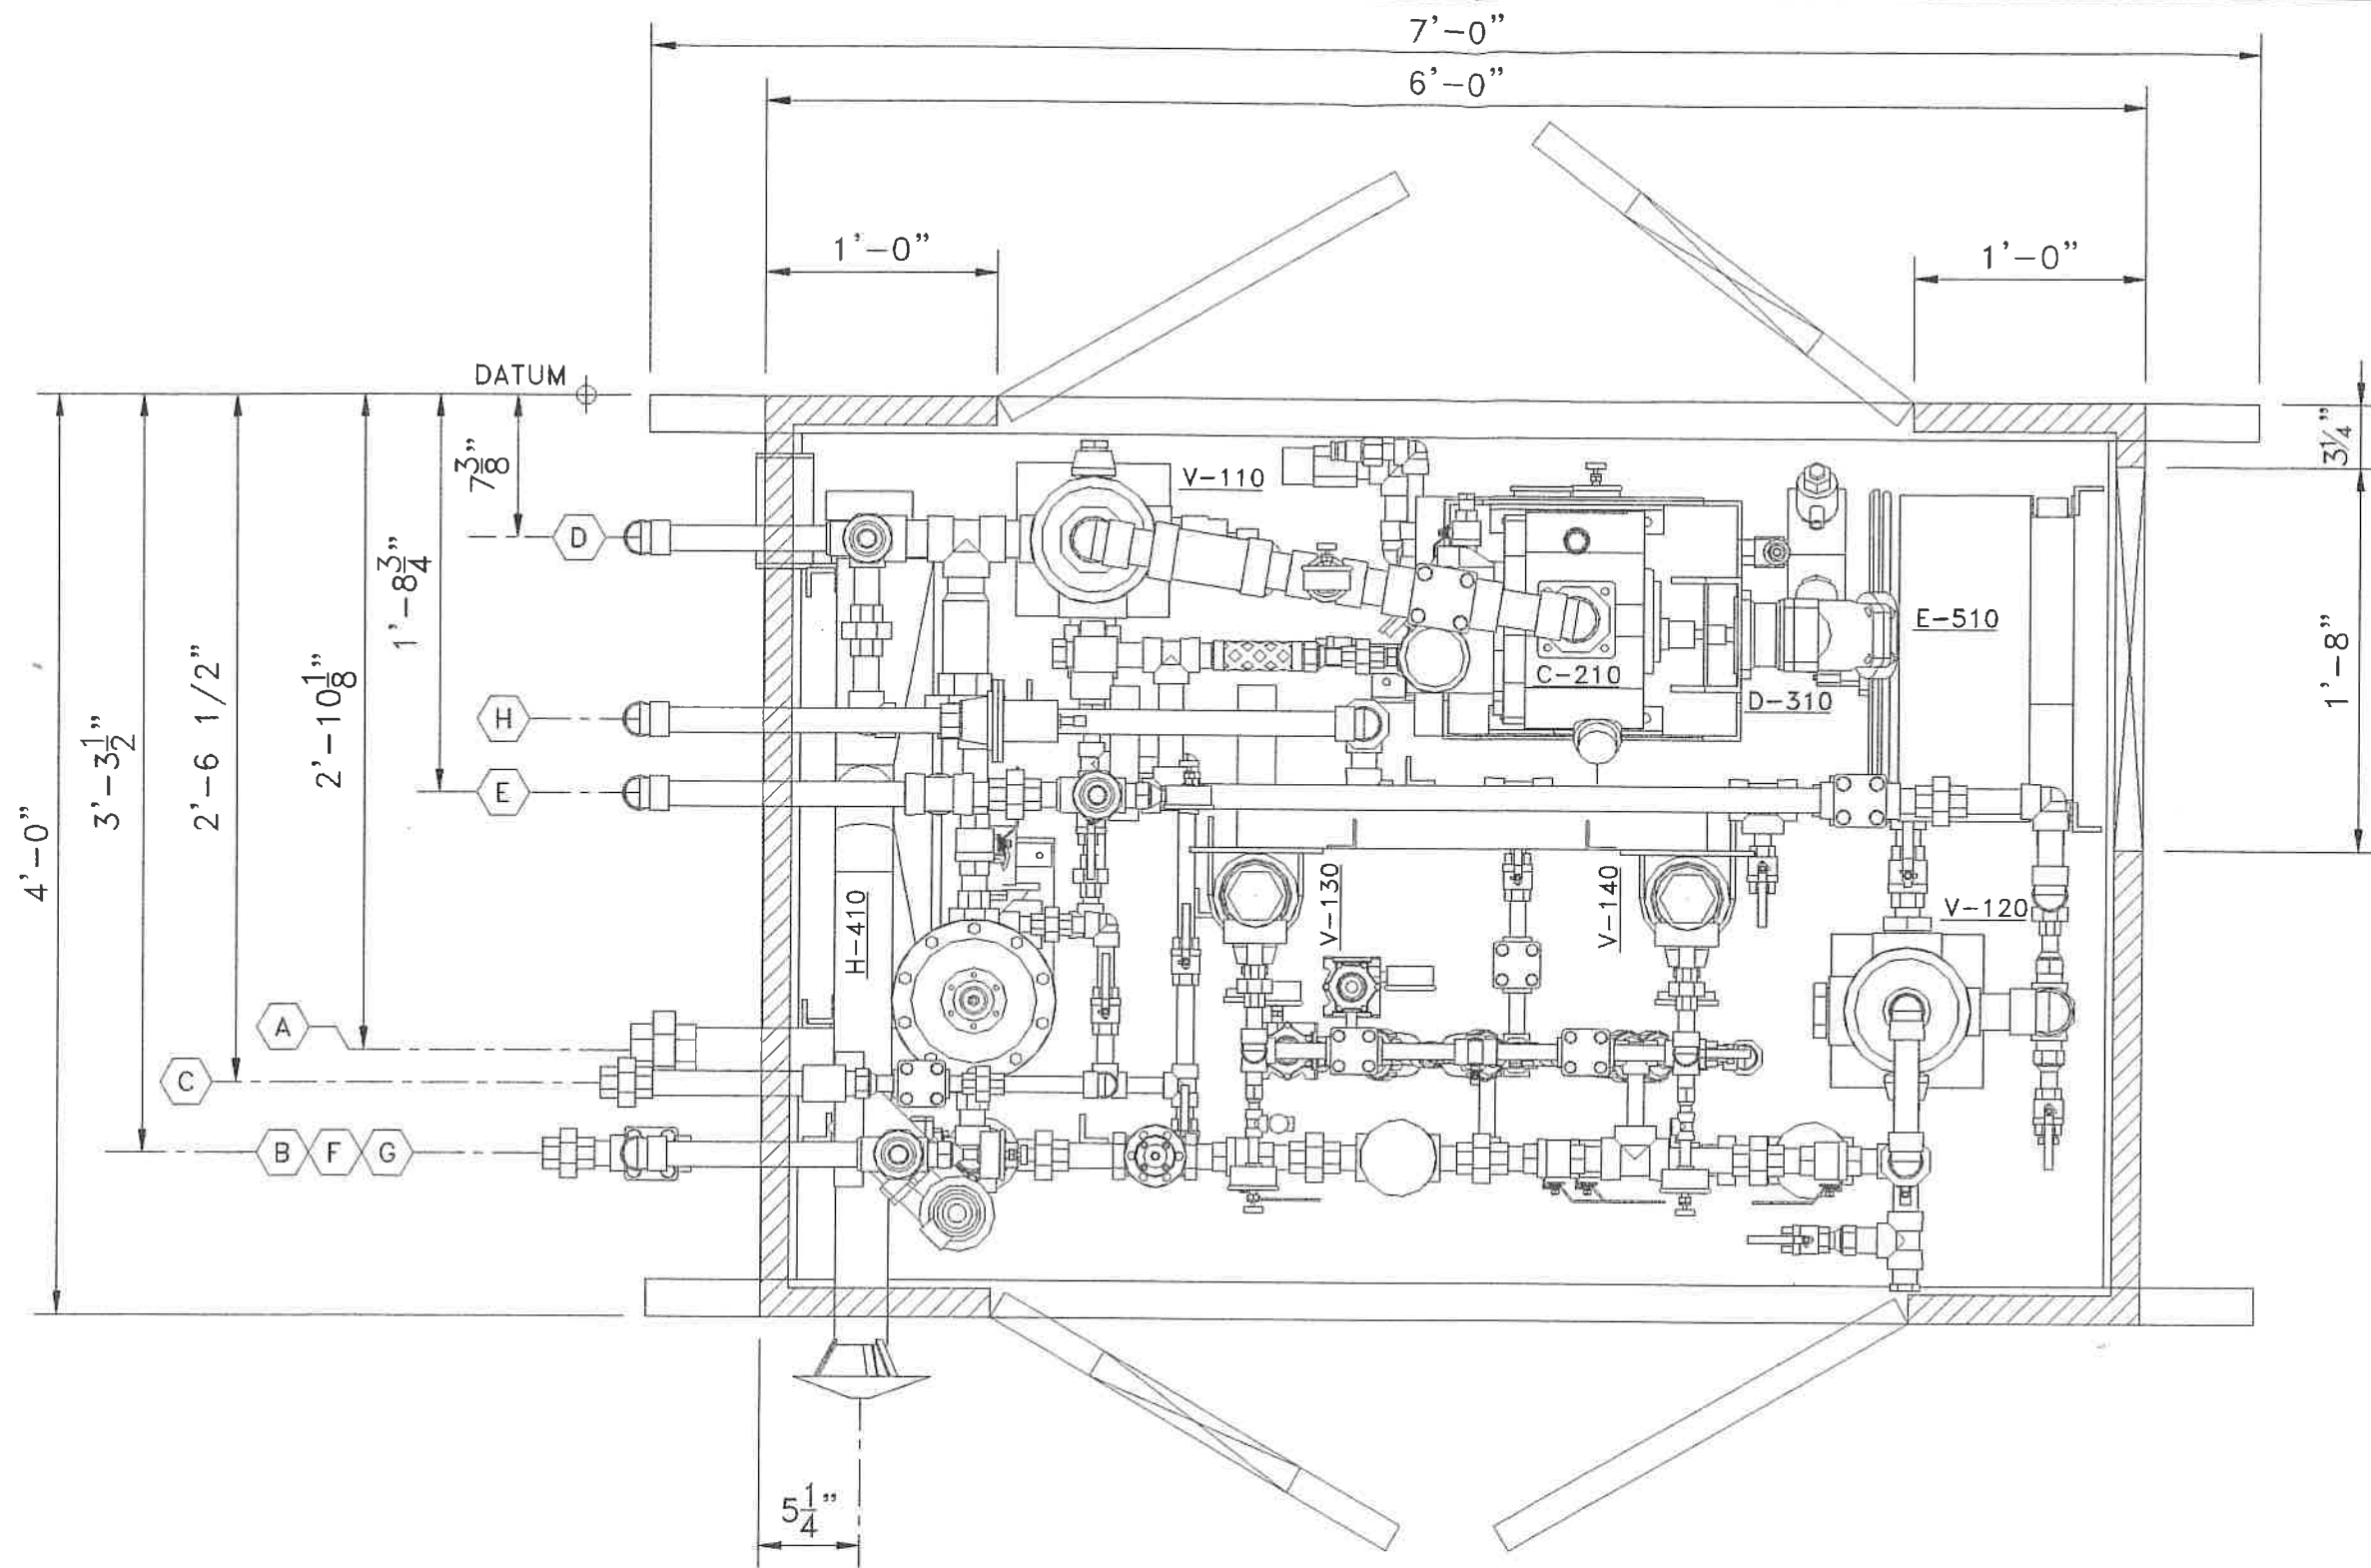

CUSTOMER CONNECTIONS

ITEM	DESCRIPTION	SIZE	ELEVATION	PROJ.
A	GAS INLET	2" 3000# NPT	2'-9 3/8" FTOS	6"
B	GAS OUTLET	1" 3000# NPT	1'-4 7/8" FTOS	6"
C	LIQUID OUTLET	1" 3000# NPT	5'-2" FTOS	6"
D	PSV-1101 VENT	1" NPT	5'-2 3/8" FTOS	6"
E	PSV-2101 VENT	1" NPT	5'-2 1/4" FTOS	6"
F	FUEL GAS	1" NPT	5'-2" FTOS	6"
G	PSV-1402	1" NPT	5'-10 1/8" FTOS	6"
H	PRV-1101	1" NPT	5'-10 5/8" FTOS	6"

CONNECTION NOTE:

- THESE CONNECTIONS ARE PREASSEMBLY ONLY. THEY ARE TO BE USED FOR REFERENCE ONLY.
- PLACE DISCHARGE CHECK AT 3" FROM BUILDING WALL

PLAN VIEW
SCALE 1:10

REV.	DESCRIPTION	BY	DATE	CHKD	APPD
1	AS BUILT				
0	ISSUED FOR CONSTRUCTION				



2308-8th Street
Nisku Alberta
T9E 7Z2

Office: 780.955.4292
Fax: 780.955.4294
Toll Free: 888.955.4292

Drawn by:
S.D.C.
Date:
07-18-06
Checked by:
SDC
Approved by:
[Signature]
Scale:
1:10

ROTORCOMP w/ AA DRYING
NK60 w/ SUNFAB M012WH-B4KU
SKID MOUNTED, SWEET SERVICE

Company:
HUSKY OIL OPERATIONS LTD
Quote/Ref. NO.:
Job NO.:
Unit NO.:
Drawing NO.:
Rev.:

1-795
RCAA-07058
GA-RCAA07058-B-01
1