



P:\PC Compression\Drafting\Work-Internal\1-795 RCAA-07058 HUSKY NK60 AB\B-GA-RCAA07058 AB.dwg, ELEVATION VIEWS, 7/24/2007 9:21:17 AM, scottape, This drawing is the Property of PC Compression Inc. It may not be duplicated without written permission.

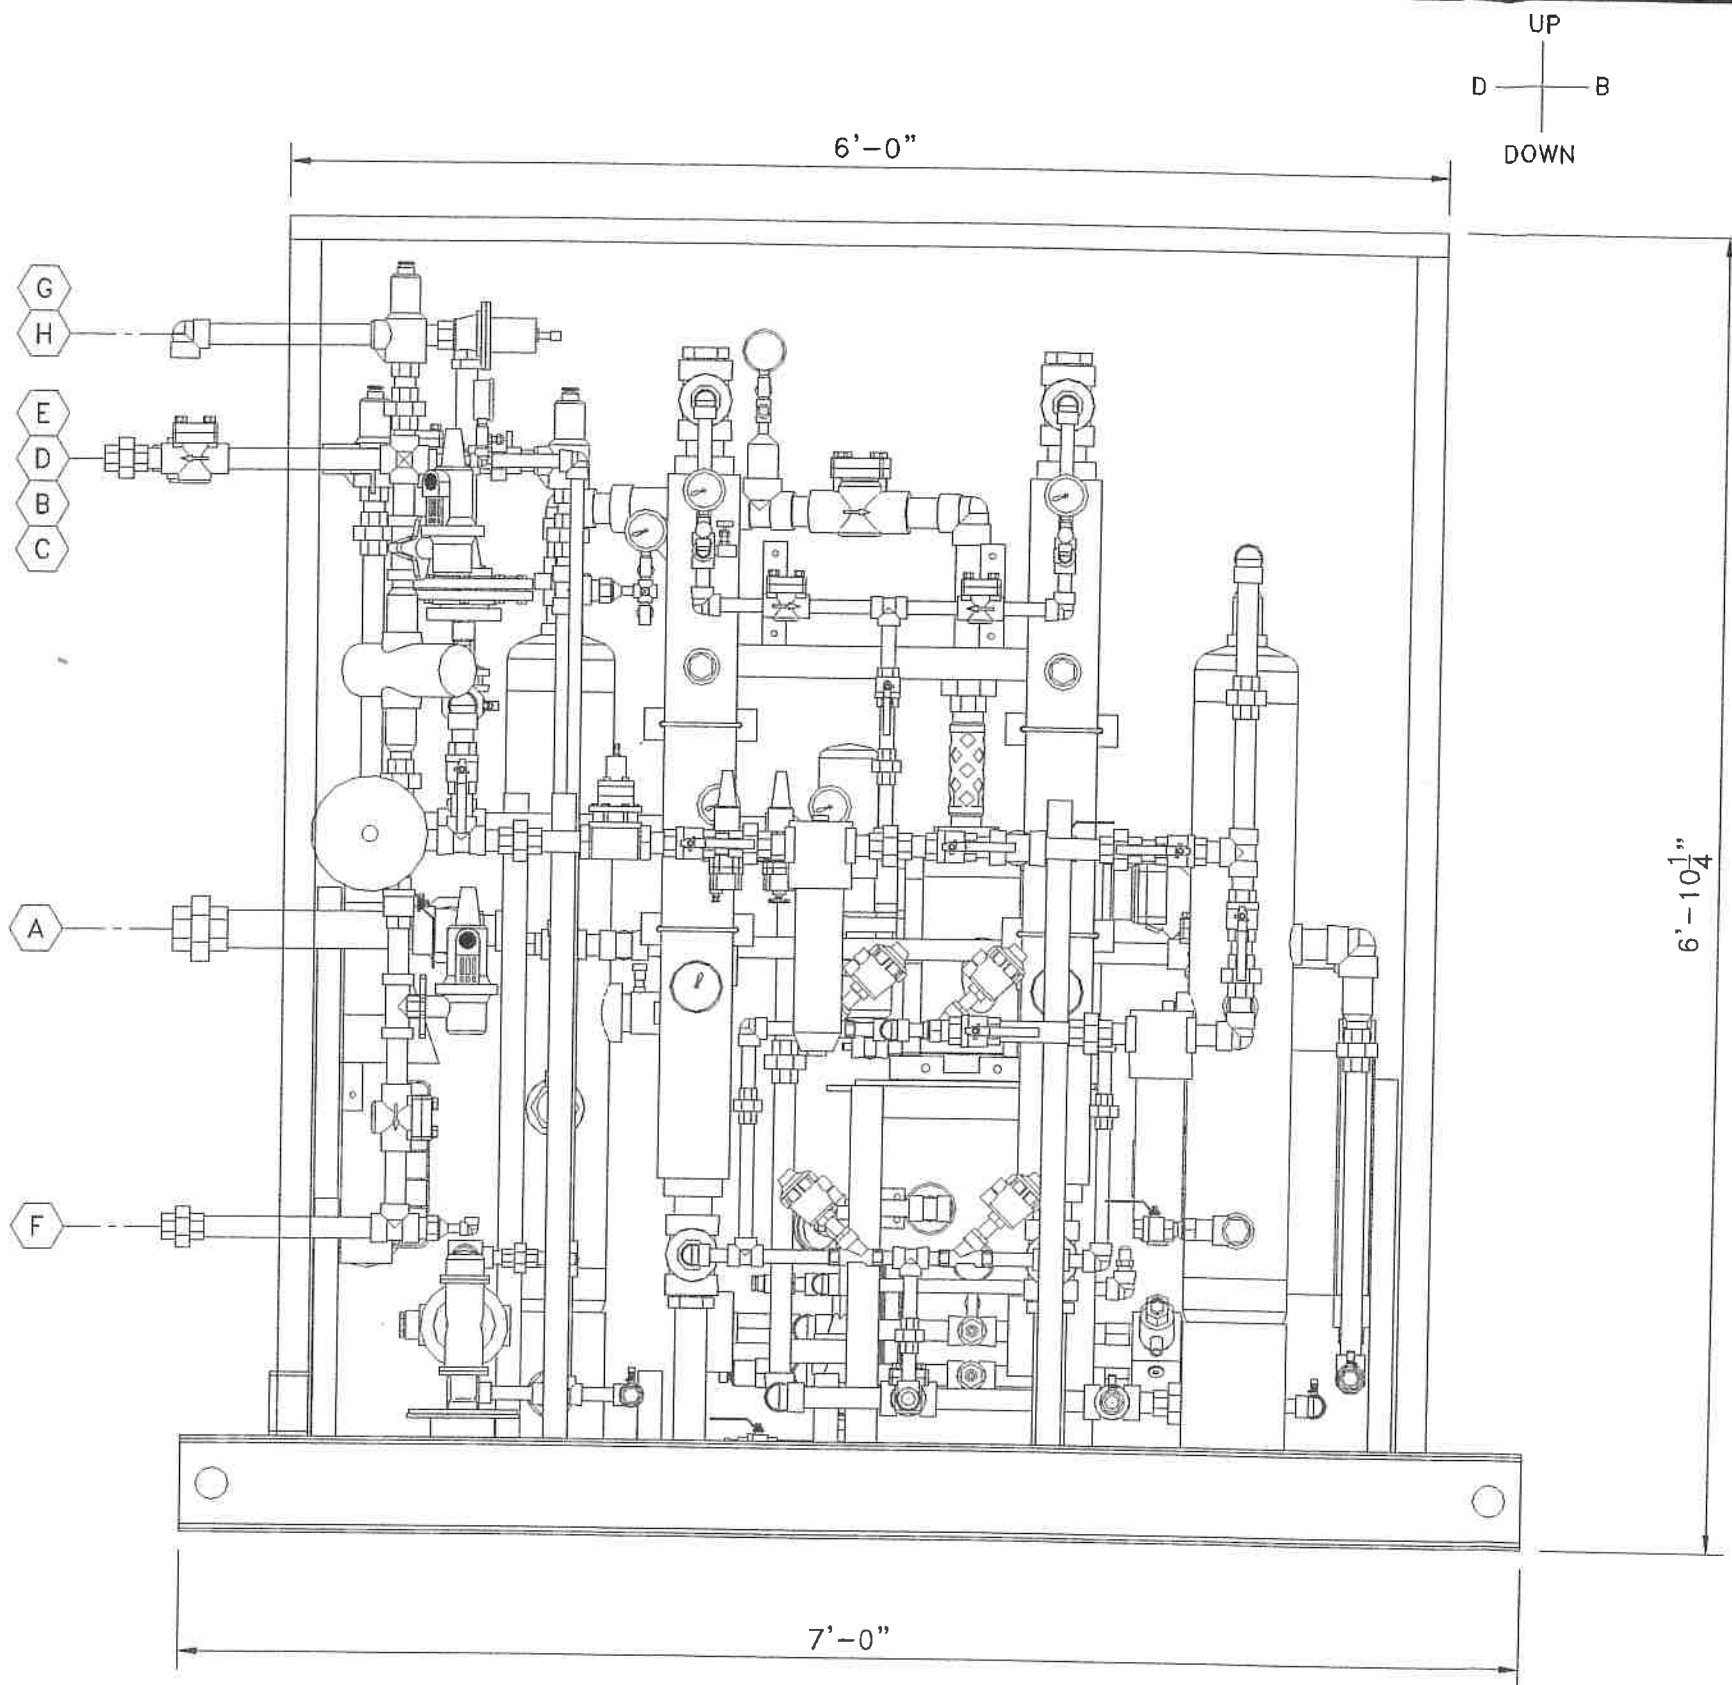

'C' ELEVATION VIEW
SCALE 1:12

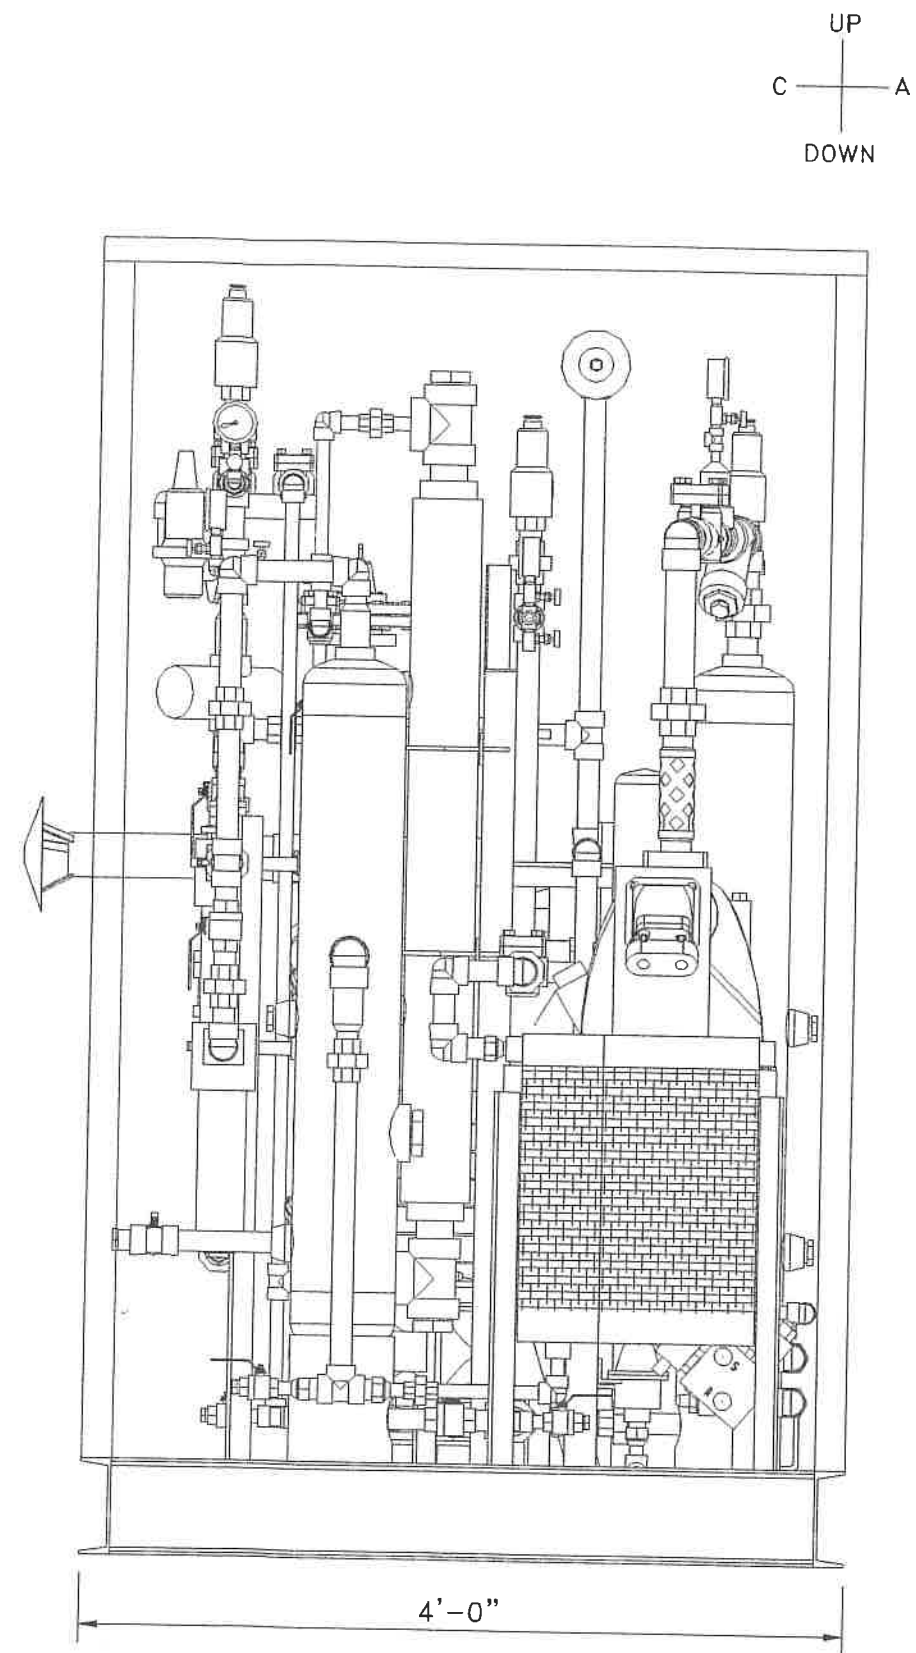

'B' ELEVATION VIEW
SCALE 1:12

1 AS BUILT		SDC	07-24-07		
0 ISSUED FOR CONSTRUCTION		SDC	05-29-07	SDC	BH
REV.	DESCRIPTION	BY	DATE	CHKD	APPD



2308-8th Street
Nisku, Alberta
T0C 7Z2

Office: 780.955.4282
Fax: 780.955.4284
Toll Free: 866.955.4282

Drawn by: S.D.C.	Date: 07-18-06	Checked by: SDC	Approved by: BH	Company: HUSKY OIL OPERATIONS LTD
Scale: 1:12	Quote/Ref. NO.:	JOB NO.:	Unit NO.:	Drawing NO.:
		1-795	RCAA-07058	GA-RCAA07058-B-02

1