



P:\PC Compression\Drafting\Internal\Work-Internal\1-795 RCAA-07058 HUSKY NK60 AB\B-C-A-RCAA07058 AB.dwg, ISOMETRIC VIEWS 2, 7/24/2007 9:21:51 AM, scottape, This drawing is the Property of PC Compression Inc. It may not be dup

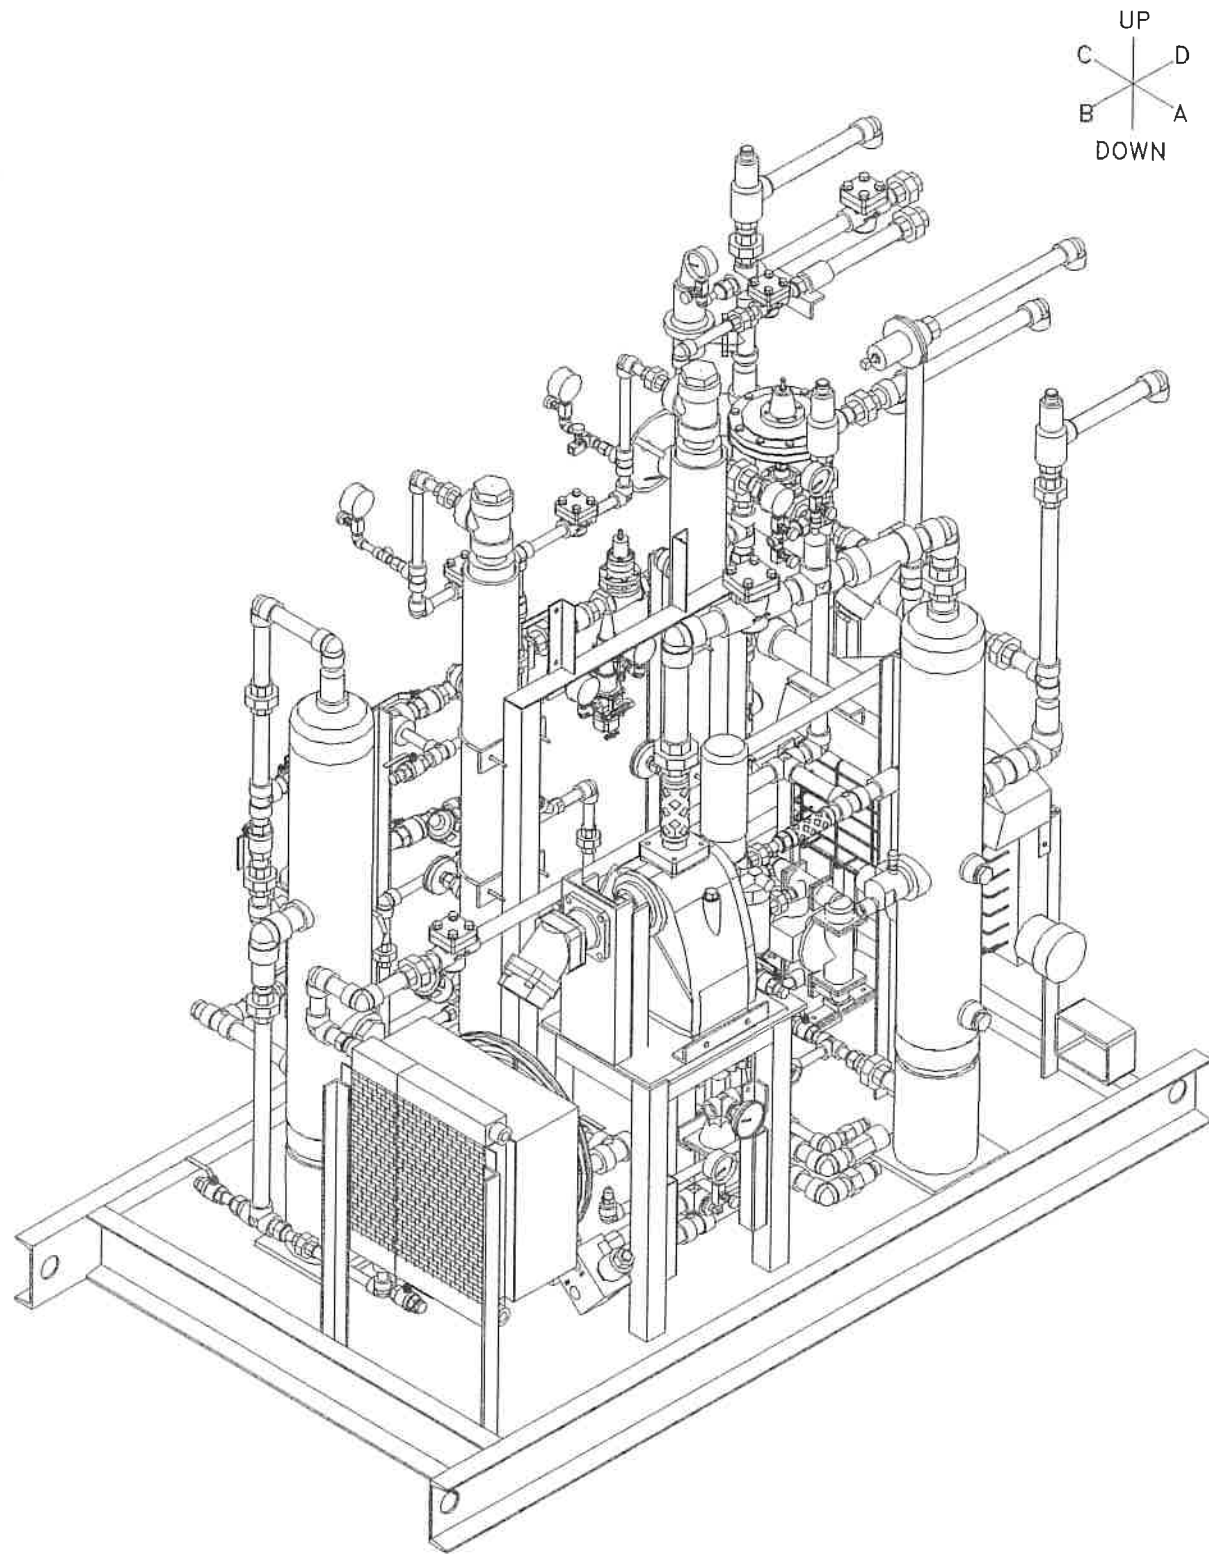

'BA' ISOMETRIC VIEW
SCALE 1:15

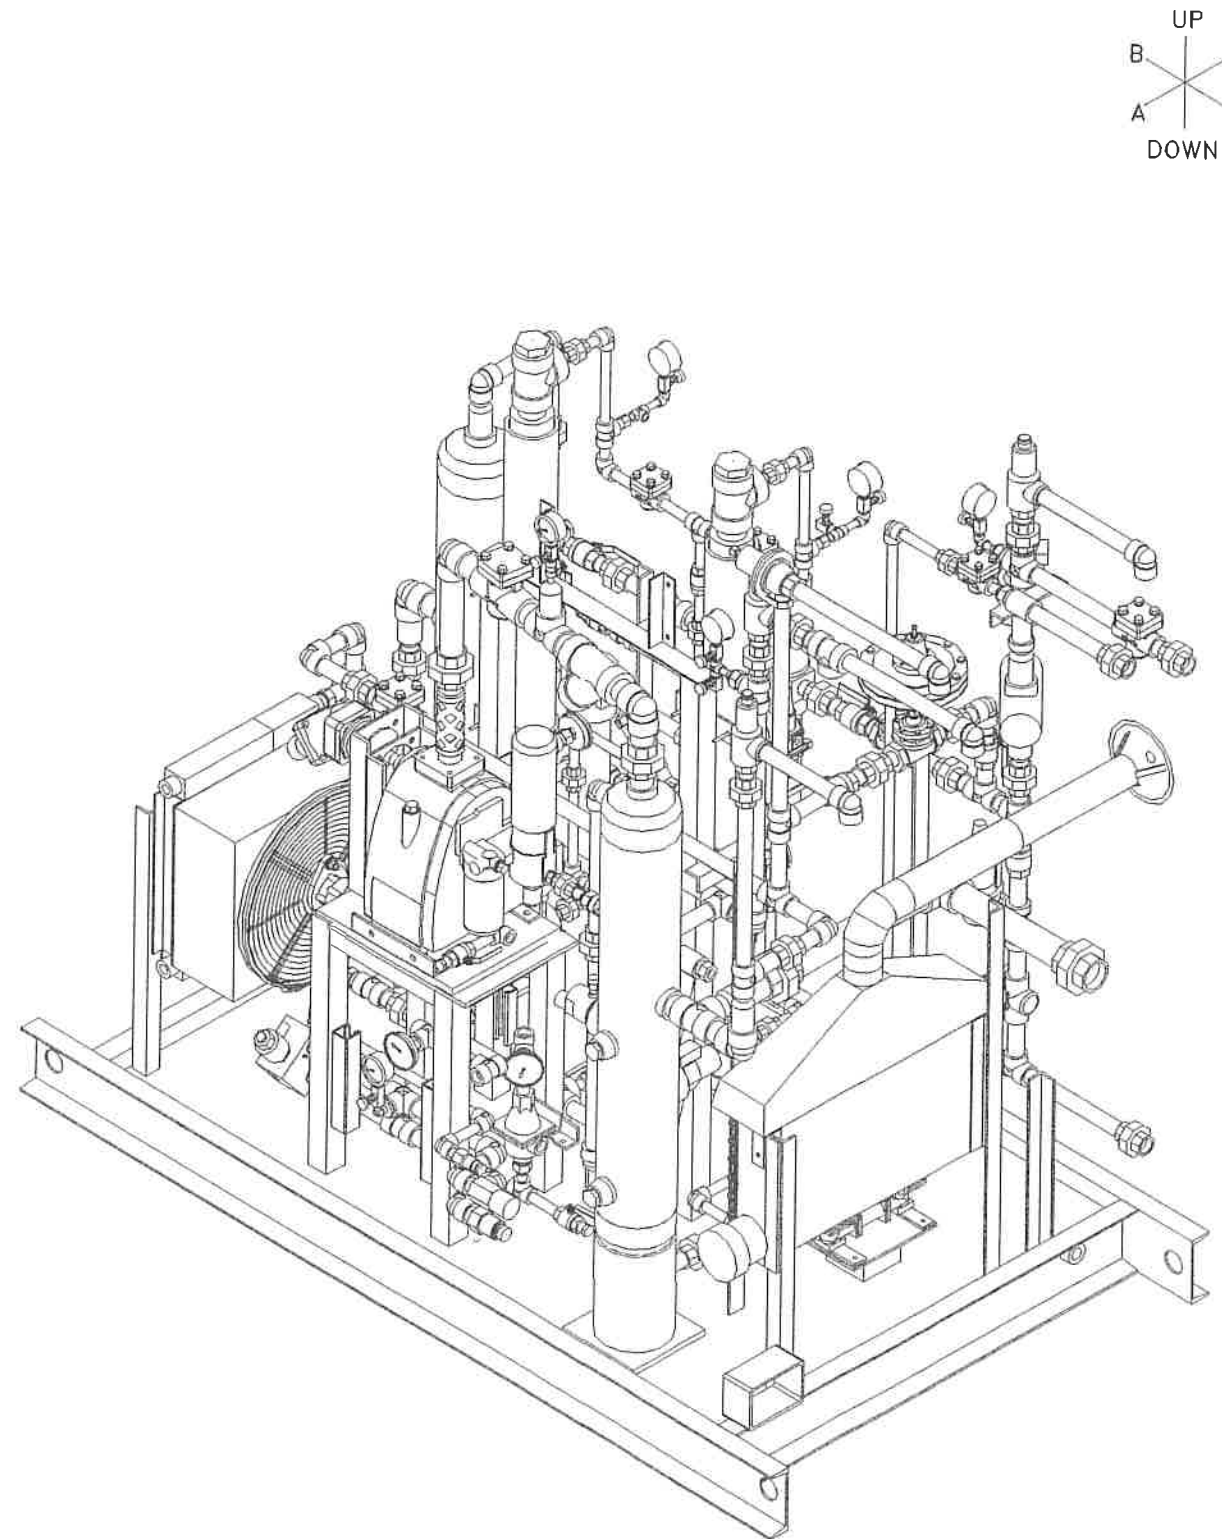

'AD' ISOMETRIC VIEW
SCALE 1:15

				2308-8th Street Nisku Alberta T9E 7Z2		Office: 780.955.4292 Fax: 780.955.4294 Toll Free: 866.955.4292		Drawn by: S.D.C. Date: 07-18-06 Checked by: S.D.C. Approved by: S.D.C.		ROTORCOMP w/ AA DRYING NK60 w/ SUNFAB M012WH-B4KU SKID MOUNTED, SWEET SERVICE									
AS BUILT				SDC 07-24-07				Company:		HUSKY OIL OPERATIONS LTD									
ISSUED FOR CONSTRUCTION				SDC 05-29-07		SDC BH		Quote/Ref. NO.:		JOB NO.:		Unit NO.:		Drawing NO.:					
DESCRIPTION				BY		DATE		CHKD		APPD		1-795		RCAA-07058		GA-RCAA07058-B-04		1	