

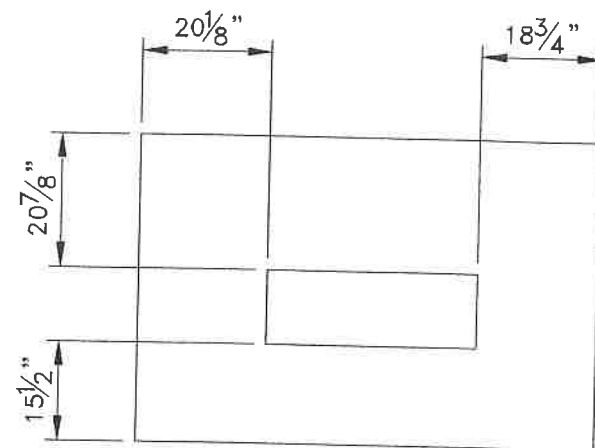



P:\PC Compression\Drafting\Work-Internal\1-795 RCAA-07058 HUSKY NK60 AB\F-BLD-RCAA07058 AB.dwg, Plan, 7/24/2007 9:24:34 AM, scottpc. This drawing is the Property of PC Compression Inc. It may not be duplicated or tra

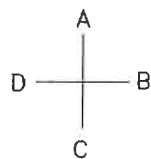


PLAN VIEW
SCALE 1:30

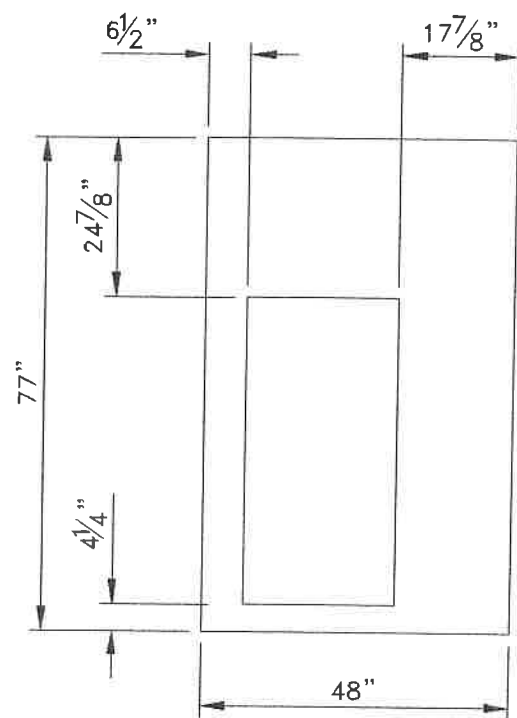


LEFT SIDE VIEW
SCALE 1:30

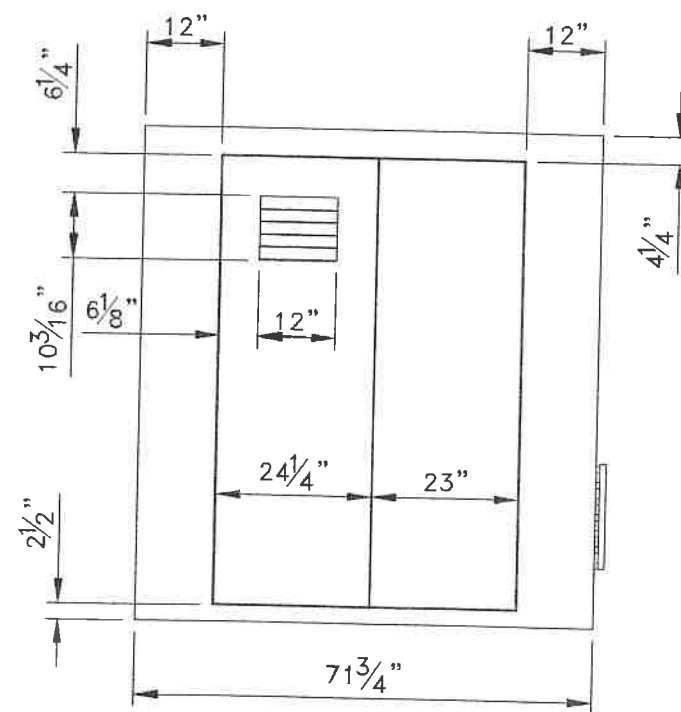


FRONT & BACK VIEW
SCALE 1:30

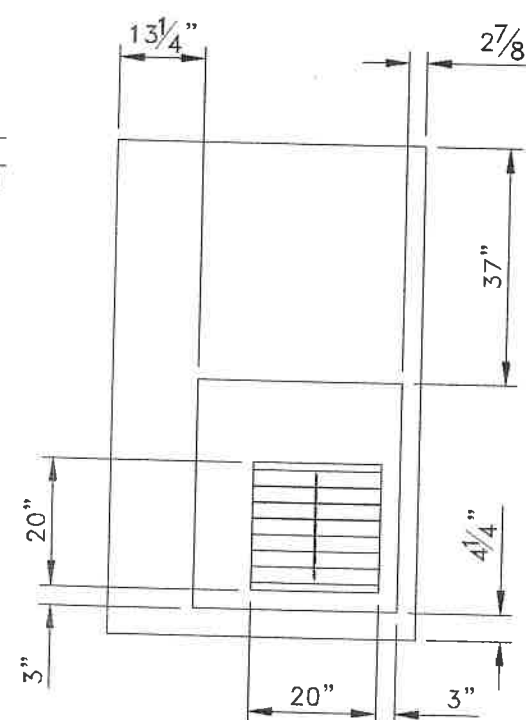

RIGHT SIDE VIEW
SCALE 1:30

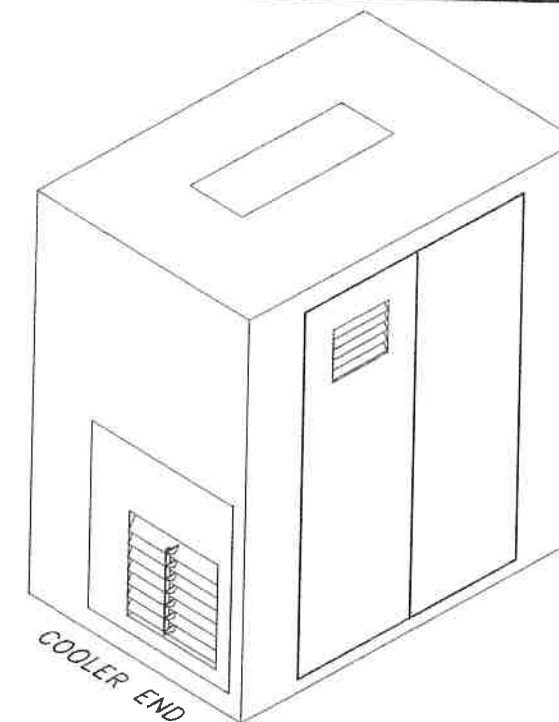

NE ISOMETERIC VIEW
SCALE 1:30

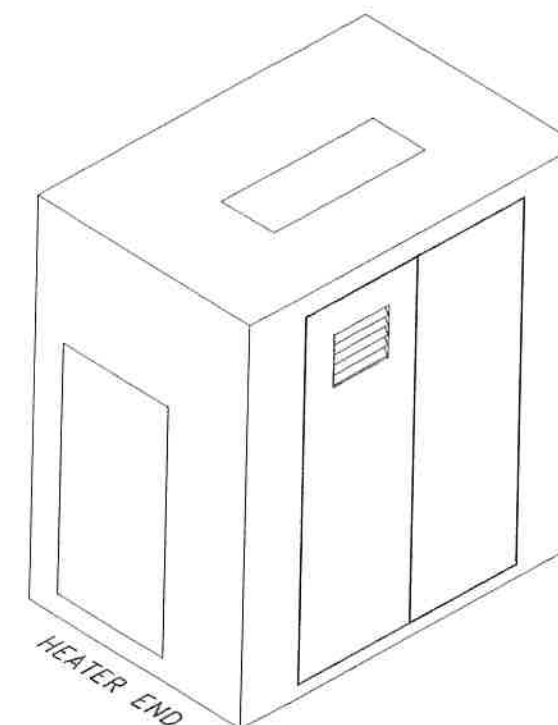

SW ISOMETERIC VIEW
SCALE 1:30

GENERAL NOTES:

- BUILDING WALLS & ROOF MADE OF 1 1/2" THICK FOAM INSULATED PANELS w/ GALVALUME INTERIOR AND EXTERIOR

REV.		AS BUILT		DESCRIPTION		SDC 07-24-07		BY		DATE		CHKD		APPD	
2308 8th Street Nisku, Alberta T9E 7Z2															
Office: 780.955.4282 Fax: 780.955.4284 Toll Free: 866.955.4282															
Drawn by: F.L.															
Date: 11-29-06															
Checked by: SDC															
Approved by: 64															
Scale: 1:30															
Company: ROTORCOMP w/ AA DRYING															
1-1/2" FOAM PANEL BUILDING															
BUILDING LAYOUT															
HUSKY OIL OPERATIONS LTD															
Quote/Ref. NO.:		JOB NO.:		Unit NO.:		Drawing NO.:		Rev.:							
1-795		RCAA-07058		BLD-RCAA07058-F-01		1									