


SECTION A
00-04

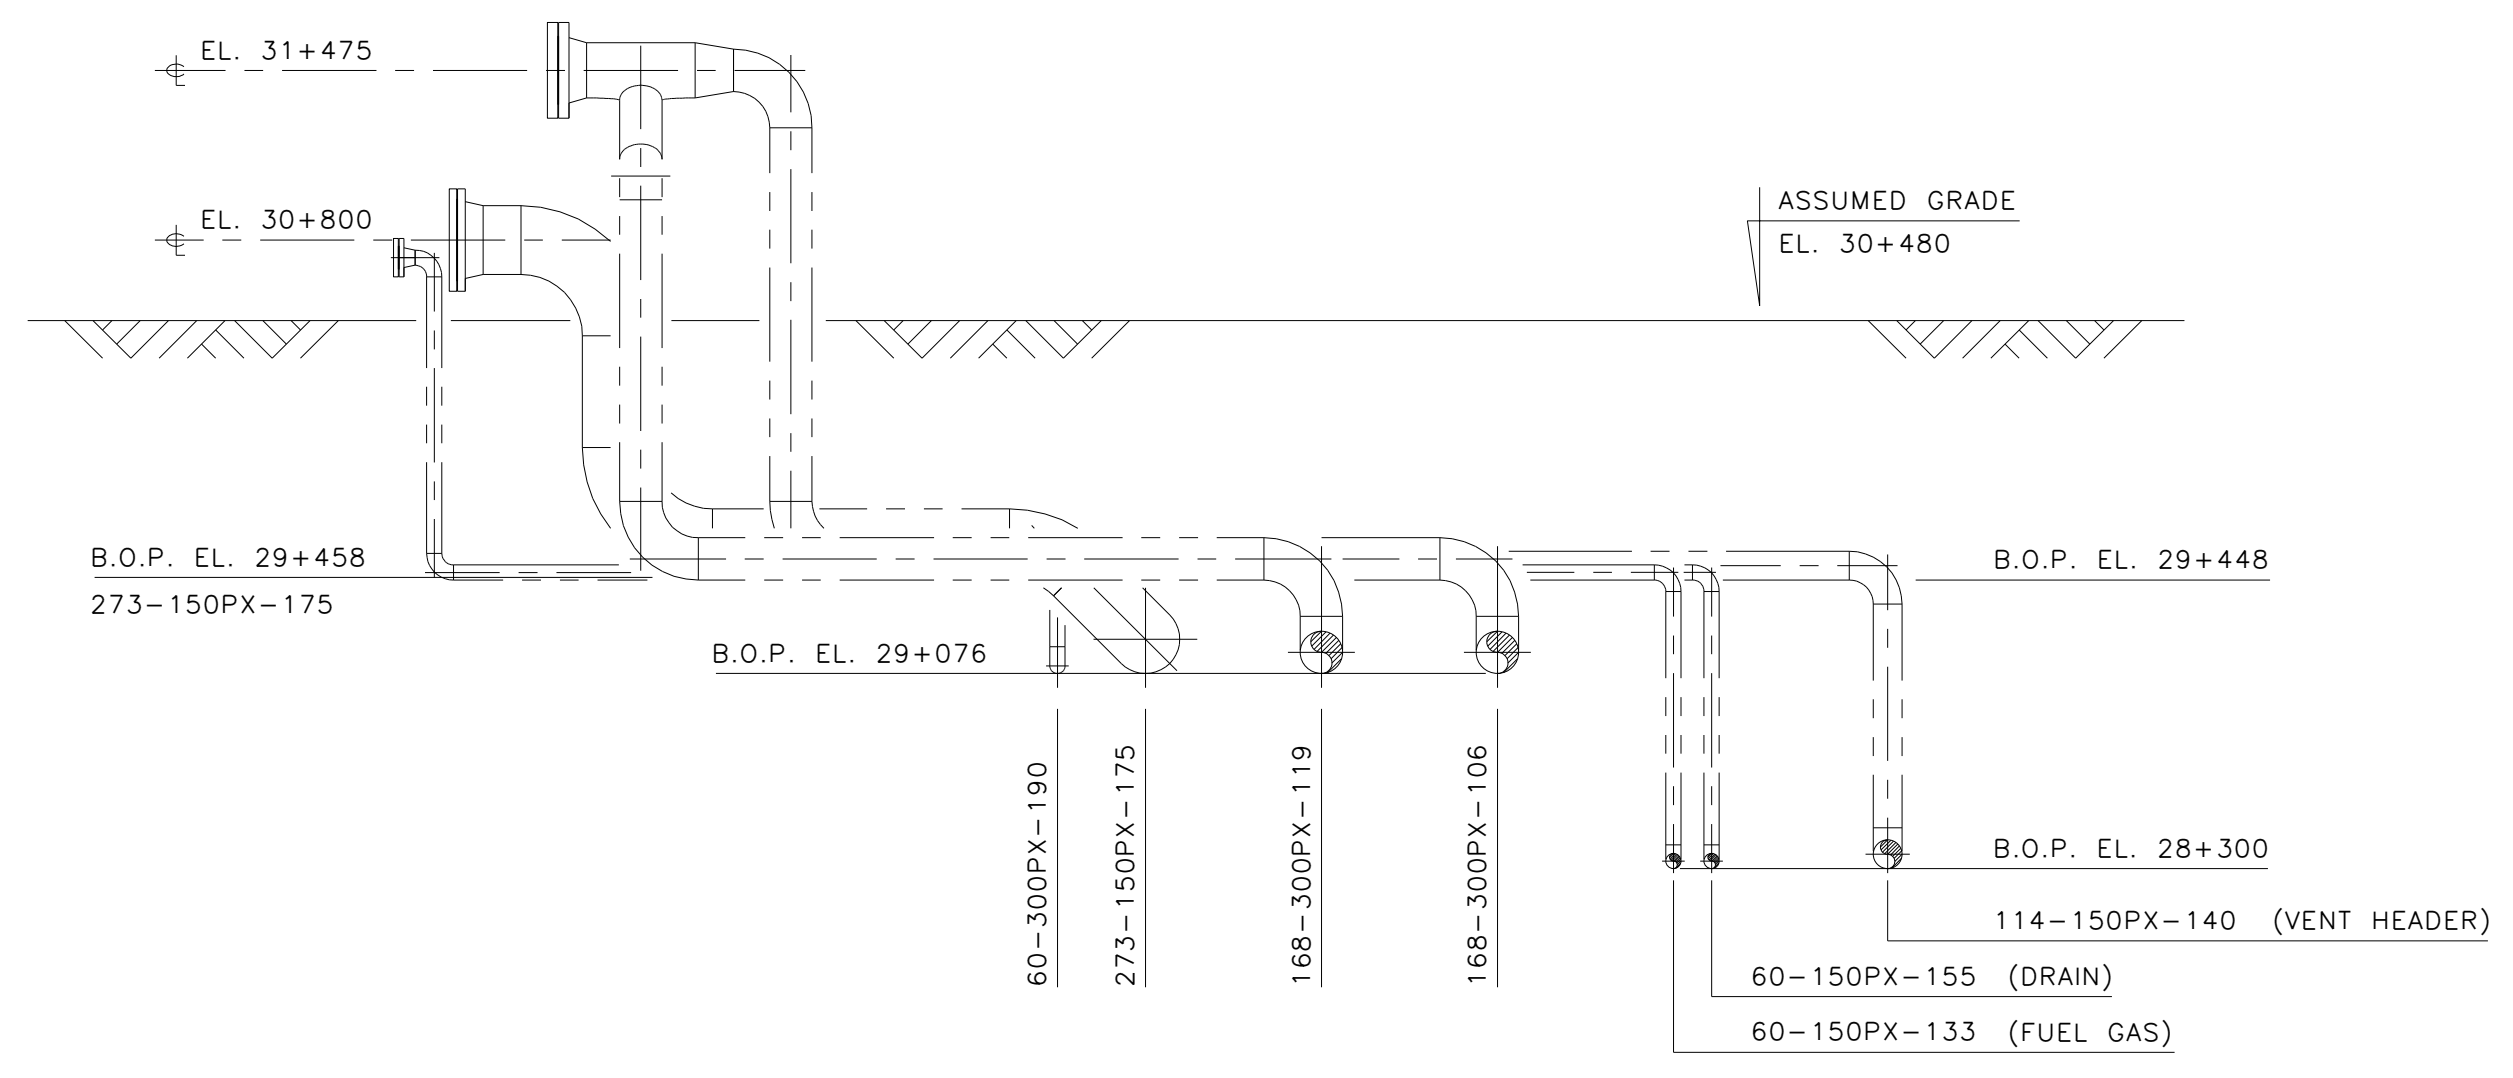

SECTION B
00-04

NO.	REVISION	PROJ. No.	BY	DATE	CHK.	DATE
3	POST CONSTRUCTION ISSUE	23154	L. St.	03.07.17		
2	REDRAWN ON CAD. K-620 REMOVED	23154	FJ	03.01.21	RD	03.02.06
1	AS-BUILT (1992)		CR	92.10.20		
0	ISSUED FOR CONSTRUCTION					

PERMIT STAMP:	

GENERAL NOTES:

- "POST CONSTRUCTION DRAWINGS" ARE GENERATED FROM CONSTRUCTION CHANGE INFORMATION FORWARDED TO BOWER DAMBERGER ROLSETH ENGINEERING LTD. BY THE OWNER'S FIELD SUPERVISORS AND/OR THIRD PARTY CONTRACTORS. ANY CHANGES NOT DOCUMENTED WILL NOT APPEAR ON THE DRAWING AND THEREFORE THE DRAWING MAY NOT BE AN ACCURATE REPRESENTATION OF THE CONSTRUCTED FACILITY.
- PRIOR TO THE COMMENCEMENT OF ANY CONSTRUCTION AND/OR EXCAVATION IT SHALL BE THE RESPONSIBILITY OF THE OWNER'S REPRESENTATIVE TO VERIFY THE LOCATION AND STATUS OF ANY PIPING, ELECTRICAL EQUIPMENT OR BUILDINGS.
- ANY REVISIONS MADE TO EXISTING EQUIPMENT, PIPING OR ELECTRICAL ON A FACILITY NOT OCCUPIED BY B.D.R. ENG. LTD. IS ONLY SHOWN AS A REPRESENTATION OF WHAT EXISTS AND MUST BE VERIFIED BY THE OWNER.

DRN.	BY	DATE
CHK.	L.S.	92.06.10
APP'D.		
L.S.D.	14-10-62-04	W4M



HUSKY OIL OPERATIONS LIMITED		
FORT KENT COMPRESSOR STATION ADDITION COMPRESSOR K-620 AREA PIPING SECTIONS		
SCALE	DRAWING NUMBER	REV
1:30	D-7225-P-00-09	3