
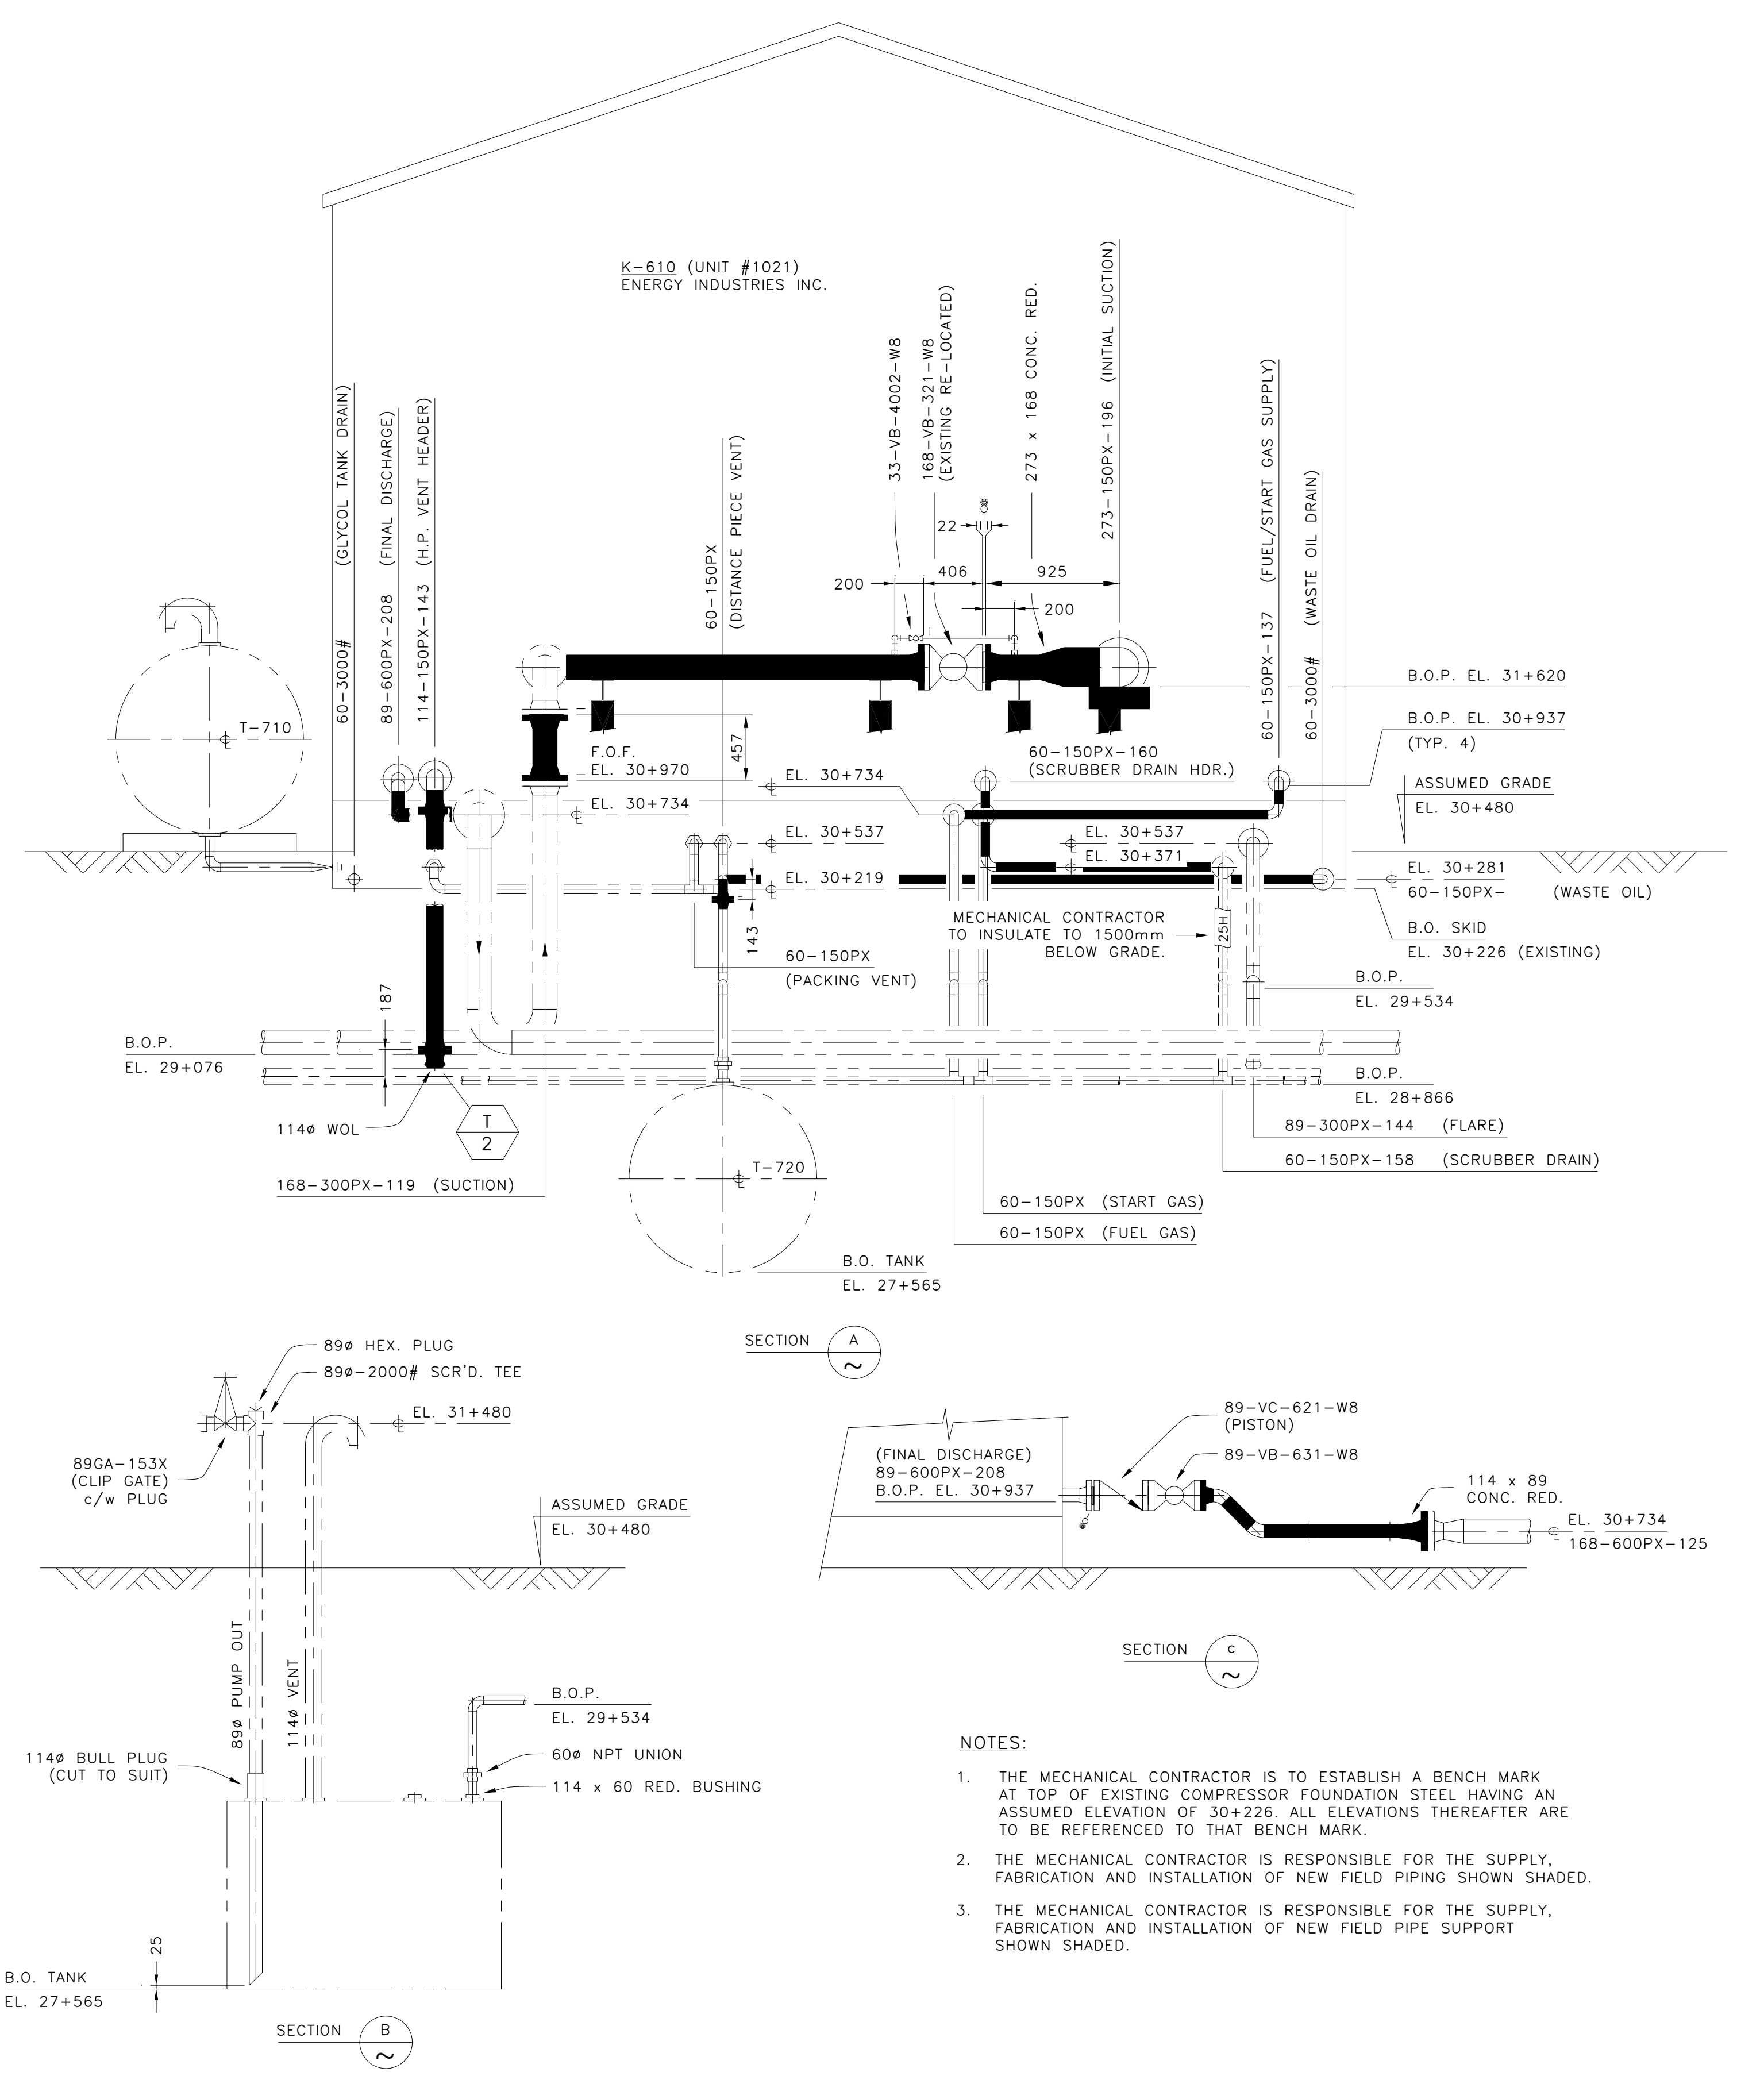


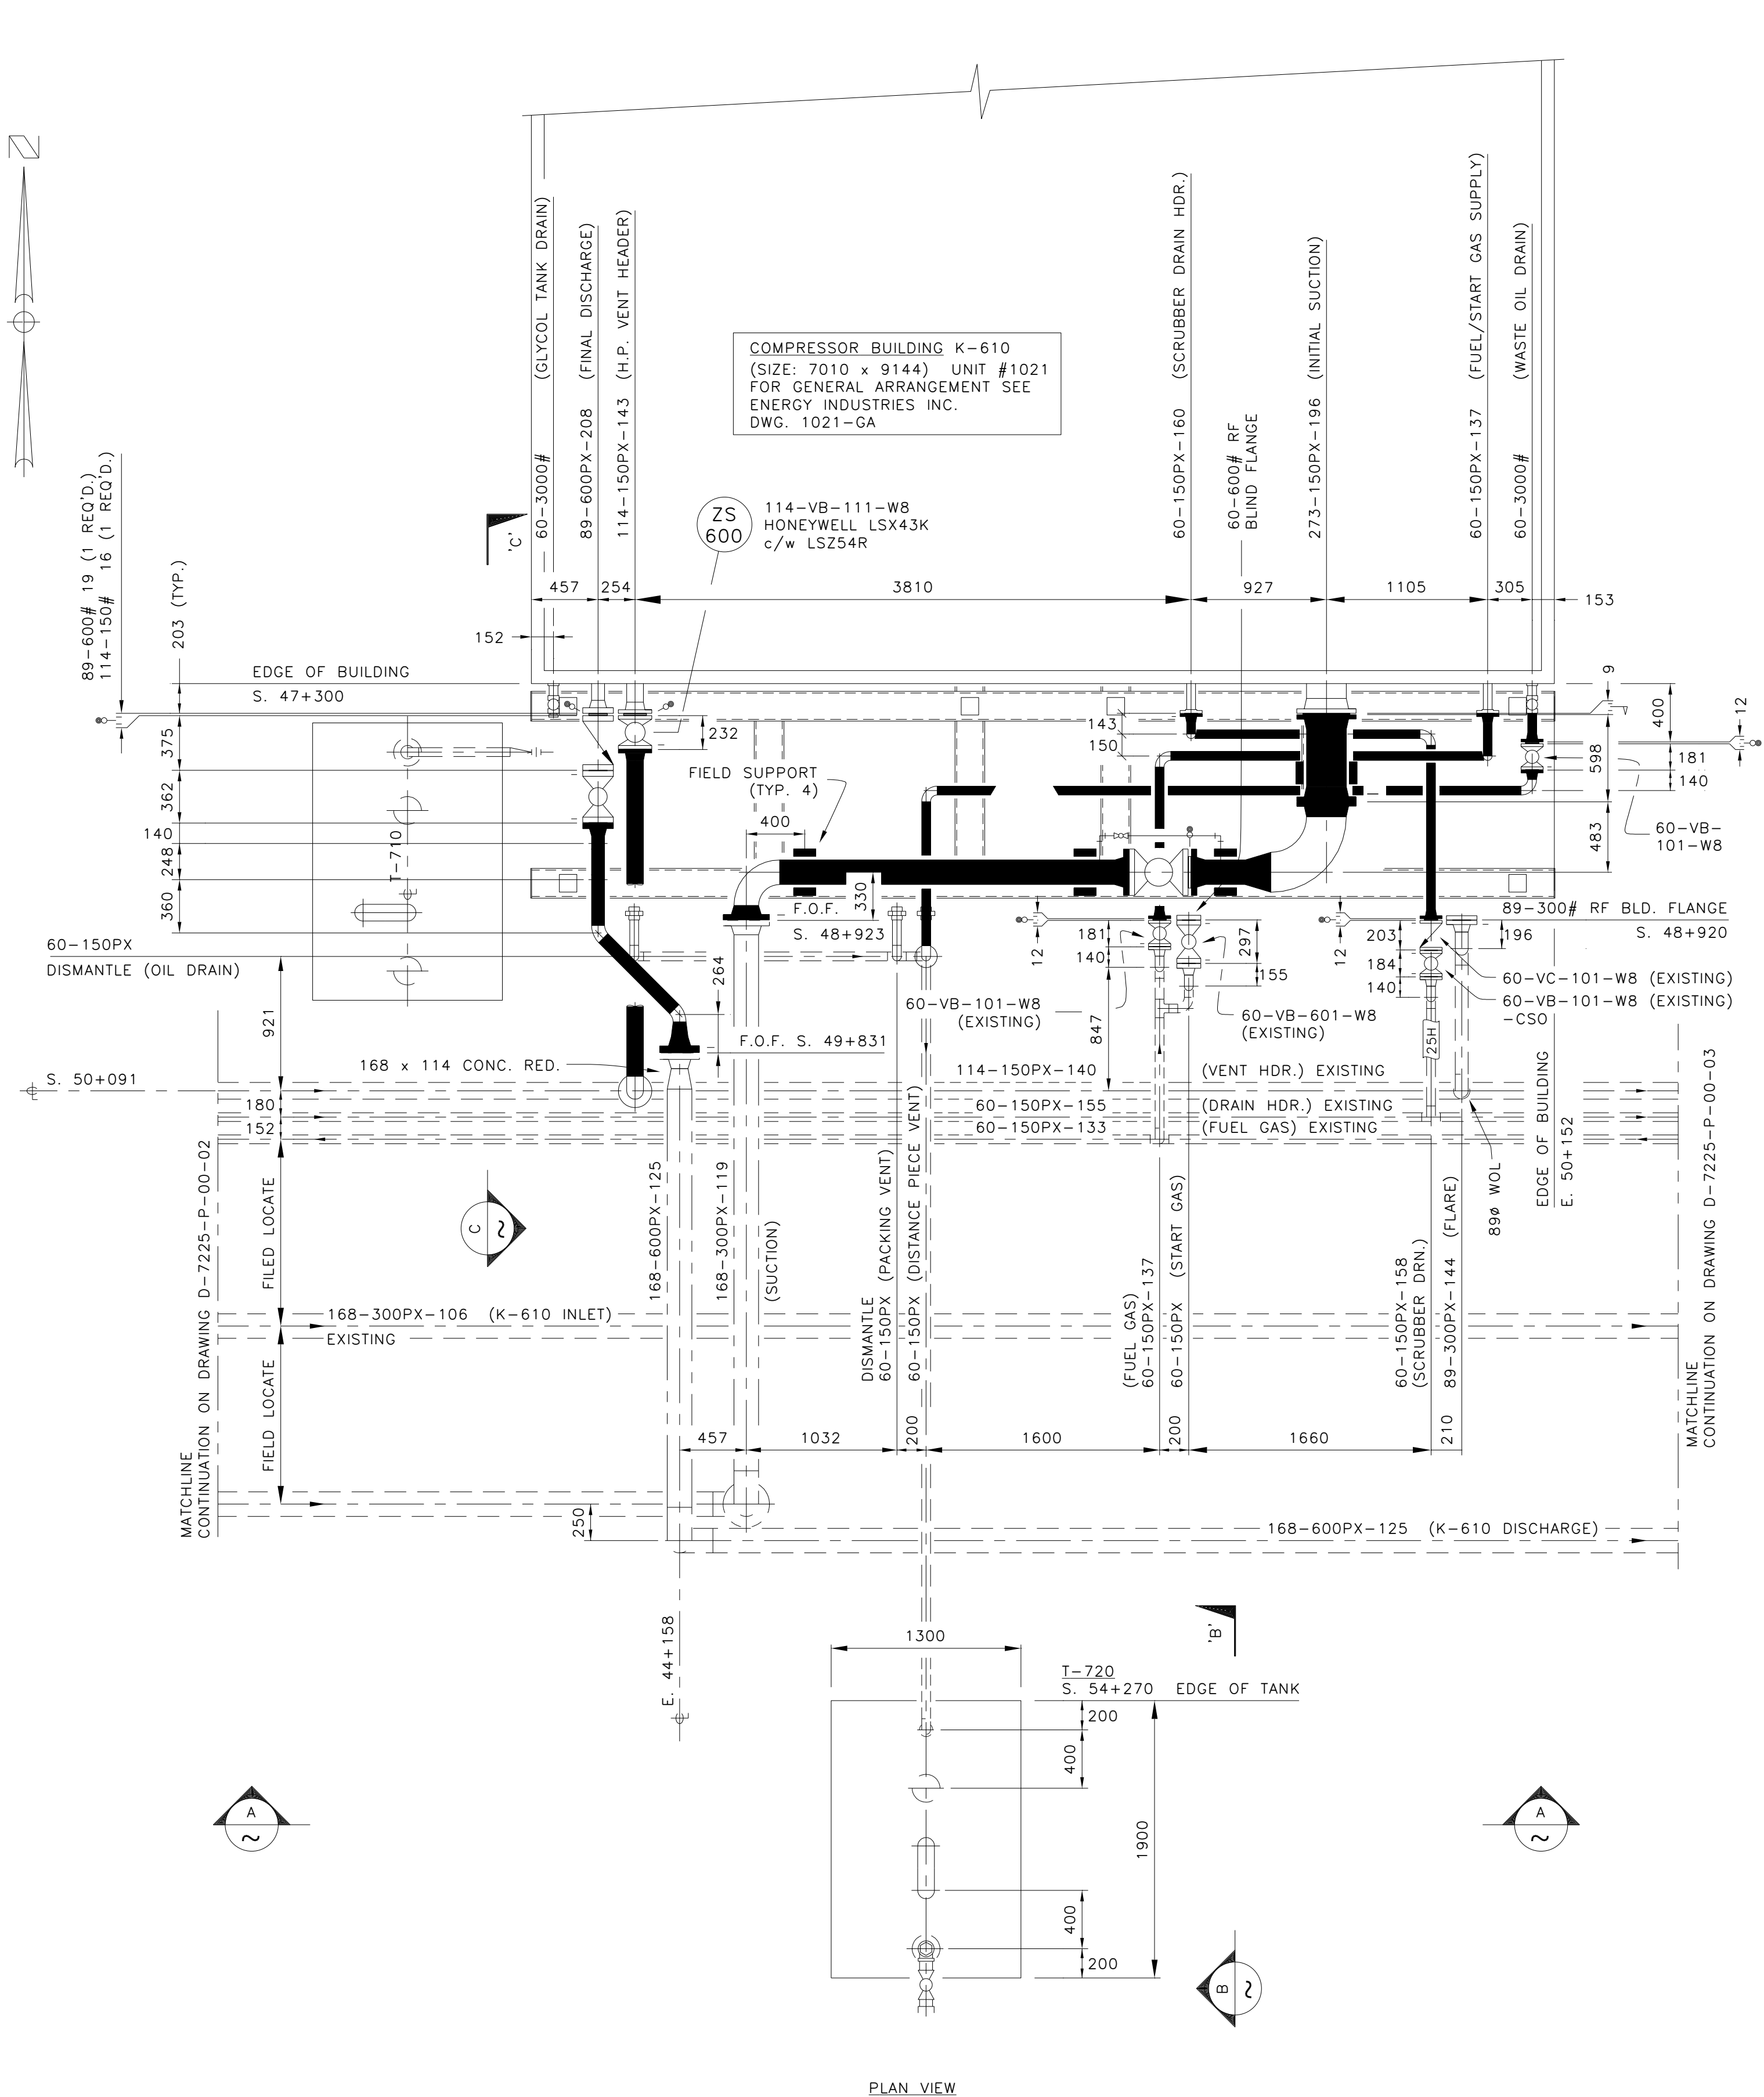

- NOTES:**
1. THE MECHANICAL CONTRACTOR IS TO ESTABLISH A BENCH MARK AT TOP OF EXISTING COMPRESSOR FOUNDATION STEEL HAVING AN ASSUMED ELEVATION OF 30+226. ALL ELEVATIONS THEREAFTER ARE TO BE REFERENCED TO THAT BENCH MARK.
 2. THE MECHANICAL CONTRACTOR IS RESPONSIBLE FOR THE SUPPLY, FABRICATION AND INSTALLATION OF NEW FIELD PIPING SHOWN SHADED.
 3. THE MECHANICAL CONTRACTOR IS RESPONSIBLE FOR THE SUPPLY, FABRICATION AND INSTALLATION OF NEW FIELD PIPE SUPPORT SHOWN SHADED.

NO.	REVISION	PROJ. No.	BY	DATE	CHK.	DATE
4	POST CONSTRUCTION ISSUE	23154	L St.	03.07.17		
3	REDRAWN ON CAD & MODIFIED FOR NEW K-610 COMPRESSOR	23154	FJ	02.12.20	RD	03.02.05
2	AS BUILT		CR	89.12.11		
1	ISSUED FOR CONSTRUCTION		RWF	89.10.2		
0	ISSUED FOR BID		RWF	89.9.21		

PERMIT STAMP:						

GENERAL NOTES:	BY	DATE
1. "POST CONSTRUCTION DRAWINGS" ARE GENERATED FROM CONSTRUCTION CHANGE INFORMATION FORWARDED TO BOWER DAMBERGER ROLSETH ENGINEERING LTD. BY THE OWNER'S FIELD SUPERVISORS AND/OR FIELD CONTRACTORS. ANY CHANGES NOT DOCUMENTED WILL NOT APPEAR ON THE DRAWINGS AND THEREFORE THE DRAWING MAY NOT BE AN ACCURATE REPRESENTATION OF THE CONSTRUCTED FACILITY.	DRN.	R. FLUTER 89.8.23
2. PRIOR TO THE COMMENCEMENT OF ANY CONSTRUCTION AND/OR EXCAVATION IT SHALL BE THE RESPONSIBILITY OF THE OWNER'S REPRESENTATIVE TO VERIFY THE LOCATION AND EXISTENCE OF ANY PIPING, ELECTRICAL, EQUIPMENT OR BUILDINGS.	CHK.	
3. ANY REVISIONS MADE TO EXISTING EQUIPMENT, PIPING OR ELECTRICAL ON A FACILITY NOT DESIGNED BY BDR ENG. LTD. IS ONLY SHOWN AS A REPRESENTATION OF WHAT EXISTS AND MUST BE VERIFIED BY THE OWNER.	APP'D.	
	L.S.D.	14-10-62-04 W4M

bdr
Bower Damberger Rolseth
Engineering Ltd.

HUSKY OIL OPERATIONS LIMITED		
FORT KENT COMPRESSOR STATION ADDITION COMPRESSOR K-610 AREA PIPING		
SCALE	DRAWING NUMBER	REV
1:30	D-7225-P-00-02	4