


PLAN VIEW

6200

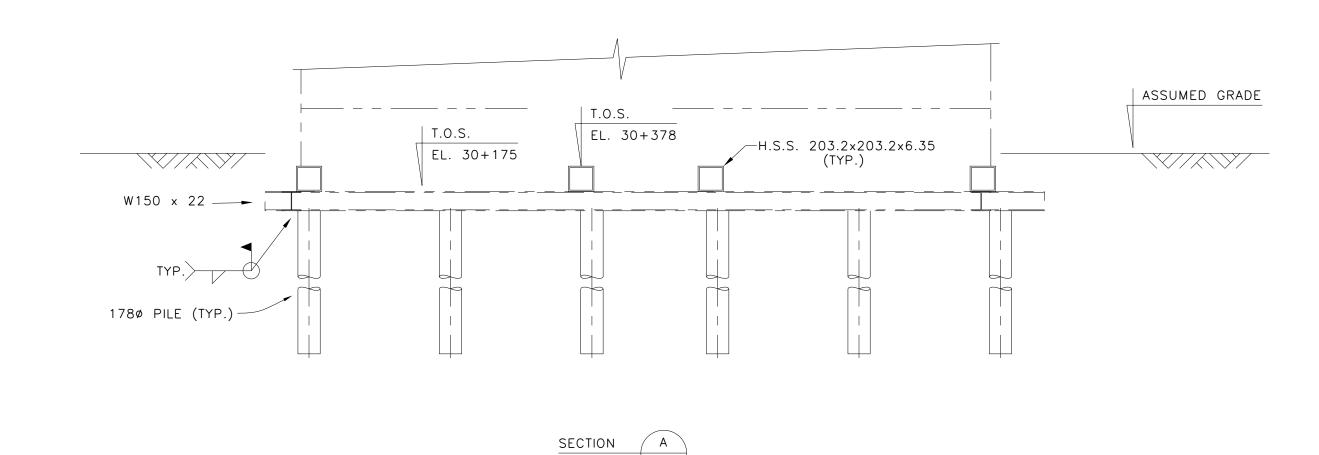

## NOTES

- 1. THE MECHANICAL CONTRACTOR IS TO ESTABLISH A BENCH MARK AT TOP OF EXISTING COMPRESSOR FOUNDATION STEEL HAVING AN ASSUMED ELEVATION OF 30+226. ALL ELEVATIONS THEREAFTER ARE TO BE REFERENCED TO THAT BENCH MARK.
- STRUCTURAL CONTRACTOR TO SUPPLY STEEL PRE-CUT, CLEANED TO SSPC-SP2, PRIMED WITH 1 S/C CLOVERDALE, TAGGED AND CAPPED WITH 6mm THICK END PLATES WHERE APPLICABLE.
- 3. COMPRESSOR SKID WILL BE SHIMMED TO ENSURE GOOD CONTACT BETWEEN THE SKID MAIN SUPPORT BEAMS AND THE FOUNDATION CROSS MEMBERS.
- 4. THE SKID WILL BE STITCH WELDED TO THE FOUNDATION STRUCTURAL STEEL AS ACCESS PERMITS. THIS SHOULD INCLUDE THE MAIN RUNNERS UNDER THE ENGINE AND AS WELL AS THE INSIDE AND OUTSIDE OF THE PERIMETER BEAMS.
- 5. NEW FIELD FOUNDATION STEEL SHOWN CROSS HATCHED.

## <u>NOTES</u>

- 1. PILES ARE TO BE DRIVEN TO REFUSAL OR A DEPTH OF 16,770mm.
- 2. REFUSAL SHALL BE DEFINED AS THE POINT AT WHICH IT REQUIRES 50 BLOWS WITH A 20 KILO JOULE (14,750 ft/lb) FORCE TO DRIVE THE PILE 305mm (1 ft.).
- 3. ALL PILES TO BE LEFT PROJECTING 600mm ABOVE GRADE.
- 4. ALL ELEVATIONS ARE REFERENCED TO TOP OF EXISTING DEHYDRATOR SKID HAVING AN ASSUMED ELEVATION OF EL. 30+734.

							PERMIT STAMP:
							TERMIT STAMIL.
5	POST CONSTRUCTION ISSUE	23154	L St.	03.07.17			
4	REDRAWN ON CAD. & MODIFIED FOR NEW K-610 COMPRESSOR	23154	FJ	03.01.16	RD	03.02.06	
3	"AS BUILT"		CR				
2	ADDED STEEL ELEVATIONS	7225	CR	88.01.27			
1	ISSUED FOR CONSTRUCTION	7225	FJ	88.01.27			
0	ISSUED FOR BID	7225	CR	88.01.12			
NO.	REVISION	PROJ. No.	BY	DATE	снк.	DATE	

GENERAL NOTES:

1. "POST CONSTRUCTION DRAWINGS" ARE GENERATED FROM CONSTRUCTION CHANGE INFORMATION FORWARDED TO BOWER DAMBERGER ROLSETH ENGINEERING LTD. BY THE OWNER'S FIELD SUPERVISORS AND ON HIRED CONTRACTORS. ANY CHANGES NOT DOCUMENTED WILL NOT APPEAR ON THE DRAWINGS AND THEREFORE THE DRAWING MAY NOT BE AN ACCURATE REPRESENTATION OF THE CONSTRUCTED FACILITY.

2. PRIOR TO THE COMMENCEMENT OF ANY CONSTRUCTION AND OR EXCAVATION IT SHALL BE THE RESPONSIBILITY OF THE OWNERS REPRESENTATIVE TO VERIFY THE LOCATION AND STATUS OF ANY PIPING, ELECTRICAL, EQUIPMENT OR BUILDINGS.

	BY	DATE
DRN.	CR	88.01.12
CHK.	F. JOSEPH	88.01.27
APP'D.		
L.S.D.	14-10-62	2-04 W4M

Bower Damberger Rolseth Engineering Ltd.

## HUSKY OIL OPERATIONS LIMITED

FORT KENT COMPRESSOR STATION COMPRESSOR K-600 FOUNDATION

SCALE	DRAWING NUMBER	REV
1:30	D-7225-C-00-01	5