


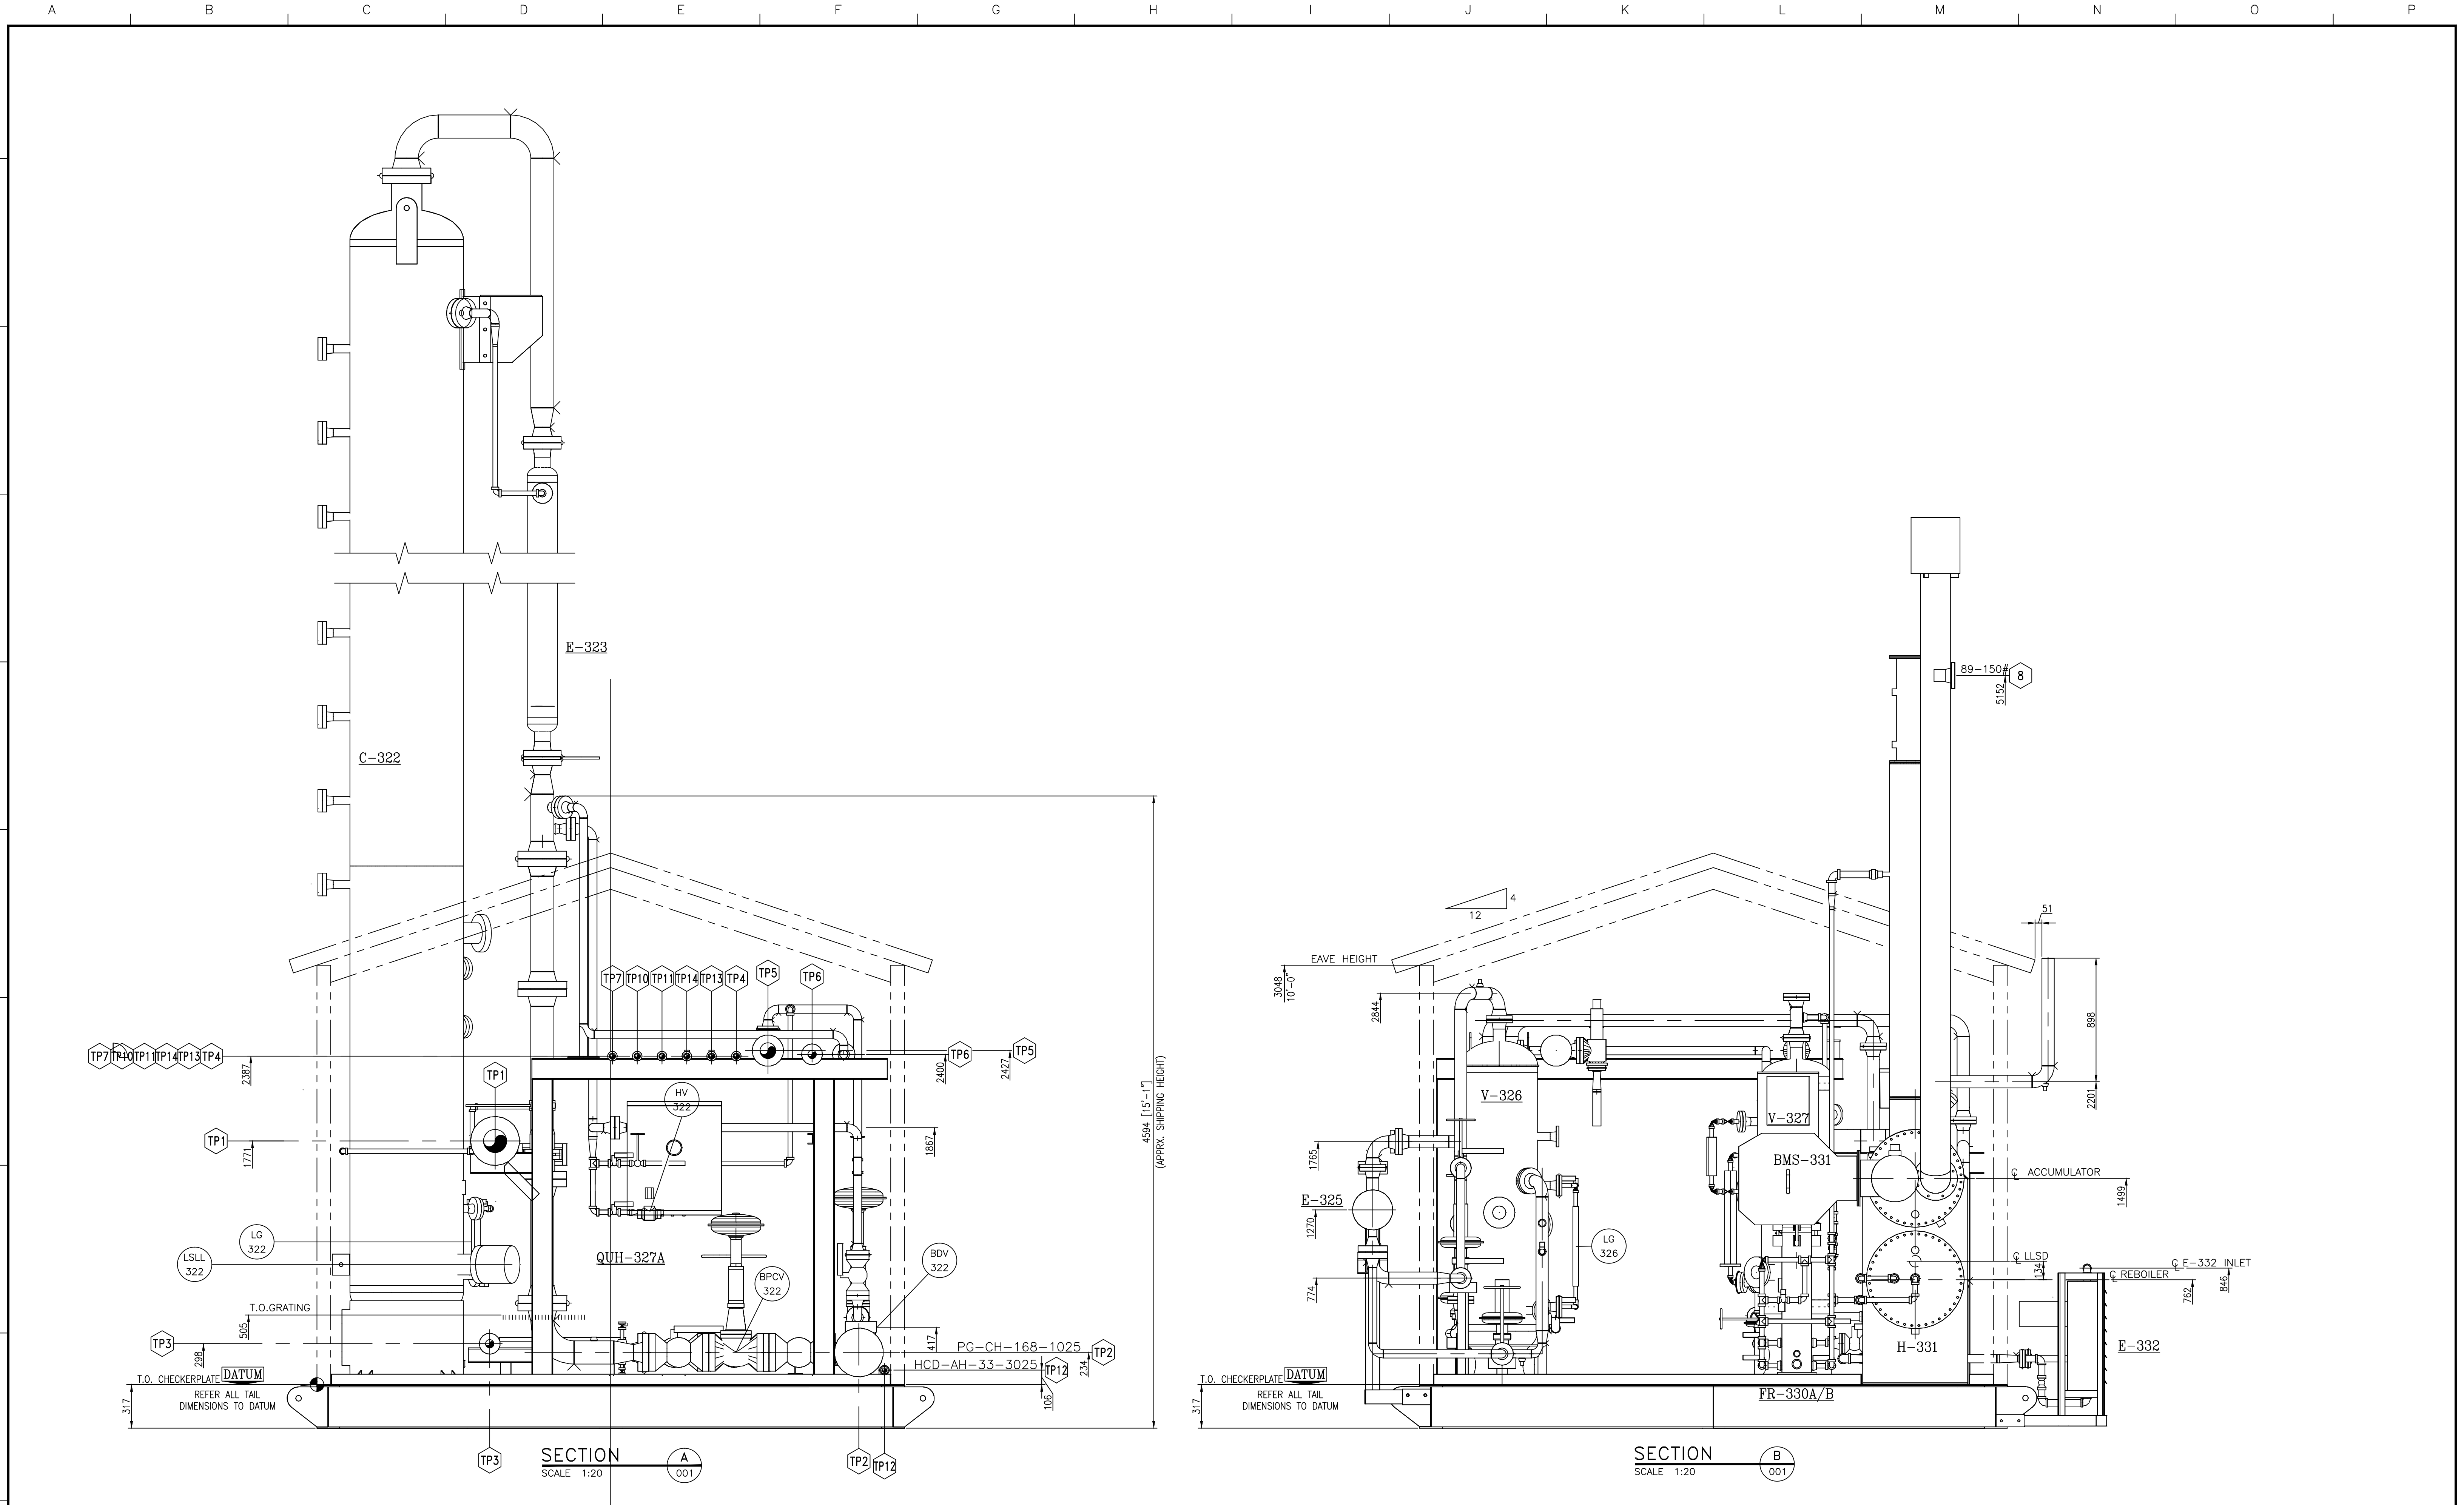

										No.	DATE	REVISIONS				BY	CHK	REW	APP	No.	DATE	REVISIONS				BY	CHK	REW	APP	SPECTRUM Process Systems	ENGINEERS' RECORD		DATE		SPECTRUM Process Systems	CLIENT		HUSKY ENERGY c/o EXCELSIOR ENGINEERING	
										A	SEPT. 24, 2014	ISSUED FOR APPROVAL				PT															DRAWN BY	PHUONG TRAN	23/09/2014	PROJECT		DEHYDRATION AND JT PACKAGE LSD: 02-20-050-18 WSM COMPRESSOR STATION RAVEN CREEK			
										0	OCT. 01, 2014	ISSUED FOR CONSTRUCTION				PT	TD	DC	LA										CHECKED BY		TANYA DIXON	02/10/2014	TITLE			PIPING AND EQUIPMENT GENERAL ARRANGEMENT-SECTION VIEWS			
										1	NOV. 05, 2014	REMOVED "HOLD" ON JT AREA/ ADDED TP#8,9				PT	TD	SS	LA												REVIEWED BY	DAVE CLARK	02/10/2014	P.O. #		8400843246			
												REVISED SHIPPING WEIGHT & DIMS																			PM APPD. BY	LANE ARIAS	02/10/2014	Scale		JOB No.			
												ADDED E-332 INLET ELEVATION																						DWS. No.		REV.			
										2	JAN. 16, 2015	AS-BUILT				JC																	L-14-05110-21-003		2				

P.O. # 8400843246