


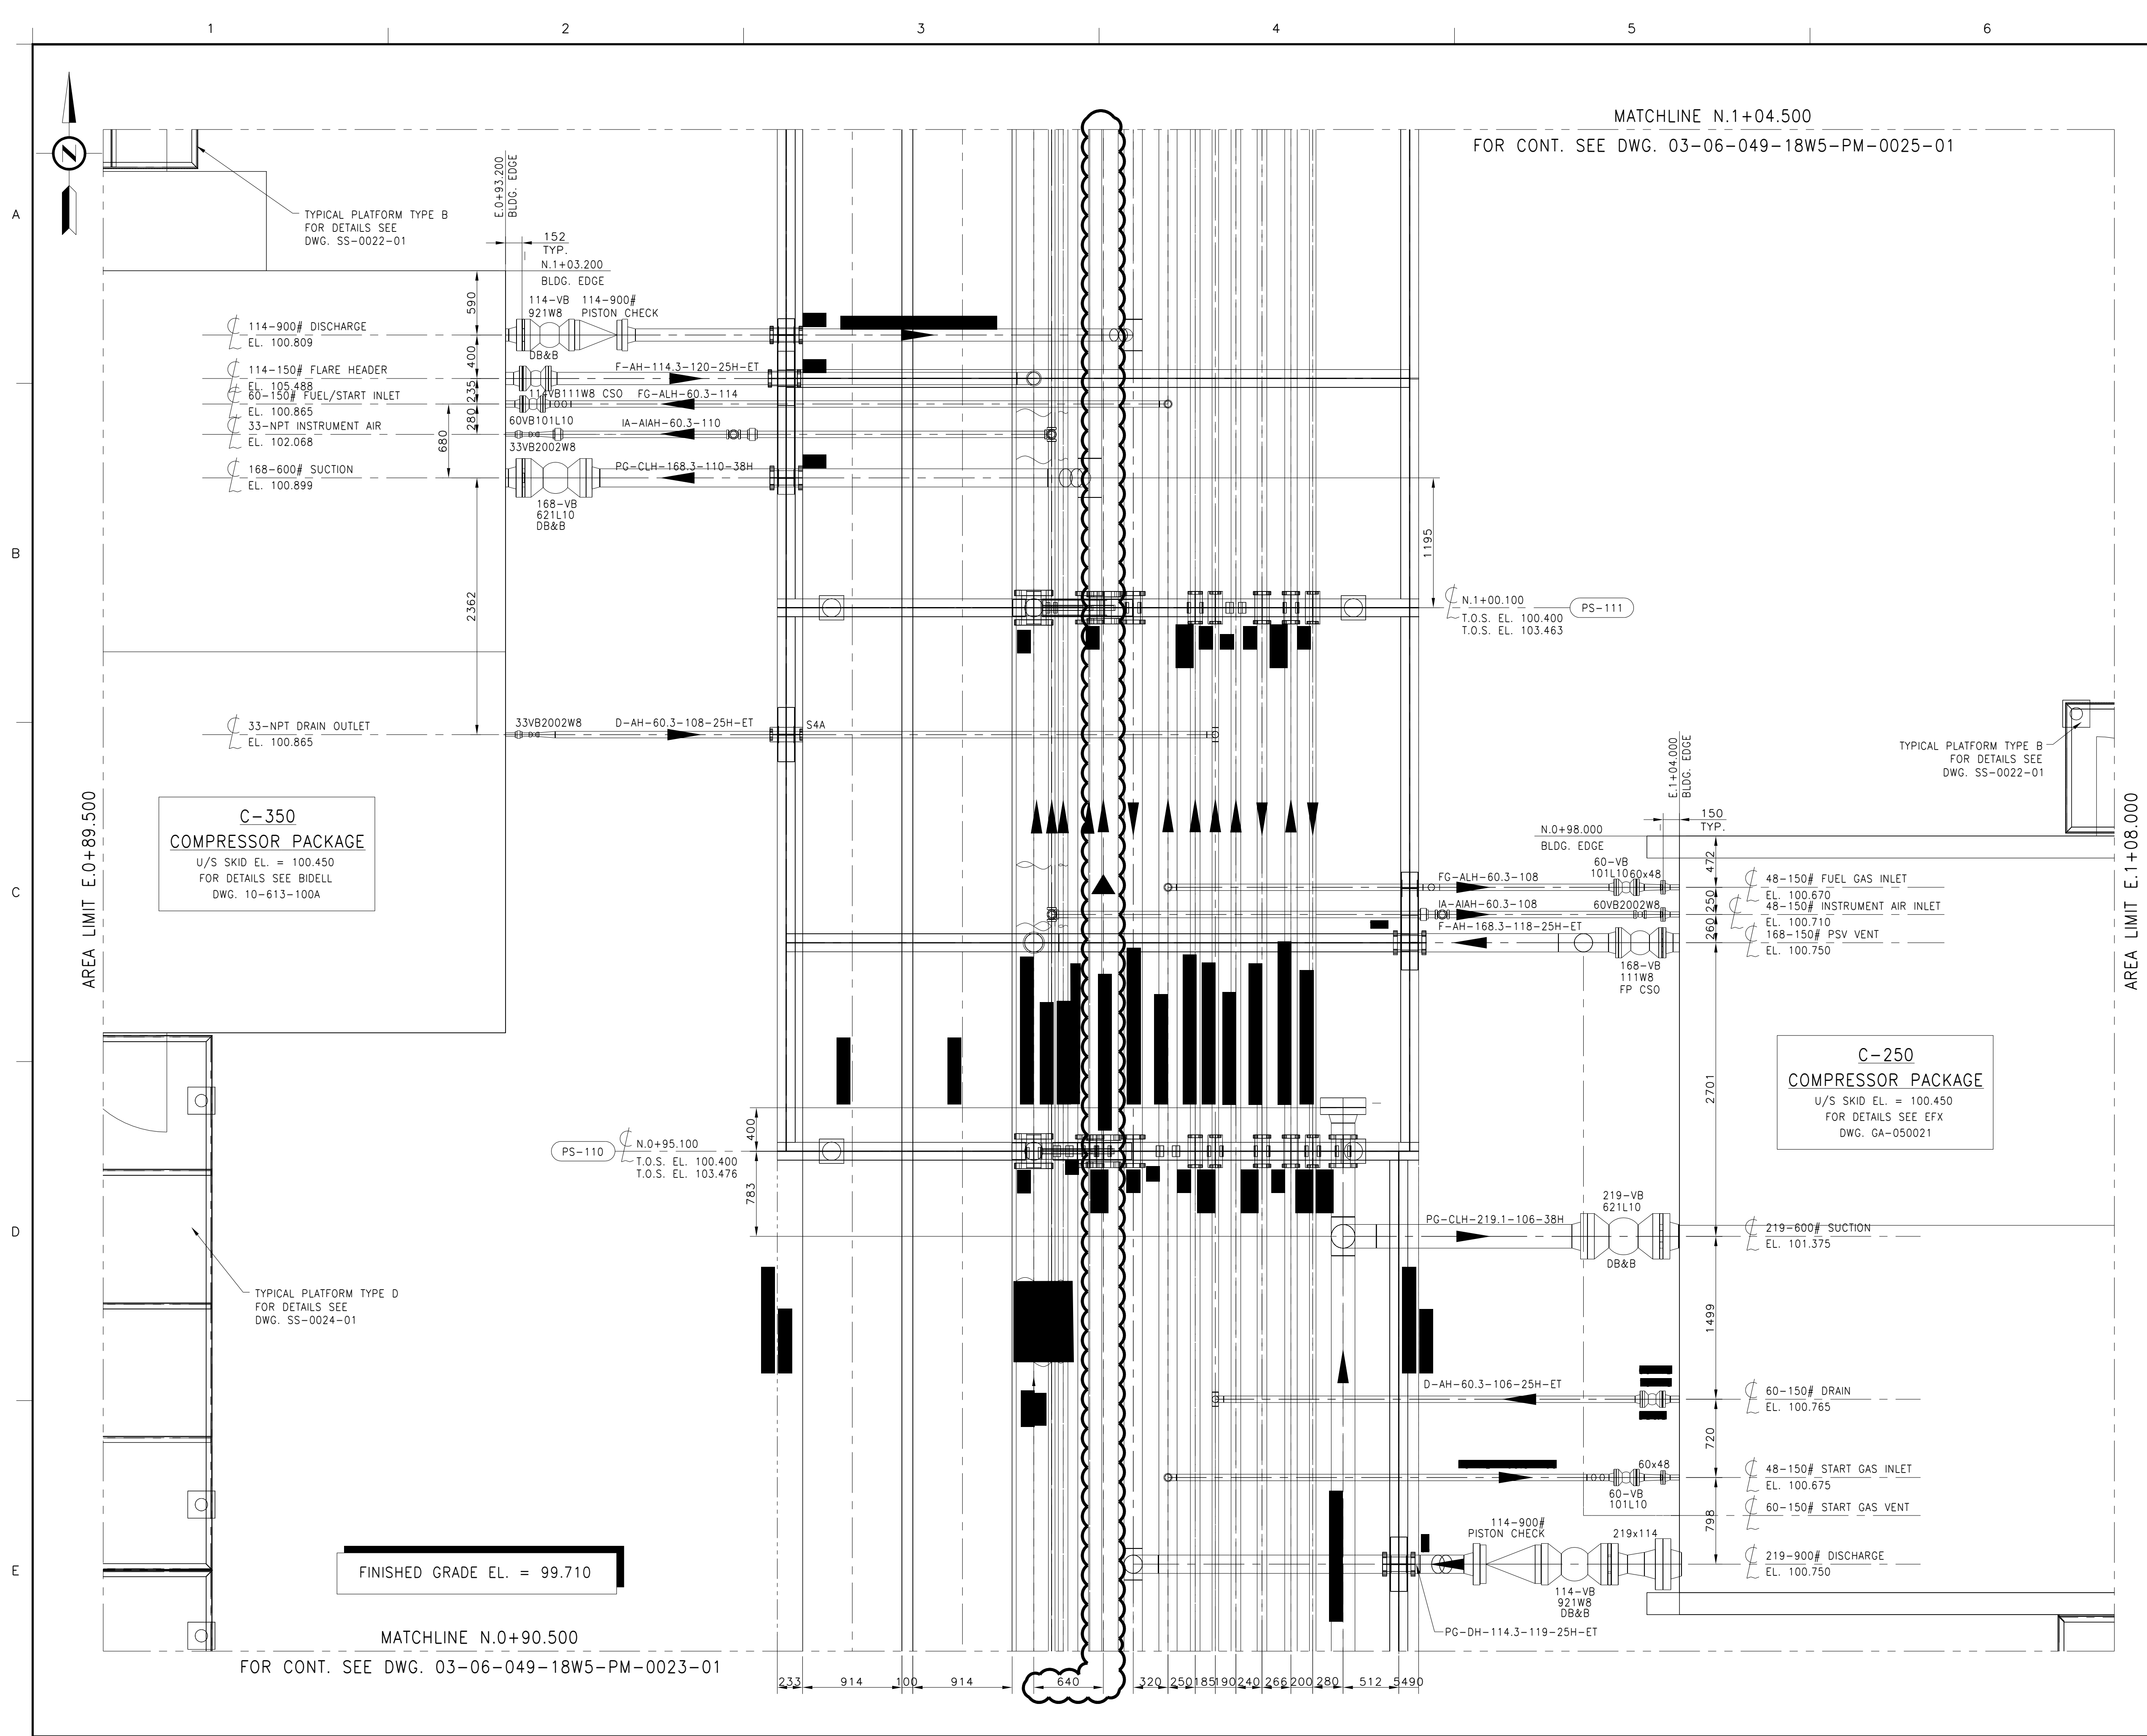

NOTES

- TRACE & OR INSULATE BURIED LINES TO BOTTOM OF TRENCH.
- PIG BARRELS ARE NOT TO BE INSULATED OR HEAT TRACED.
- ALL PROCESS & INSTRUMENT VENTS SHALL BE AT LEAST 500mm FROM ANY ELECTRICAL CONNECTION OR OUTLET.
- ▲DENOTES VENDOR SUPPLIED ITEMS.
- FOR PIPE SHOES AND OTHER LINE SUPPORT DETAILS (eg. S1A/G1) SEE STANDARD DRAWINGS 03-06-049-18W5-XX-0002-01 & 0003-01.
- FOR PIPE SUPPORT DETAILS (eg. PS-100) SEE STRUCTURAL PIPE SUPPORT DRAWING 03-06-049-18W5-SS-0016-01.
- CONTRACTOR TO PROVIDE & LOCATE 27mm VENTS & DRAINS AS REQUIRED FOR HYDROTESTING.
- WHERE SPECIFIED INSULATE ALL PIPING, VALVES & FLANGES WITH SPECIFIED THICKNESS FIBERGLASS W/ALUMINUM CLADDING A/G & POLYURETHANE WITH TAPE U/G.

ENGINEERING COMPANY PERMIT STAMP

REGISTERED PROFESSIONAL ENGINEER STAMP

REF	DRAWING NUMBER	DRAWING TITLE
REFERENCE DRAWINGS		
3	2012/10/04	IFC FOR EWR 15740 EXCELSIOR 3245
2	2011/12/07	AS BUILT FOR EWR 11959 EXCELSIOR 2479
1	2011/04/30	IFC FOR EWR 11959 EXCELSIOR 2479

REV	DATE	DESCRIPTION	BY	CHK	ENG	APR
REVISION HISTORY						

MINEHEAD 03-06-049-18W5 COMPRESSOR STN.

TITLE

C-250 & C-350 COMPRESSOR PACKAGES AREA
PIPING & MECHANICAL

SURFACE LOCATION

03-06-049-18W5

ALTERNATE DWG NUMBER	REV NO
HUSKY DWG NUMBER	3
VENDOR DWG NUMBER	SCALE
AMU/FLOC NUMBER	1:30
DCN NO	PROJECT NO
	EWR 15740

