


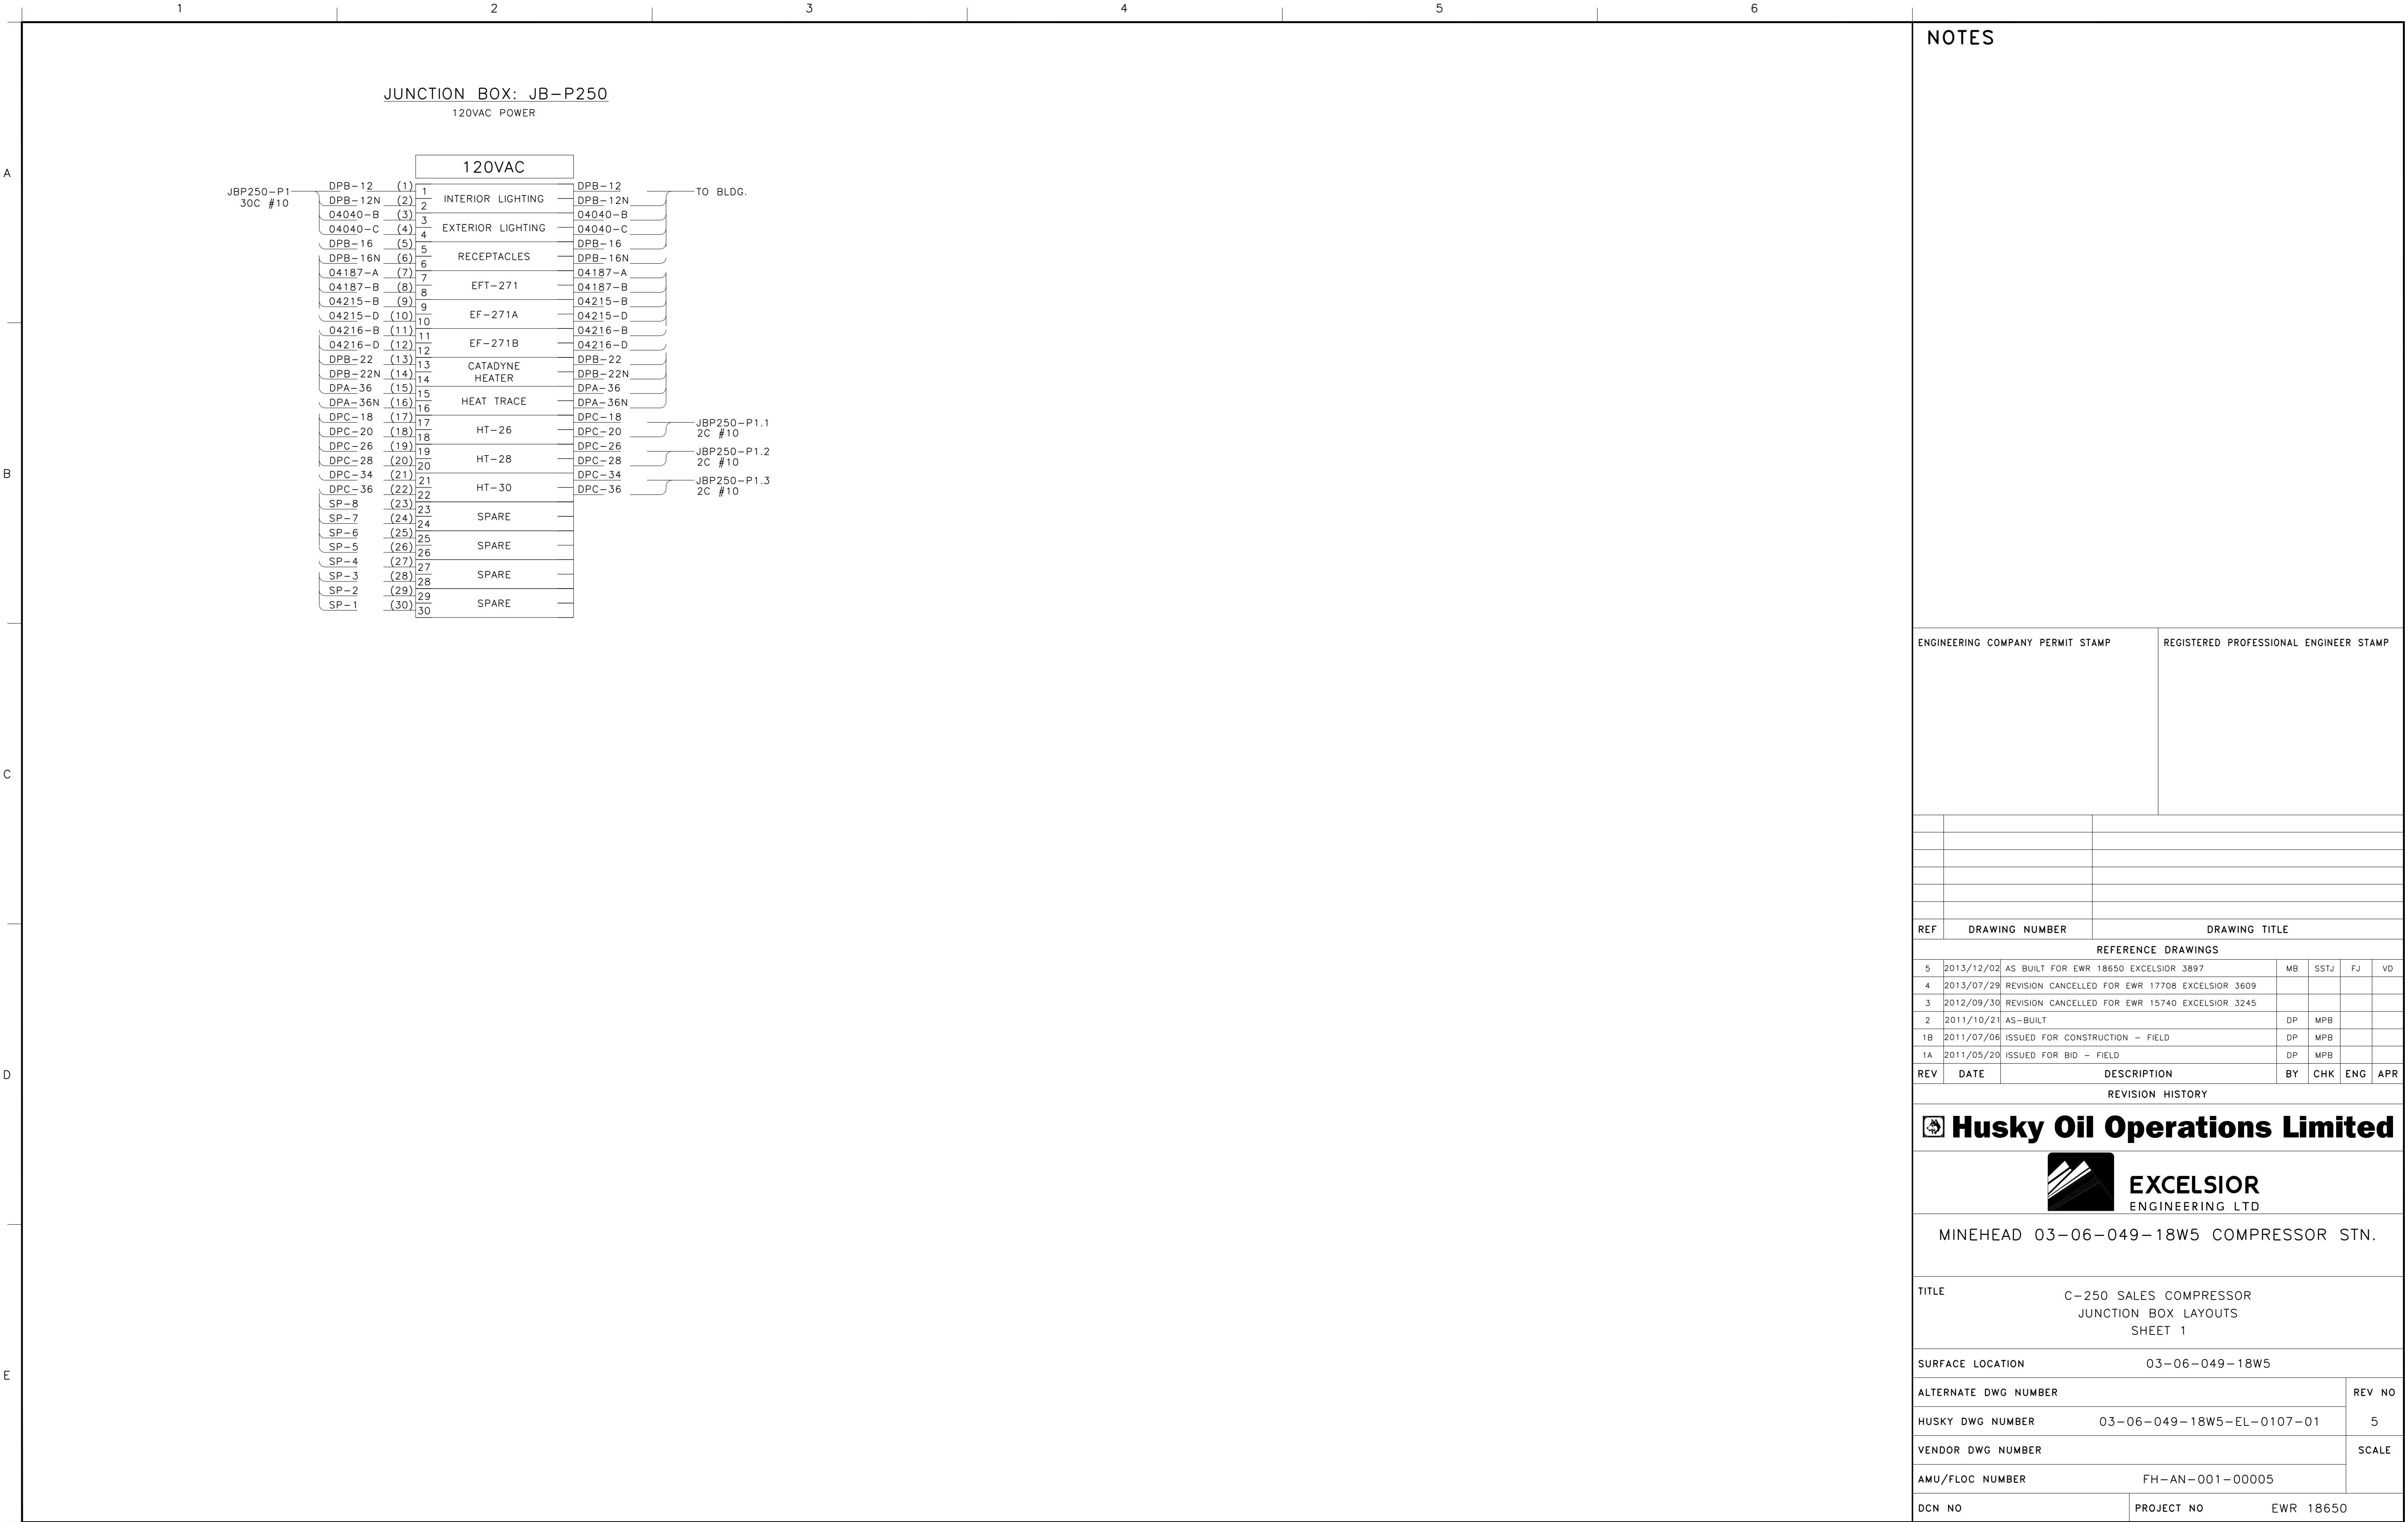


NOTES

ENGINEERING COMPANY PERMIT STAMP

REGISTERED PROFESSIONAL ENGINEER STAMP

REF	DRAWING NUMBER		DRAWING TITLE					
REFERENCE DRAWINGS								
5	2013/12/02	AS BUILT FOR EWR 18650 EXCELSIOR 3897	MB	SSTJ	FJ	VD		
4	2013/07/29	REVISION CANCELLED FOR EWR 17708 EXCELSIOR 3609						
3	2012/09/30	REVISION CANCELLED FOR EWR 15740 EXCELSIOR 3245						
2	2011/10/21	AS-BUILT	DP	MPB				
1B	2011/07/06	ISSUED FOR CONSTRUCTION - FIELD	DP	MPB				
1A	2011/05/20	ISSUED FOR BID - FIELD	DP	MPB				
REV	DATE	DESCRIPTION	BY	CHK	ENG	APR		

 **Husky Oil Operations Limited**

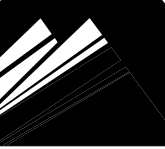 **EXCELSIOR**
ENGINEERING LTD

MINEHEAD 03-06-049-18W5 COMPRESSOR STN.

TITLE

C-250 SALES COMPRESSOR
JUNCTION BOX LAYOUTS
SHEET 1

SURFACE LOCATION

03-06-049-18W5

ALTERNATE DWG NUMBER

HUSKY DWG NUMBER03-06-049-18W5-EL-0107-01

VENDOR DWG NUMBER

AMU/FLOC NUMBERFH-AN-001-00005

DCN NO

PROJECT NOEWR 18650

REV NO

5

SCALE