


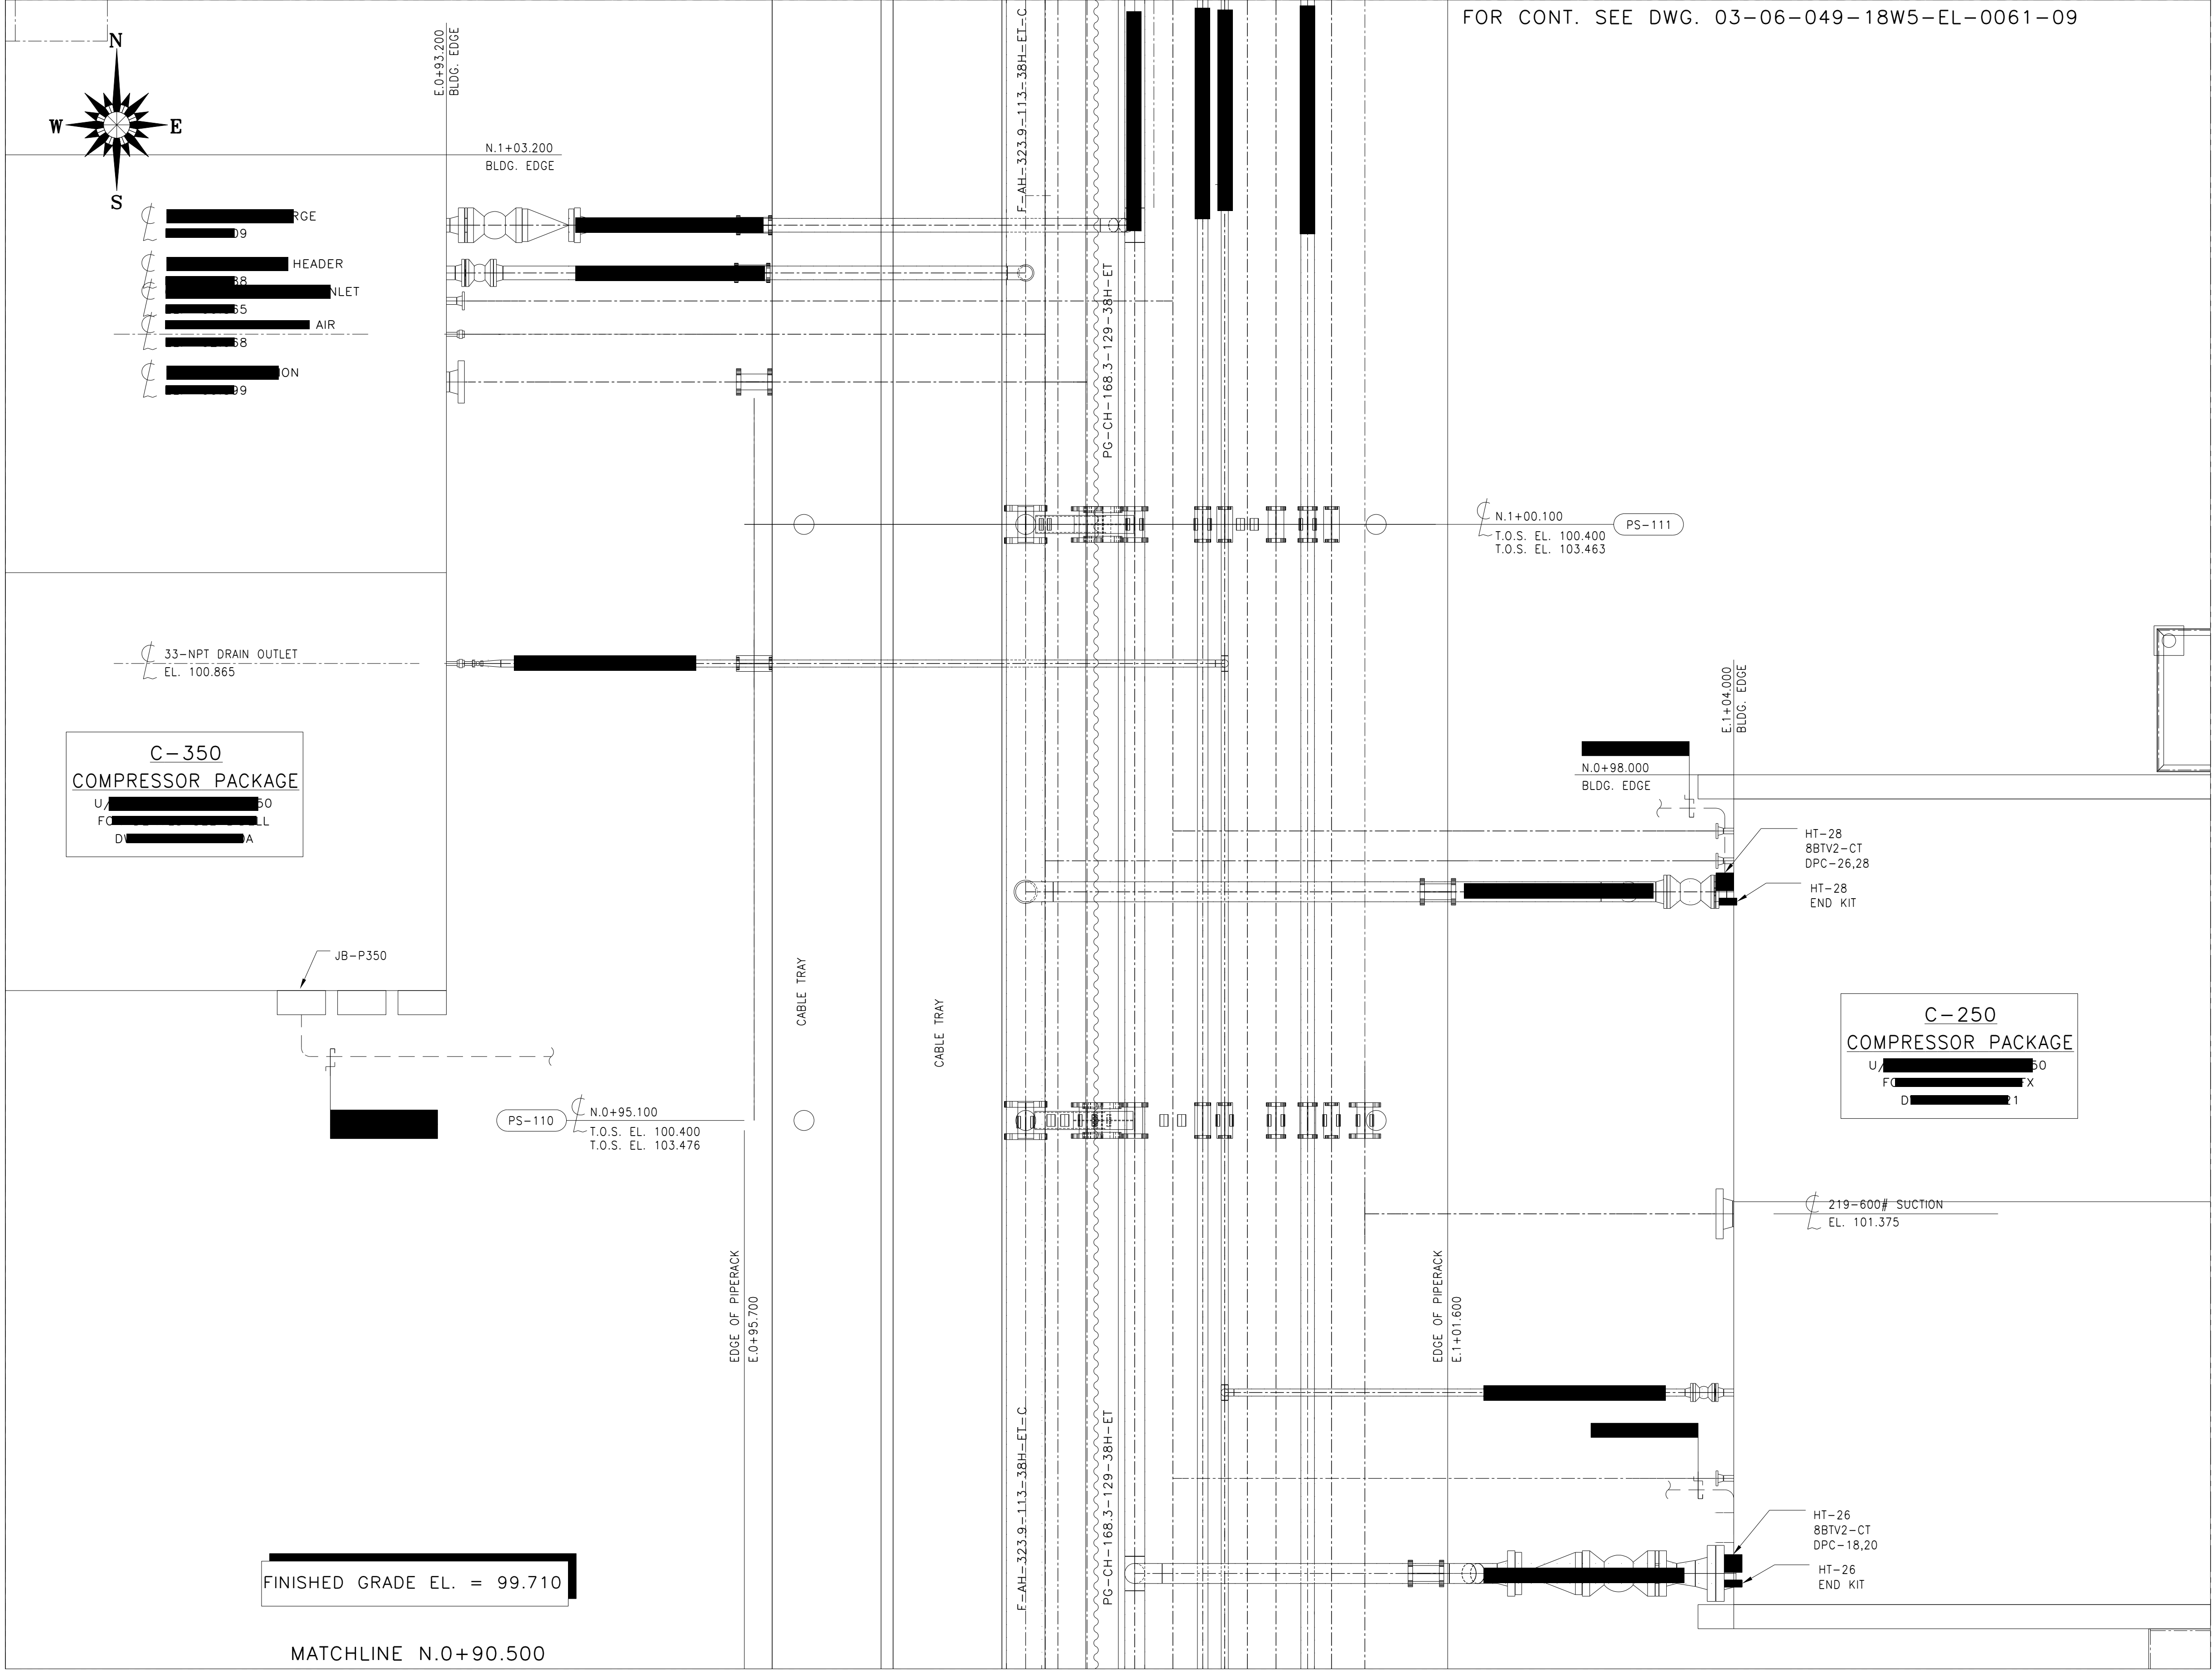

NOTES

ENGINEERING COMPANY PERMIT STAMP REGISTERED PROFESSIONAL ENGINEER STAMP

REF	DRAWING NUMBER		DRAWING TITLE				
REFERENCE DRAWINGS							
5	2013/12/04	AS BUILT FOR EWR 18650 EXCELSIOR 3897	TL	SSTJ	FJ	VD	
4	2013/07/29	REVISION CANCELLED FOR EWR 17708 EXCELSIOR 3609					
3	2012/09/30	IFC FOR EWR 15740 EXCELSIOR 3245	PF	RGS			
2	2011/10/21	AS-BUILT	DP	MPB			
1A	2011/07/06	ISSUED FOR CONSTRUCTION - FIELD	DP	MPB			
REV	DATE	DESCRIPTION	BY	CHK	ENG	APR	
REVISION HISTORY							

Husky Oil Operations Limited



MINEHEAD 03-06-049-18W5 COMPRESSOR STN.

TITLE		C-250 & C-350 COMPRESSOR PACKAGES AREA HEAT TRACE LAYOUTS SHEET 8
SURFACE LOCATION		03-06-049-18W5
ALTERNATE DWG NUMBER		REV NO
HUSKY DWG NUMBER		5
VENDOR DWG NUMBER		SCALE
AMU/FLOC NUMBER		1:30
DCN NO		PROJECT NO EWR 18650

