

NOTES

- BUILDING IS CLASSIFIED AS CLASS 1, ZONE 2.
- CONTROL DEVICES TO BE CONNECTED WITH LT FLEX OR TECK.
- CONDUITS & FITTINGS ARE TO BE RIGID ALUMINUM & SIZED TO CANADIAN ELECTRICAL CODE PART I, MINIMUM SIZE TO BE 3/4".
- ALL JUNCTION BOX ENTRIES TO UTILIZE MYERS HUB.
- LAMACOIDS ARE TO BE SUPPLIED & INSTALLED BY SKID ELECTRICAL CONTRACTOR.
- LIGHTS WILL BE INSTALLED AND TESTED, THEN TAKEN DOWN FOR SHIPMENT. LIGHTS WILL BE PROPERLY SECURED TO EQUIPMENT AND PACKAGED INTO THEIR ORIGINAL CONTAINERS.
- GROUNDING CAN RUN UNDER SKID TO MINIMIZE TRENCHING.
- ELECTRICAL BUILDING CONTRACTOR TO INSTALL JUNCTION BOXES 1380mm FROM UNDERSIDE OF SKID TO TOP OF JUNCTION BOX.
- ELECTRICAL BUILDING CONTRACTOR TO RUN 1/4" SS TUBING FROM LEL SENSOR TO IT'S LEL CONTROLLER FOR CALIBRATION.
- CATADYNE HEATERS ARE POWERED BY 12VDC BATTERY.
- H2S SENSOR IS TO BE INSTALLED 450mm ABOVE FINISHED FLOOR.
- ALL CONDUITS ENTERING THE JUNCTION BOXES ARE TO BE FROM THE BOTTOM.

ENGINEERING COMPANY PERMIT STAMP

REGISTERED PROFESSIONAL ENGINEER STAMP

EF	DRAWING NUMBER		DRAWING TITLE							
REFERENCE DRAWINGS										
	4	2013/12/04	AS BUILT FOR EWR 18650 EXCELSIOR 3897				TL	SSTJ	FJ	VD
	3	2013/07/29	REVISION CANCELLED FOR EWR 17708 EXCELSIOR 3609							
	2	2011/10/21	AS-BUILT				DP	MPB		
	B	2011/07/06	ISSUED FOR CONSTRUCTION - FIELD				DP	MPB		
	A	2011/05/20	ISSUED FOR BID - FIELD				DP	MPB		
EV	DATE		DESCRIPTION				BY	CHK	ENG	APR
REVISION HISTORY										




Husky Oil Operations Limited

EXCELSIOR
ENGINEERING LTD

MINEHEAD 03-06-049-18W5 COMPRESSOR STN.

TITLE C-250 SALES COMPRESSOR BUILDING
ELECTRICAL LAYOUT

SURFACE LOCATION	03-06-049-18W5	REV NO
ALTERNATE DWG NUMBER		4
HUSKY DWG NUMBER	03-06-049-18W5-EL-0050-01	SCALE
VENDOR DWG NUMBER		1:30
AMU/FLOC NUMBER	FH-AN-001-00005	
DCN NO	PROJECT NO	EWR 18650

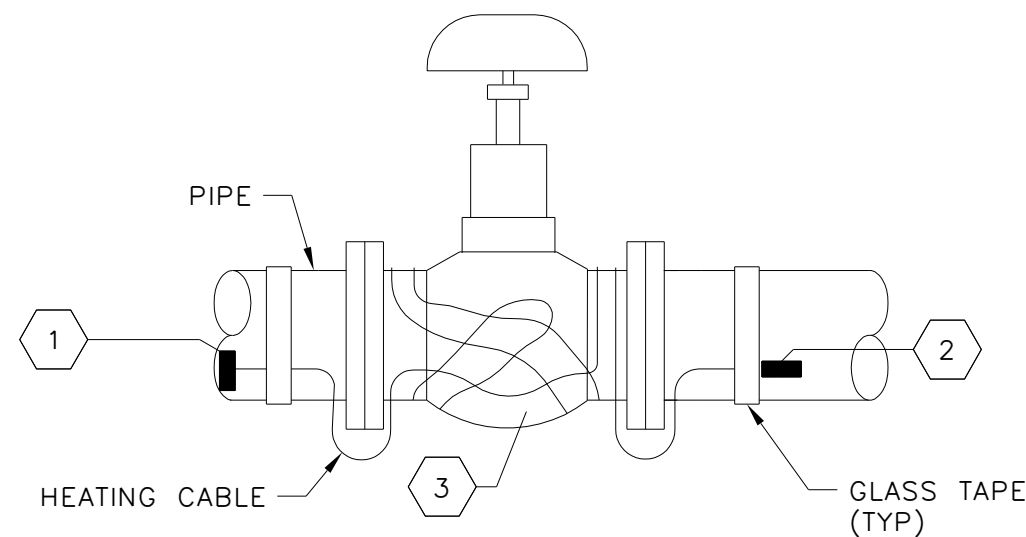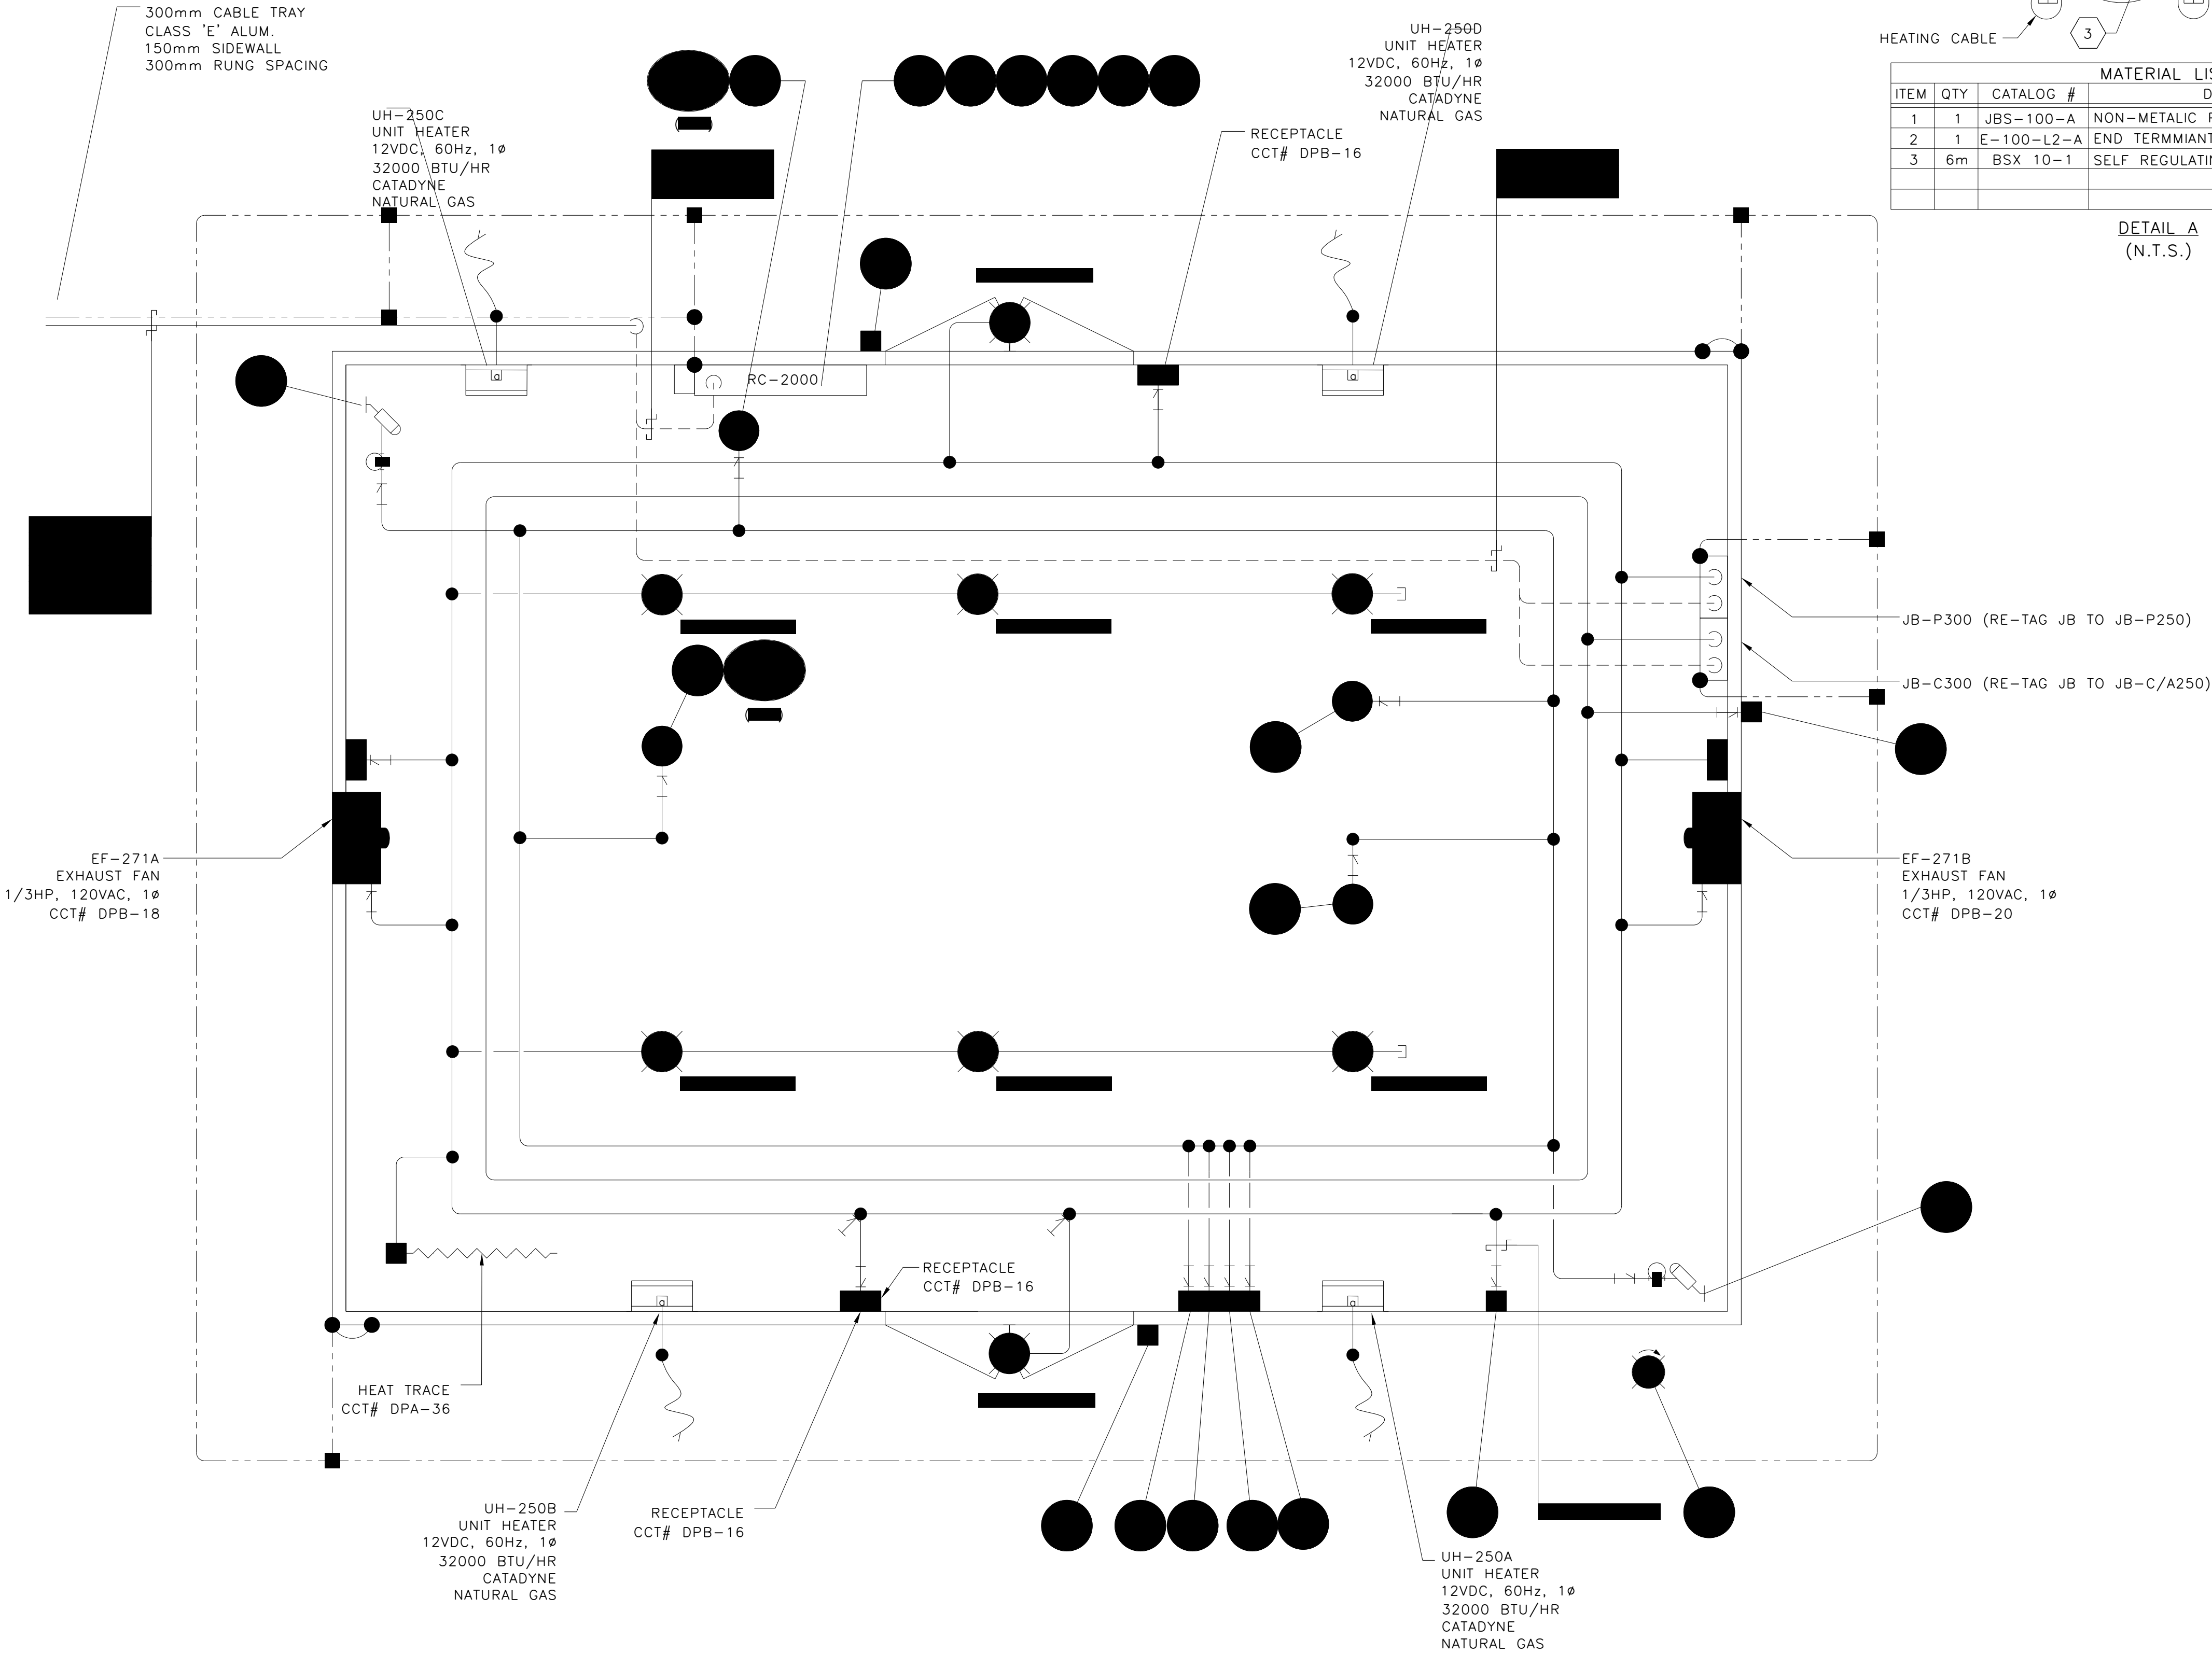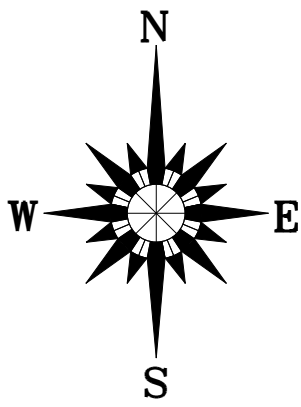

MATERIAL LIST			
ITEM	QTY	CATALOG #	DESCRIPTION
1	1	JBS-100-A	NON-METALIC POWER CONNECTION BOX
2	1	E-100-L2-A	END TERMMIANTION KIT C/W LIGHT
3	6m	BSX 10-1	SELF REGULATING HEATING CABLE

DETAIL A
(N.T.S.)

NOTES

- BUILDING IS CLASSIFIED AS CLASS 1, ZONE 2.
- CONTROL DEVICES TO BE CONNECTED WITH LT FLEX OR TECK.
- CONDUITS & FITTINGS ARE TO BE RIGID ALUMINUM & SIZED TO CANADIAN ELECTRICAL CODE PART I. MINIMUM SIZE TO BE 3/4".
- ALL JUNCTION BOX ENTRIES TO UTILIZE MYERS HUB.
- LAMACOIDS ARE TO BE SUPPLIED & INSTALLED BY SKID ELECTRICAL CONTRACTOR.
- LIGHTS WILL BE INSTALLED AND TESTED, THEN TAKEN DOWN FOR SHIPMENT. LIGHTS WILL BE PROPERLY SECURED TO EQUIPMENT AND PACKAGED INTO THEIR ORIGINAL CONTAINERS.
- GROUNDING CAN RUN UNDER SKID TO MINIMIZE TRENCHING.
- ELECTRICAL BUILDING CONTRACTOR TO INSTALL JUNCTION BOXES 1380mm FROM UNDERSIDE OF SKID TO TOP OF JUNCTION BOX.
- ELECTRICAL BUILDING CONTRACTOR TO RUN 1/4" SS TUBING FROM LEL SENSOR TO IT'S LEL CONTROLLER FOR CALIBRATION.
- CATADYNE HEATERS ARE POWERED BY 12VDC BATTERY
- H2S SENSOR IS TO BE INSTALLED 450mm ABOVE FINISHED FLOOR
- ALL CONDUITS ENTERING THE JUNCTION BOXES ARE TO BE FROM THE BOTTOM

ENGINEERING COMPANY PERMIT STAMP

REGISTERED PROFESSIONAL ENGINEER STAMP

REF

DRAWING NUMBER

DRAWING TITLE

REFERENCE DRAWINGS

4	2013/12/04	AS BUILT FOR EWR 18650 EXCELSIOR 3897	TL	SSTJ	FJ	VD	
3	2013/07/29	REVISION CANCELLED FOR EWR 17708 EXCELSIOR 3609					
2	2011/10/21	AS-BUILT	DP	MPB			
1B	2011/07/06	ISSUED FOR CONSTRUCTION - FIELD	DP	MPB			
1A	2011/05/20	ISSUED FOR BID - FIELD	DP	MPB			

REV

DATE

DESCRIPTION

BY

CHK


ENG

APR

REVISION HISTORY



Husky Oil Operations Limited

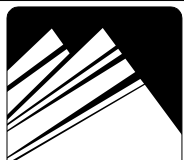

EXCELSIOR
ENGINEERING LTD

MINEHEAD 03-06-049-18W5 COMPRESSOR STN.

TITLE

C-250 SALES COMPRESSOR BUILDING
ELECTRICAL LAYOUT

SURFACE LOCATION

03-06-049-18W5

ALTERNATE DWG NUMBER

REV NO

HUSKY DWG NUMBER

03-06-049-18W5-EL-0050-01

4

VENDOR DWG NUMBER

SCALE

AMU/FLOC NUMBER

FH-AN-001-00005

1:30

DCN NO

PROJECT NO

EWR 18650