


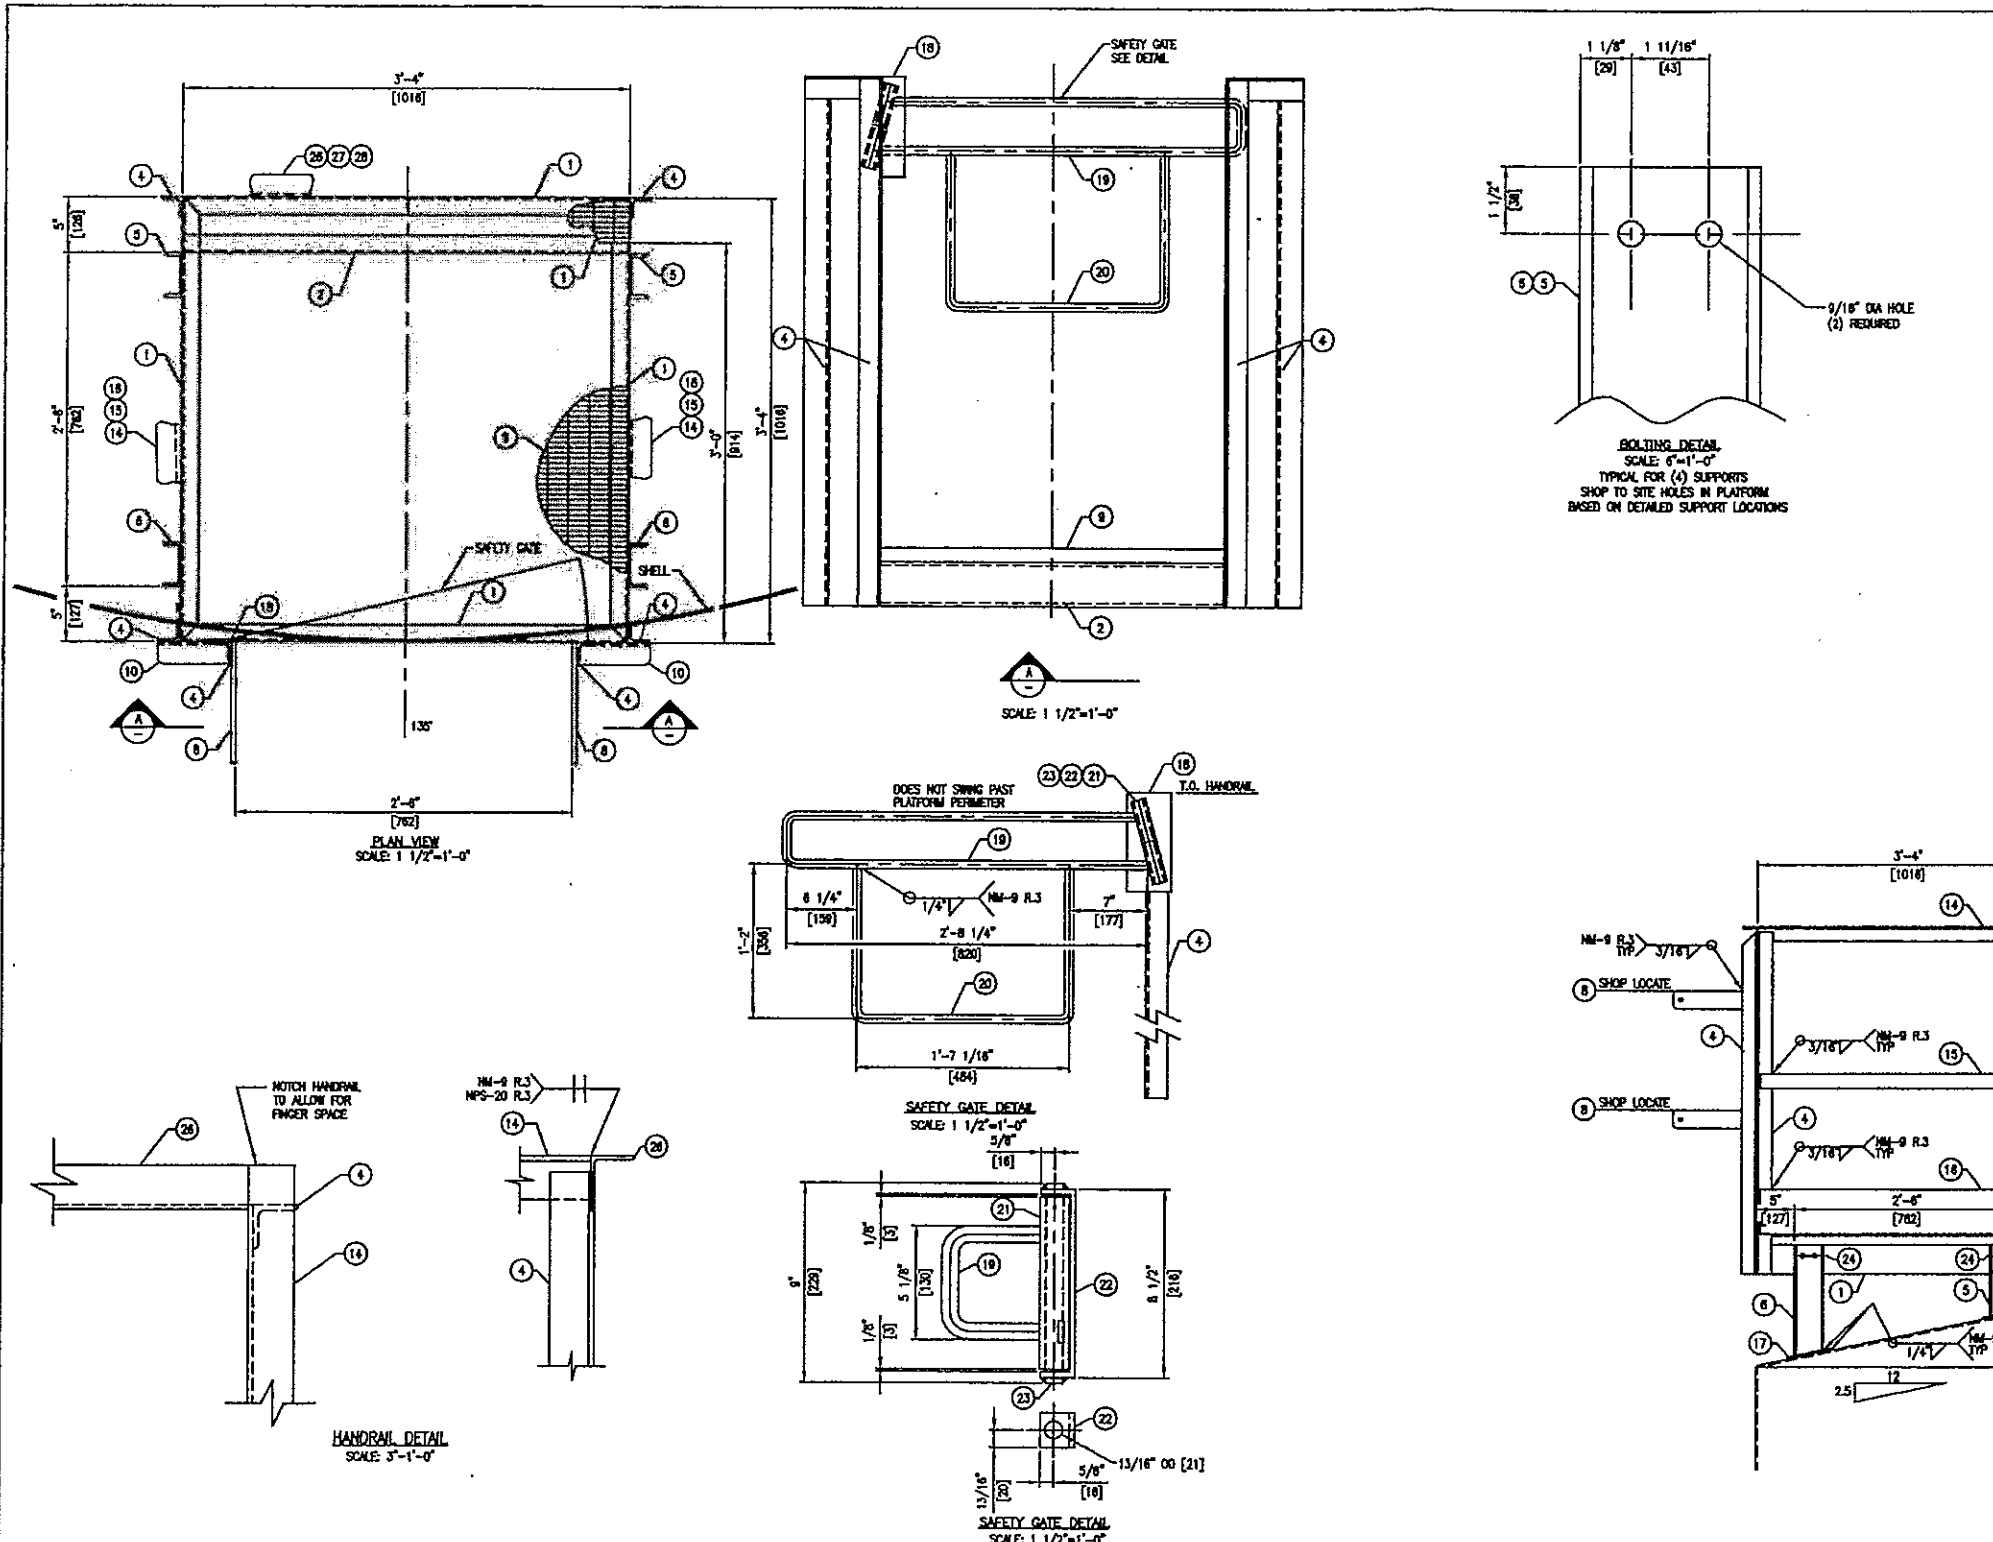


MATERIAL LIST						
ITEM	QTY	PART	DESCRIPTION	MATERIAL	UNIT WEIGHT	TOTAL WEIGHT
1	4	FRAME	C4 x 5.4 x 3'-4" LG (MSE)	G40.21-44W	18 LBS	72 LBS
2	1	SUPPORT	C4 x 5.4 x 3'-3 5/8" LG	G40.21-44W	18 LBS	18 LBS
3						
4	8	POST	2" x 2" x 1/4" ANGLE x 3'-10 1/2" LG (MSE)	G40.21-44W	12 LBS	96 LBS
5	2	SUPPORT	C4 x 5.4 x 3 5/8" LG	G40.21-44W	5 LBS	10 LBS
6	2	SUPPORT	C4 x 5.4 x 1'-3 1/8" LG	G40.21-44W	7 LBS	14 LBS
7						
8	4	LADDER CLIP	STD. LADDER CLIP (DWG. CLIP-A)	A-36	3 LBS	12 LBS
9	1	GRATING	DB-GRATING (19-4) 1" x 3/16" B. BAR-3'-0" WIDE x 3'-4" LG	SEPARATED GALVANIZED	67 LBS	67 LBS
10	2	HANDRAIL	2" x 2" x 3/16" ANGLE x 6 5/8" LG (MSE) (COPE TO FIT)	G40.21-44W	1 LBS	2 LBS
11	1	GRATING	DB-GRATING (19-4) 1" x 3/16" B. BAR-4" WIDE x 3'-4" LG	SEPARATED GALVANIZED	7 LBS	7 LBS
12						
13						
14	2	HANDRAIL	2" x 2" x 3/16" ANGLE x 3'-7 5/8" LG (MSE)	G40.21-44W	8 LBS	16 LBS
15	2	MD RAIL	2" x 3/16" F.B. x 3'-2" LG	A-36	4 LBS	8 LBS
16	2	KICK PLATE	6" x 3/16" F.B. x 3'-2" LG	A-36	12 LBS	24 LBS
17	4	REPHD	6" OD x 1/4" THK. REPHD	G40.21-280W	2 LBS	8 LBS
18	1	GATE CLIP	4" x 1/4" x 8" LG SHOP SUIT TO FIT	A-36	3 LBS	3 LBS
19	1	GATE	3/4" DIA ROD x 5'-9" LG (BEND TO SUIT)	A-36	9 LBS	9 LBS
20	1	GATE	3/4" DIA ROD x 3'-11" LG (BEND TO SUIT)	A-36	6 LBS	6 LBS
21	1	PIPE	1" SCH 160 PIPE x 7 3/4" LG	A-106 Gr.B	2 LBS	2 LBS
22	1	BRACKET	1 9/16" x 1/4" PL x 11 5/8" LG	A-36	1 LBS	1 LBS
23	1	FIN	3/4" DIA ROD x 9" LG	A-36	1 LBS	1 LBS
24	12	BOLTING	1/2" x 1 1/2" LG UNC HEX CAPSCREW c/w (1) NUT EA.	PLATED	0.15 LBS	2 LBS
25	6	CLIP	TYPE "D" GRATING CLIP ASSEMBLY (SHOP LOCATE)			
26	1	HANDRAIL	2" x 2" x 3/16" ANGLE x 3'-3 5/8" LG (MSE)	G40.21-44W	10 LBS	10 LBS
27	1	MD RAIL	2" x 3/16" F.B. x 3'-6" LG	A-36	7 LBS	7 LBS
28	1	KICK PLATE	6" x 3/16" F.B. x 3'-6" LG	A-36	14 LBS	14 LBS

NOTES:

1 ESTIMATED WEIGHT: 351 Lbs.

2 ALL BURRS AND SHARP EDGES SHALL BE REMOVED.

3 USE WELD PROCEDURE NM-9 R.J. NPS-20 R.J. FOR ALL ATTACHMENTS WELDS UNLESS OTHERWISE NOTED

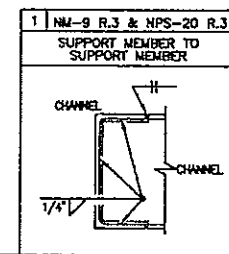

THIS DRAWING IS THE PROPERTY OF ALTUS ENERGY SERVICES PARTNERSHIP, AND IS LOANED TO THE RECIPIENT FOR THEIR CONFIDENTIAL USE ONLY. IN CONSIDERATION OF THE LOAN OF THIS DRAWING, THE RECIPIENT AGREES THAT IT SHALL NOT BE USED IN ANY WAY DETRIMENTAL TO THE INTERESTS OF ALTUS ENERGY SERVICES PARTNERSHIP, THAT IT SHALL BE RETURNED UPON REQUEST AND THAT IT SHALL NOT BE REPRODUCED, COPIED, LENT OR OTHERWISE DISPOSED OF DIRECTLY OR INDIRECTLY WITHOUT THE WRITTEN PERMISSION OF ALTUS ENERGY SERVICES PARTNERSHIP.

REV.	DATE	DRWN	CHECKED	ENG.	APPROVED	DESCRIPTION
1	25-Apr-11	DT				AS-BUILT
0	26-Jan-11	DT				ISSUED FOR CONSTRUCTION

ALTUS ENERGY SERVICES PARTNERSHIP			
CUSTOMER: HUSKY ENERGY c/o EXCELSIOR ENGINEERING LTD.		TAG: T-650	
TITLE: 2500 BBL CONDENSATE STORAGE TANK 40" WIDE x 40" LG ROOF PLATFORM		CUSTOMER P.O. NO.: 8400245730	
LOCATION: LSD: 03-06-049-18 WSM		TENDER NO.: T0235-10-12-001-r0	
SCALE: AS SHOWN		DRAWING NO.: 4101072-001-32-601	
DATE: 28-JAN-11		REV. 1	

AS BUILT