
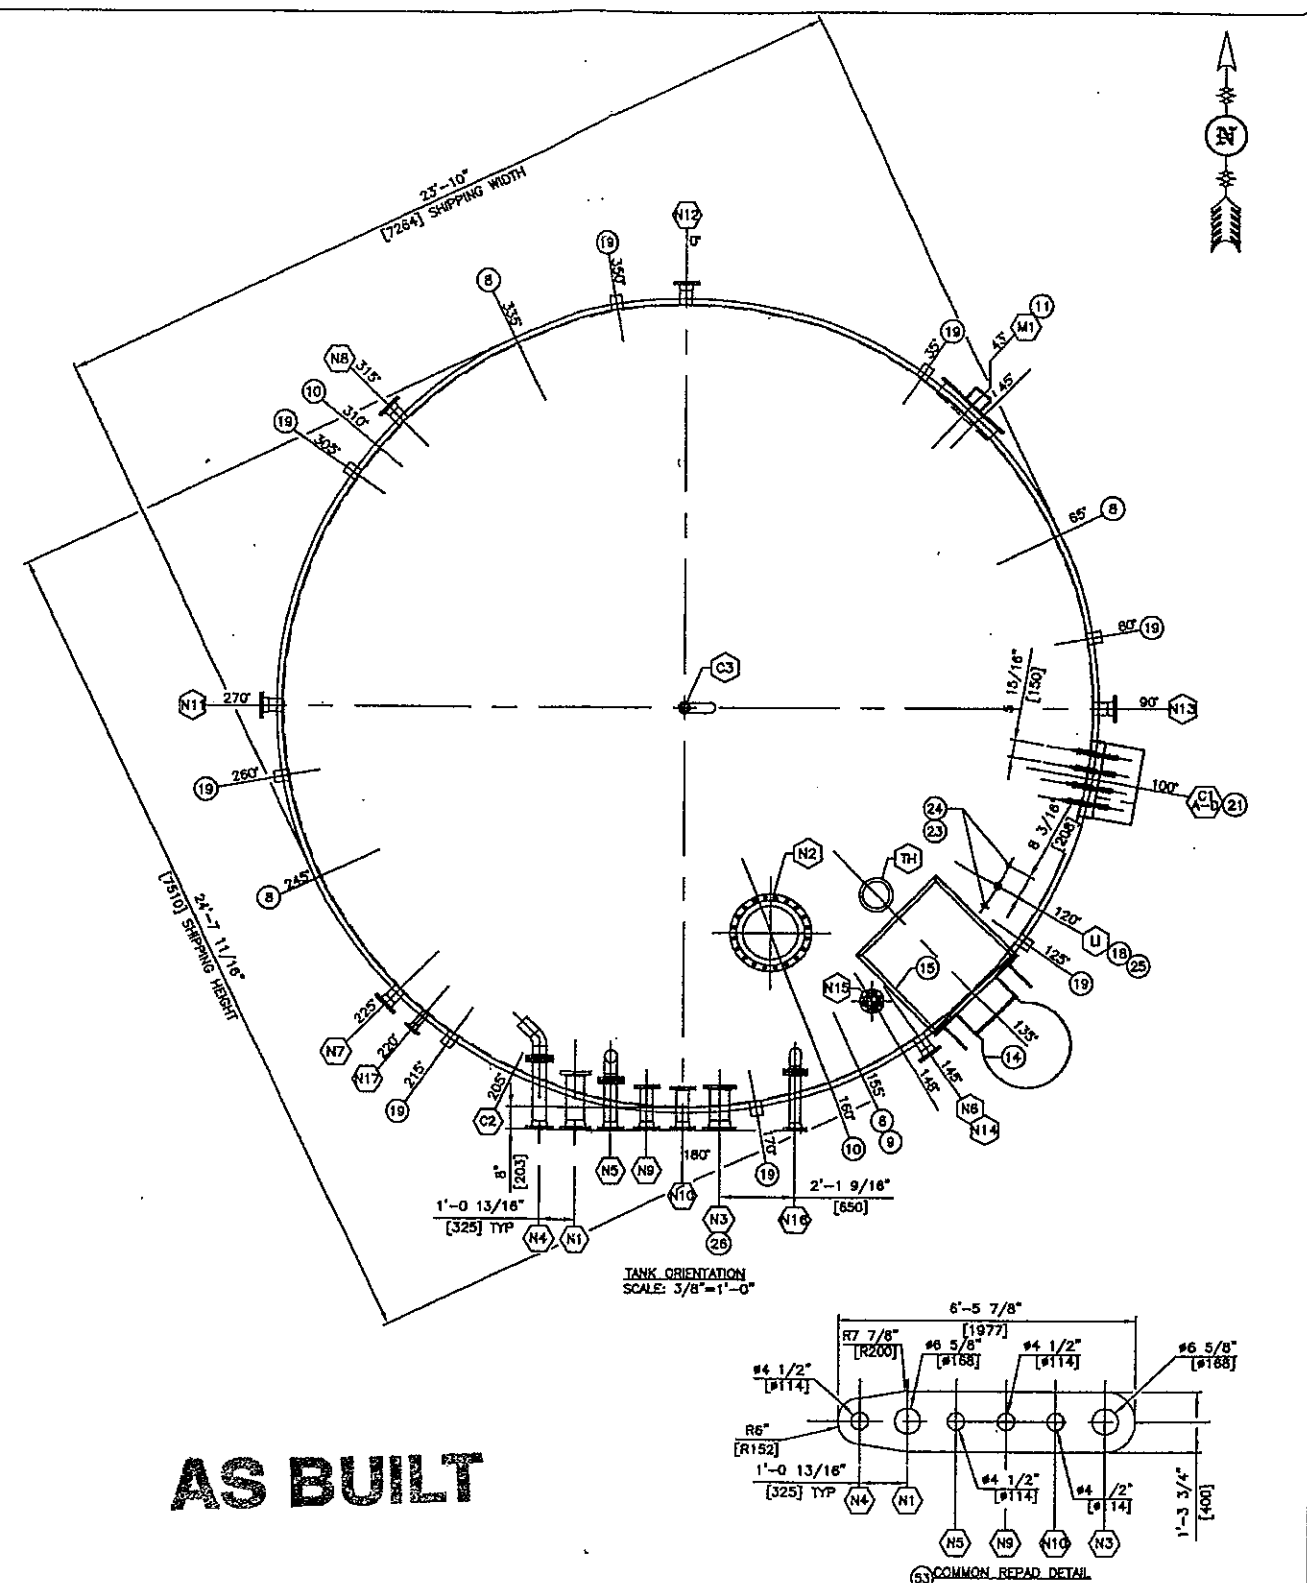


9	NM-9 R3 NOZZLE THRU ROOF & REPAD
8	NM-9 R3 NOZZLE THRU ROOF OR SHELL
7	NM-9 R3 WELD NECK FLANGES/FITTINGS TO PIPE WELDS
6	NM-9 R3 SLIP-ON FLANGES TO PIPE WELDS

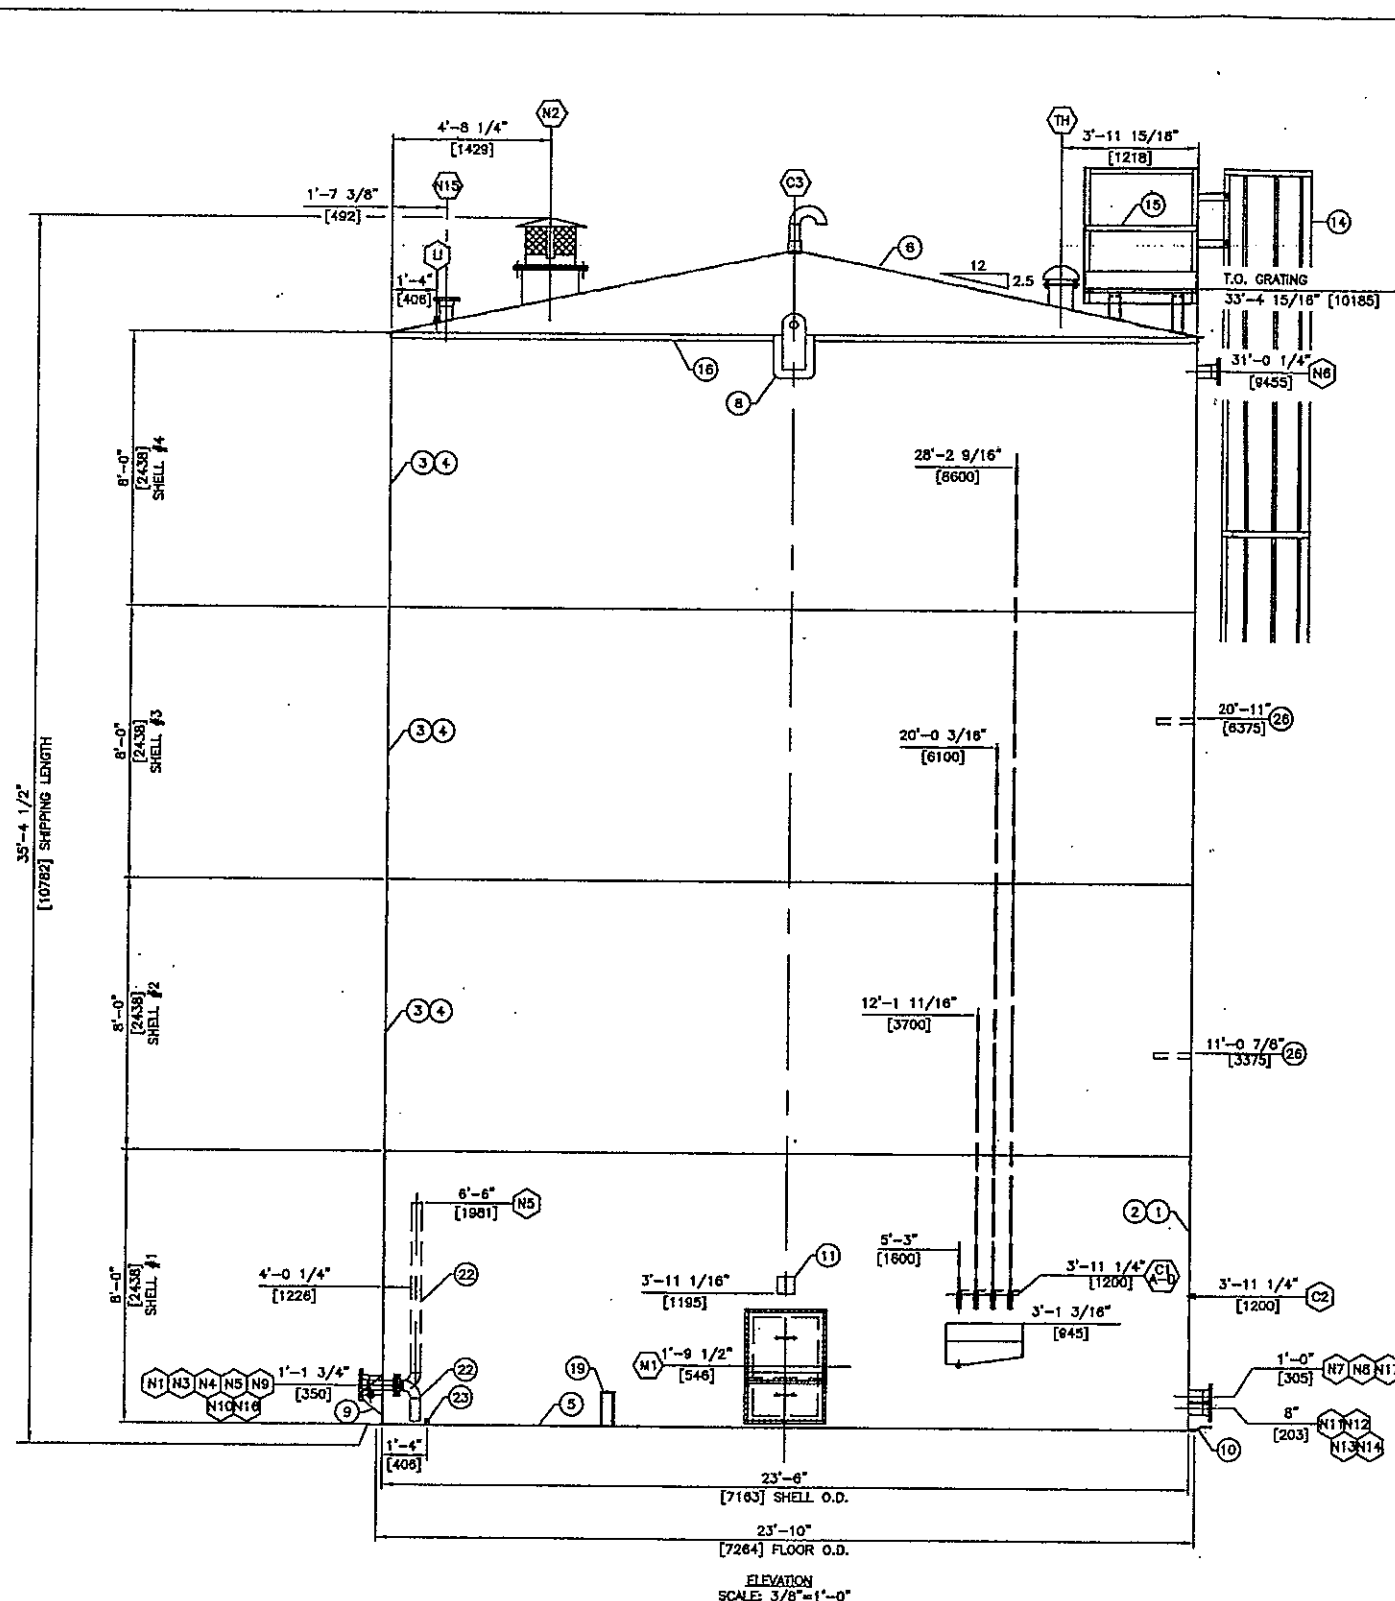

AS BUILT

[illegible]