



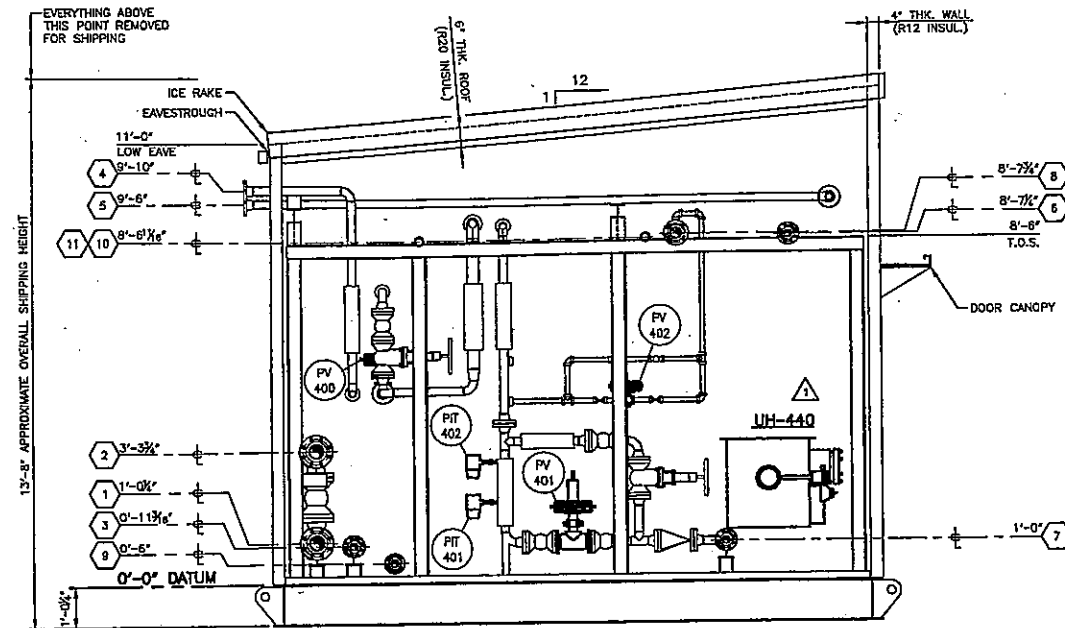

SECTION "A-A"
SCALE: 1/8"=1'-0"

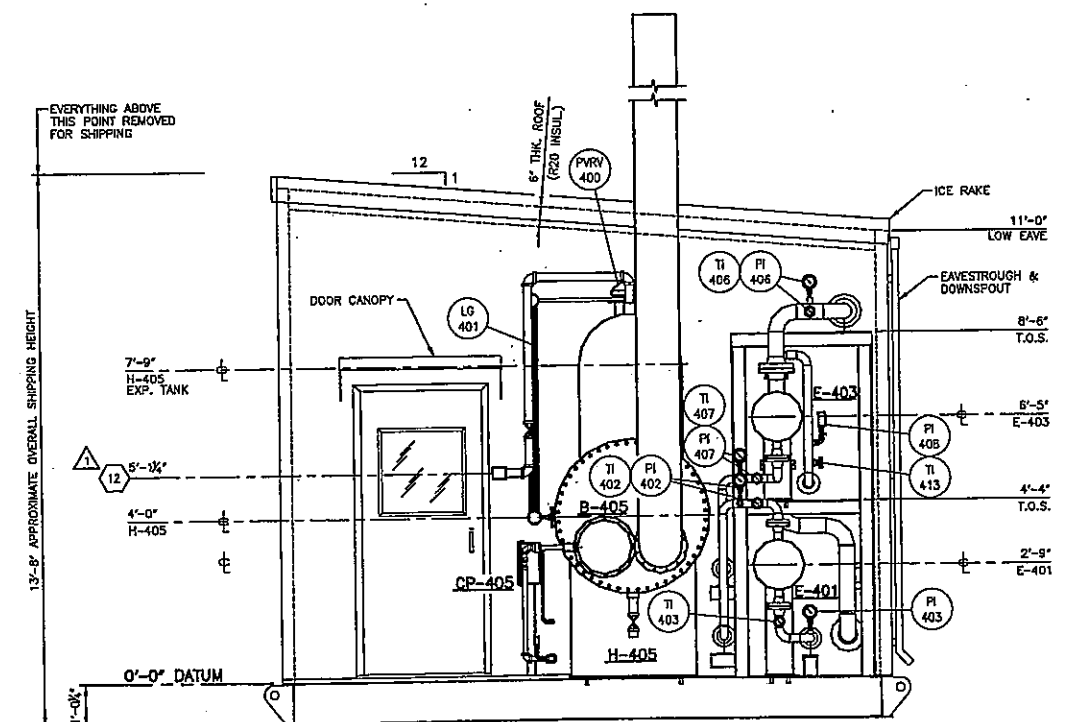

SECTION "C-C"
SCALE: 1/8"=1'-0"

GENERAL NOTES:


- SEE DRAWING D-2011-8169-50A-001 FOR GENERAL NOTES.

PIPING SPEC. SCHEDULE:

- SEE DRAWING D-2011-8169-50A-001 FOR PIPING SPEC. SCHEDULE.

TIE-IN SCHEDULE:

- SEE DRAWING D-2011-8169-50A-001 FOR TIE-IN SCHEDULE.

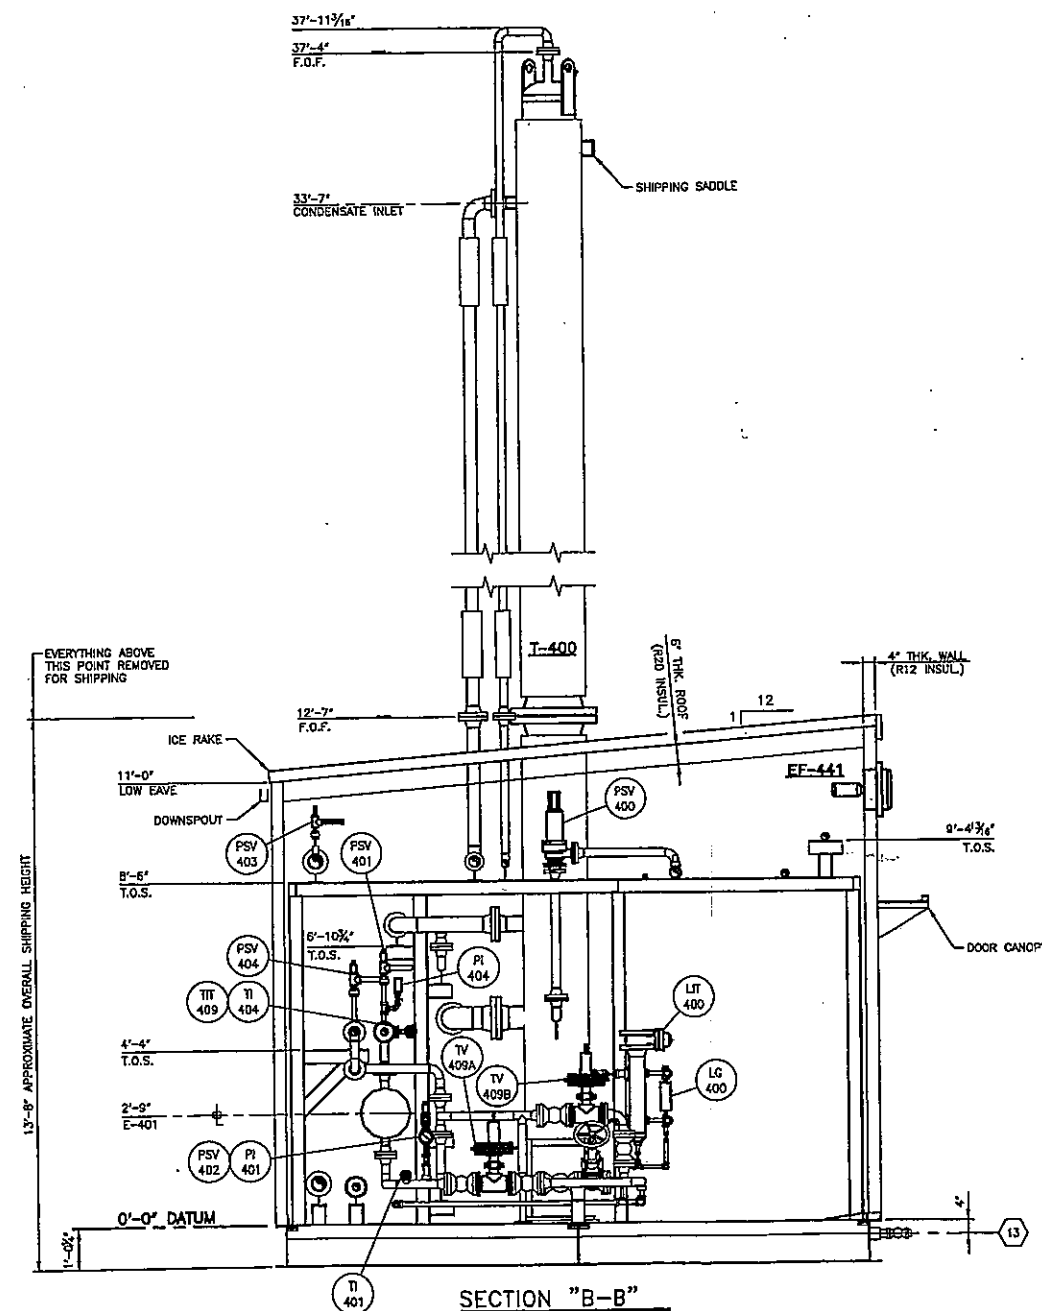

SECTION "B-B"
SCALE: 1/8"=1'-0"

REFERENCE DRAWINGS				REVISIONS			
DWG.	DESCRIPTION	REV.	DATE	REV.	DATE	DESCRIPTION	
B-2011-8169-500	BILL OF MATERIALS	1	2011-02-04			AS BUILT	
D-2011-8169-50A-004	CONDENSATE STABILIZER UNIT - SECTIONS	1	2011-02-04			ISSUED FOR CONSTRUCTION	
D-2011-8169-50A-002	CONDENSATE STABILIZER UNIT - PLAN	0	2011-02-04			REVISED PER CUSTOMER COMMENTS	
D-2011-8169-50A-001	CONDENSATE STABILIZER UNIT - ISOMETRIC	B	2011-02-04			ISSUED FOR CUSTOMER APPROVAL	
D-2011-8169-50F-001	MECHANICAL FLANGES	A	2011-02-04				
DWG.				REV. DATE			
DESCRIPTION				REV. DATE			
REFERENCE DRAWINGS				REVISIONS			

ONE (1) UNIT REQUIRED

ALCO GAS & OIL
PRODUCTION EQUIPMENT LTD.

SECTION VIEWS
CONDENSATE STABILIZER UNIT
TAG #: T-400

LOCATION: MINEHEAD COMPRESSOR STATION L.S.D.: 03-06-049-16 WSM

CUSTOMER: HUSKY OIL OPERATIONS LIMITED % EXCELSIOR ENGINEERING LTD.

DWG/SHOP ORDER: D-2011-8169-50A-003/004 REV. 1