


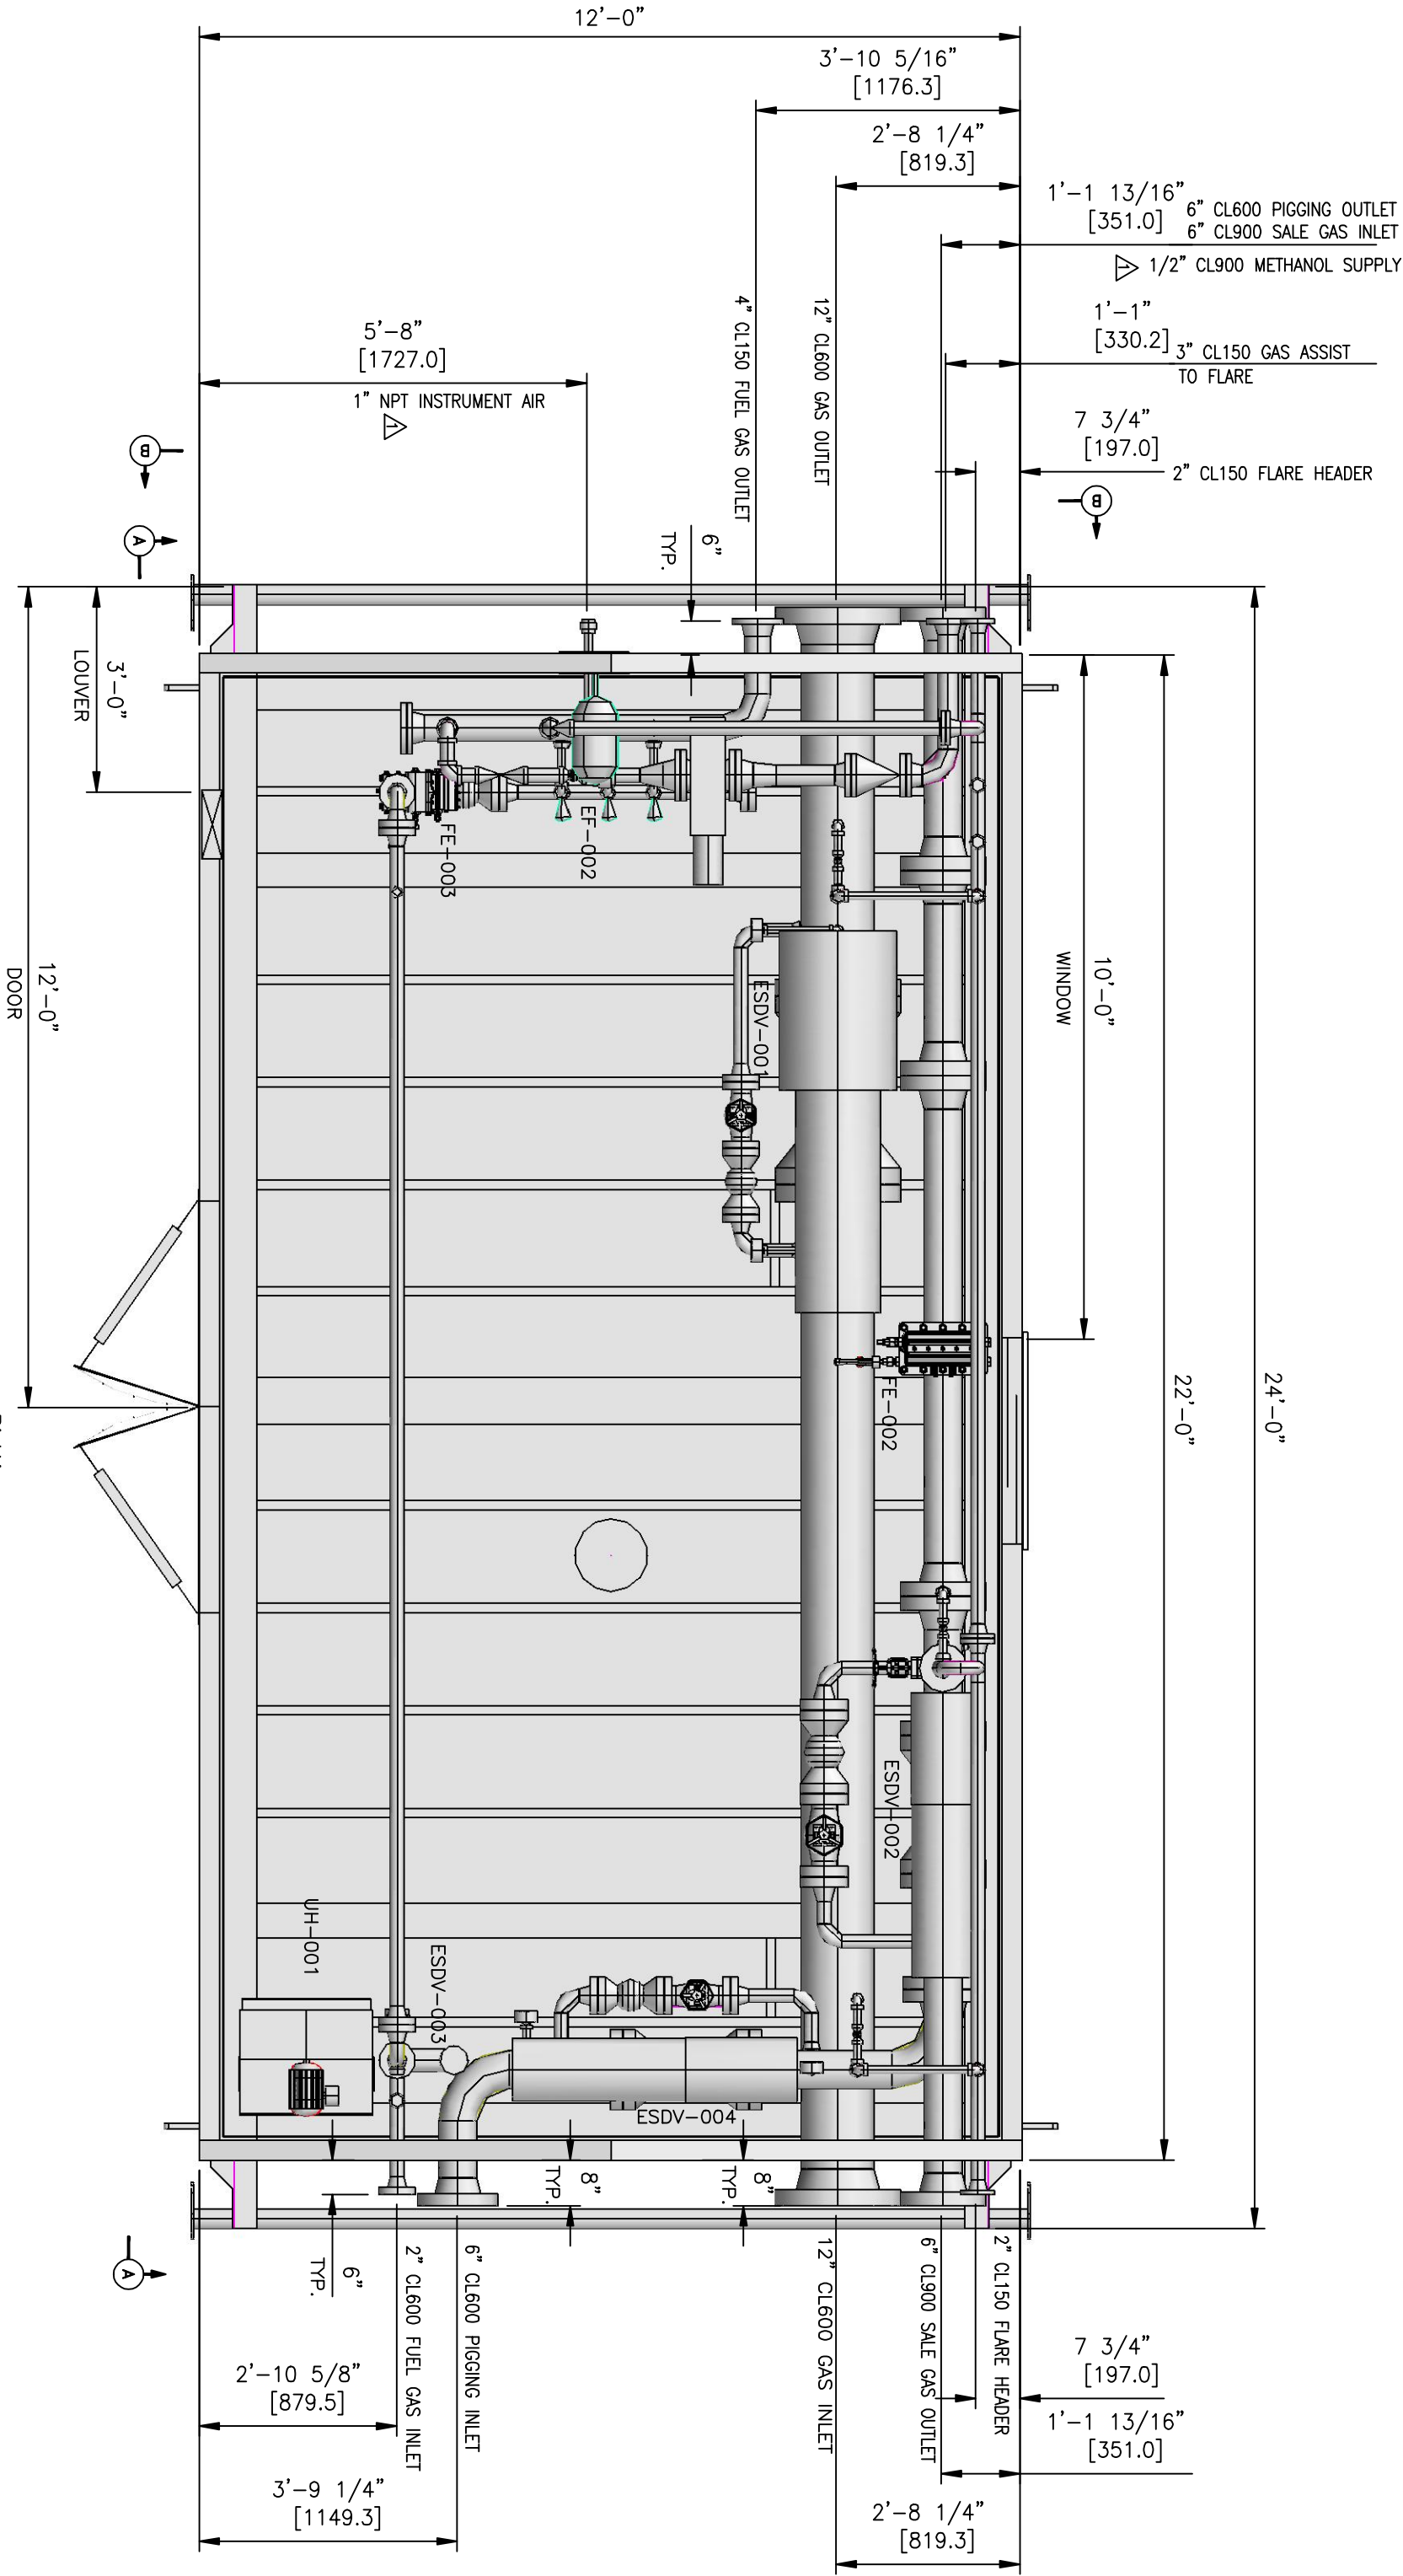

PLAN
SCALE -

NO.		DATE	REVISIONS	CHK'D	APP.	DESIGNED BY		DATE	CLIENT	
3	11-05-30	AS BUILT		KG		DESIGNED BY		11-02-24	HUSKY OIL OPERATIONS LIMITED	
2	11-04-06	CHANGED ESDV VALVES TO HORIZONTAL ACTUATOR AS SHOWN		PL		DRAWN BY		PES	LSD: 03-06-049-18 WSM	
1	11-03-28	REVISED PER CUSTOMER MARKUPS AND CHANGED PROJECT AS NOTED		PL		CHECKED BY		PES	TITLE	
0	11-03-21	ISSUED FOR CONSTRUCTION		PL		PROJECT NO.			GENERAL ARRANGEMENT DRAWING	
C	11-03-15	REVISED PER CUSTOMER MARKUPS		PL		SHEET NO.			SWEET SERVICE ESDV AND METERING PACKAGED	
B	11-03-04	ISSUED FOR APPROVAL		PL		DRAWING NO.			TAG: (PKG-001)	
A	11-02-24	ISSUED FOR APPROVAL		PL		PROJECT NO.			1899562	
						SHEET NO.			2 OF 4	
						DRAWING NO.			PES-18090505GA PLAN	
						REV. NO.			3	



THIS DRAWING IS THE PROPERTY OF PAINTEARTH ENERGY SERVICES. ANY UNAUTHORIZED REPRODUCTION OR DISTRIBUTION WITHOUT WRITTEN AUTHORIZATION IS STRICTLY PROHIBITED.