




A-A SECTION

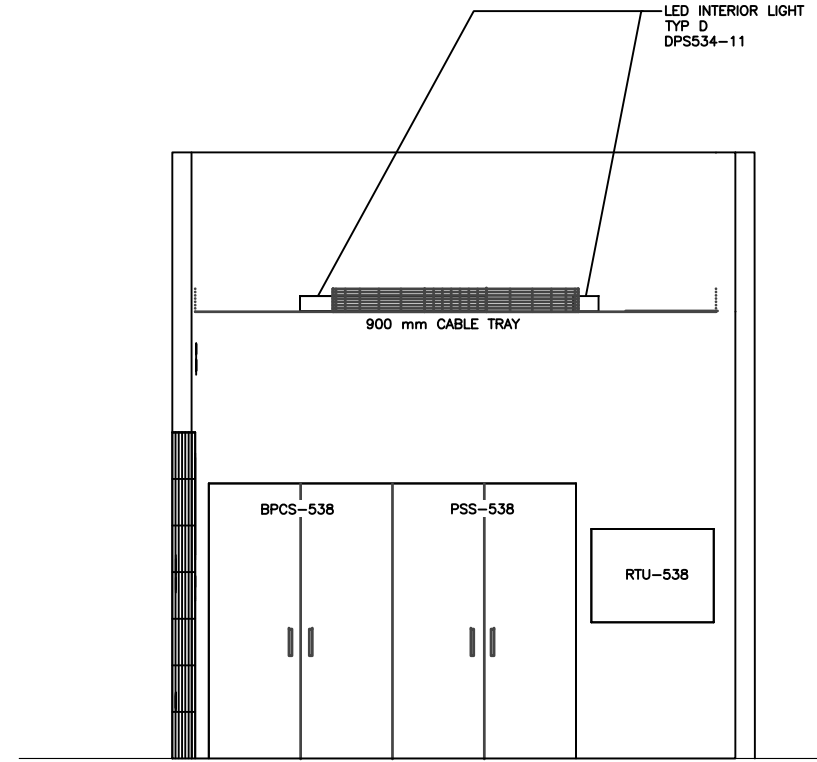

D-D SECTION

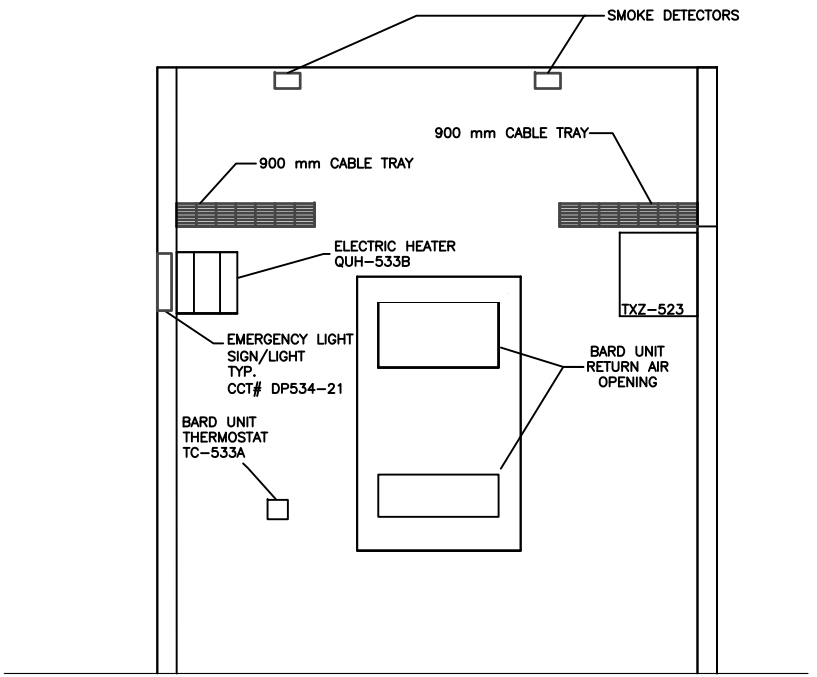

E-E SECTION

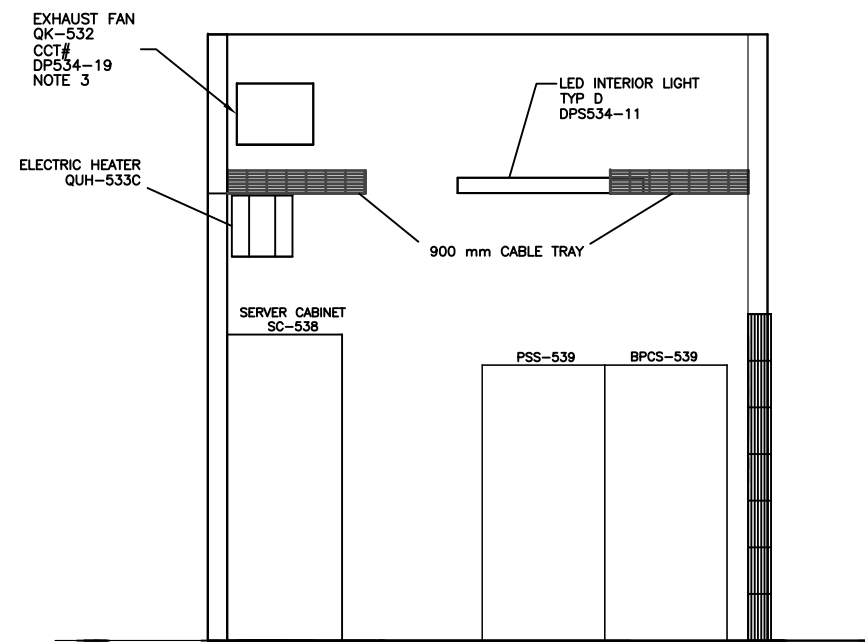

F-F SECTION

- NOTES**
- ALL SWITCHES TO BE INSTALLED 1200mm ABOVE PLATFORM FLOORING.
 - TO BE WIRED TO GROUNING BUS BAR. #2 AWG CABLE TO BE USED FOR ALL EQUIPMENTS EXCEPT MCC PANEL. GROUNING CABLE FOR MCC PANEL IS #2/0 AWG.
 - THE LOCATION OF EXHAUST FAN IS TO BE ON EAST WALL REFER TO WARWICK VENDOR DWG. W31534-A1 FOR MORE INFORMATION.
 - CABLE TRAYS TO BE 100MM AWAY FROM THE ADJACENT WALLS.
 - CLOUDED AREAS OTHER THAN AREAS IN NOTE 8 ARE IN THE SCOPE OF WORK OF FIELD ELECTRICAL CONTRACTOR FOR TRAIN 2.
 - FIELD ELECTRICAL CONTRACTOR TO INSTALL WARNING NAMEPLATE ON EACH SECTION OF MCC PANEL (MCC-531), SYNCHRONIZING SWITCHGEAR (SWG-537) AND SERVER CABINET.

ENGINEERING COMPANY PERMIT STAMP REGISTERED PROFESSIONAL ENGINEER STAMP

WHEN SIGNED & DATED, THE ENGINEERING SEAL & PERMIT AFFIXED ABOVE WILL APPLY TO THE CLOUDED AREAS FOR THE CURRENT REVISION ONLY.

6		
5		
4		
3		
2		
1		
REF	DRAWING NUMBER	DRAWING TITLE

REFERENCE DRAWINGS						
REV	DATE	DESCRIPTION	BY	CHK	ENG	APR
4	2015/08/26	AS BUILT FOR EWR 19227 EXCELSIOR 4178HUS	MB	BS	FJ	VD
3	2011/12/17	IFC FOR EWR 19227 EXCELSIOR 4178HUS	AE	BS	FJ	VD
2	2014/09/02	AS BUILT FOR EWR 18319 EXCELSIOR 3829	MB	BS	FJ	VD
1	2014/03/18	IFC FOR EWR 18319 EXCELSIOR 3829	BS	SSTJ	FJ	VD

REVISION HISTORY

Husky Oil Operations Limited



ANSELL 02-20-050-18W5 COMPRESSOR STN

TITLE MCC BUILDING (X-530)
ELECTRICAL & INSTRUMENTATION LAYOUT
SHEET 3

SURFACE LOCATION	02-20-050-18W5	REV NO	
ALTERNATE DWG NUMBER	LY-10-E-0001-3	HUSKY DWG NUMBER	02-20-050-18W5-EL-0022-03
VENDOR DWG NUMBER		SCALE	1:50
AMU/FLOC NUMBER	FH-AN-001-00007	DCN NO	
PROJECT NO 4178HUS EWR 19227			