




ENGINEERING COMPANY PERMIT STAMP					REGISTERED PROFESSIONAL ENGINEER STAMP				
WHEN SIGNED & DATED, THE ENGINEERING SEAL & PERMIT AFFIXED ABOVE WILL APPLY TO THE CLOUDED AREAS FOR THE CURRENT REVISION ONLY.									
6									
5									
4									
3									
2									
1									
	DRAWING NUMBER		DRAWING TITLE						
REFERENCE DRAWINGS									
2	2014/09/04	AS BUILT FOR EWR 18319 EXCELSIOR 3829	AE	SSTJ	FJ	VD			
1	2014/03/17	IFC FOR EWR 18319 EXCELSIOR 3829	AM	SSTJ	FJ	VD			
	DATE	DESCRIPTION	BY	CHK	ENG	APR			
REVISION HISTORY									
 Husky Oil Operations Limited									
 EXCELSIOR ENGINEERING LTD									
RAVEN CREEK 02-20-050-18W5 COMPRESSOR STN									
TITLE 02-20 MCC AREA HEAT TRACING PLOT PLAN LAYOUT/HT CIRCUIT #25									
SURFACE LOCATION 02-20-050-18W5									
ALTERNATE DWG NUMBER			LE-10-E-0025-3				REV NO		
HUSKY DWG NUMBER			02-20-050-18W5-ET-0024-03				2		
VENDOR DWG NUMBER							SCALE		
AMU/FLOC NUMBER			FH-AN-001-00007				1:30		
DCN NO			PROJECT NO 3829			EWR 18319			
</									

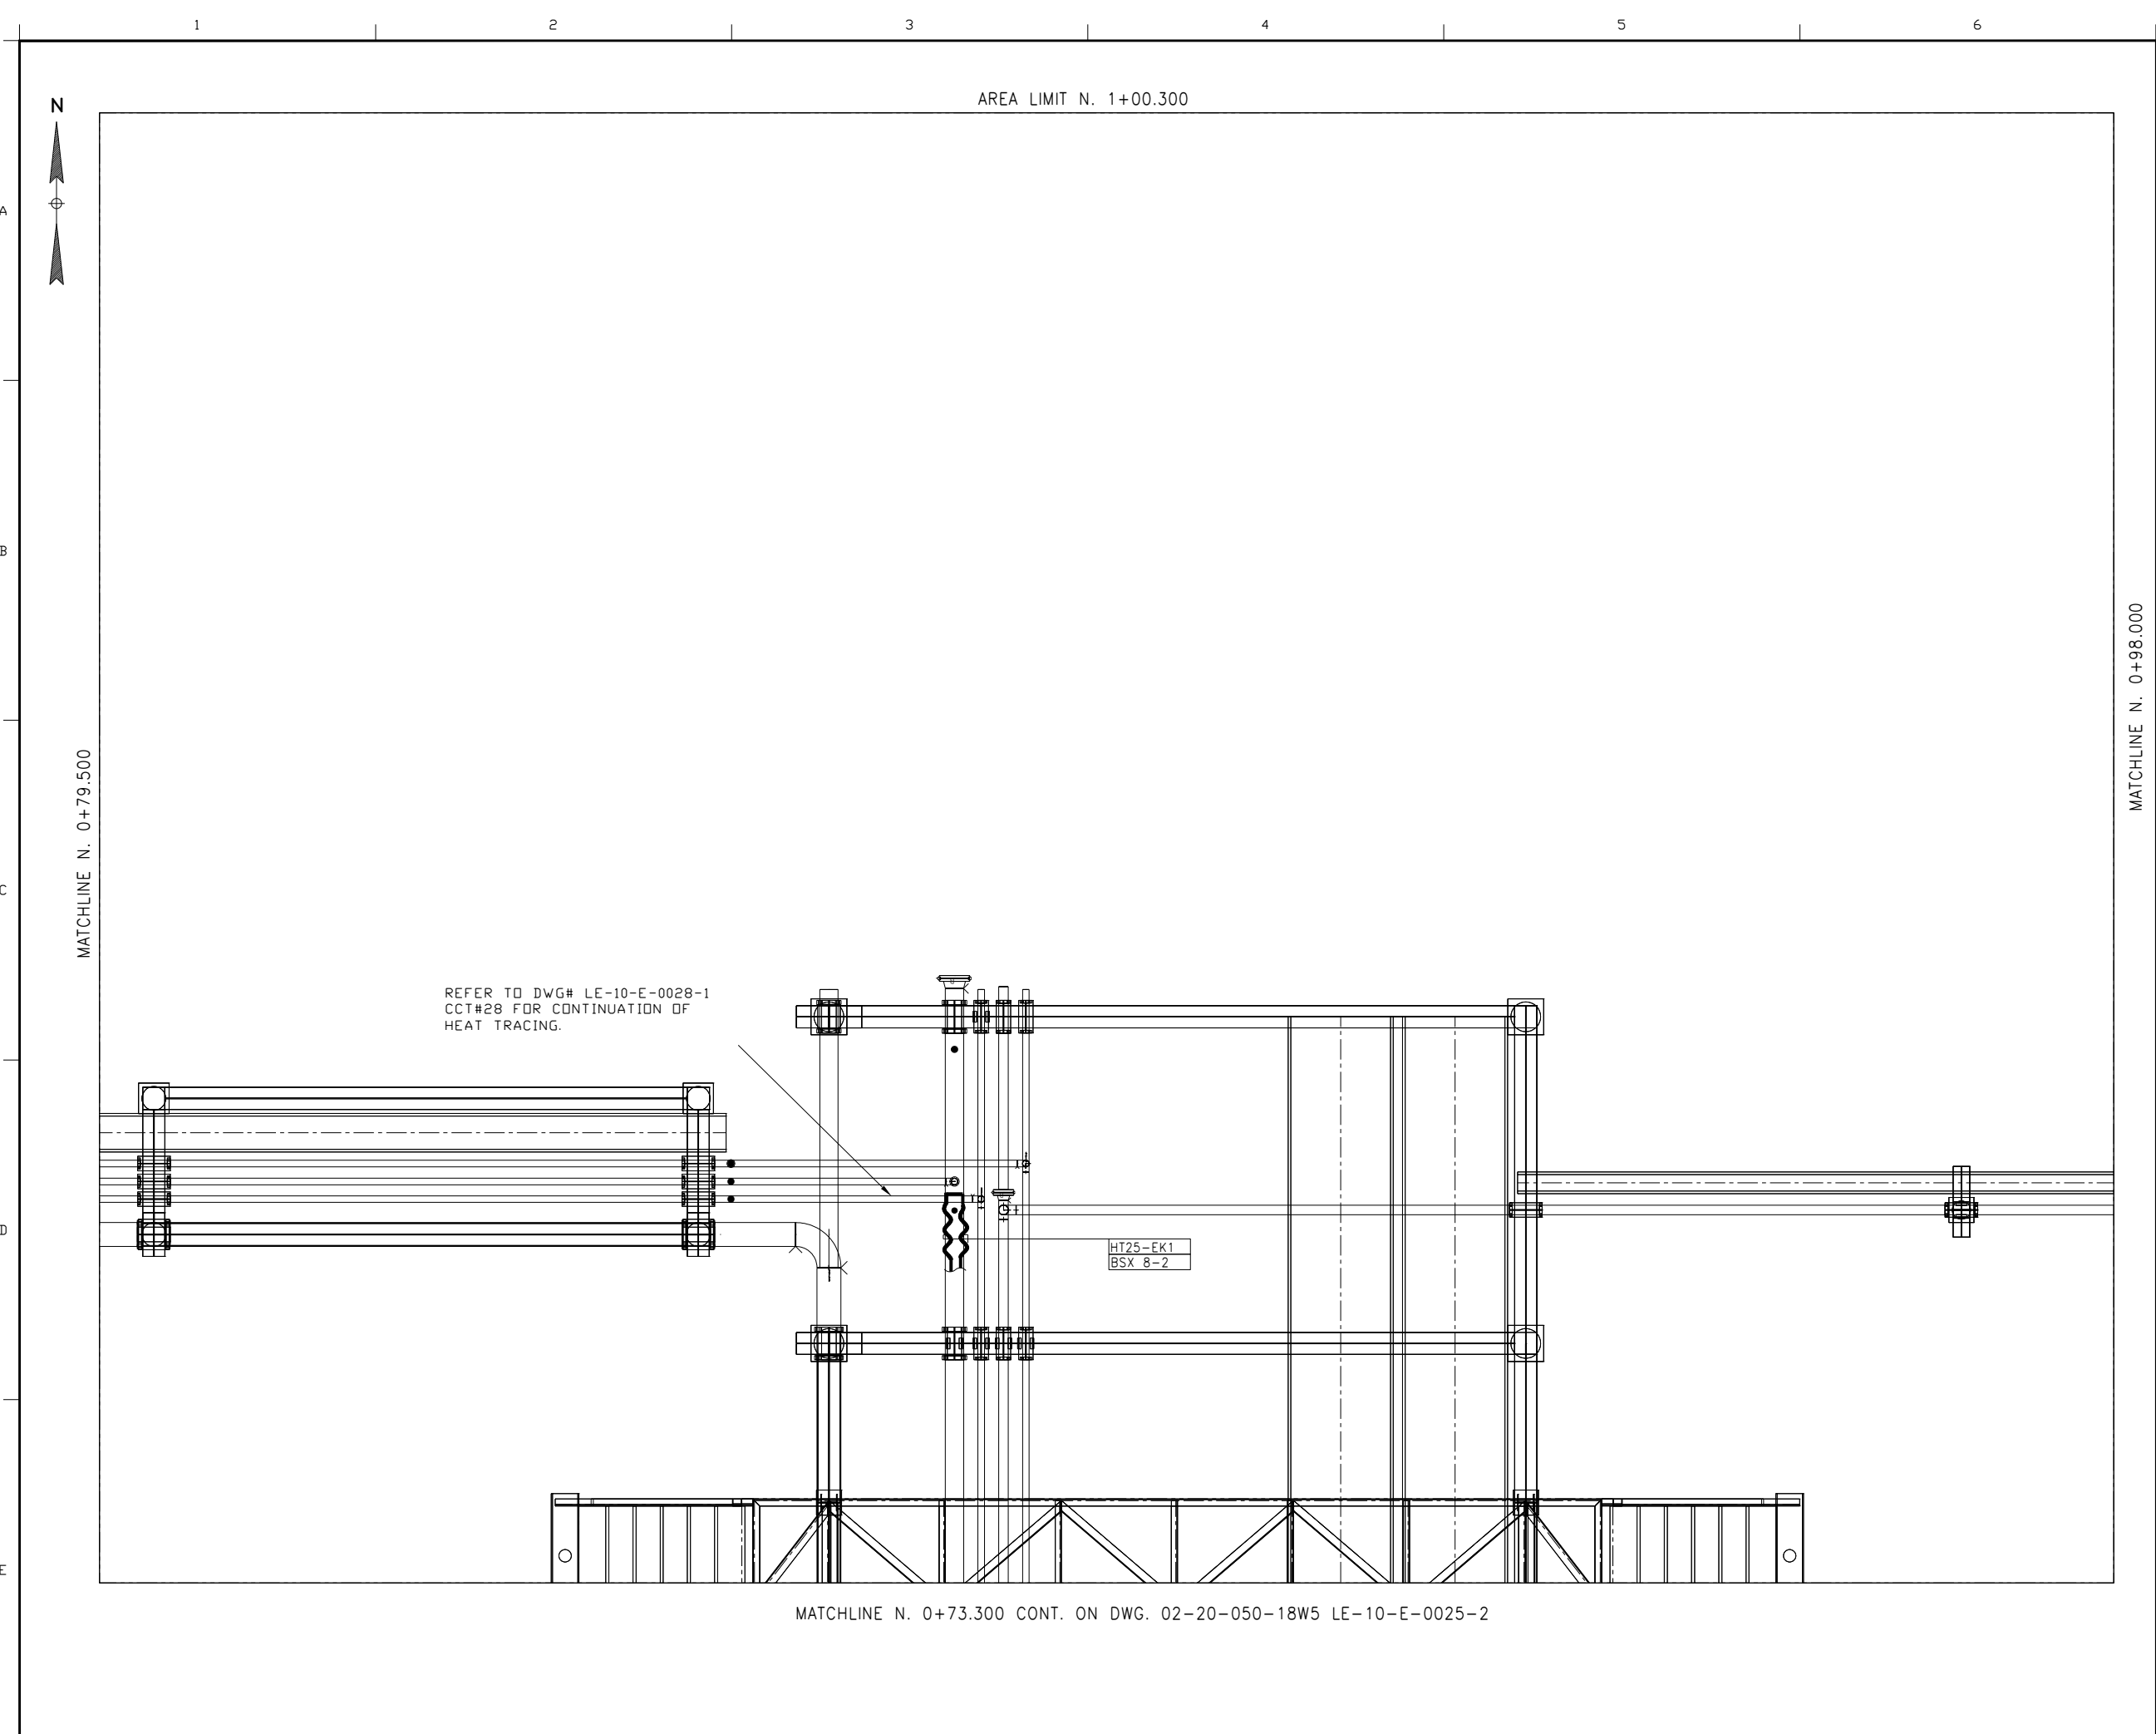