




MATCHLINE N. 0+79.500 CONT. ON DWG. 02-20-050-18W5 LE-10-E-0028-2

AREA LIMIT N. 1+00.300

MATCHLINE N. 0+98.000

MATCHLINE N. 0+86.800

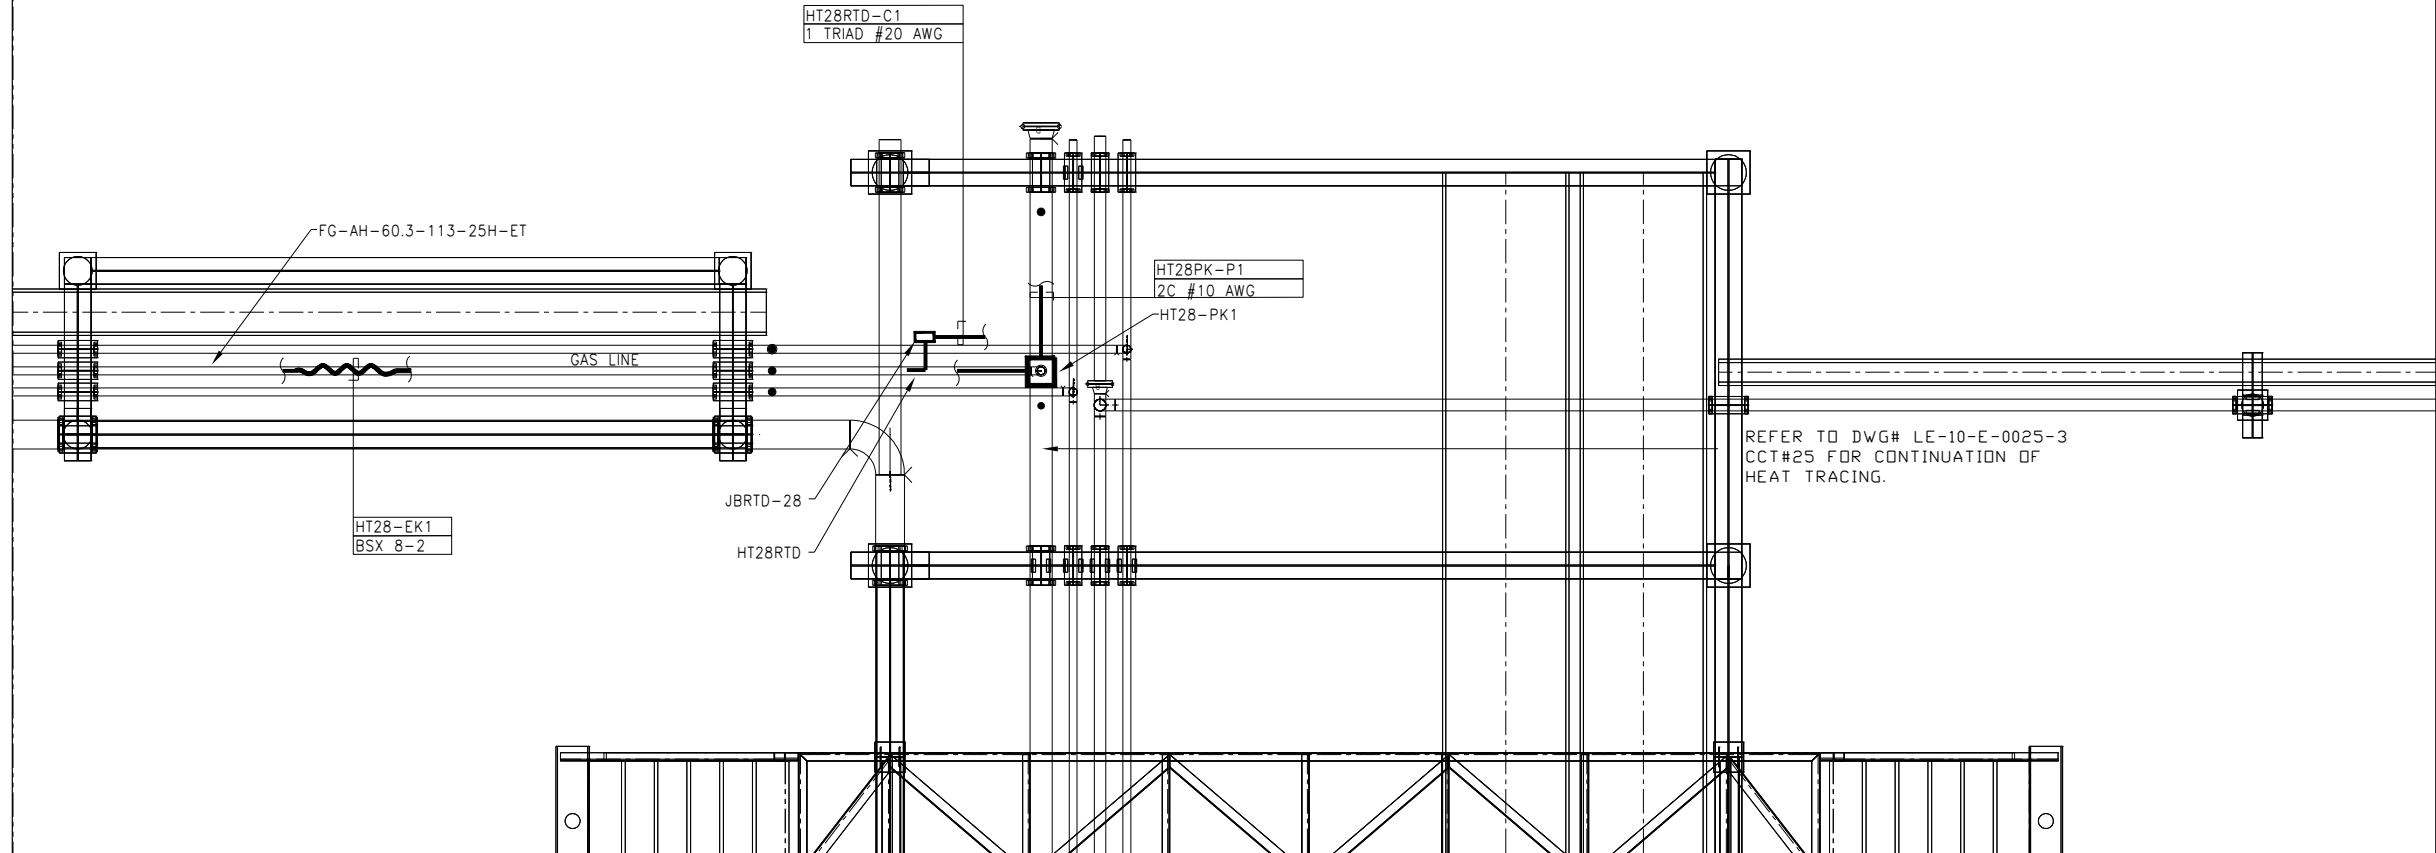

ENGINEERING COMPANY PERMIT STAMP		REGISTERED PROFESSIONAL ENGINEER STAMP	

WHEN SIGNED & DATED, THE ENGINEERING SEAL & PERMIT AFFIXED ABOVE WILL APPLY TO THE CLOUDED AREAS FOR THE CURRENT REVISION ONLY.

6		
5		
4		
3		
2		
1		
DRAWING NUMBER		DRAWING TITLE

REFERENCE DRAWINGS							
2	2014/09/04	AS BUILT FOR EWR 18319 EXCELSIOR 3829	AE	SSTJ	FJ	VD	
1	2014/03/17	IFC FOR EWR 18319 EXCELSIOR 3829	AM	SSTJ	FJ	VD	
	DATE	DESCRIPTION	BY	CHK	ENG	APR	

REVISION HISTORY

 **Husky Oil Operations Limited**



RAVEN CREEK 02-20-050-18W5 COMPRESSOR STN

TITLE 02-20 MCC AREA
HEAT TRACING PLOT PLAN LAYOUT/HT CIRCUIT# 28

SURFACE LOCATION		02-20-050-18W5
ALTERNATE DWG NUMBER	LE-10-E-0028-1	REV NO
HUSKY DWG NUMBER	02-20-050-18W5-ET-0027-01	2
VENDOR DWG NUMBER		SCALE
AMU/FLOC NUMBER	FH-AN-001-00007	1:30
DCN NO	PROJECT NO 3829	EWR 18319

