


Ground Fault not external - DITTO UNIT 'A'

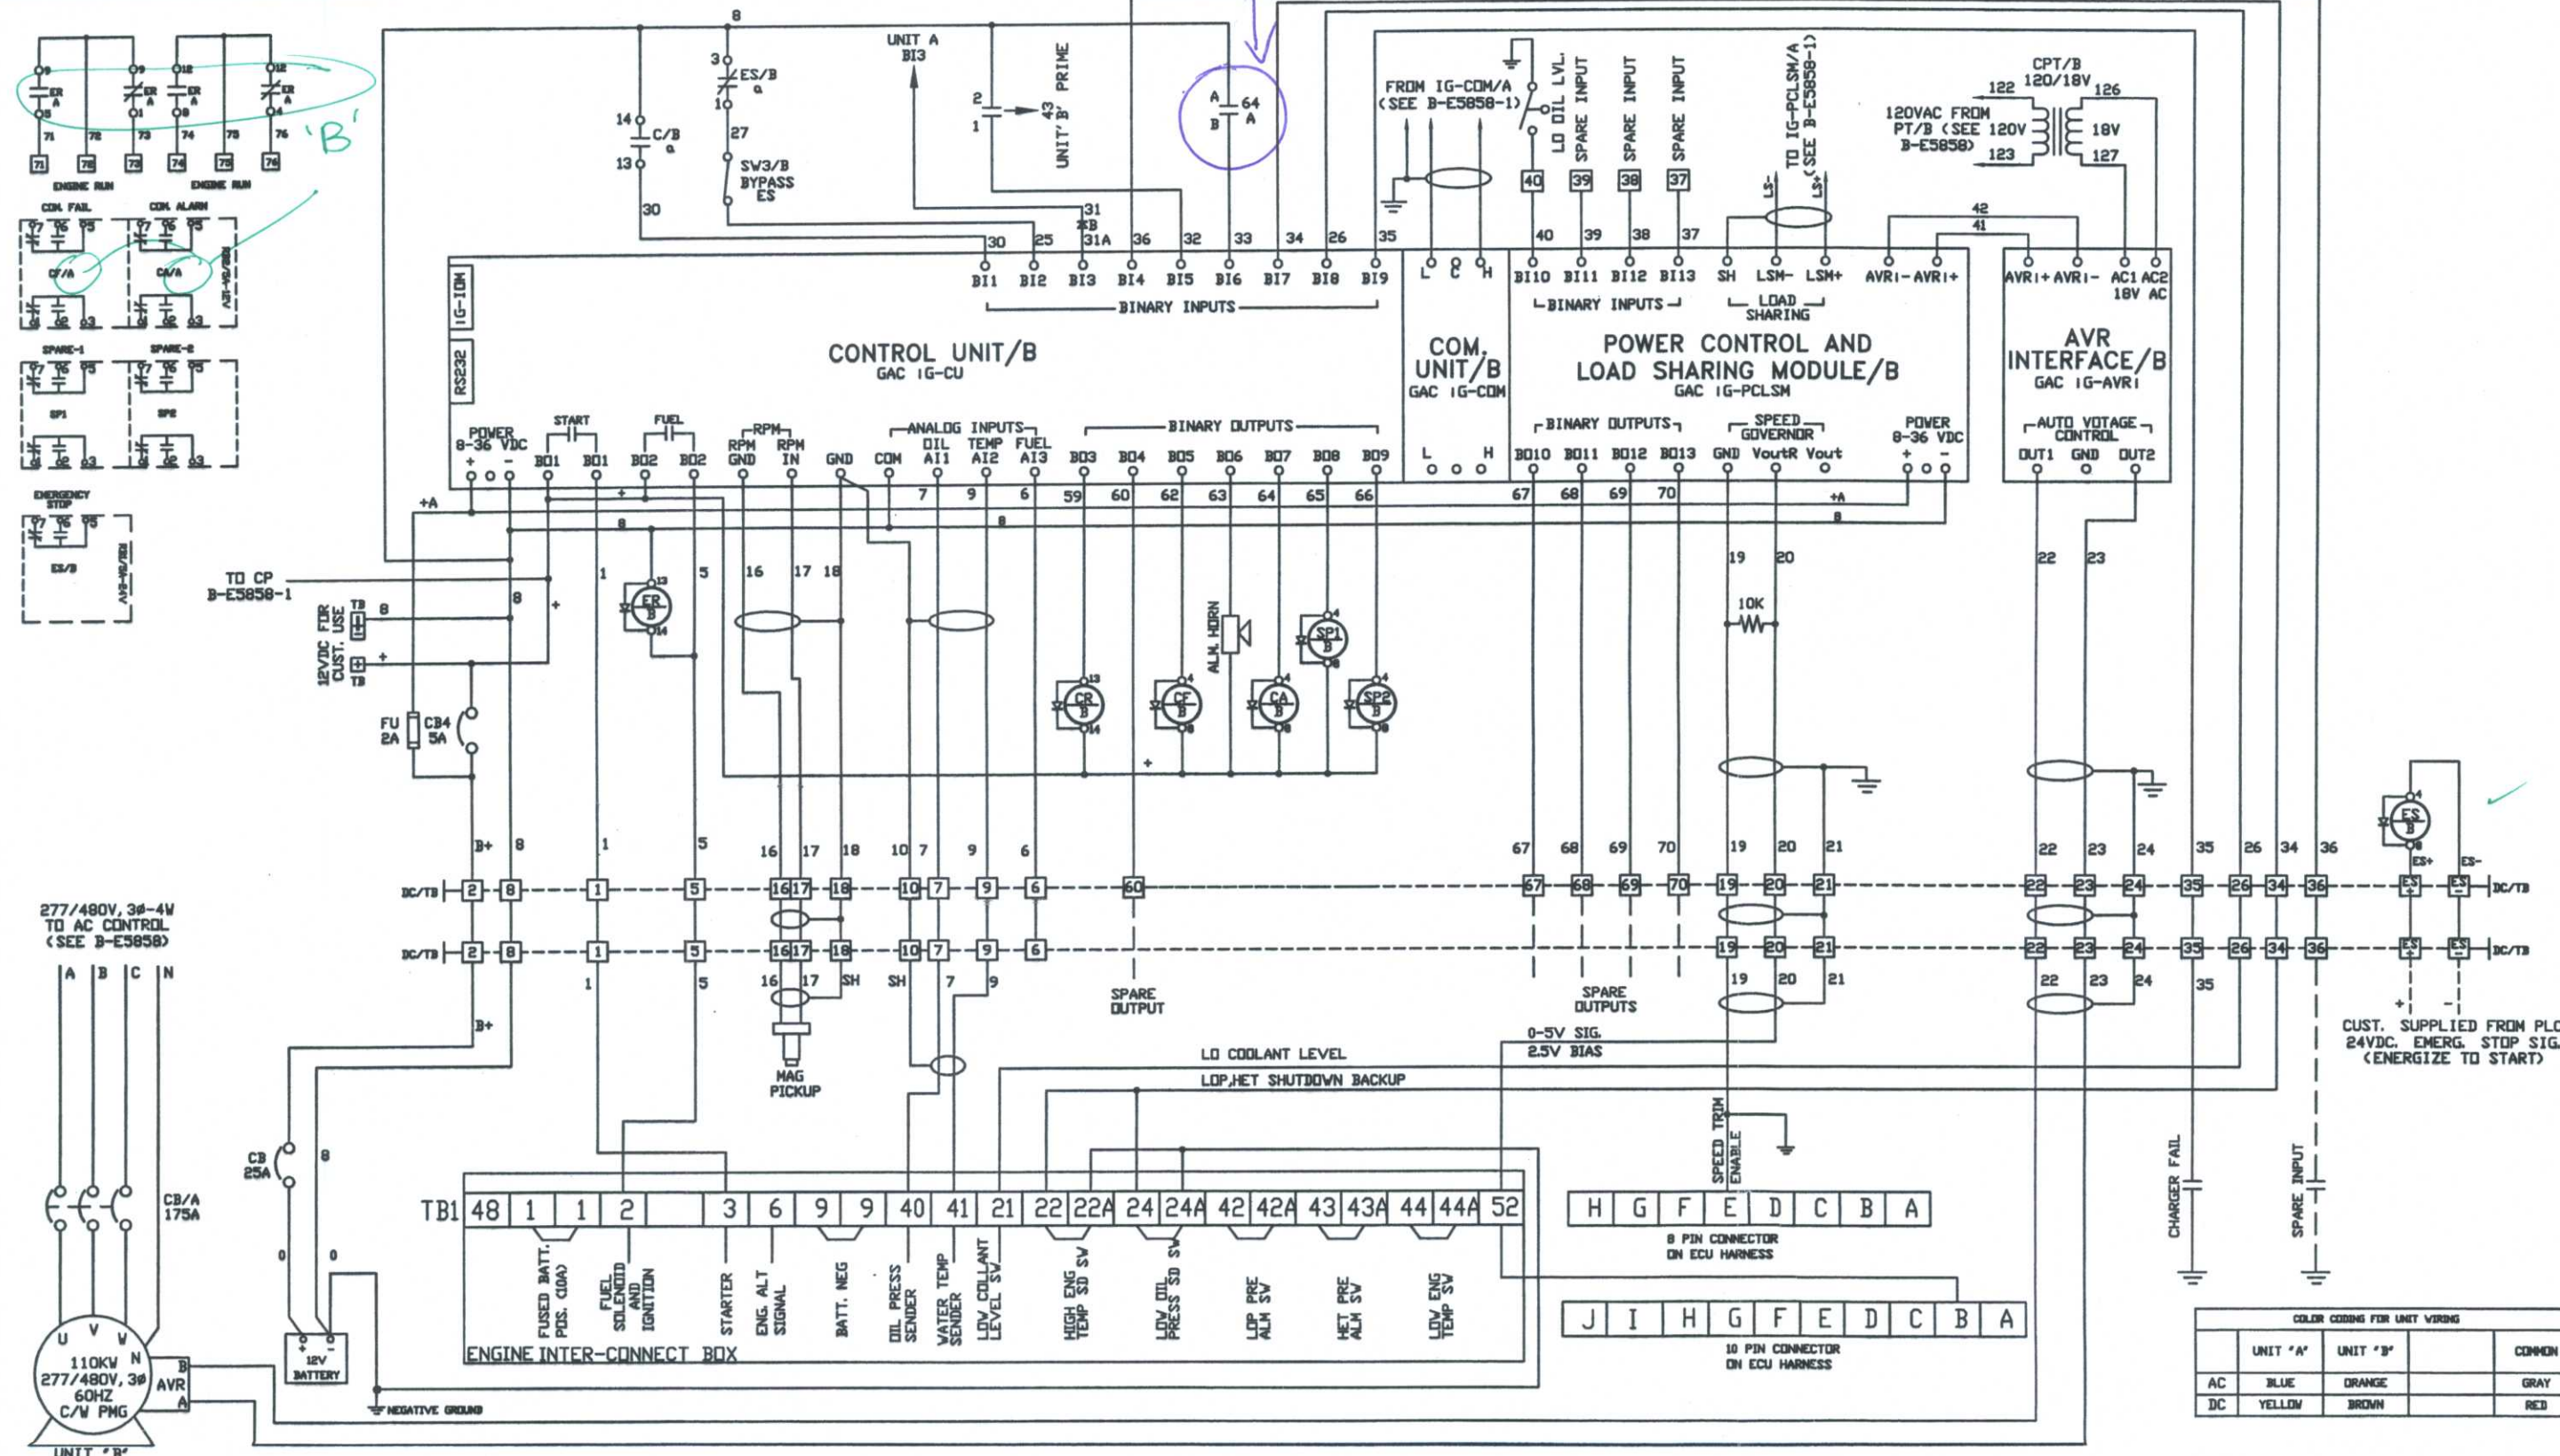

Tartan ENGINEERING

DRAWING REVIEW

REVIEW IS FOR GENERAL COMPLIANCE WITH CONTRACT DOCUMENTS. NO RESPONSIBILITY IS ASSUMED FOR CORRECTNESS OF DESIGN (IF REQUIRED OF THE VENDOR/CONTRACTOR), DIMENSIONS OR DETAILS.

☒ NO EXCEPTIONS TAKEN
PROCEED WITH CONSTRUCTION

☒ MAKE CORRECTIONS NOTED
PROCEED WITH CONSTRUCTION

☐ REVISE AND RESUBMIT

BY: AB DATE: 05-06-06

PROJ. NO. 336500 DATE RECEIVED May 25/06

Tartan ENGINEERING

DRAWING CHECK

Department	Circulate to	Initial	Date Received	Date Checked
Piping & Design	JK	JK	May 26/06	
Process	NF	NF	May 31/06	
Mechanical	JB/GM			
Instrument	KB/BW		May 31/06	
Systems			June/06	
Electrical	JF	JF	May 31/06	
Civil & Structural	AB			
Operations				
Project Engineer				
Project Manager	HT			

RETURN TO: Bob B. BY: May 30/06

THIS DRAWING CONTAINS CONFIDENTIAL INFORMATION OF A PROPRIETARY NATURE TO SIMMAX INC. REPRODUCTION, TRANSMISSION OR USE FOR ANY PURPOSE WITHOUT THE EXPRESS WRITTEN CONSENT OF SIMMAX INC. IS STRICTLY PROHIBITED.

RELEASED TO PRODUCTION

NO CUSTOMER APPROVAL REQUIRED

CUSTOMER: S/M CALGARY

HUSKY OIL OPERATIONS LTD.

ANSELL - C/O TARTAN ENG.

06C254

NOTES:		DRAWN BY: G.P.LAPOINTE		DATE:	
NO.	DESCRIPTION	CHECKED BY:		05/10/06	
		REVISIONS			
		NO.	DATE	BY	DESCRIPTION

SIMSON-MAXWELL

TITLE: SCHEMATIC DIAGRAM OF GEN. CONTROL DC WIRING UNIT "B"

SCALE: N.T.S. DRAWING NO: B-E5858-2 REV: 0 SIZE: B