




FRONT VIEW

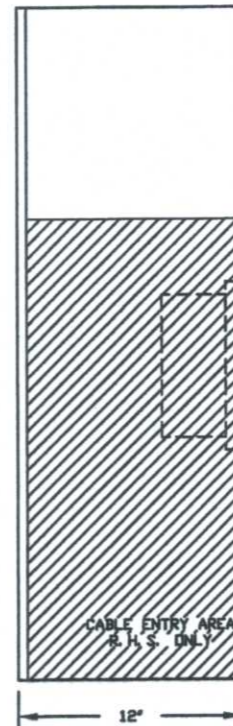

SIDE VIEW

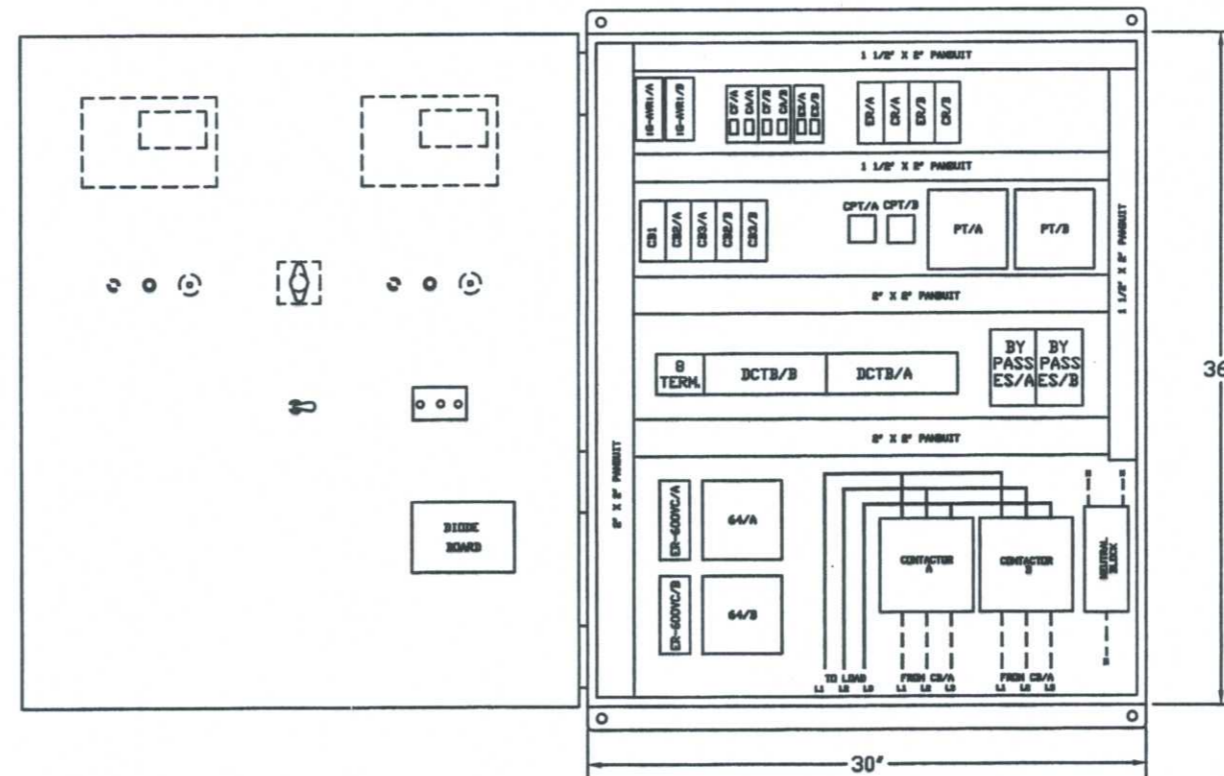

FRONT VIEW (DOOR OPEN)

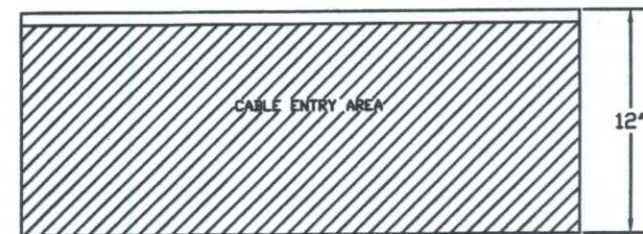

BOTTOM VIEW

THIS DRAWING CONTAINS CONFIDENTIAL INFORMATION OF A PROPRIETARY NATURE TO SIMMAX INC. REPRODUCTION, TRANSMISSION OR USE FOR ANY PURPOSE WITHOUT THE EXPRESS WRITTEN CONSENT OF SIMMAX INC. IS STRICTLY PROHIBITED.

RELEASED TO PRODUCTION

NO CUSTOMER APPROVAL REQUIRED

CUSTOMER:

S/M CALGARY

HUSKY OIL OPERATIONS  
ANSELL - C/O TARTAN ENG.  
06C254

NOTES:

NO.	DESCRIPTION

DRAWN BY: G.P.LAPOINTE

DATE:

05/10/06

CHECKED BY:

REVISIONS

NO.	DATE	BY	DESCRIPTION



**SIMSON-MAXWELL**

TITLE: PHYSICAL LAYOUT OF  
2 UNIT PRIME POWER GENSET CONTROL  
PANEL, 277/480V, 3Ø-4W+G

SCALE: 1"=10"  
DRAWING NO: B-M5858  
REV: 0  
SIZE: B

**Tartan ENGINEERING** **DRAWING REVIEW**

REVIEW IS FOR GENERAL COMPLIANCE WITH CONTRACT DOCUMENTS. NO RESPONSIBILITY IS ASSUMED FOR CORRECTNESS OF DESIGN (IF REQUIRED OF THE VENDOR/CONTRACTOR), DIMENSIONS OR DETAILS.

☒ NO EXCEPTIONS TAKEN  
PROCEED WITH CONSTRUCTION

☐ MAKE CORRECTIONS NOTED  
PROCEED WITH CONSTRUCTION

☐ REVISE AND RESUBMIT

BY: [Signature] DATE: 06.06.06  
PROJ. NO. 336500 DATE RECEIVED May 25

**Tartan ENGINEERING** **DRAWING CHECK**

Department	Calculate to	Initial	Date Received	Date Checked
Piping & Design	JK	[Signature]	May 26/06	
Process	NF	[Signature]	May 26/06	
Mechanical	JB/GM	[Signature]	May 31/06	
Instrument	KB/BW	[Signature]	June 1/06	
Systems		[Signature]	June 1/06	
Electrical	JF	[Signature]	May 31/06	
Valve & Instrumental	AB			
Operations				
Project Engineer				
Project Manager	HT			

RETURN TO: Bob B. BY: May 30