

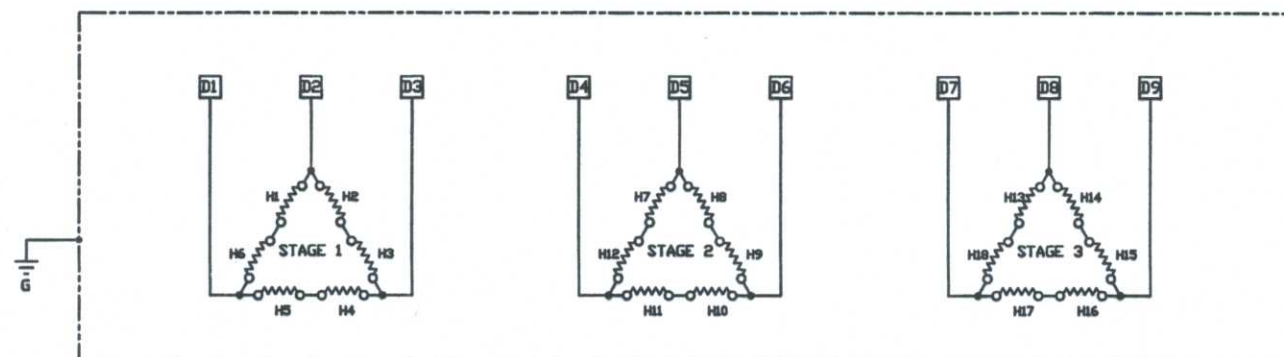
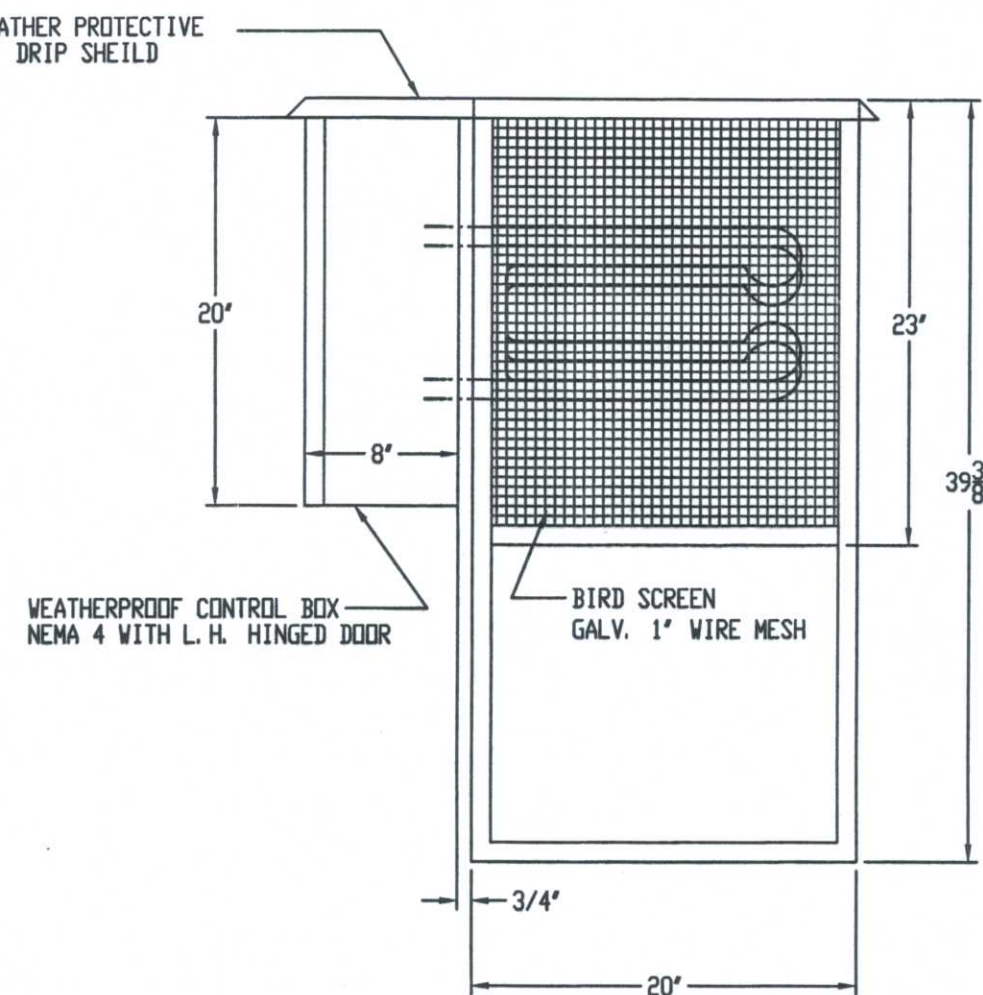
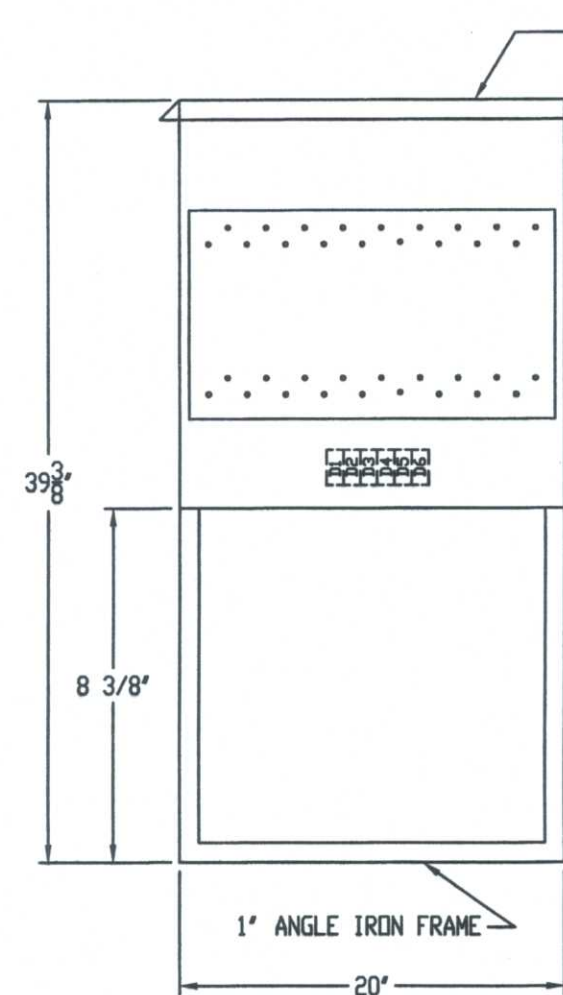


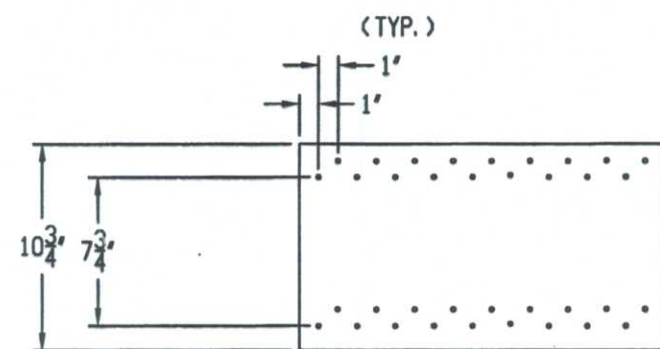

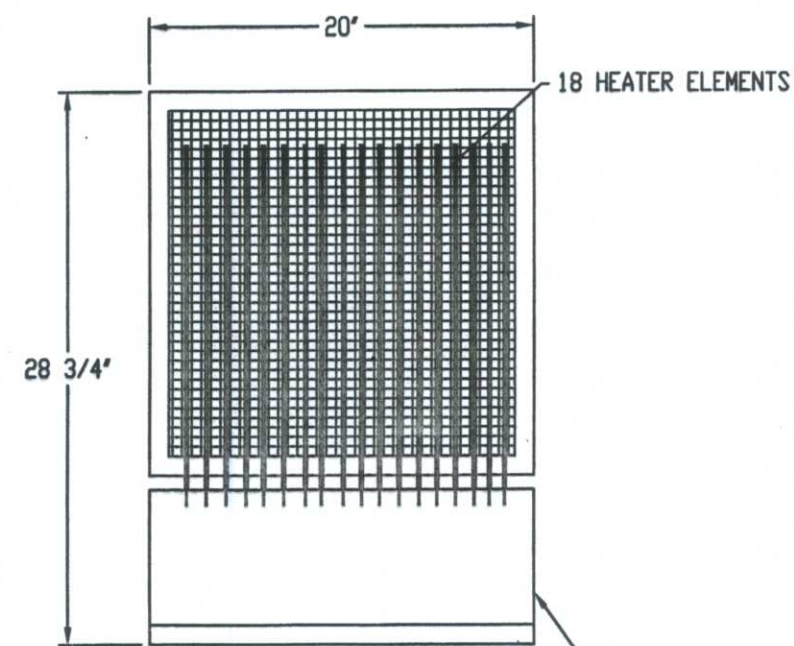

Tartan

ESTABLISHED 1982

DRAWING REVIEW

REVIEW IS FOR GENERAL COMPLIANCE
WITH CONTRACT DOCUMENTS.
NO RESPONSIBILITY IS ASSUMED FOR
CORRECTNESS OF DESIGN (IF REQUIRED
OF THE VENDOR/CONTRACTOR),
DIMENSIONS OR DETAILS.

☒ NO EXCEPTIONS TAKEN
PROCEED WITH CONSTRUCTION

☐ MAKE CORRECTIONS NOTED
PROCEED WITH CONSTRUCTION

☐ REVISE AND RESUBMIT

BY RS

DATE 06.06.09

PROJ. NO. 336500

DATE RECEIVED May 25/06



DRAWING CHECK

Department	Circulate to	Initial	Date Received	Date Checked
Piping & Design	JK	JK	May 26/06	
Process	NF	NF	May 31/06	May 31/06
Mechanical	JB/GM			
Instrument	KB/BW	BW	mm 31/06	
Reviews		BW	June 1/06	
Operations	JB	JRF	MAY 31/06	
Project Engineer	AB			
Project Manager	HT			

RETURN TO Bob. B BY May 30/06

THIS DRAWING CONTAINS CONFIDENTIAL INFORMATION OF A PROPRIETARY NATURE TO SIMMAX INC. REPRODUCTION, TRANSMISSION OR USE FOR ANY PURPOSE WITHOUT THE EXPRESS WRITTEN CONSENT OF SIMMAX INC. IS STRICTLY PROHIBITED.	RELEASED TO PRODUCTION	CUSTOMER: S/M CALGARY HUSKY OIL OPERATIONS LTD. 06C254	NOTES:		DRAWN BY: R.DHANU		DATE:		 SIMSON-MAXWELL		
	NO CUSTOMER APPROVAL REQUIRED		NO.	DESCRIPTION	CHECKED BY:		05/11/06			TITLE: PHYSICAL LAYOUT OF DL40 ,3 STAGE, 18ELEMENT 480V 3Ø LOAD BANK	
					REVISIONS NO. DATE BY DESCRIPTION		SCALE: 1:10		DRAWING NO: B-M5858-1	REV:	SIZE: B