


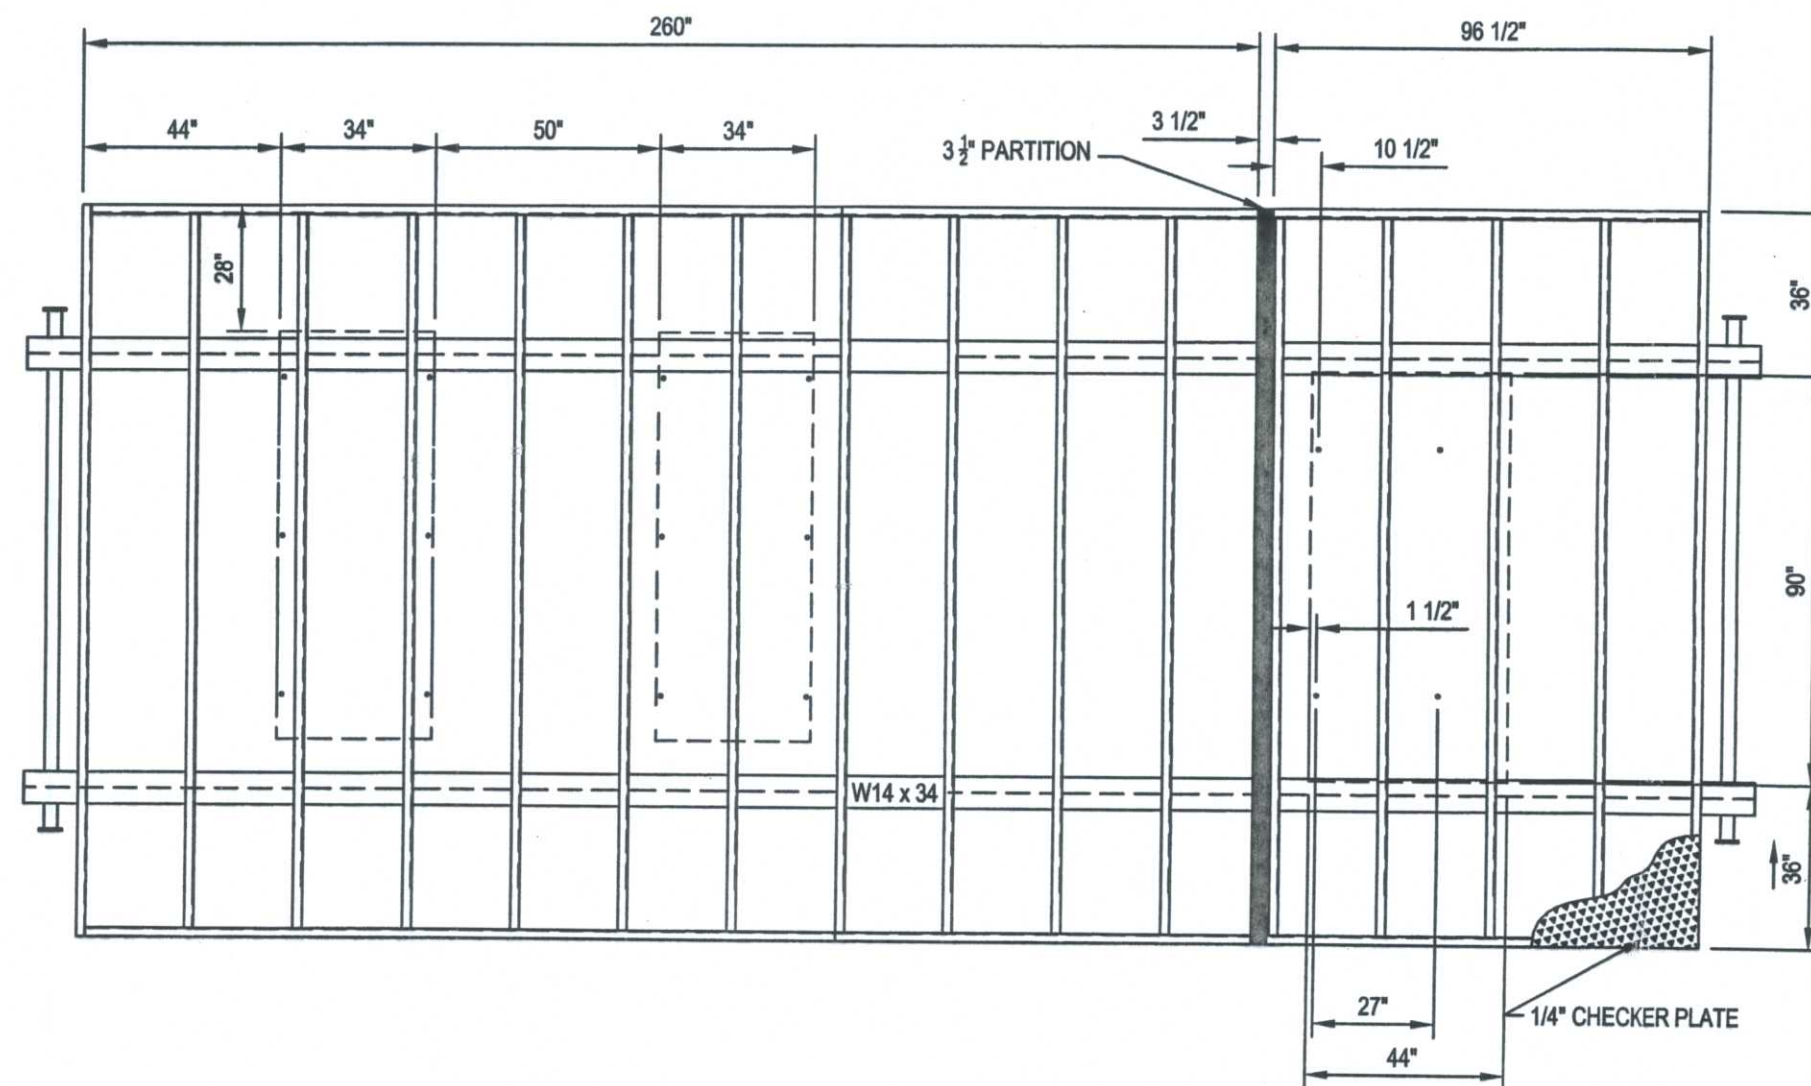

Tartan ENGINEERING

DRAWING REVIEW

REVIEW IS FOR GENERAL COMPLIANCE WITH CONTRACT DOCUMENTS. NO RESPONSIBILITY IS ASSUMED FOR CORRECTNESS OF DESIGN (IF REQUIRED OF THE VENDOR/CONTRACTOR), DIMENSIONS OR DETAILS.

☒ NO EXCEPTIONS TAKEN
PROCEED WITH CONSTRUCTION

☐ MAKE CORRECTIONS NOTED
PROCEED WITH CONSTRUCTION

☐ REVISE AND RESUBMIT

BY: JB DATE: 06-06-09

PROJ. NO. 336500 DATE RECEIVED May 25/06

Tartan ENGINEERING

DRAWING CHECK

Department	Circulate to	Initial	Date Received	Date Checked
Piping & Design	JK	JK	May 26/06	
Process	NF	NF	May 31/06	
Mechanical	JB/GMA	JB	May 31/06	
Instrument	KIB/BW	KIB	May 31/06	
Systems			June 6/06	
Electrical	SF	SF	MAY 31/06	
Oil & Chemical	AB	AB		
Construction				
Process Engineers				
Project Manager	HT	HT		

RETURN TO BoB.B BY May 30-06

THIS DRAWING CONTAINS CONFIDENTIAL INFORMATION OF A PROPRIETARY NATURE TO SIMMAX INC. REPRODUCTION, TRANSMISSION OR USE FOR ANY PURPOSE WITHOUT THE EXPRESS WRITTEN CONSENT OF SIMMAX INC. IS STRICTLY PROHIBITED.

TOLERANCE UNLESS NOTED

DIMENSIONS	X.X	X.XX	X.XXX
INCH	±1/16"	±1/64"	±1/128"
mm	±1.0	±0.375	±0.125
ANGLE	±0.5		

THIRD ANGLE PROJECTION

FOR APPROVAL (CHECK ONE ONLY)

☐ APPROVED

☐ APPROVED, SEE CHANGES

☐ RE-SUBMIT, SEE CHANGES

☐ NOT APPROVED

SIGNED: _____ DATED: _____

CUSTOMER: **HUSKY**

06C254

NOTES:

NO.	DESCRIPTION

DRAWN BY: **W CABLE**

CHECKED BY: _____

DATE: **05/19/06**

REVISIONS

NO.	DATE	BY	DESCRIPTION

SIMSON-MAXWELL

TITLE: **SKID LAYOUT**

SCALE: **NTS**

DRAWING NO: **06C254-B**

REV: **0**

SIZE: **B**