




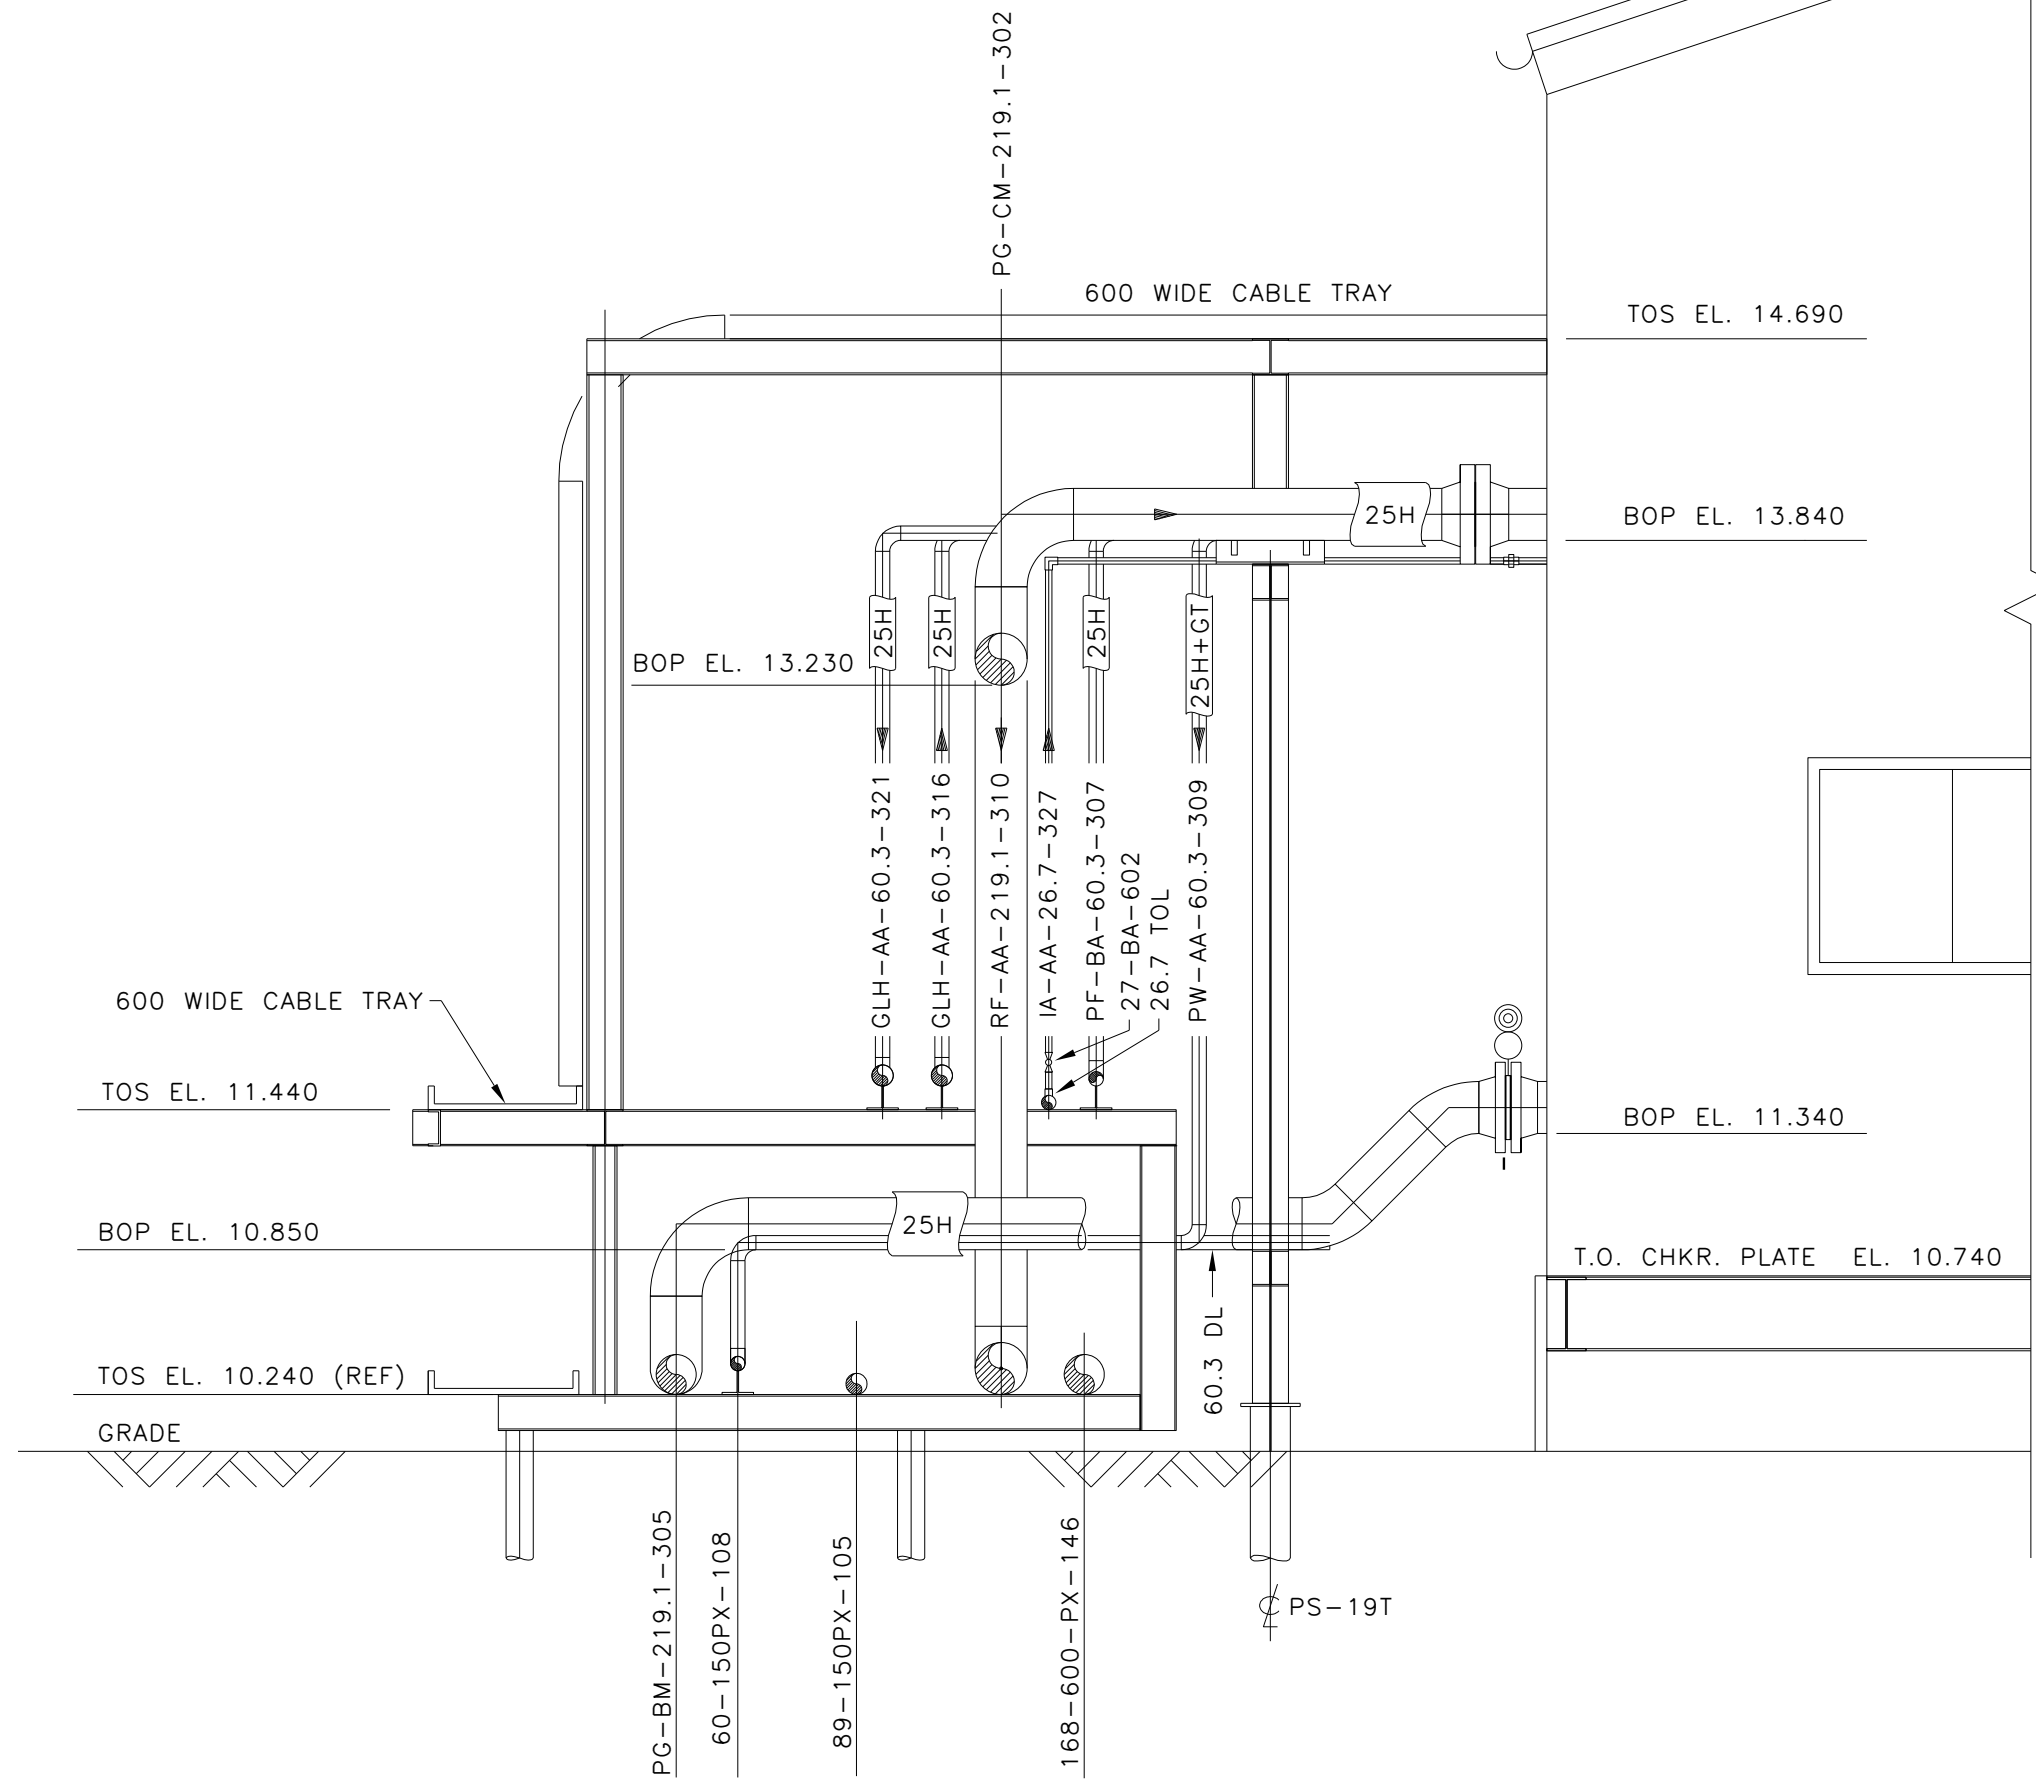

A
SECTION
001

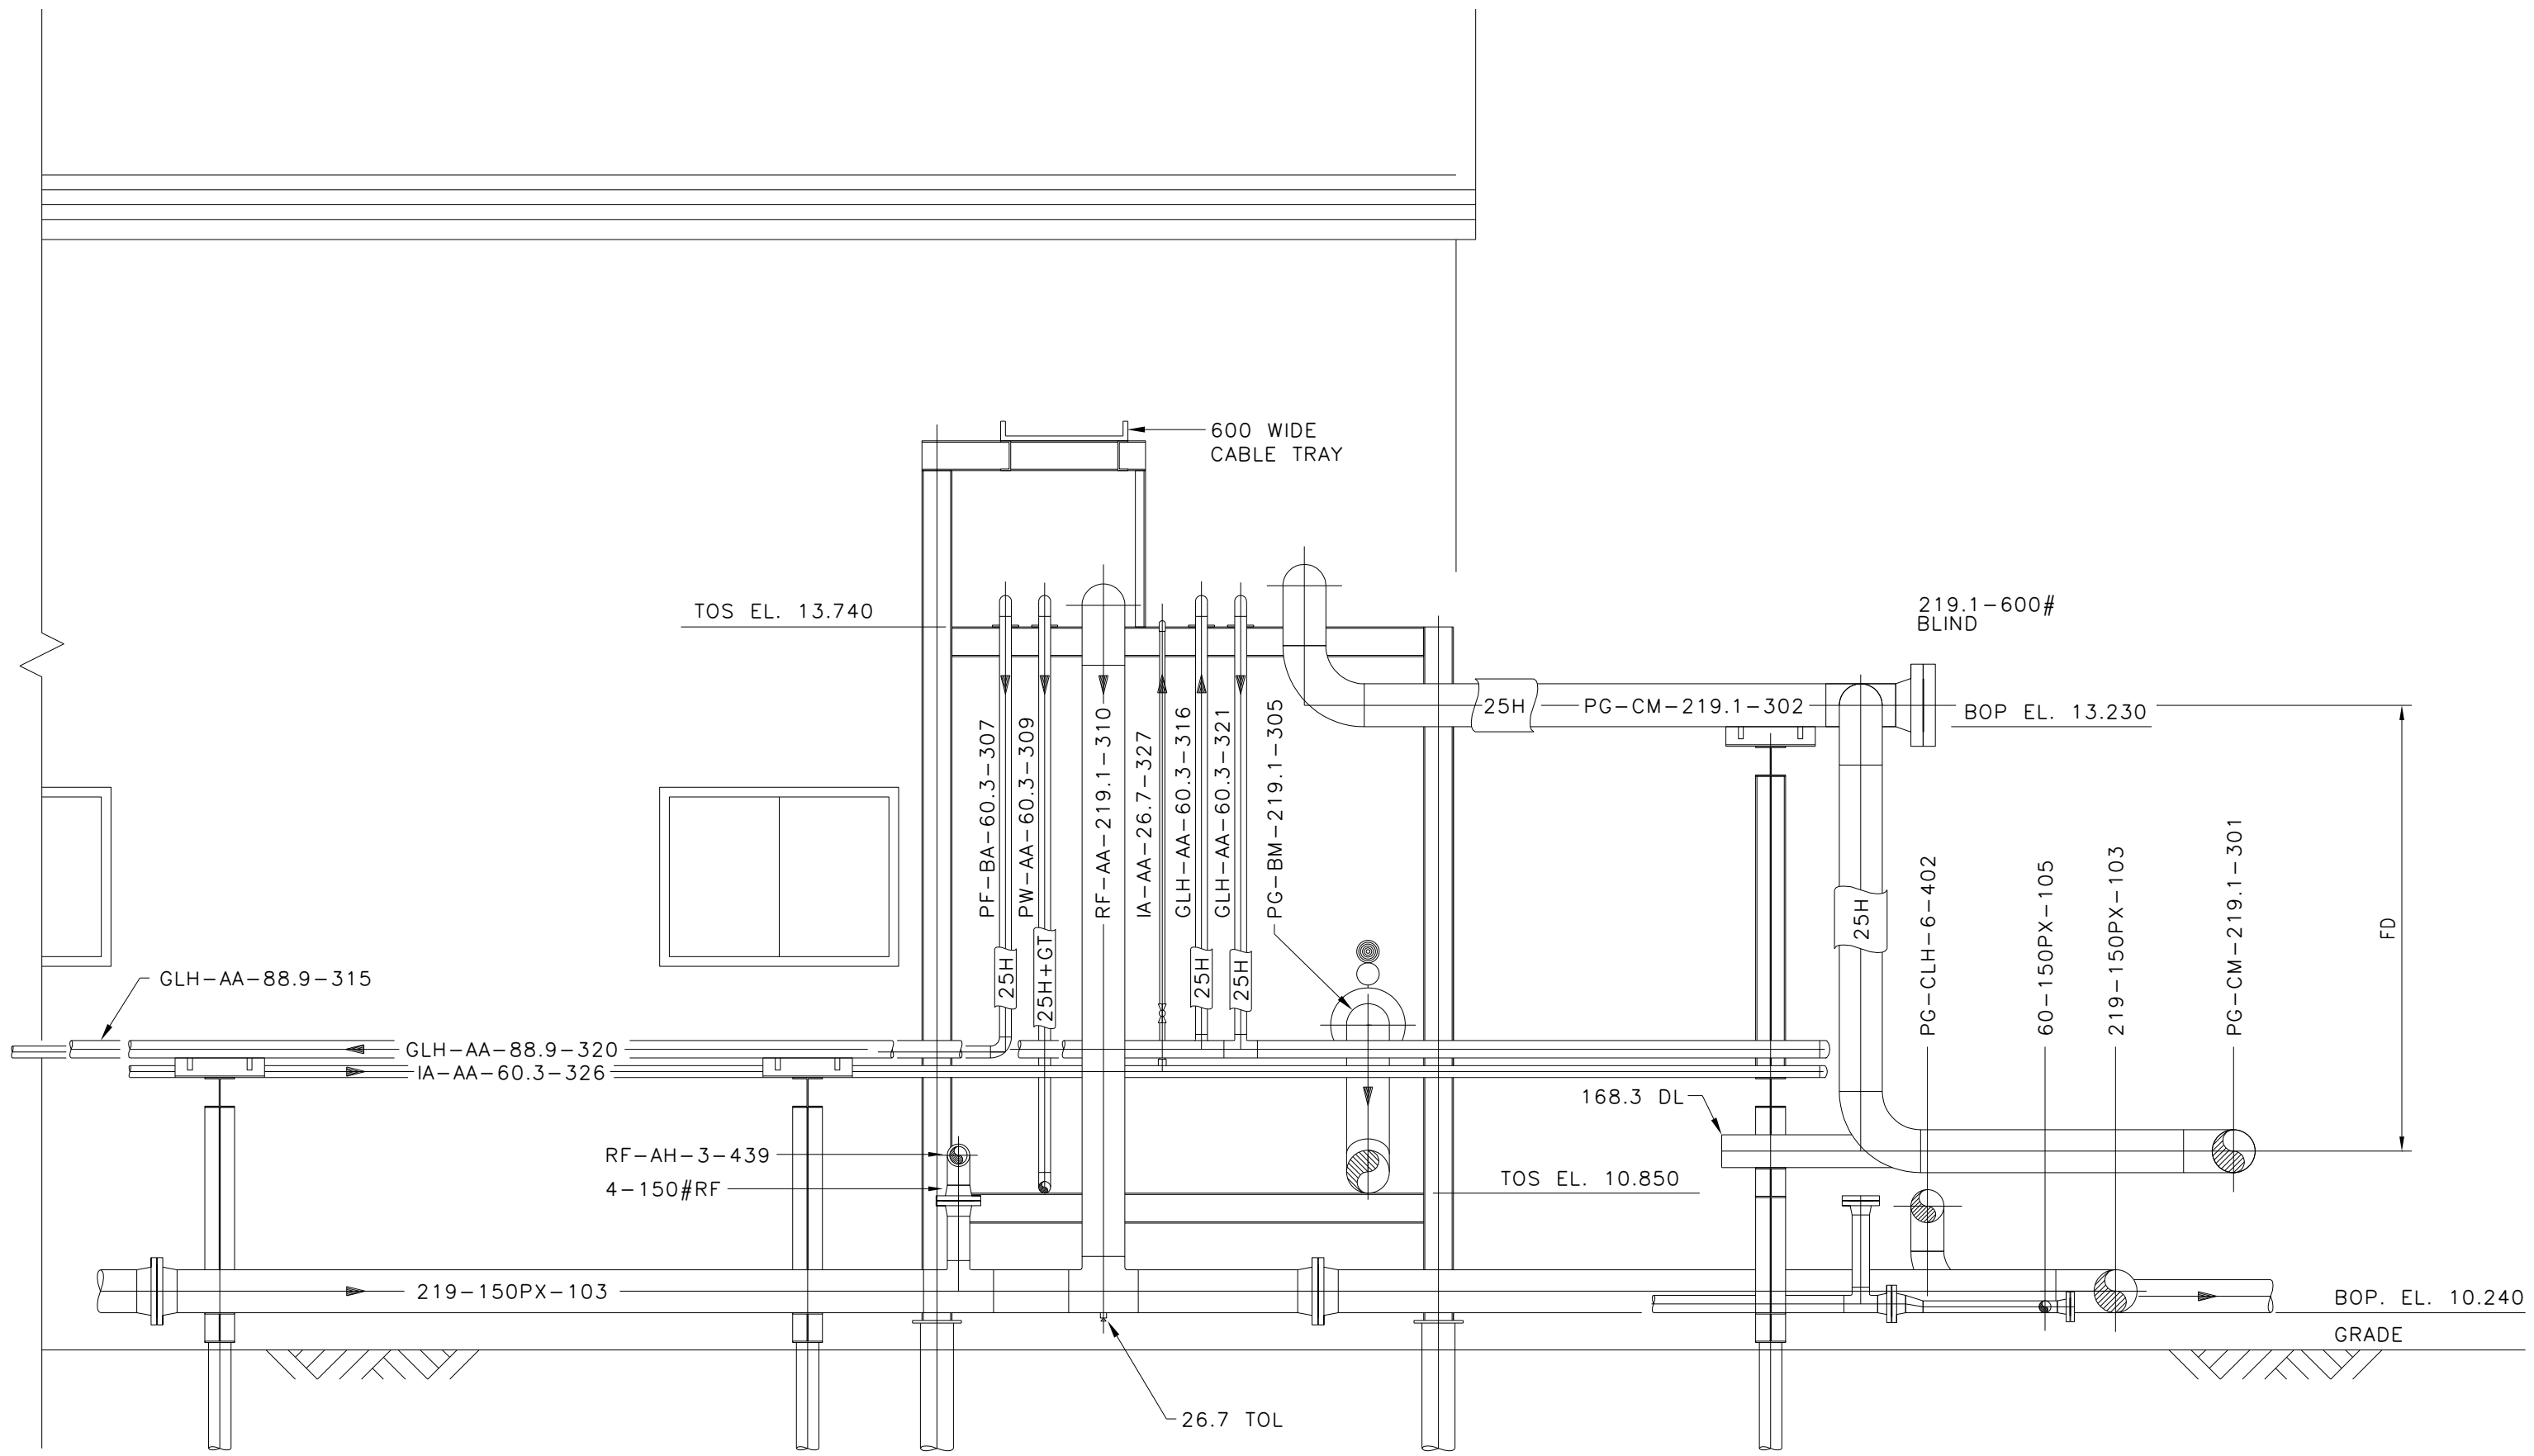

B
SECTION
001

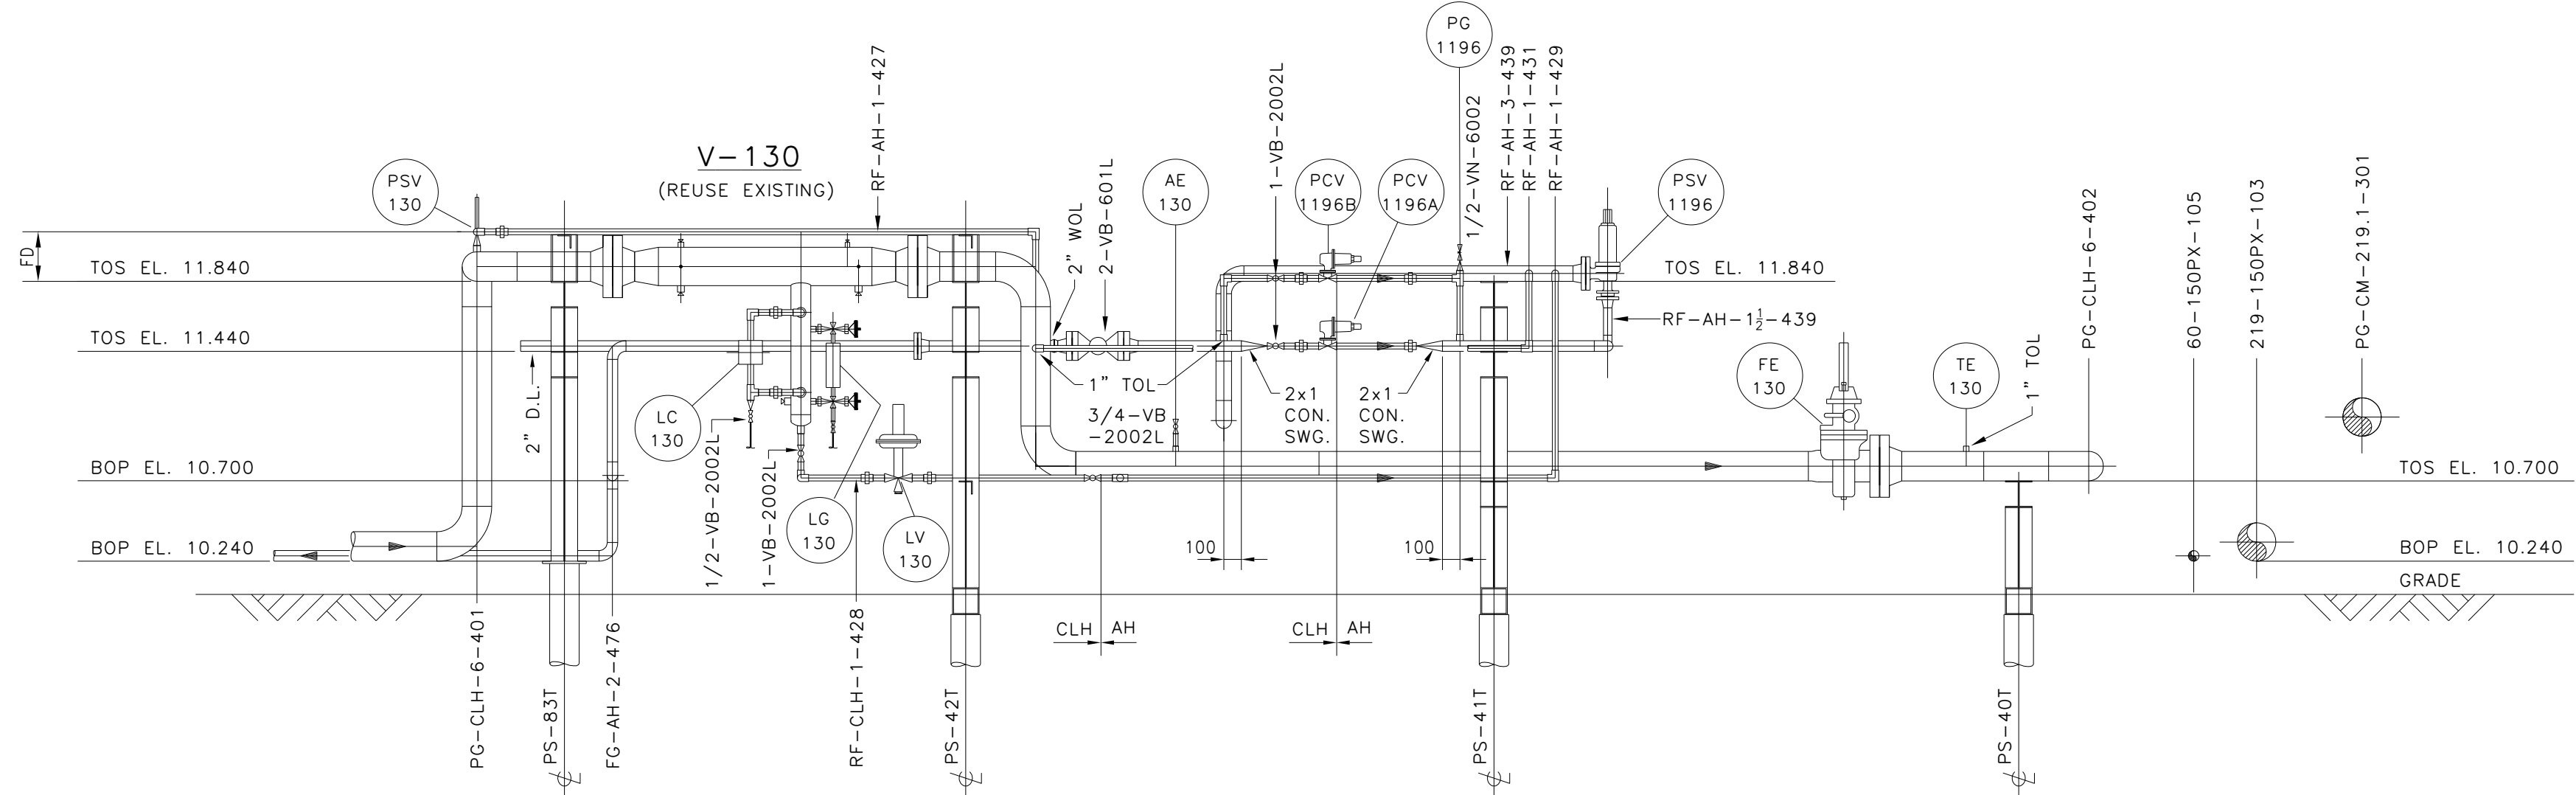

C
SECTION
001

PERMIT TO PRACTICE & PROFESSIONAL ENGINEER STAMPS BY TRIDYNE PROJECTS INC. ARE ON THE 11x17 ISSUED FOR CONSTRUCTION DWG ONLY.

TRIDYNE PROJECTS INC. JOB NO. 1022 AT REV. 3

TRIDYNE PROJECTS INC. JOB NO. 1022 FROM REV.2

TRIDYNE DRAWING NO.:
 TRIDYNE PROJECTS INC. JOB NO. 1009

NUMBER	TITLE	NO.	DATE	DESCRIPTION	BY	APP'D
REFERENCE DRAWINGS						
4	03-06-05	REVISED AS PER FIELD CONTRACTOR MARK-UPS	KT			
3	03-01-15	TRIDYNE JOB 1022: ISSUED FOR CONSTRUCTION	GL			
2	02-12-06	TRIDYNE JOB 1022: HC DEWPOINT PLANT ADDITION	GL			
1	02-05-01	AS-BUILT	VC			
0	02-01-04	ISSUED FOR CONSTRUCTION	GL			
A	01-11-30	ISSUED FOR BID	VC			
REVISIONS						

JOB NO. TRIDYNE # 1009
 DRAWN BY VC
 CHECKED BY JVAZ
 APPROVED BY MFC
 ORIGINATING DEPT.

HUSKY OIL OPERATIONS LTD.
 ROSEVEAR-GALLOWAY COMPRESSOR STATION
 INLET SEPARATOR
 PIPING SECTIONS

Husky Oil
 SCALE 1:30
 DATE 01-11-10 FILE
 DRAWING NO. 2076-11-PM-015 REV. 4