
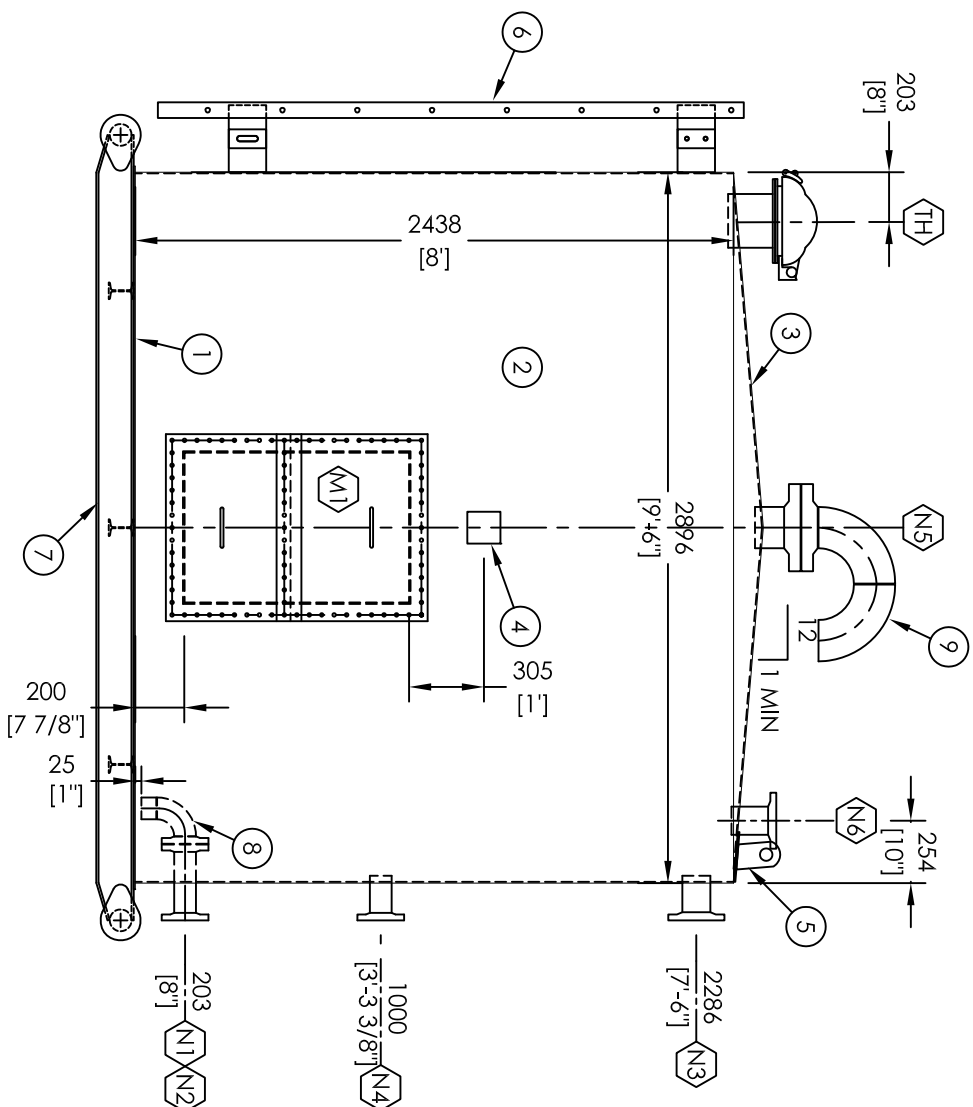


SHIPPING INFORMATION:
HEIGHT: APPROX. 2988mm (9'-9 5/8")
WIDTH: 3006mm (9'-10 3/8")
LENGTH: 3461mm (11'-4 1/4")
WEIGHT: APPROX. 5880 LBS (2671 KG)
SHIPPED LOOSE ITEMS
(11) 6" GOOSENECK c/w BOLTUPS

[illegible]

ELEVATION

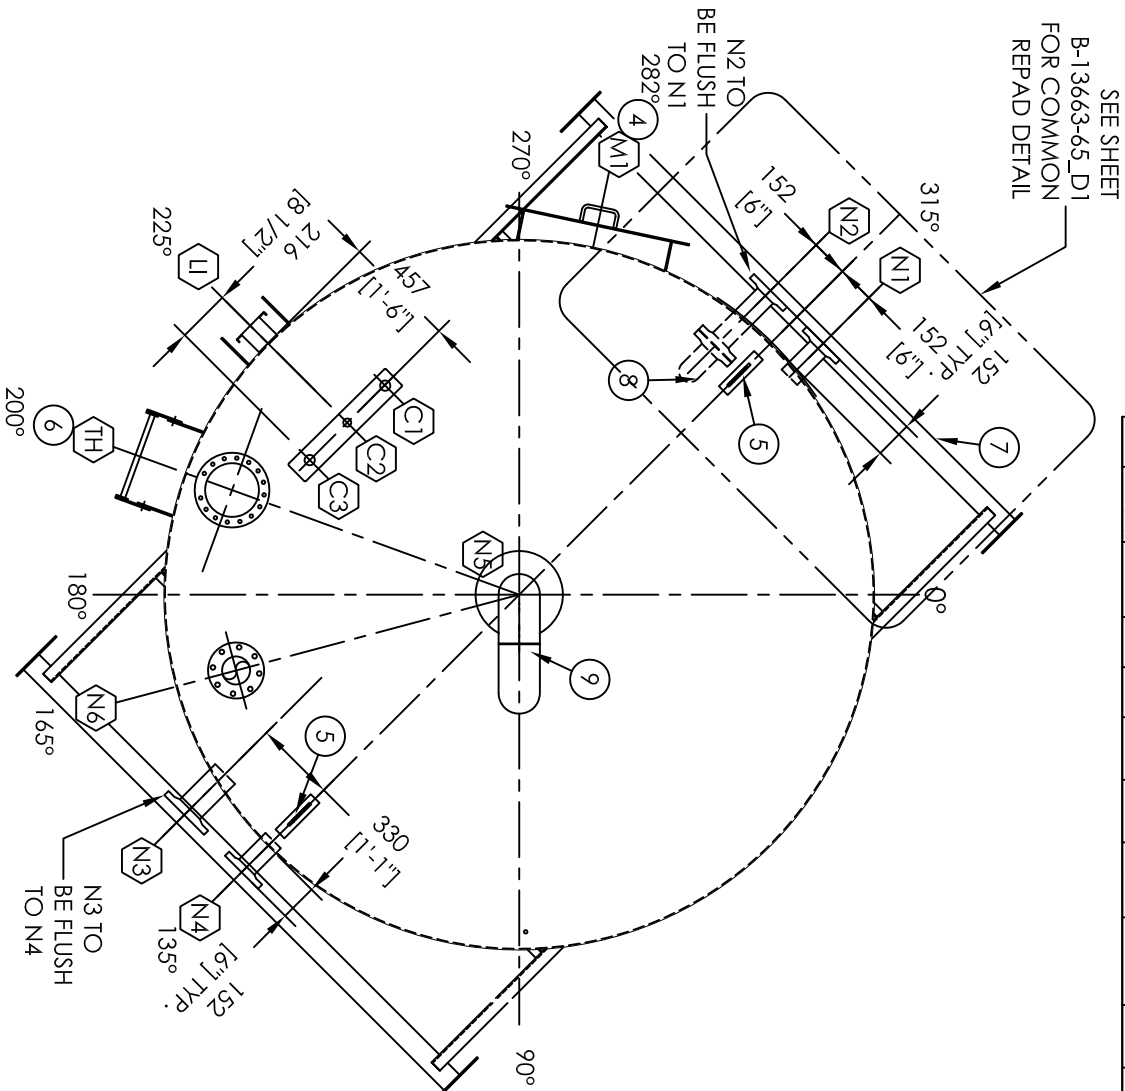

ORIENTATION

TESTING NOTES: 1) TANK TO BE AIR/LEAK TESTED TO 1.5 PSI									
1. INTERNAL FINISH: BLAST: NO INTERNAL FINISH									
2. EXTERNAL FINISH: BLAST: SSPC-SP7 BRUSH BLAST PRIMER: 1.5 - 2.0 MILS DFT OF CLOVERDALE T-101 PRIMER INSULATION: NONE PAINT: 1.5 - 2.0 MILS DFT OF CLOVERDALE (ARGO GREY : CC425 ENAMEL)									
3. EXTERNAL BOTTOM FINISH: BLAST: NO BOTTOM FINISH									
THIRD PARTY INSPECTION: YES									

REVISIONS									
2		AS BUILT	03.24.15	CP					
1	REVISED	GOOSENECK, ADDED N6 AND REORIENTED L1 & TH	12.24.14	CGC					
0		ISSUED FOR FABRICATION	12.02.14	CP					
B		ISSUED FOR APPROVAL	11.12.14	MG					
A		ISSUED FOR REVIEW/MARKUP	10.23.14	CP	CGC				
REV.		DESCRIPTION	DATE	BY	CHK	APP			

CUSTOMER: PO # 8400899432 HUSKY LSD. XX-XX-XXX-XX WXM									
TITLE: ONE (1) 16 CU.M. (100BBL) 2896mm (9'-6") DIA. X 2438mm (8'-0") HIGH 100 BBL BASE SKIDDED STORAGE TANK ORIENTATION DRAWING									
 ARGO SALES LTD		DWG BY: CP		QUOTE #:	TQ14-116B	SCALE:	1:50	CUSTOMER TAG #:	T-100
PROJ. MANAGER: RR		SHEET:	SERIAL #:	DWG TAG:		SHEET:		REV.	
ARGO DRAWING NO.:		B	13663-65	OR		1 of 7			