

62066548

GENERAL NOTES

DESIGN DATA	MATERIAL SPECIFICATIONS	EXTERNAL FINISH	INTERNAL FINISH	TESTING
DESIGN CODE: API 650 MODIFIED DESIGN PRESSURE/VAC: 3.75 oz. PRESS. - 0.4 oz. VAC. SIGN TEMPERATURE: 93°C (200°F) GN SPECIFIC GRAVITY: 1.00 SMIC ZONE: - DESIGN WIND LOAD: 100 MPH DESIGN LIVE ROOF LOAD: 27.5 PSF CORROSION ALLOWANCE: NONE MAXIMUM FILLING HEIGHT: 7315mm (24'-0")	ROOF: G40.21-44W ANNULAR: - SHELL: G40.21-44W FLOOR: G40.21-44W STRUCTURAL: G40.21-44W PIPE: A-53-B FLANGES: A-105	COUPLINGS: A-105 FITTINGS: A-234-WEB STUD BOLTS: A-193-B7 HEX NUTS: A-124-2H GASKETS: GARLOC 7819 HEAT COIL: A-53-B	-SANDBLAST SHELL & ROOF TO SSPC-SP6 & APPLY ONE COAT OF PRIMER AND TWO COATS OF SILVER ENAMEL. -SANDBLAST FLOOR & LOWER 3 FEET OF SHELL TO SSPC-SP5 & COAT WITH 12 TO 15 MILS OF DEVCO 253	-AS PER API 650 LIMITED TO AIR TESTING -AIR TEST TO 1.69" H ₂ O
INSULATION				
-NONE				

NOZZLE SCHEDULE







MK	NO	SIZE	SCH	RATE	TYPE	EXT. PROJ.	REPAD	YES	NO	DESCRIPTION
N2	1	60	2"	STD	ANSI 150 RFSO	152 6"		✓		HEATING COIL INLET (GLYCOL)
N3	1	60	2"	STD	ANSI 150 RFSO	152 6"		✓		HEATING COIL OUTLET (GLYCOL)
N4	1	114	4"	STD	ANSI 150 RFWN	203 8"		✓		LOAD LINE
N5	1	114	4"	STD	ANSI 150 RFWN	191 1 1/2"		✓		
N6	1	89	3"	STD	ANSI 150 RFWN	152 6"		✓		DRAIN C/W DOWNCOMER TO 4"
N7	1	89	3"	STD	ANSI 150 RFWN	152 6"		✓		HUSKY DIVERTER C/W INTERNAL PIPING
N8	1	219	8"	STD	ANSI 150 RFWN	203 8"		✓		C/W INTERNAL ELBOW UP
N9	1	89	3"	STD	ANSI 150 RFWN	152 6"		✓		CAN-OXY RECYCLE
N10	1	219	8"	STD	ANSI 150 RFWN	235 1 1/2"		✓		
N12	1	114	4"	STD	ANSI 150 RFWN	203 8"		✓		DRAIN
N13	1	219	8"	STD	ANSI 150 RFWN	203 8"		✓		EQUALIZER C/W INTERNAL PIPING
N14	1	168	6"	STD	ANSI 150 RFWN	203 8"		✓		
N15	1	60	2"	STD	ANSI 150 RFWN	203 8"		✓		VENT GAS
C1	1	51	2"	-	3000# FULL CPLG	HALF		✓		LEVEL GAUGE
C1	2	32	1 1/4"	-	3000# FULL CPLG	HALF		✓		LEVEL GAUGE GUIDE WIRES
C3	1	51	2"	-	3000# FULL CPLG	FULL		✓		PROBE
C4	1	13	1/2"	-	3000# FULL CPLG	FULL		✓		TI
C5	1	6	25	1"	-	3000# FULL CPLG	HALF	✓		SAMPLERS
C6	1	25	1"	-	3000# FULL CPLG	HALF		✓		BLANKET GAS SUPPLY
T1	1	219	8"	-	ENARDO 330	152 6"		✓		THIEF HATCH 4 oz. PRESSURE AND 0.4 oz. VACUUM
M1	1	2' x 4'	-	-	API FAB'D	102 4"		✓		SHELL MANWAY

MATERIAL LIST

MK	QTY.	DESCRIPTION	REFERENCE	WT.
A	-	FLOOR PLATE 1/4" THK. x 30'-4" DIA.	REF. DWG T-10285-D102	7378
B	-	ROOF PLATE 3/16" THK. x 30'-1 3/4" FLAT DIA.	REF. DWG T-10285-D102	5467
C	6	SHELL PLATE 3/16" THK. x 8'-0" x 32'-0" LG.	G40.21-44W	11766
D	3	SHELL PLATE 3/16" THK. x 8'-0" x 30'-2 3/8" LG.	G40.21-44W	5552
E	1	RUNAROUND ANGLE 2' x 2' x 1/4" x 94'-9 1/4" LG.	G40.21-44W	231
F	1	SHELL MANWAY 2' x 4' c/w 3/16" COVER PLATE	REF. DWG EDS-2605	302
G	1	NAMEPLATE	-	5
H	1	REPAD FOR 2' x 4' MANWAY - 3/16" THK.	REF. DWG EDS-2211	43
I	1	LADDER 28'-4" HIGH	REF. DWG EDS-4003	
J	1	HEAT COIL DETAIL (28'-0" Ø DIAMETER)	REF. DWG T-10285-D105	
K	1	ROOF PLATFORM 3'-0" x 3'-0"	REF. DWG T-10285-D106	
L	1	THIEF HATCH NOZZLE C/W ENARDO 330 SET Ø 4 oz. PRESS. & 0.4 oz. VAC.	REF. DWG EDS-2101	13
M				
N	1	HAWKEYE LEVEL INDICATOR ASSY C/W PLASTIC FLOAT, METRIC BOARD AND MOUNTING ACCESSORIES	-	100
O				
P				
Q				
R	15	INTERNAL ROOF RAFTERS C4 X 5.4#	REF. DWG T-10285-D104	1053
S	1	CENTER POLE - 6" SCH. STD.	REF. DWG T-10285-D104	836
T				
U				
V				
W				
X				
Y				
Z				

- NOTE:
- ALL FLANGE RATINGS TO BE ASME/ANSI B16.5 - 1988, ADDENDA B16.5a-1992.
 - DRILL AND TAP 1/4" DIA. TELLTALE HOLE IN REINFORCING PADS.
 - FLANGE AND BOLT HOLES TO STRADDLE PRINCIPAL CENTERLINES OF TANK.
 - INSIDE EDGES OF NOZZLE NECKS, INSPECTION OPENINGS AND MANWAYS SHALL BE ROUNDED TO A RADIUS OF 1/8" MIN. OR ONE HALF THE WALL THICKNESS IF THE PIPE WALL IS LESS THAN 1/4".
 - ALL DIMENSIONS ARE IN MILLIMETERS. DIMENSIONS IN BRACKETS ARE FOR REFERENCE ONLY.
 - TAG ALL PIECES WITH JOB NO.
 - ALL NOZZLE PROJECTIONS GIVEN ARE ALONG THE NOZZLE CENTERLINE.
 - NOZZLES TO BE FIELD INSTALLED. (RIVERHILL ENTERPRISES)

SUB-TOTAL 32803
X 1.06
TOTAL 34771 lbs.

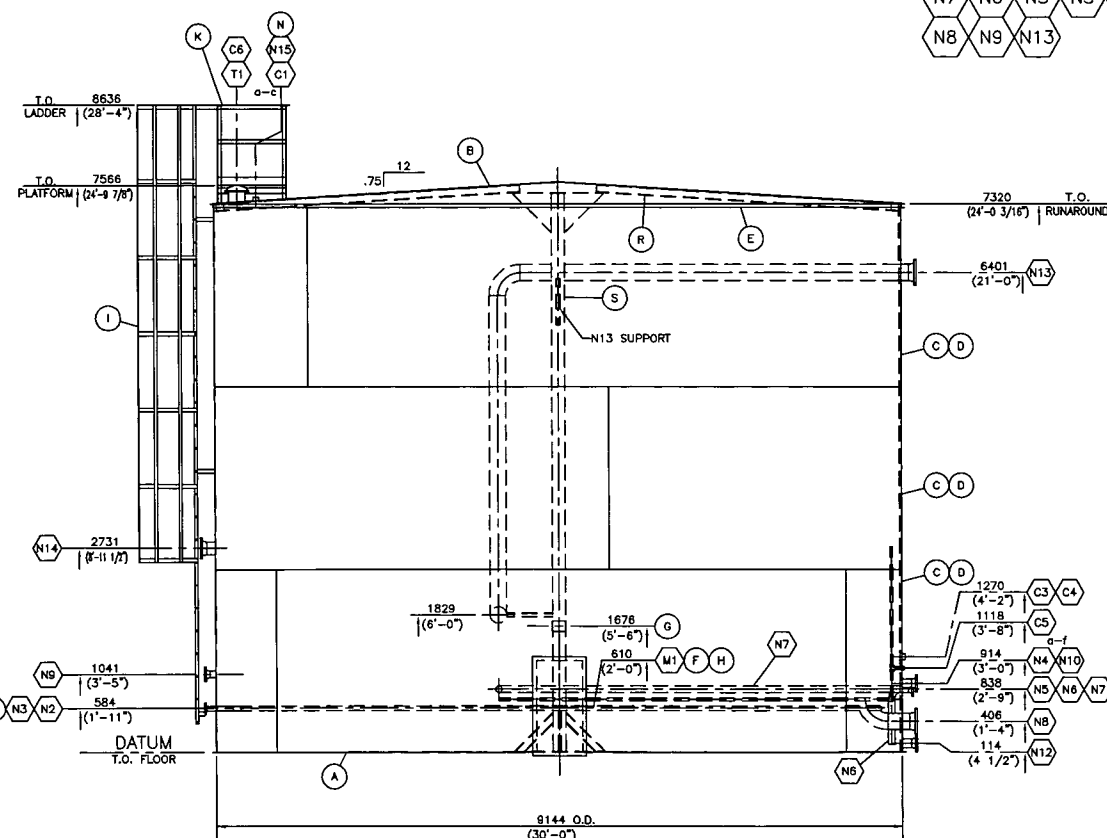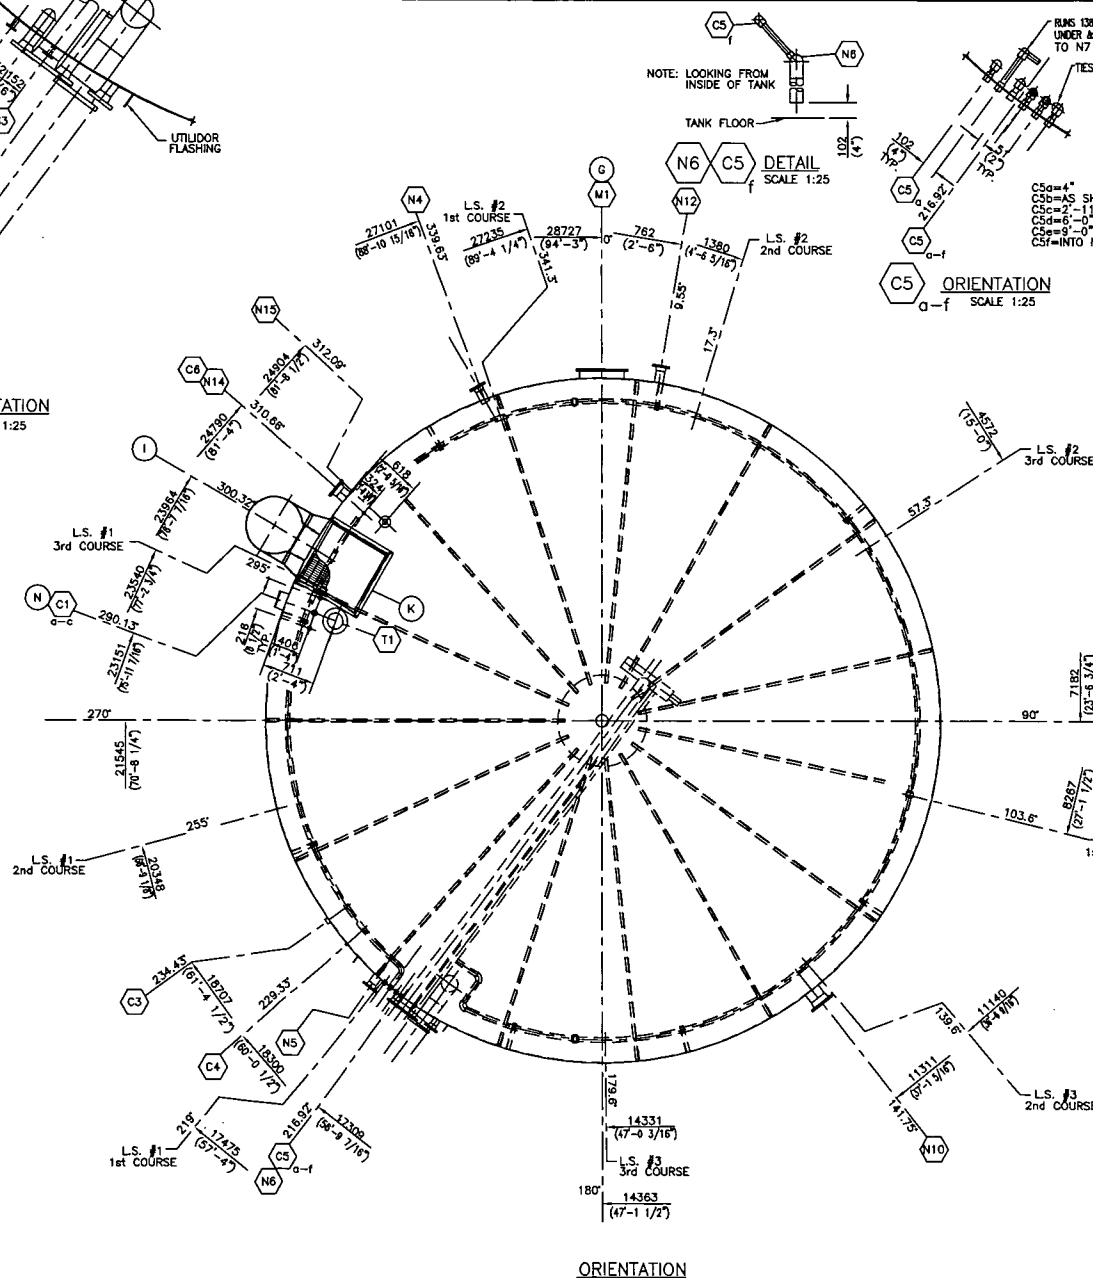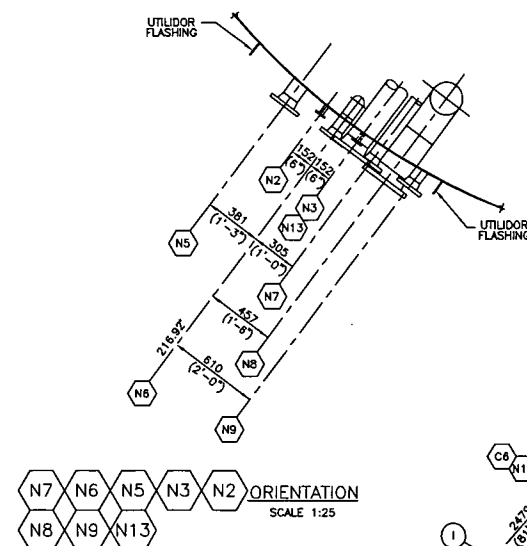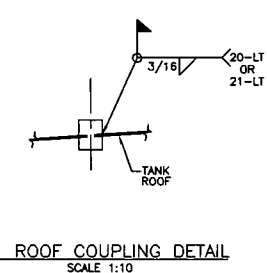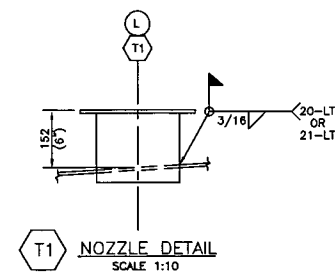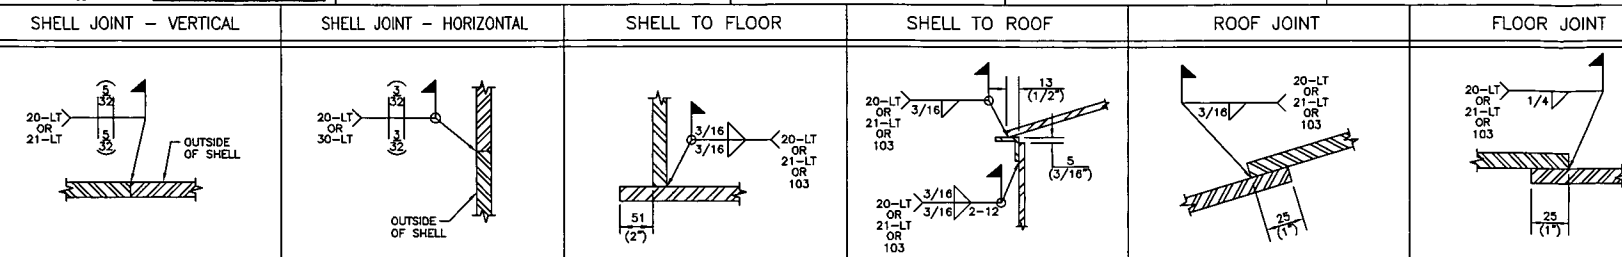

NO	DATE	REVISIONS	BY	APP
15/08/97	AS-BUILT		ALS	
29/05/97	ISSUED FOR CUSTOMER APPROVAL		ALS	JK

THIS DRAWING IS THE PROPERTY OF UNIVERSAL INDUSTRIES LTD. AND IS TO BE USED ONLY IN CONJUNCTION WITH PERFORMANCE OF WORK BY UNIVERSAL INDUSTRIES LTD.. REPRODUCTION OR USE OF IN WHOLE OR IN PART FOR ANY OTHER PURPOSE IS EXPRESSLY FORBIDDEN.

UNIVERSAL INDUSTRIES LTD. LLOYDMINSTER, AB.

CLIENT: CANADIAN OCCIDENTAL PETROLEUM MORGAN BATTERY ISLAY, AB.

DWG. TITLE: STORAGE TANK - EAST TANK GENERAL ARRANGEMENT

SIZE: 9144mm O.D. x 7320mm HIGH (30'-0" O.D. x 24'-0 3/16" HIGH)	VOLUME: 477 CUBIC METERS (3000 Bbl)
SCALE: 1:50	DWG. NO. T-10285-D101
DATE: 28/05/97	CHK'D: A. SMITHSON
	APP: 1 OF 1

COPYRIGHT © DWG 610285/10110285