


THE INFORMATION AND DATA CONTAINED IN THIS DRAWING IS CONFIDENTIAL, PROPRIETARY IN NATURE AND SUBJECT TO COPYRIGHT, AND MAY NOT BE REPRODUCED, COPIED, MIMICED, ADAPTED, OR USED IN ANY FORM WITHOUT THE WRITTEN PERMISSION OF CONOCO-PHILLIPS CANADA.

A
B
C
D
E
F
G
H
I
J
K




8

1 2 3 4 5 6 7 9 10 11 12 13 14 15

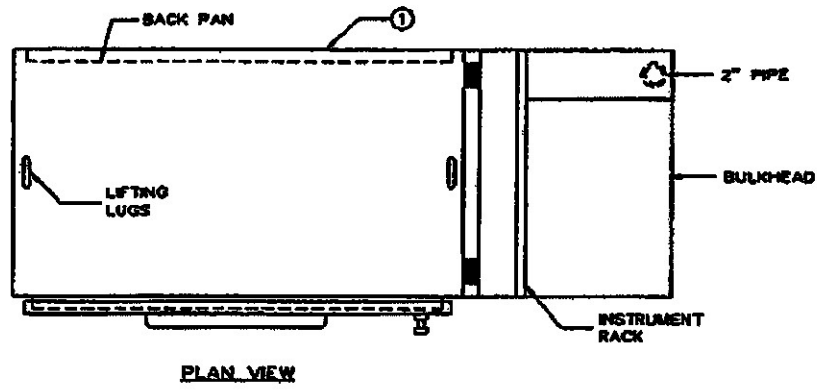

BILL OF MATERIALS	
ITEM	DESCRIPTION
1	ENCLOSURE 36" W X 60" H X 20" D, PAINTED BLACK C/W INSTRUMENT RACK, BACK MOUNTING PAN, DOOR & LIFTING LUGS.
2	ALLEN BRADLEY MOMENTARY ACTION PUSHBUTTON (RED), MODEL# 800CM-G4, C/W GUARD; 1 N.C. CONTACT BLOCK, MODEL# 800E-2X01 & BASE PLATE, MODEL# 800E-A3.
3	LAMACORD TAG, WHITE BACKGROUND WITH RED LETTERS, AS PER NAMEPLATE ENGRAVING SCHEDULE.
4	ALLEN BRADLEY TOUCHSCREEN INTERFACE "PANELVIEW 1000", 24VDC, 1.1AMP, CAT.# 2711-T10C1B1 C/W RS-232/DT CONNECTION.

NAMEPLATE ENGRAVING		
TAG/ID	FIRST LINE	SECOND LINE
A 3	COMPRESSOR	QUICK STOP
B	CAUTION MAKE CERTAIN AREA IS NON HAZARDOUS BEFORE SERVICING PANEL	

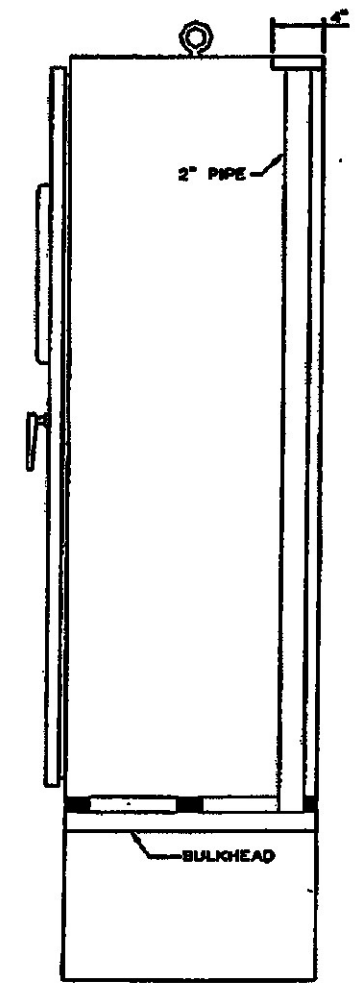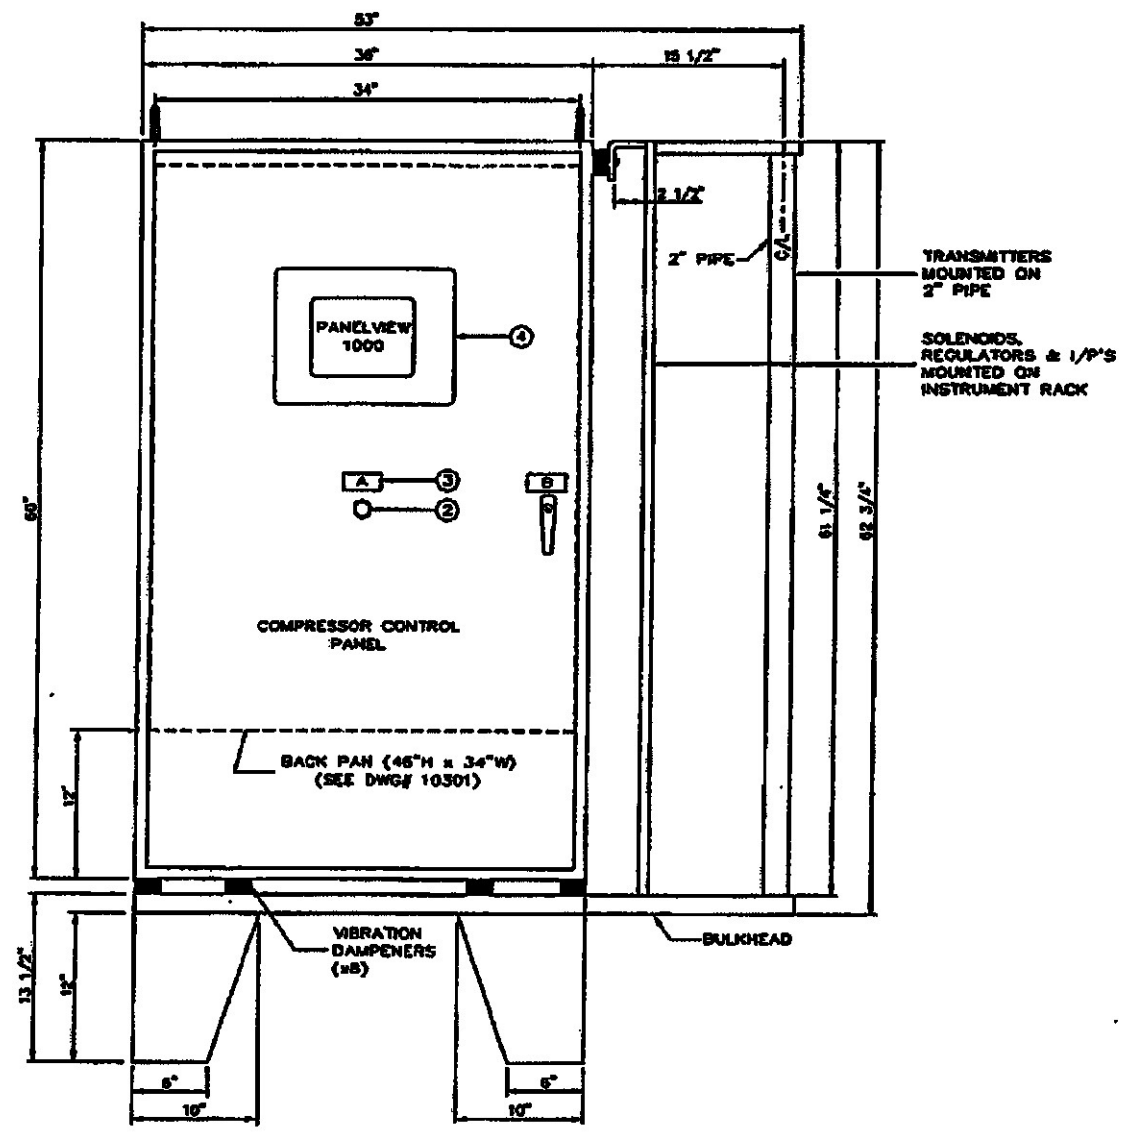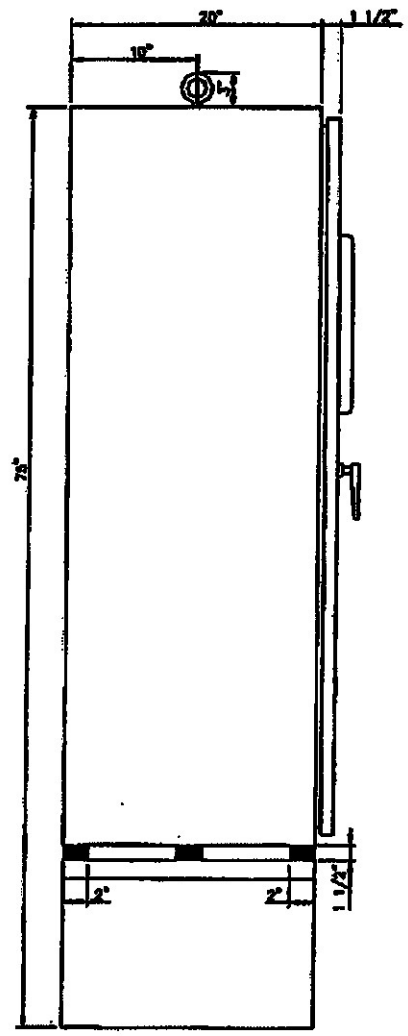

REFERENCE DRAWINGS	
DWG No.	TITLE

PROJECT VERSION (Clear cell info prior to returning to CPC)									
VER.	DATE	BY	CHK'D DFTG	CHK'D ENG	APP'D PM	VERSION ISSUE			

REVISIONS									
REV.	DATE	BY	CHK'D DFTG	CHK'D ENG	APP'D PM	REVISION ISSUE			
1	10/05/20	G.O.	G.O.	G.O.	C.T.	TRANSFERED FROM PROLOGIC CONTROLS UNIVERSAL UNIT 023212 (STEL 10-028)			
2	10/05/27	G.O.	G.O.	G.O.	C.T.	K-106 COMP PANEL SWAP - I.F.C. (STEL 10-028)			
3	10/06/04	M.H.	G.O.	G.O.	C.T.	AS BUILT			

ENGINEERING SEAL

PREPARED BY
ConocoPhillips
Canada

PERMIT

ConocoPhillips
Canada

BRASSEY CENTRAL FACILITIES
K-106 COMPRESSOR CONTROL PANEL
OVERALL VIEW AND LAYOUT

LEGAL DESC. FROM:
d-13-F/93-P-10

LEGAL DESC. TO (IF APPL.):

LEGACY DWG NO.:
10300

SCALE:
N.T.S.

CPC DWG. NO.:
BSY-001-ELE-006-0004

REV.:
3

ENG. CO. PROJ. NO.:
10028

DATE:
10.05.20