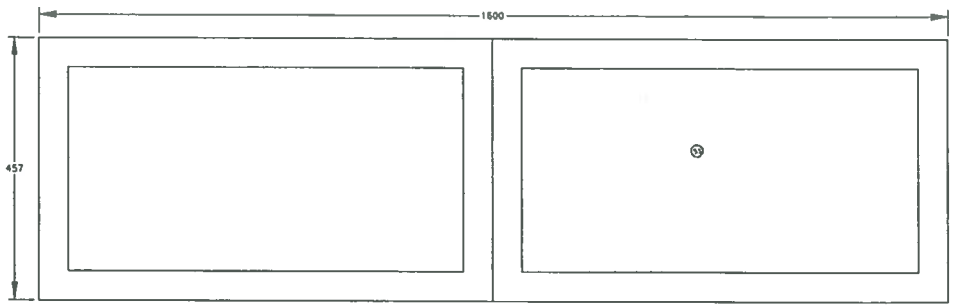

Note: Cutouts on bottom of top hat are to be aligned with all vertical panduits

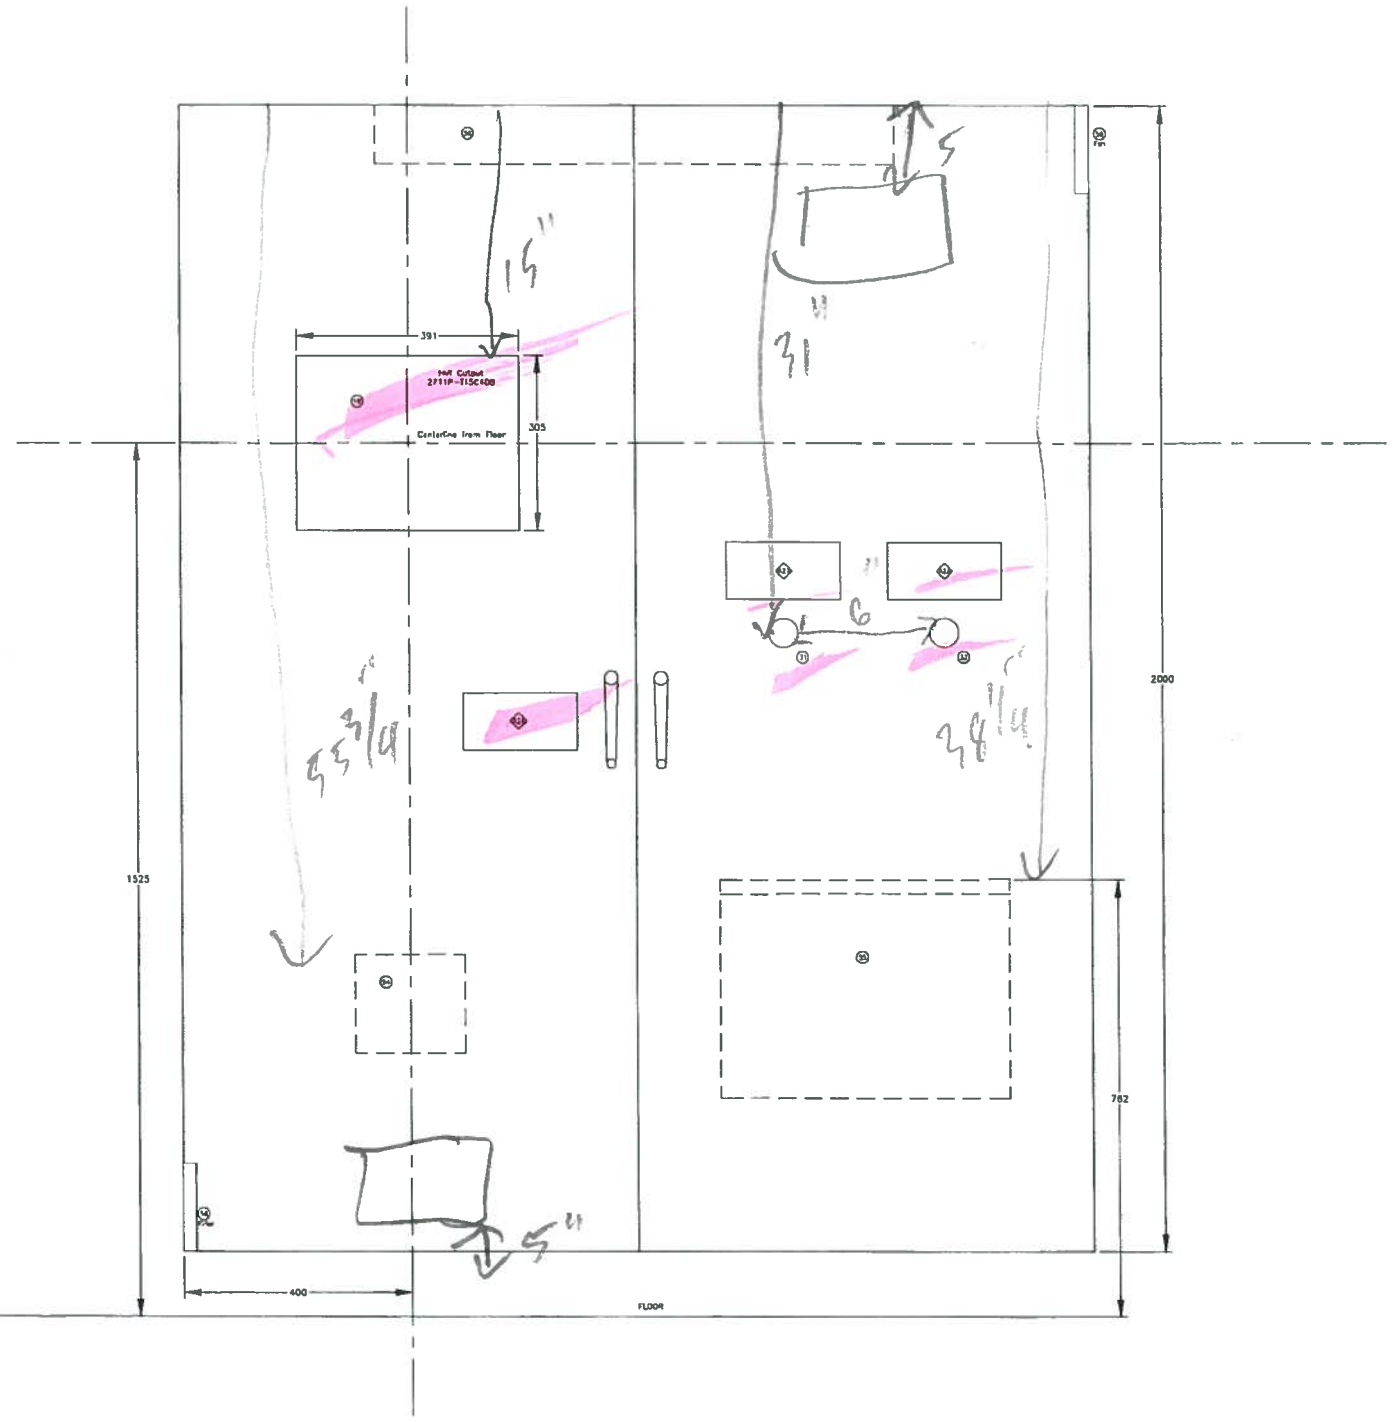

SHOP COPY

PFX13250 Dec-12

DRAWING#	REFERENCE DRAWING TITLE

REV	DATE	DESCRIPTION	DWN	CHKD	APPR
A	22JUL2013	ISSUED FOR REVIEW	RR	CF	--
B	08OCT2013	ISSUED FOR APPROVAL	R.R	MG	MG
0	21OCT2013	ISSUED FOR CONSTRUCTION	R.R	MG	MG

ENGINEER STAMP

PROFESSIONAL ENGINEER — PROVINCE OF BRITISH COLUMBIA — M. A. GHALY # 38913

OCT 24 2013

THIS DRAWING IS THE PROPERTY OF PENN WEST ENERGY TRUST AND ANY REPRODUCTION IN WHOLE OR PART WITHOUT EXPRESS WRITTEN PERMISSION IS PROHIBITED.

PIONEER ENGINEERING INC.

THIRD PARTY LOGO

SCALE	AS SHOWN	SIZE: D
EPCM PROJECT#: 13053		

PennWest Exploration

CORDOVA – MULTI WELL TIE–IN
PENN WEST WELLSITE
d–055–A/094–P–10
Control Panel Layout

DWG#	d055A094P10-ELC-3401	SHT 2 OF 3	REV	0

Note: Cutouts on top of panel are to be aligned with all vertical panduits

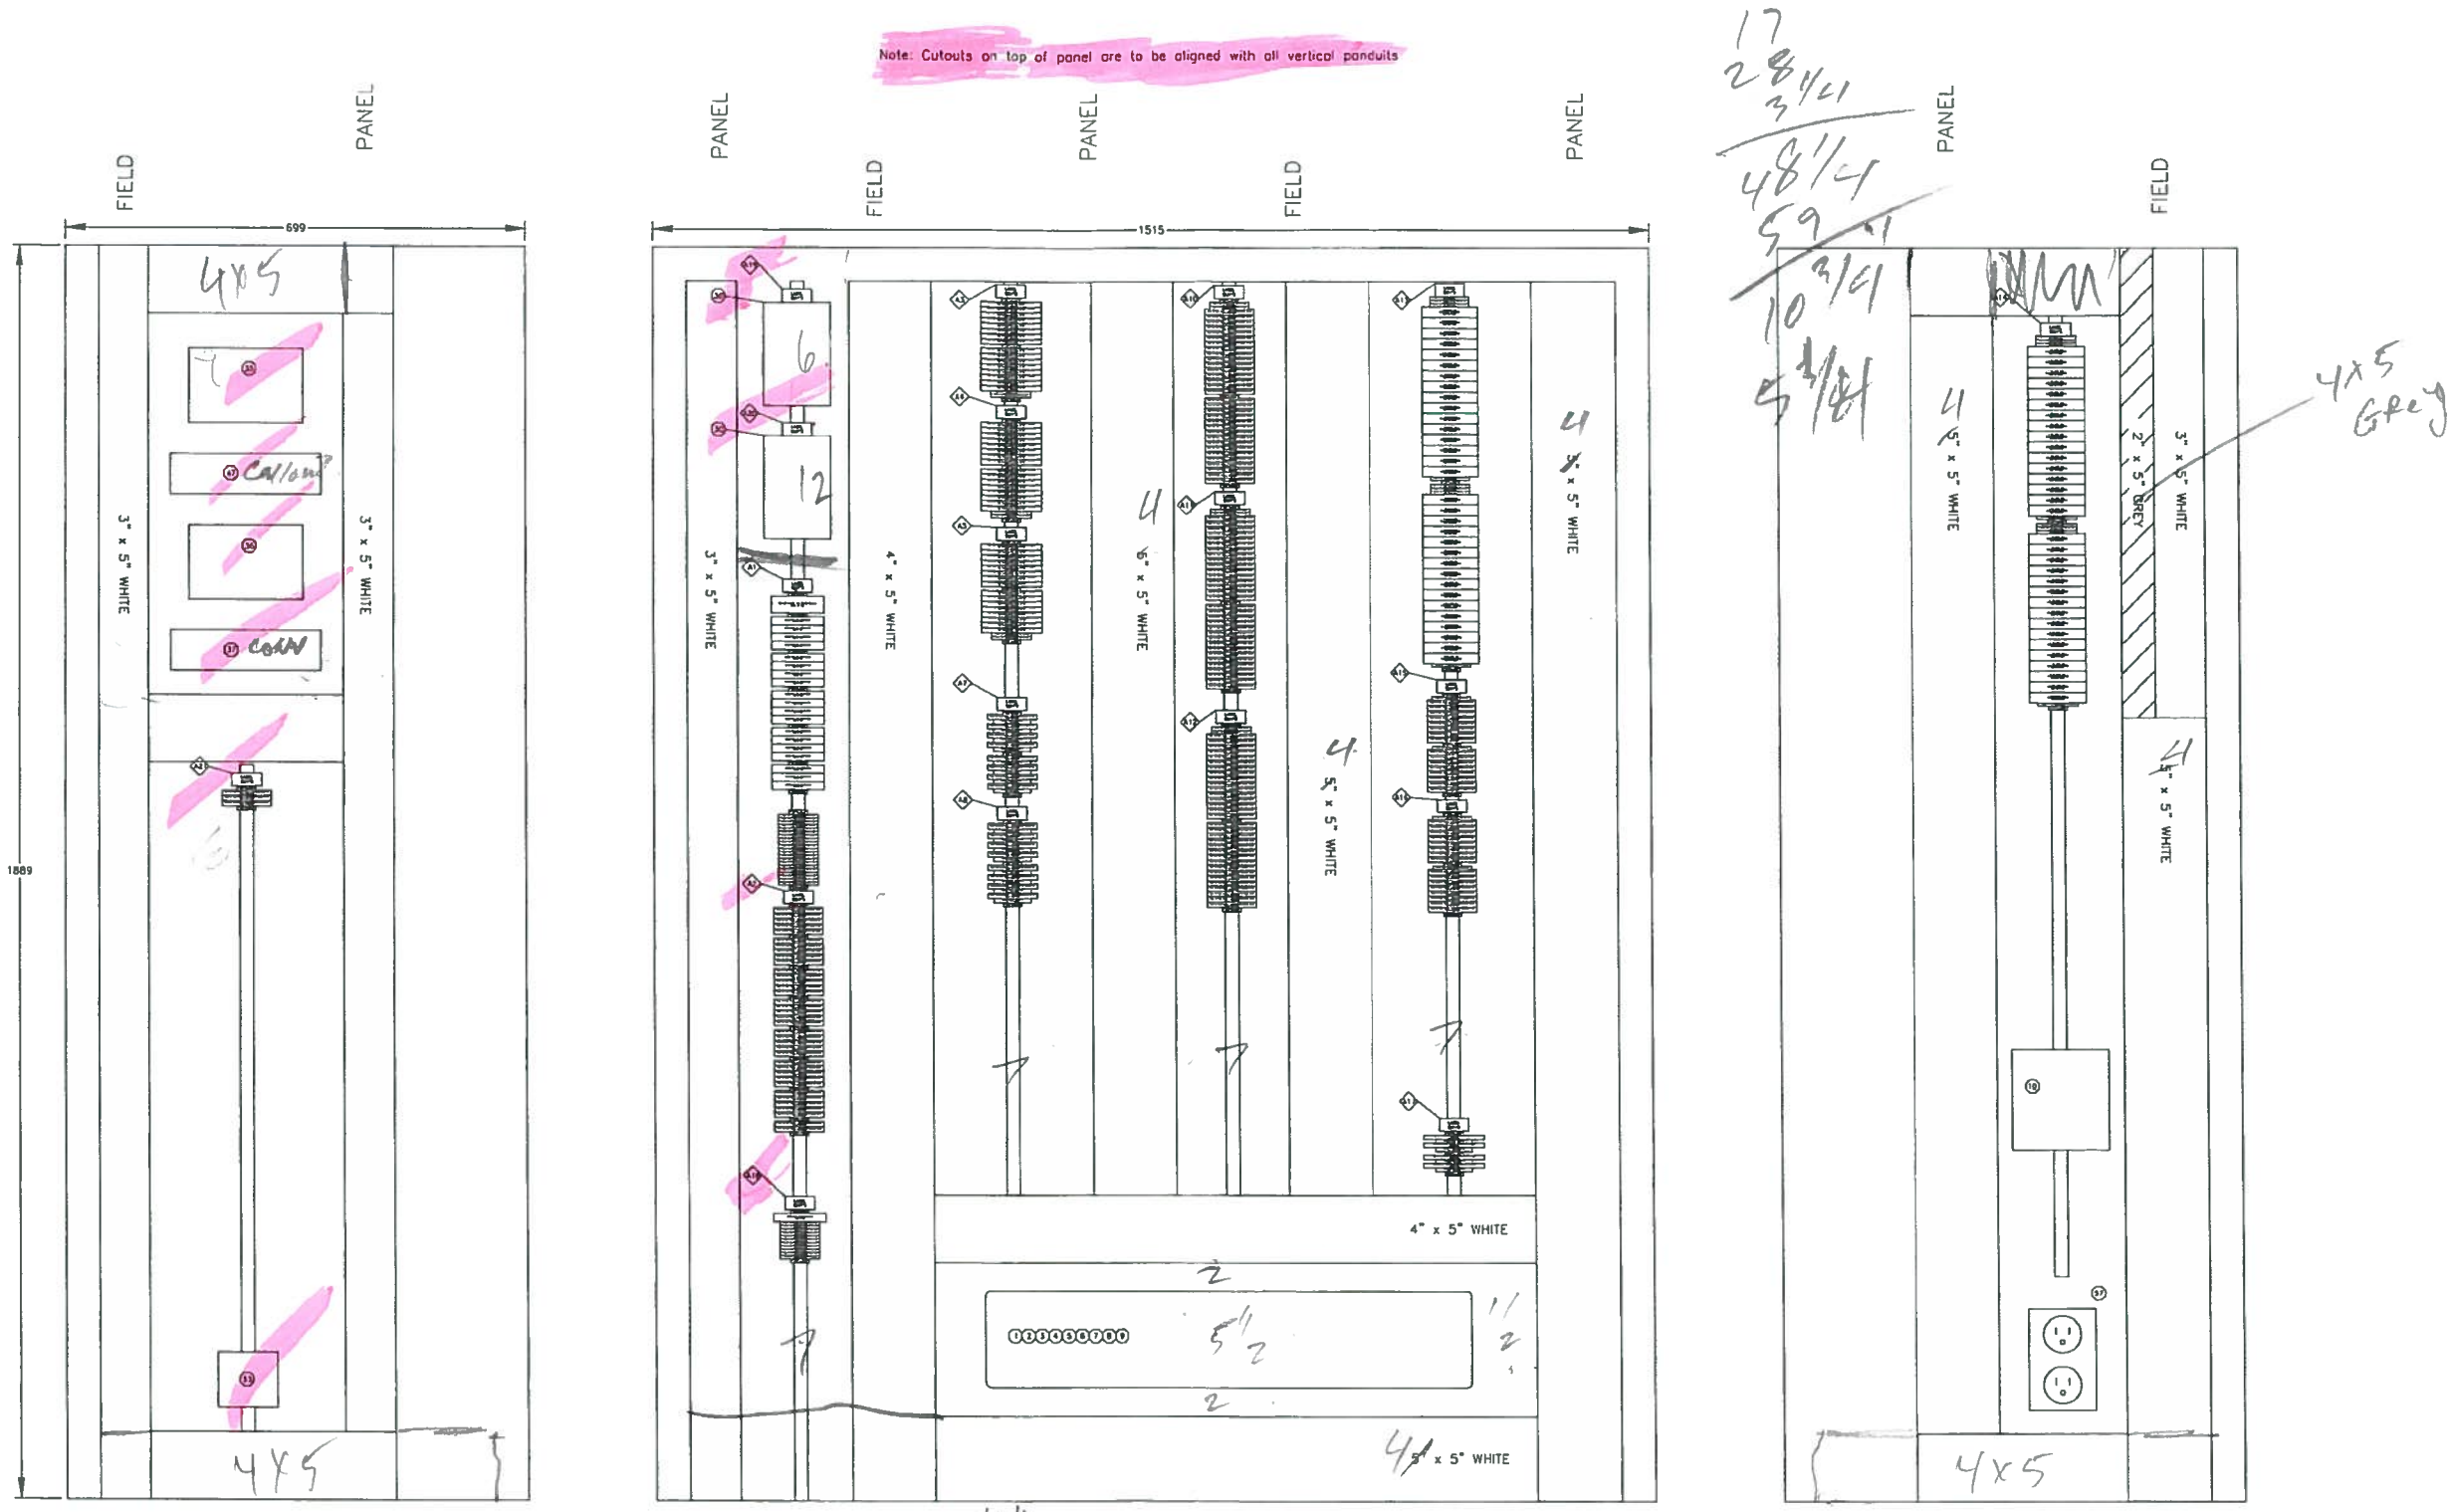

DRAWING#	REFERENCE DRAWING TITLE

REV	DATE	DESCRIPTION	DWN	CHKD	APPR
A	22JUL2013	ISSUED FOR REVIEW	RR	CF	–
B	08OCT2013	ISSUED FOR APPROVAL	R.R	MG	MG
0	21OCT2013	ISSUED FOR CONSTRUCTION	R.R	MG	MG

ENGINEER STAMP

PROFESSIONAL ENGINEER — PROVINCE OF BRITISH COLUMBIA — M. A. GHALY # 38913

OCT 2 4 2013

THIS DRAWING IS THE PROPERTY OF PENN WEST ENERGY TRUST AND ANY REPRODUCTION IN WHOLE OR PART WITHOUT EXPRESS WRITTEN PERMISSION IS PROHIBITED.

PIONEER ENGINEERING INC.

THIRD PARTY LOGO

SCALE	AS SHOWN	SIZE: D
EPCM PROJECT#: 13053		

PennWest Exploration

CORDOVA – MULTI WELL TIE-IN
PENN WEST WELLSITE
d-055-A/094-P-10
Control Panel Layout

DWG# d055A094P10-ELC-3400 | SHT 1 OF 3 | REV 0

(99)

Bill Of Materials

Item	Qty	Description	Mfr	CAT#	Supplier
1	1	PLC Processor	AB	1756-L72	Owner
2	1	PLC Power Supply	AB	1756-PB75	Owner
3	1	PLC Rack	AB	1756-A17	Owner
4	3	PLC Input Card	AB	1756-IB32	Owner
5	2	PLC Output Card	AB	1756-OB32	Owner
6	2	PLC Relay Output Card	AB	1756-OW16I	Owner
7	3	PLC Analog Input Card	AB	1756-IF16	Owner
8	2	PLC Analog Output Card	AB	1756-OF8	Owner
9	1	PLC Communications Card	AB	1756-EN2T	Owner
10	1	Ethernet Switch	Stratix	1783-RMS10T	Owner
11	1	HMI	AB	2711P-T15C4D8	Owner
12	2	PLC BLANK FILLERS	AB	1756-N2	Owner
13	1	Prosoft Modbus Card	Prosoft	MVI56E-MCM	Owner
14	0				
15	0				
16	0				
17	TBD	Fuse Indication c/w Feed Through - KDKS1EN	Weidmuller	2147483647	Vendor
18	TBD	Label - SCHT5	Weidmuller	1631930000	Vendor
19	TBD	End Bracket - WEW 35/2	Weidmuller	1061200000	Vendor
20	64	1 Pole 24VDC Relay	Omron	G2R-1-SND-24VDC	Vendor
21	64	1 Pole 24VDC Relay Base	Omron	P2RF-05-E	Vendor
22	0	Single Disconnect - WTR 2.5	Weidmuller	1855610000	Vendor
23	TBD	Ground Terminal - WPE4	Weidmuller	1010100000	Vendor
24	TBD	Double Disconnect - WDTR 2.5	Weidmuller	2147483647	Vendor
25	TBD	Fused with Feed Through KDKS1EN/SMT10-60VUC BFI H-	Weidmuller	2147483647	Vendor
26	0	DC Blown Fuse Indication - KDKS 1PE/LD	Weidmuller	9158330001	Vendor
27	TBD	Circuit breaker	Weidmuller	CB4200Series	Vendor
28	TBD	Regular Feed Through Terminal - WDU 2.5	Weidmuller	1020000000	Vendor
29	As Req	Wireway	Open	-	Vendor
30	2	3 Pole Power Distribution Block	Mersen	67593	Vendor
31	1	Pushbutton - 1NO 1NC Push-Pull Mushroom Red Button c/w Guard	AB	800T-FX6D4 800T-N129	Vendor
32	1	Pushbutton - Green c/w NO Contacts	AB	800T-A2A2	Vendor
33	1	Spare Fuse Holder c/w 10 of Each Fuse Size	Open		Vendor
34					
35	1	Ethernet Radio	MDS	iNet2	Owner
36	1	UHF Base Radio	Motorola	CDM750	Owner
37	1	24-12VDC Converter	Open	~~10~~ Amp 20	Owner
38					
39					
40	0	ROC827 Series 2 c/w Ethernet	Emerson		Owner
41	0	ROC Expander Rack	Emerson	EXP	Owner
42	0	ROC 24VDC Power Supply	Emerson	PM-24	Owner
43	0	ROC Advanced Pulse Module	Emerson		Owner
44	0	ROC MVS	Emerson		Owner
45	0	ROC RS485	Emerson		Owner
46	0	ROC Analog Output	Emerson		Owner
47	1	Callout Main Module	Barnett	B1290	Owner
48	0				Owner
49	0				Owner
50	1	Cabinet - 1600mmWx2000mmHx800mmD	Rittal	8901410	Vendor
51	1	Backpan - 1515mmWx1900mmH	Rittal		Vendor
52	2	Sidepan - 700mmWx1900mmH	Rittal		Vendor
53	1	Top Hat - 1600mmW x 457mmH	Open		Vendor
54	1	Drawing Packet	Open		Vendor
55	1	Fold Down Table	Open		Vendor
56	1	Flourescent Light c/w Door Switch	Open		Vendor
57	1	GFIC Receptacle	Open		Vendor
58	1	Fan c/w Filter	Open		Vendor

A99

Nameplate Schedule

Qty	Item	Color	Description	Size
1	A1	Black On White	24VDC DISTRIBUTION	44.5x9.5
1	A2	Black On White	24VDC DISTRIBUTION	44.5x9.5
1	A3	Black On White	SLOT2 IF16	44.5x9.5
1	A4	Black On White	SLOT3 IF16	44.5x9.5
1	A5	Black On White	SLOT4 IF16	44.5x9.5
0	A6	Black On White		44.5x9.5
1	A7	Black On White	SLOT6 OF8	44.5x9.5
1	A8	Black On White	SLOT7 OF8	44.5x9.5
0	A9	Black On White		44.5x9.5
1	A10	Black On White	SLOT9 IB32	44.5x9.5
1	A11	Black On White	SLOT10 IB32	44.5x9.5
1	A12	Black On White	SLOT11 IB32	44.5x9.5
1	A13	Black On White	SLOT 12 OB32	44.5x9.5
1	A14	Black On White	SLOT13 OB32	44.5x9.5
1	A15	Black On White	SLOT14 OW16	44.5x9.5
1	A16	Black On White	SLOT15 OW16	44.5x9.5
1	A17	Black On White	SLOT16 MODBUS	44.5x9.5
1	A18	Black On White	MANUAL ESD	44.5x9.5
1	A19	Black On White	+24VDC POWER BLOCK	44.5x9.5
1	A20	Black On White	-24VDC POWER BLOCK	44.5x9.5
1	A21	Black On White	12VDC DISTRIBUTION	44.5x9.5
1	A22	Black On White		44.5x9.5
0	A23	Black On White		44.5x9.5
0	A24	Black On White		44.5x9.5
0	A25	Black On White		44.5x9.5
0	A26	White On Red	DANGER AUTHORIZED PERSONNEL ONLY MORE THAN ONE VOLTAGE SOURCE	~~100x200~~ 2x4
0	A27	White On Red	MANUAL ESD	~~100x200~~ 2x4
0	A28	Black On White	MANUAL ESD RESET	~~100x200~~ 1x4
0	A29			100x200

WIRE COLOR	
DESCRIPTION	COLOR
DIGITAL INPUT&OUTPUT	ORANGE
ANALOG INPUT	PURPLE
DC+	RED
DC-	BLUE
ANALOG OUTPUT	1 PAIR BELDEN

DRAWING#	REFERENCE DRAWING TITLE

REV	DATE	DESCRIPTION	DWN	CHKD	APPR
A	22JUL2013	ISSUED FOR REVIEW	RR	CF	-
B	08OCT2013	ISSUED FOR APPROVAL	R.R	MG	MG
0	21OCT2013	ISSUED FOR CONSTRUCTION	R.R	MG	MG

ENGINEER STAMP

PROFESSIONAL ENGINEER PROVINCE OF BRITISH COLUMBIA M. A. GHALY # 38913

OCT 24 2013

THIS DRAWING IS THE PROPERTY OF PENN WEST ENERGY TRUST AND ANY REPRODUCTION IN WHOLE OR PART WITHOUT EXPRESS WRITTEN PERMISSION IS PROHIBITED.

PIONEER ENGINEERING INC.

THIRD PARTY LOGO

SCALE: AS SHOWN | SIZE: D

EPCM PROJECT#: 13053

PennWest Exploration

CORDOVA - MULTI WELL TIE-IN
PENN WEST WELLSITE
d-055-A/094-P-10
Control Panel Layout

DWG# d055A094P10-ELC-3402 | SHT 3 OF 3 | REV 0

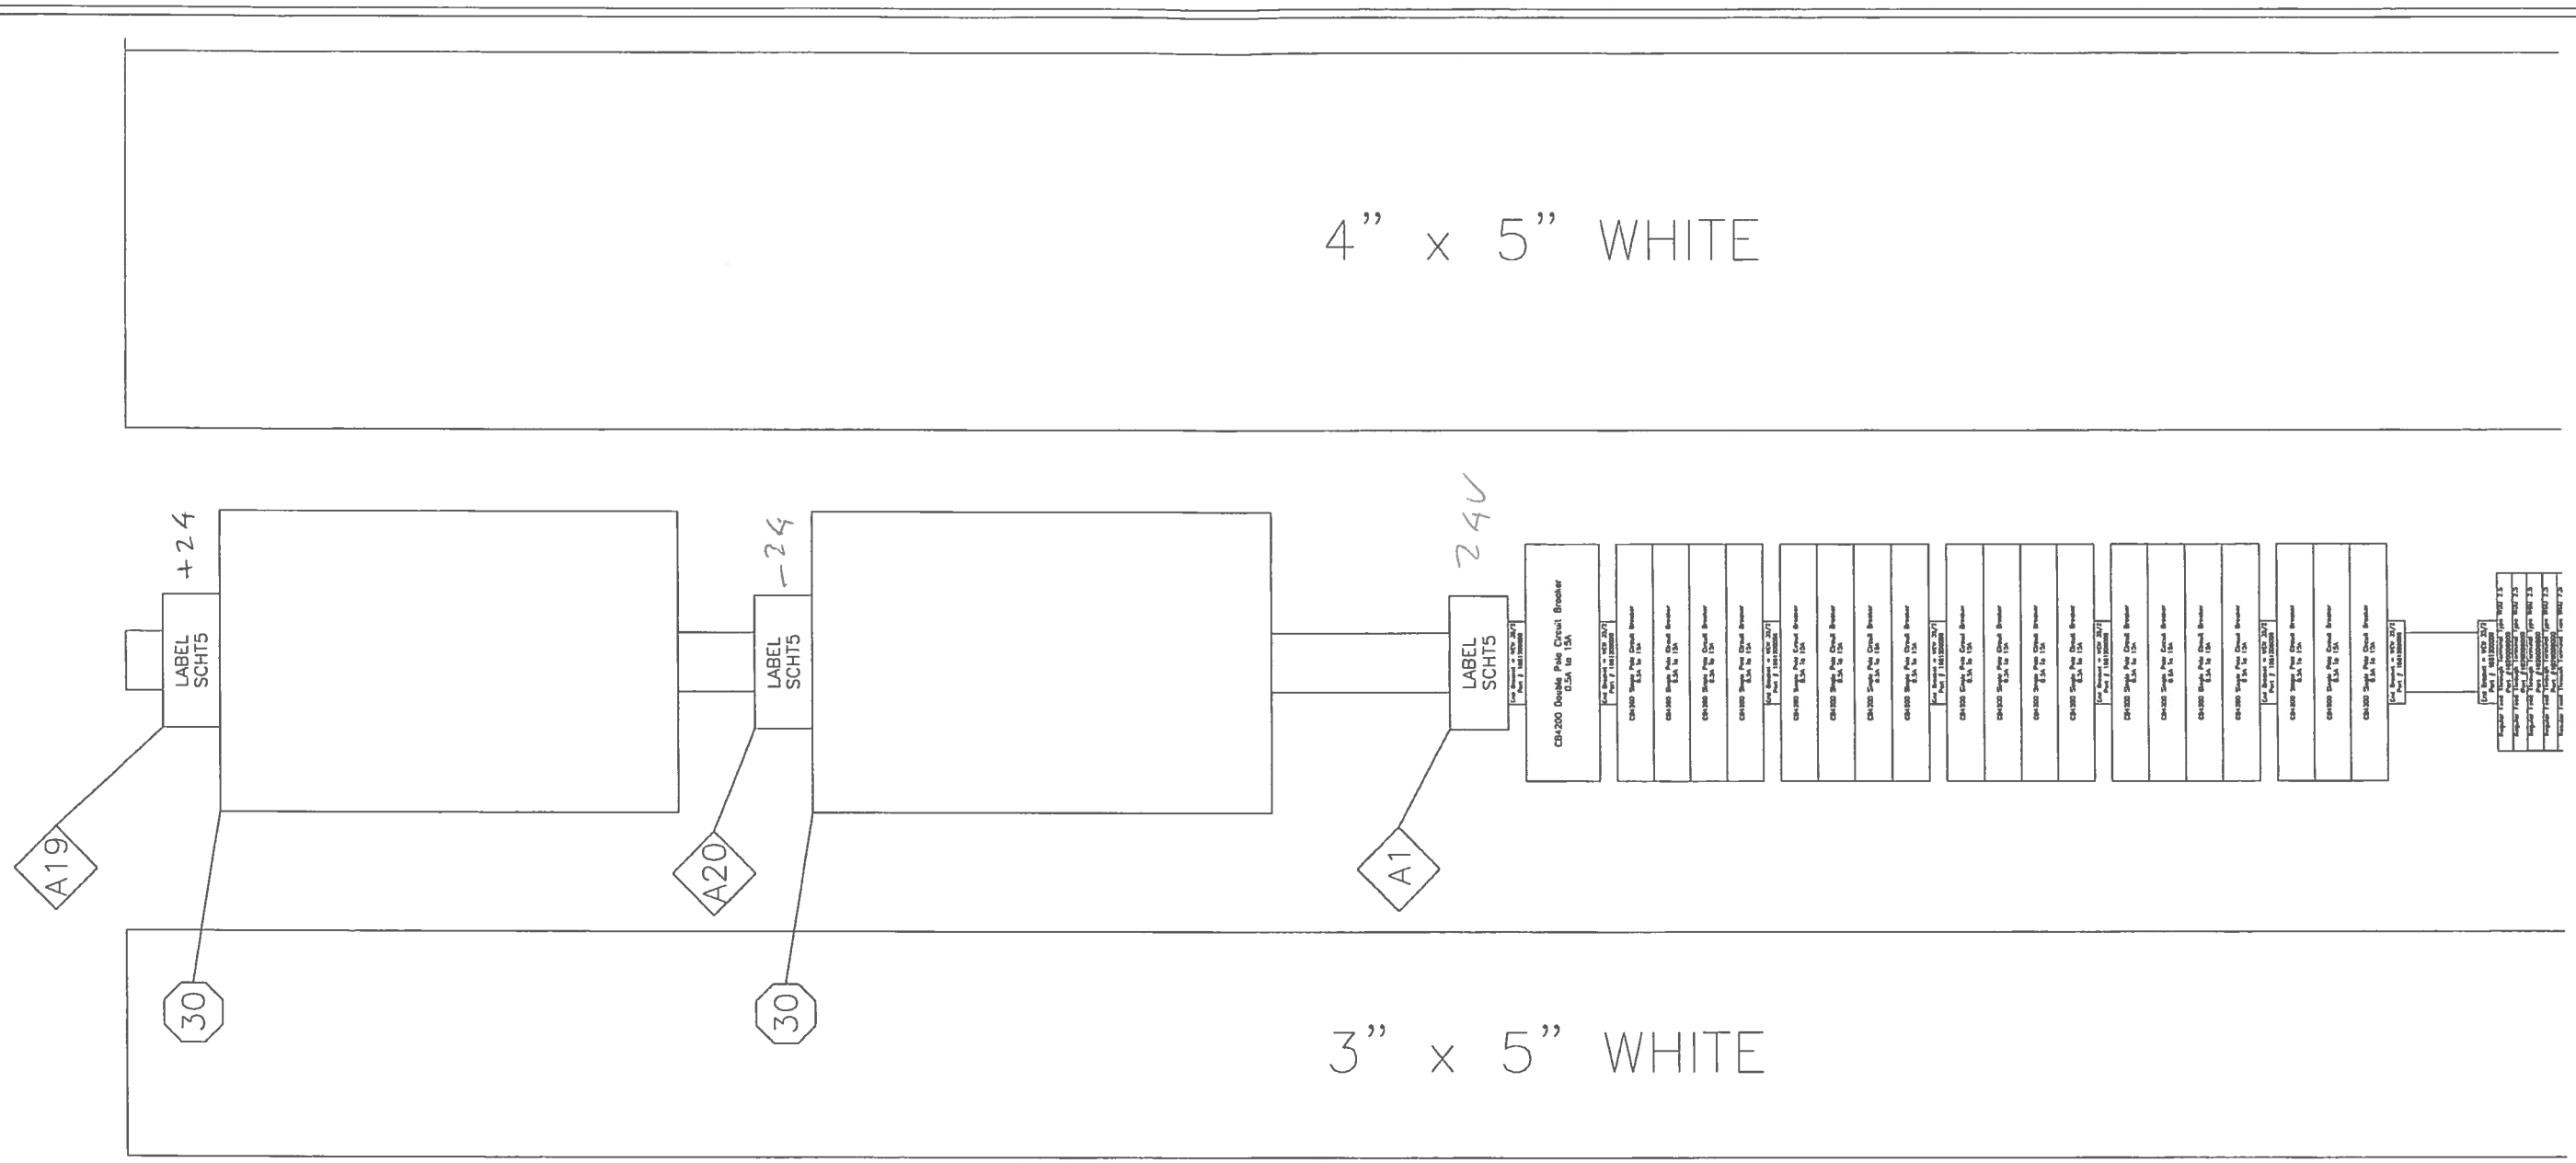

DRAWING#	REFERENCE DRAWING TITLE

REV	DATE	DESCRIPTION	DWN	CHKD	APPR
A	22JUL2013	ISSUED FOR REVIEW	RR	CF	–
B	08OCT2013	ISSUED FOR APPROVAL	R.R	MG	MG
0	21OCT2013	ISSUED FOR CONSTRUCTION	R.R	MG	MG

PROFESSIONAL ENGINEER STAMP

PROVINCE OF BRITISH COLUMBIA
M. A. GHALY
38913
PROFESSIONAL ENGINEER

OCT 2 4 2013

THIS DRAWING IS THE PROPERTY OF PENN WEST ENERGY TRUST AND
ANY REPRODUCTION IN WHOLE OR PART WITHOUT EXPRESS WRITTEN PERMISSION IS PROHIBITED.

PIONEER ENGINEERING INC.

THIRD PARTY LOGO

SCALE	AS SHOWN	SIZE: D
EPCM PROJECT#: 13053		

PennWest Exploration

CORDOVA – MULTI WELL TIE-IN
PENN WEST WELLSITE
d-055-A/094-P-10
CONTROL PANEL TERMINAL LAYOUT

DWG#	d055A094P10-ELC-3410	SHT 1 OF 10	REV	0

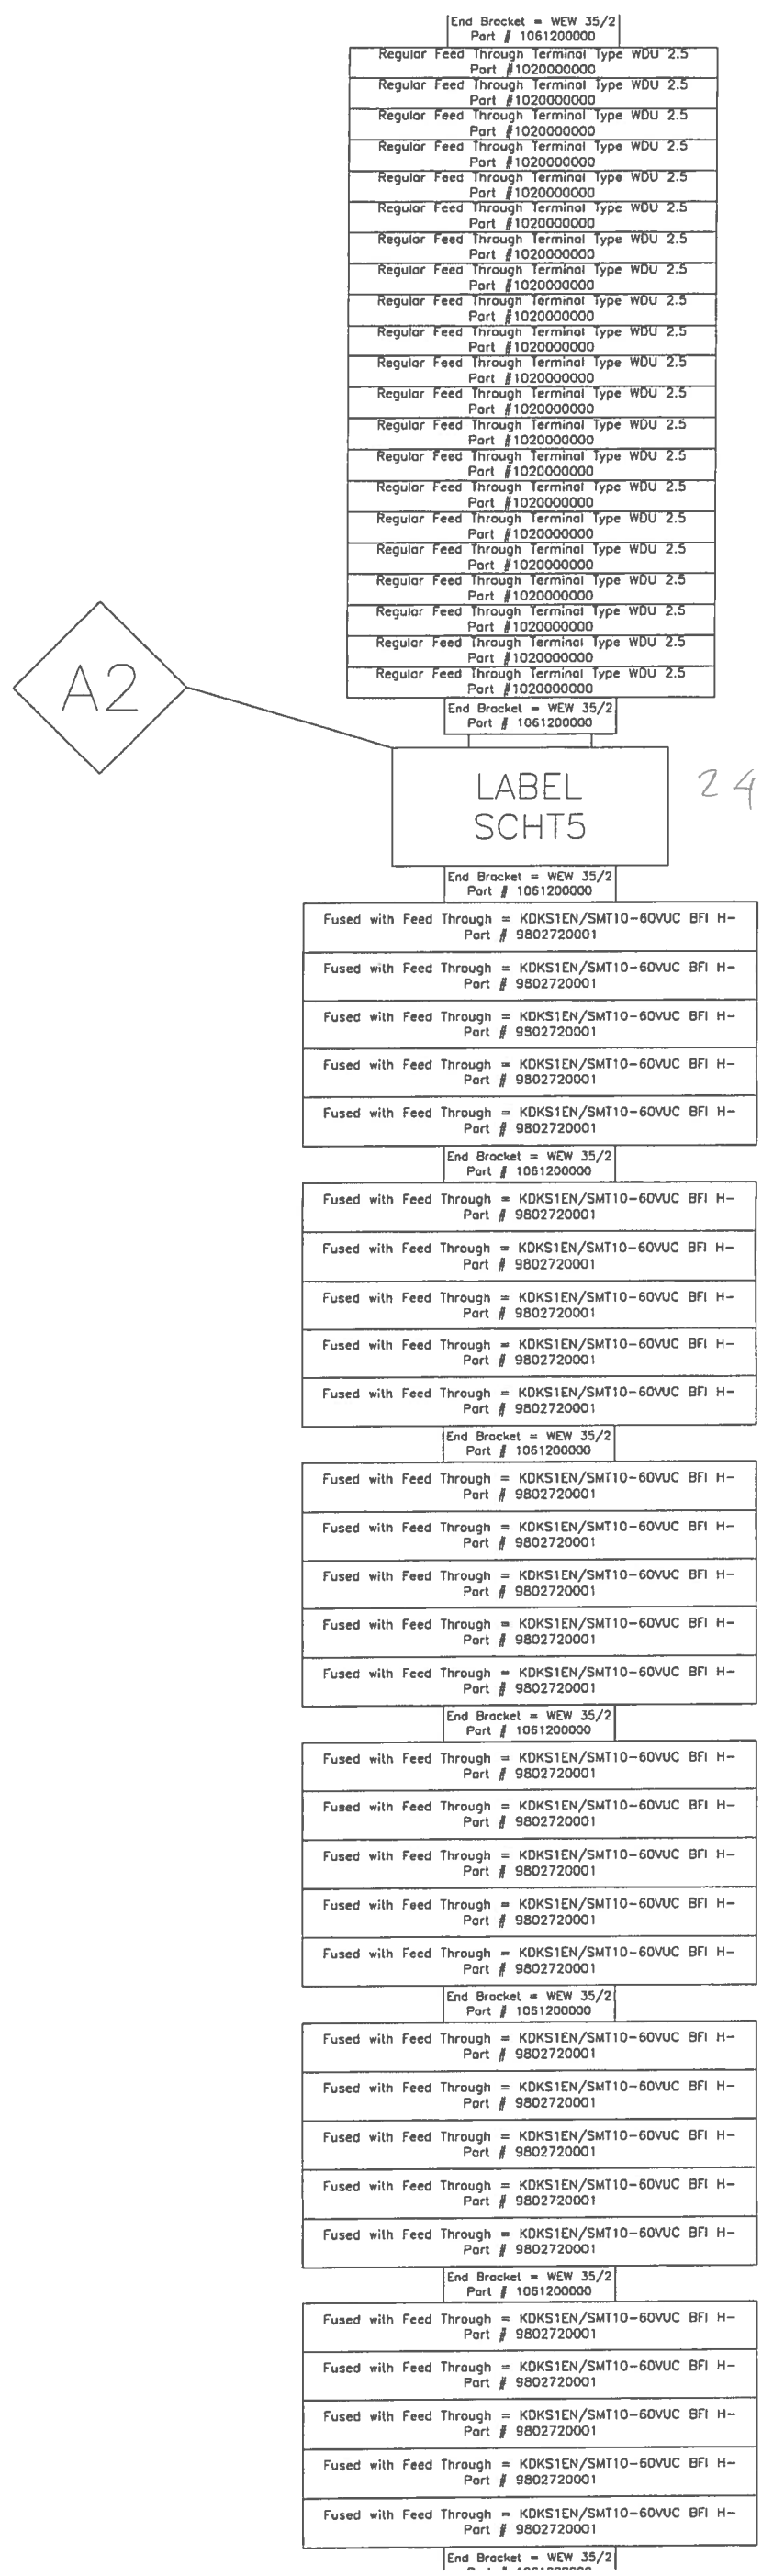

DRAWING#	REFERENCE DRAWING TITLE

REV	DATE	DESCRIPTION	DWN	CHKD	APPR
A	22JUL2013	ISSUED FOR REVIEW	RR	CF	-
B	08OCT2013	ISSUED FOR APPROVAL	R.R	MG	MG
0	21OCT2013	ISSUED FOR CONSTRUCTION	R.R	MG	MG

ENGINEER STAMP

PROFESSIONAL ENGINEER
PROVINCE OF BRITISH COLUMBIA
M. A. GHALY
38913
OCT 24 2013

THIS DRAWING IS THE PROPERTY OF PENN WEST ENERGY TRUST AND ANY REPRODUCTION IN WHOLE OR PART WITHOUT EXPRESS WRITTEN PERMISSION IS PROHIBITED.

PIONEER ENGINEERING INC.

THIRD PARTY LOGO

SCALE: AS SHOWN | SIZE: D

EPCM PROJECT#: 13053

PennWest Exploration

CORDOVA - MULTI WELL TIE-IN
PENN WEST WELLSITE
d-055-A/094-P-10
CONTROL PANEL TERMINAL LAYOUT

DWG# d055A094P10-ELC-3411

SHT 2 OF 10 | REV 0

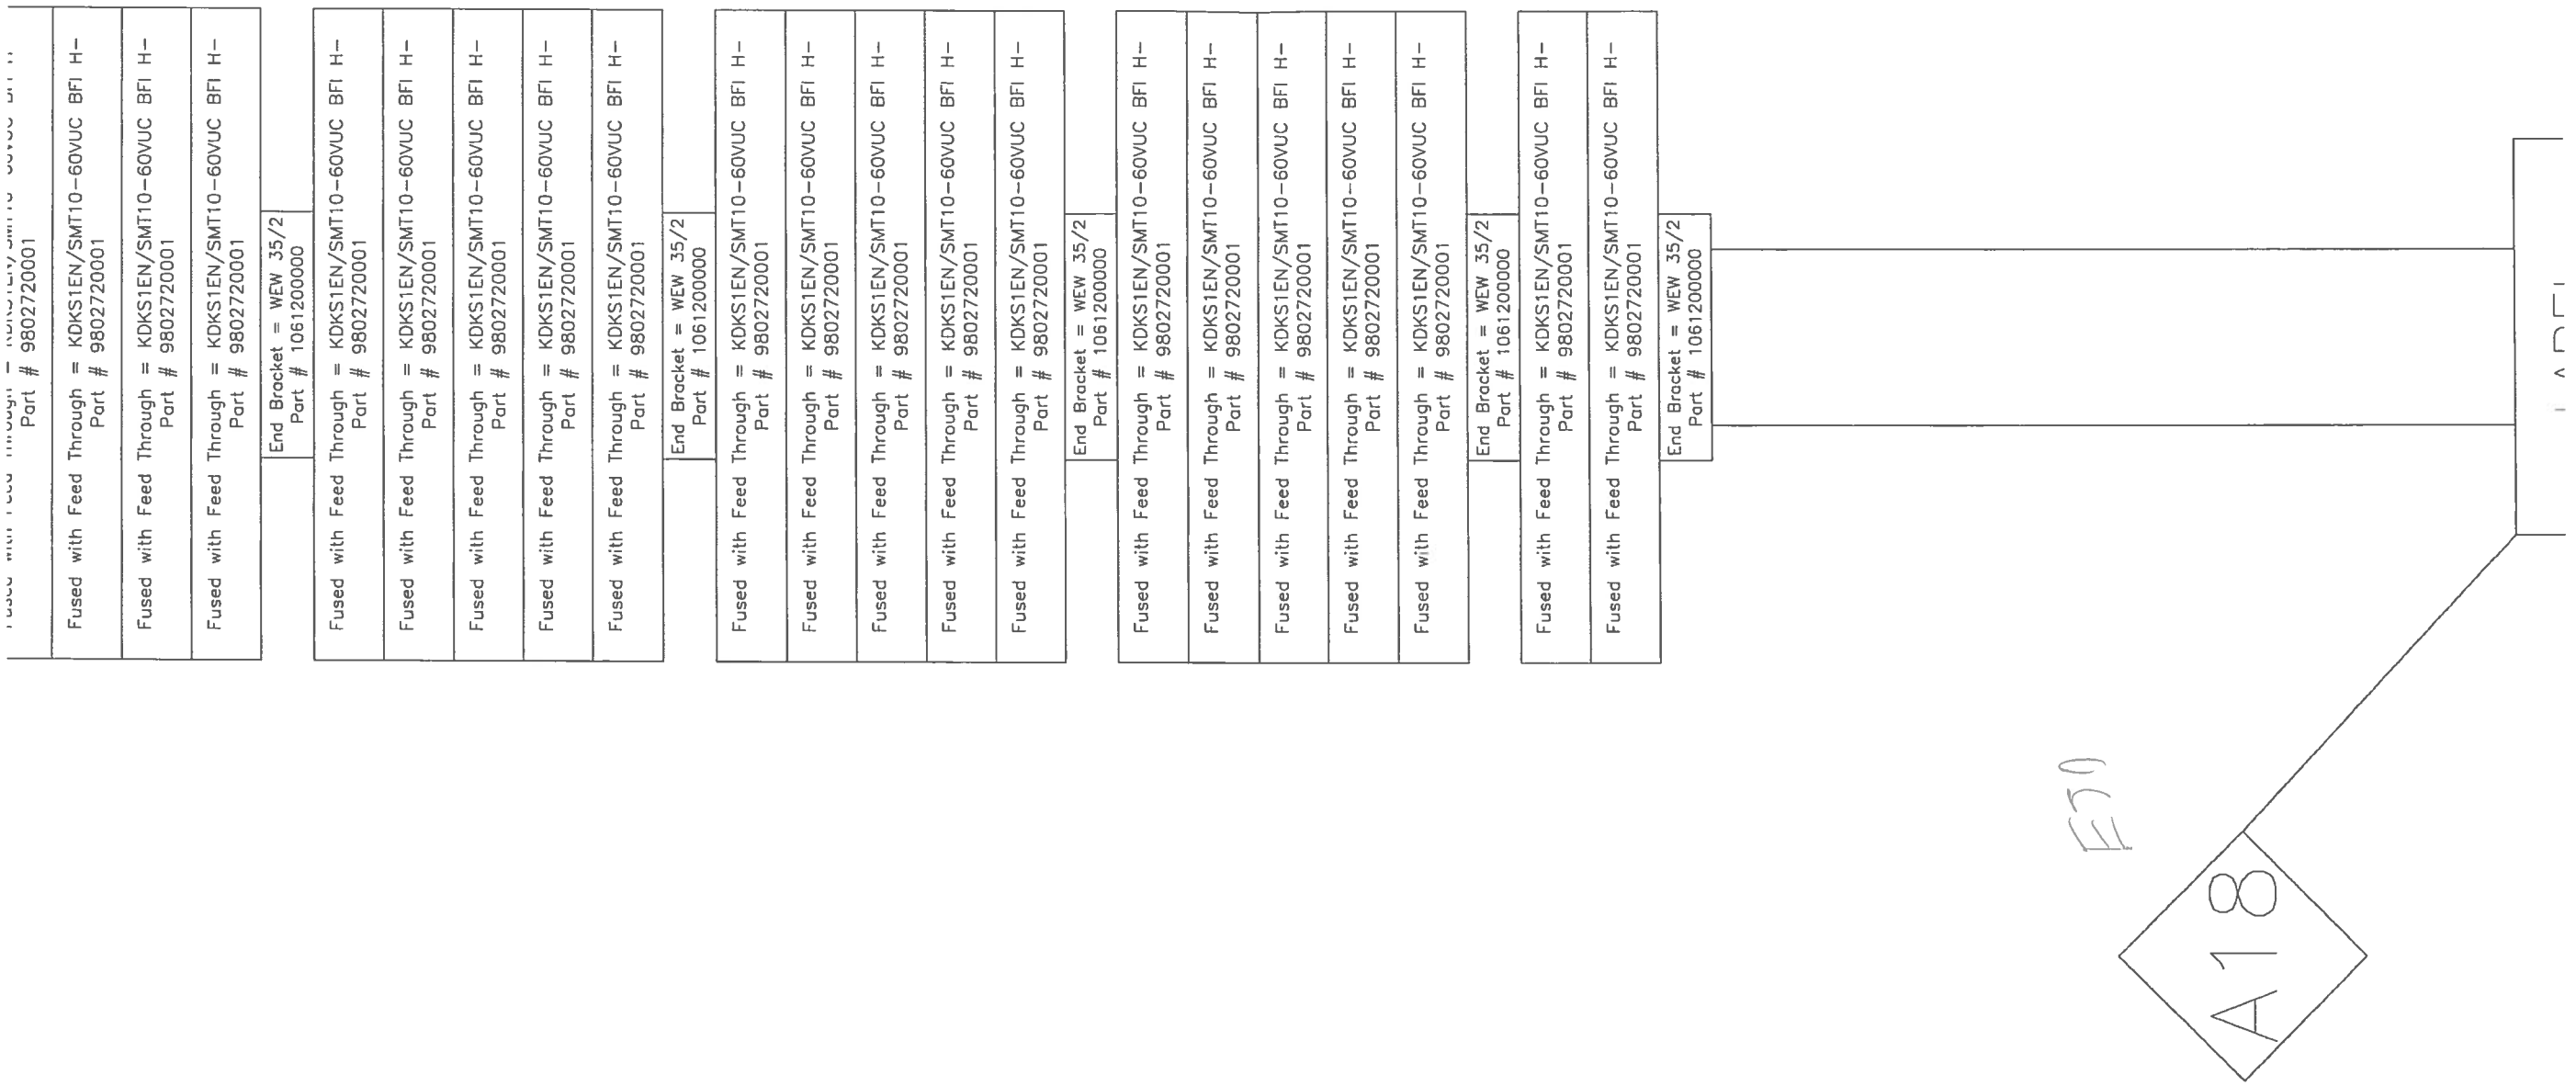

DRAWING#	REFERENCE DRAWING TITLE

REV	DATE	DESCRIPTION	DWN	CHKD	APPR
A	22JUL2013	ISSUED FOR REVIEW	RR	CF	–
B	08OCT2013	ISSUED FOR APPROVAL	R.R	MG	MG
0	21OCT2013	ISSUED FOR CONSTRUCTION	R.R	MG	MG

ENGINEER STAMP

PROFESSIONAL ENGINEER — PROVINCE OF BRITISH COLUMBIA — M. A. GHALY # 38913

OCT 2 4 2013

THIS DRAWING IS THE PROPERTY OF PENN WEST ENERGY TRUST AND ANY REPRODUCTION IN WHOLE OR PART WITHOUT EXPRESS WRITTEN PERMISSION IS PROHIBITED.

PIONEER ENGINEERING INC.

THIRD PARTY LOGO

SCALE: AS SHOWN | SIZE: D

EPCM PROJECT#: 13053

PennWest Exploration

CORDOVA – MULTI WELL TIE-IN
PENN WEST WELLSITE
d-055-A/094-P-10
CONTROL PANEL TERMINAL LAYOUT

DWG# d055A094P10-ELC-3412 | SHT 3 OF 10 | REV 0

A3

52 F 16

LABEL
SCHT5

End Bracket = WEW 35/2
Part # 1061200000

Blown Fuse Indication with 2 feedthrough and ground connection
Type KDKS1PE/SMT10-60VUC BFI H-
Part# 9158330001

Blown Fuse Indication with 2 feedthrough and ground connection
Type KDKS1PE/SMT10-60VUC BFI H-
Part# 9158330001

Blown Fuse Indication with 2 feedthrough and ground connection
Type KDKS1PE/SMT10-60VUC BFI H-
Part# 9158330001

Blown Fuse Indication with 2 feedthrough and ground connection
Type KDKS1PE/SMT10-60VUC BFI H-
Part# 9158330001

Blown Fuse Indication with 2 feedthrough and ground connection
Type KDKS1PE/SMT10-60VUC BFI H-
Part# 9158330001

Blown Fuse Indication with 2 feedthrough and ground connection
Type KDKS1PE/SMT10-60VUC BFI H-
Part# 9158330001

Blown Fuse Indication with 2 feedthrough and ground connection
Type KDKS1PE/SMT10-60VUC BFI H-
Part# 9158330001

Blown Fuse Indication with 2 feedthrough and ground connection
Type KDKS1PE/SMT10-60VUC BFI H-
Part# 9158330001

End Bracket = WEW 35/2
Part # 1061200000

Blown Fuse Indication with 2 feedthrough and ground connection
Type KDKS1PE/SMT10-60VUC BFI H-
Part# 9158330001

Blown Fuse Indication with 2 feedthrough and ground connection
Type KDKS1PE/SMT10-60VUC BFI H-
Part# 9158330001

Blown Fuse Indication with 2 feedthrough and ground connection
Type KDKS1PE/SMT10-60VUC BFI H-
Part# 9158330001

Blown Fuse Indication with 2 feedthrough and ground connection
Type KDKS1PE/SMT10-60VUC BFI H-
Part# 9158330001

Blown Fuse Indication with 2 feedthrough and ground connection
Type KDKS1PE/SMT10-60VUC BFI H-
Part# 9158330001

Blown Fuse Indication with 2 feedthrough and ground connection
Type KDKS1PE/SMT10-60VUC BFI H-
Part# 9158330001

Blown Fuse Indication with 2 feedthrough and ground connection
Type KDKS1PE/SMT10-60VUC BFI H-
Part# 9158330001

Blown Fuse Indication with 2 feedthrough and ground connection
Type KDKS1PE/SMT10-60VUC BFI H-
Part# 9158330001

Regular Feed Through Terminal Type WDU 2.5
Part #1020000000

Regular Feed Through Terminal Type WDU 2.5
Part #1020000000

End Bracket = WEW 35/2
Part # 1061200000

A4

53 IF 16

LABEL
SCHT5

End Bracket = WEW 35/2
Part # 1061200000

Blown Fuse Indication with 2 feedthrough and ground connection
Type KDKS1PE/SMT10-60VUC BFI H-
Part# 9158330001

Blown Fuse Indication with 2 feedthrough and ground connection
Type KDKS1PE/SMT10-60VUC BFI H-
Part# 9158330001

Blown Fuse Indication with 2 feedthrough and ground connection
Type KDKS1PE/SMT10-60VUC BFI H-
Part# 9158330001

Blown Fuse Indication with 2 feedthrough and ground connection
Type KDKS1PE/SMT10-60VUC BFI H-
Part# 9158330001

Blown Fuse Indication with 2 feedthrough and ground connection
Type KDKS1PE/SMT10-60VUC BFI H-
Part# 9158330001

Blown Fuse Indication with 2 feedthrough and ground connection
Type KDKS1PE/SMT10-60VUC BFI H-
Part# 9158330001

Blown Fuse Indication with 2 feedthrough and ground connection
Type KDKS1PE/SMT10-60VUC BFI H-
Part# 9158330001

Blown Fuse Indication with 2 feedthrough and ground connection
Type KDKS1PE/SMT10-60VUC BFI H-
Part# 9158330001

Blown Fuse Indication with 2 feedthrough and ground connection
Type KDKS1PE/SMT10-60VUC BFI H-
Part# 9158330001

Blown Fuse Indication with 2 feedthrough and ground connection
Type KDKS1PE/SMT10-60VUC BFI H-
Part# 9158330001

Blown Fuse Indication with 2 feedthrough and ground connection
Type KDKS1PE/SMT10-60VUC BFI H-
Part# 9158330001

Blown Fuse Indication with 2 feedthrough and ground connection
Type KDKS1PE/SMT10-60VUC BFI H-
Part# 9158330001

Blown Fuse Indication with 2 feedthrough and ground connection
Type KDKS1PE/SMT10-60VUC BFI H-
Part# 9158330001

Blown Fuse Indication with 2 feedthrough and ground connection
Type KDKS1PE/SMT10-60VUC BFI H-
Part# 9158330001

Blown Fuse Indication with 2 feedthrough and ground connection
Type KDKS1PE/SMT10-60VUC BFI H-
Part# 9158330001

Blown Fuse Indication with 2 feedthrough and ground connection
Type KDKS1PE/SMT10-60VUC BFI H-
Part# 9158330001

Blown Fuse Indication with 2 feedthrough and ground connection
Type KDKS1PE/SMT10-60VUC BFI H-
Part# 9158330001

Regular Feed Through Terminal Type WDU 2.5
Part #1020000000

Regular Feed Through Terminal Type WDU 2.5
Part #1020000000

End Bracket = WEW 35/2
Part # 1061200000

DRAWING#	REFERENCE DRAWING TITLE

REV	DATE	DESCRIPTION	DWN	CHKD	APPR
A	22JUL2013	ISSUED FOR REVIEW	RR	CF	-
B	08OCT2013	ISSUED FOR APPROVAL	R.R	MG	MG
0	21OCT2013	ISSUED FOR CONSTRUCTION	R.R	MG	MG

ENGINEER STAMP

PROFESSIONAL ENGINEER
PROVINCE OF ALBERTA
M. A. GHALY
38913
BRITISH COLUMBIA
OCT 24 2013

THIS DRAWING IS THE PROPERTY OF PENN WEST ENERGY TRUST AND ANY REPRODUCTION IN WHOLE OR PART WITHOUT EXPRESS WRITTEN PERMISSION IS PROHIBITED.

PIONEER ENGINEERING INC.

THIRD PARTY LOGO

SCALE: AS SHOWN
SIZE: D
EPCM PROJECT#: 13053

PennWest Exploration

CORDOVA - MULTI WELL TIE-IN
PENN WEST WELLSITE
d-055-A/094-P-10
CONTROL PANEL TERMINAL LAYOUT

DWG# d055A094P10-ELC-3413

SHT 4 OF 10

REV 0

A7

56 - OF 8

LABEL
SCHT5

End Bracket = WEW 35/2
Part # 1061200000

Fused with Feed Through = KDKS1EN/SMT10-60VUC BFI H-
Part # 9802720001

Ground Terminal Type WPE 4
Part #1010100000

Fused with Feed Through = KDKS1EN/SMT10-60VUC BFI H-
Part # 9802720001

Ground Terminal Type WPE 4
Part #1010100000

Fused with Feed Through = KDKS1EN/SMT10-60VUC BFI H-
Part # 9802720001

Ground Terminal Type WPE 4
Part #1010100000

Fused with Feed Through = KDKS1EN/SMT10-60VUC BFI H-
Part # 9802720001

Ground Terminal Type WPE 4
Part #1010100000

End Bracket = WEW 35/2
Part # 1061200000

Fused with Feed Through = KDKS1EN/SMT10-60VUC BFI H-
Part # 9802720001

Ground Terminal Type WPE 4
Part #1010100000

Fused with Feed Through = KDKS1EN/SMT10-60VUC BFI H-
Part # 9802720001

Ground Terminal Type WPE 4
Part #1010100000

Fused with Feed Through = KDKS1EN/SMT10-60VUC BFI H-
Part # 9802720001

Ground Terminal Type WPE 4
Part #1010100000

Fused with Feed Through = KDKS1EN/SMT10-60VUC BFI H-
Part # 9802720001

Ground Terminal Type WPE 4
Part #1010100000

End Bracket = WEW 35/2
Part # 1061200000

A8

57 OF 8

LABEL
SCHT5

End Bracket = WEW 35/2
Part # 1061200000

Fused with Feed Through = KDKS1EN/SMT10-60VUC BFI H-
Part # 9802720001

Ground Terminal Type WPE 4
Part #1010100000

Fused with Feed Through = KDKS1EN/SMT10-60VUC BFI H-
Part # 9802720001

Ground Terminal Type WPE 4
Part #1010100000

Fused with Feed Through = KDKS1EN/SMT10-60VUC BFI H-
Part # 9802720001

Ground Terminal Type WPE 4
Part #1010100000

Fused with Feed Through = KDKS1EN/SMT10-60VUC BFI H-
Part # 9802720001

Ground Terminal Type WPE 4
Part #1010100000

End Bracket = WEW 35/2
Part # 1061200000

Fused with Feed Through = KDKS1EN/SMT10-60VUC BFI H-
Part # 9802720001

Ground Terminal Type WPE 4
Part #1010100000

Fused with Feed Through = KDKS1EN/SMT10-60VUC BFI H-
Part # 9802720001

Ground Terminal Type WPE 4
Part #1010100000

Fused with Feed Through = KDKS1EN/SMT10-60VUC BFI H-
Part # 9802720001

Ground Terminal Type WPE 4
Part #1010100000

Fused with Feed Through = KDKS1EN/SMT10-60VUC BFI H-
Part # 9802720001

Ground Terminal Type WPE 4
Part #1010100000

End Bracket = WEW 35/2
Part # 1061200000

DRAWING#	REFERENCE DRAWING TITLE

REV	DATE	DESCRIPTION	DWN	CHKD	APPR
A	22JUL2013	ISSUED FOR REVIEW	RR	CF	-
B	08OCT2013	ISSUED FOR APPROVAL	R.R	MG	MG
0	21OCT2013	ISSUED FOR CONSTRUCTION	R.R	MG	MG

PROFESSIONAL ENGINEER STAMP

PROVINCE OF BRITISH COLUMBIA
M. A. GHALY
38913
PROFESSIONAL ENGINEER

OCT 24 2013

THIS DRAWING IS THE PROPERTY OF PENN WEST ENERGY TRUST AND ANY REPRODUCTION IN WHOLE OR PART WITHOUT EXPRESS WRITTEN PERMISSION IS PROHIBITED.

PIONEER ENGINEERING INC.

THIRD PARTY LOGO

SCALE: AS SHOWN | SIZE: D

EPCM PROJECT#: 13053

PennWest Exploration

CORDOVA - MULTI WELL TIE-IN
PENN WEST WELLSITE
d-055-A/094-P-10
CONTROL PANEL TERMINAL LAYOUT

DWG# d055A094P10-ELC-3414 | SHT 5 OF 10 | REV 0

A10

5GIB32

LABEL
SCHT5

End Bracket = WEW 35/2
Part # 1061200000

Regular Feed Through Terminal Type WDU 2.5
Part #1020000000

Regular Feed Through Terminal Type WDU 2.5
Part #1020000000

Fused with Feed Through = KDKS1EN/SMT10-60VUC BFI H-
Part # 9802720001

Fused with Feed Through = KDKS1EN/SMT10-60VUC BFI H-
Part # 9802720001

Fused with Feed Through = KDKS1EN/SMT10-60VUC BFI H-
Part # 9802720001

Fused with Feed Through = KDKS1EN/SMT10-60VUC BFI H-
Part # 9802720001

Fused with Feed Through = KDKS1EN/SMT10-60VUC BFI H-
Part # 9802720001

Fused with Feed Through = KDKS1EN/SMT10-60VUC BFI H-
Part # 9802720001

Fused with Feed Through = KDKS1EN/SMT10-60VUC BFI H-
Part # 9802720001

Fused with Feed Through = KDKS1EN/SMT10-60VUC BFI H-
Part # 9802720001

Fused with Feed Through = KDKS1EN/SMT10-60VUC BFI H-
Part # 9802720001

Fused with Feed Through = KDKS1EN/SMT10-60VUC BFI H-
Part # 9802720001

Fused with Feed Through = KDKS1EN/SMT10-60VUC BFI H-
Part # 9802720001

Fused with Feed Through = KDKS1EN/SMT10-60VUC BFI H-
Part # 9802720001

Fused with Feed Through = KDKS1EN/SMT10-60VUC BFI H-
Part # 9802720001

Fused with Feed Through = KDKS1EN/SMT10-60VUC BFI H-
Part # 9802720001

End Bracket = WEW 35/2
Part # 1061200000

Fused with Feed Through = KDKS1EN/SMT10-60VUC BFI H-
Part # 9802720001

Fused with Feed Through = KDKS1EN/SMT10-60VUC BFI H-
Part # 9802720001

Fused with Feed Through = KDKS1EN/SMT10-60VUC BFI H-
Part # 9802720001

Fused with Feed Through = KDKS1EN/SMT10-60VUC BFI H-
Part # 9802720001

Fused with Feed Through = KDKS1EN/SMT10-60VUC BFI H-
Part # 9802720001

Fused with Feed Through = KDKS1EN/SMT10-60VUC BFI H-
Part # 9802720001

Fused with Feed Through = KDKS1EN/SMT10-60VUC BFI H-
Part # 9802720001

Fused with Feed Through = KDKS1EN/SMT10-60VUC BFI H-
Part # 9802720001

Fused with Feed Through = KDKS1EN/SMT10-60VUC BFI H-
Part # 9802720001

Fused with Feed Through = KDKS1EN/SMT10-60VUC BFI H-
Part # 9802720001

Fused with Feed Through = KDKS1EN/SMT10-60VUC BFI H-
Part # 9802720001

Fused with Feed Through = KDKS1EN/SMT10-60VUC BFI H-
Part # 9802720001

Fused with Feed Through = KDKS1EN/SMT10-60VUC BFI H-
Part # 9802720001

Fused with Feed Through = KDKS1EN/SMT10-60VUC BFI H-
Part # 9802720001

Fused with Feed Through = KDKS1EN/SMT10-60VUC BFI H-
Part # 9802720001

End Bracket = WEW 35/2
Part # 1061200000

DRAWING#	REFERENCE DRAWING TITLE

REV	DATE	DESCRIPTION	DWN	CHKD	APPR
A	22JUL2013	ISSUED FOR REVIEW	RR	CF	-
B	08OCT2013	ISSUED FOR APPROVAL	R.R	MG	MG
0	21OCT2013	ISSUED FOR CONSTRUCTION	R R	MG	MG

ENGINEER STAMP

PROFESSIONAL ENGINEER
PROVINCE OF ALBERTA
M. A. GHALY
38913
OCT 2 4 2013

THIS DRAWING IS THE PROPERTY OF PENN WEST ENERGY TRUST AND ANY REPRODUCTION IN WHOLE OR PART WITHOUT EXPRESS WRITTEN PERMISSION IS PROHIBITED.

PIONEER ENGINEERING INC.

THIRD PARTY LOGO

SCALE: AS SHOWN | SIZE: D

EPCM PROJECT#: 13053

PennWest Exploration

CORDOVA - MULTI WELL TIE-IN
PENN WEST WELLSITE
d-055-A/094-P-10
CONTROL PANEL TERMINAL LAYOUT

DWG# d055A094P10-ELC-3415

SHT 6 OF 10 | REV 0

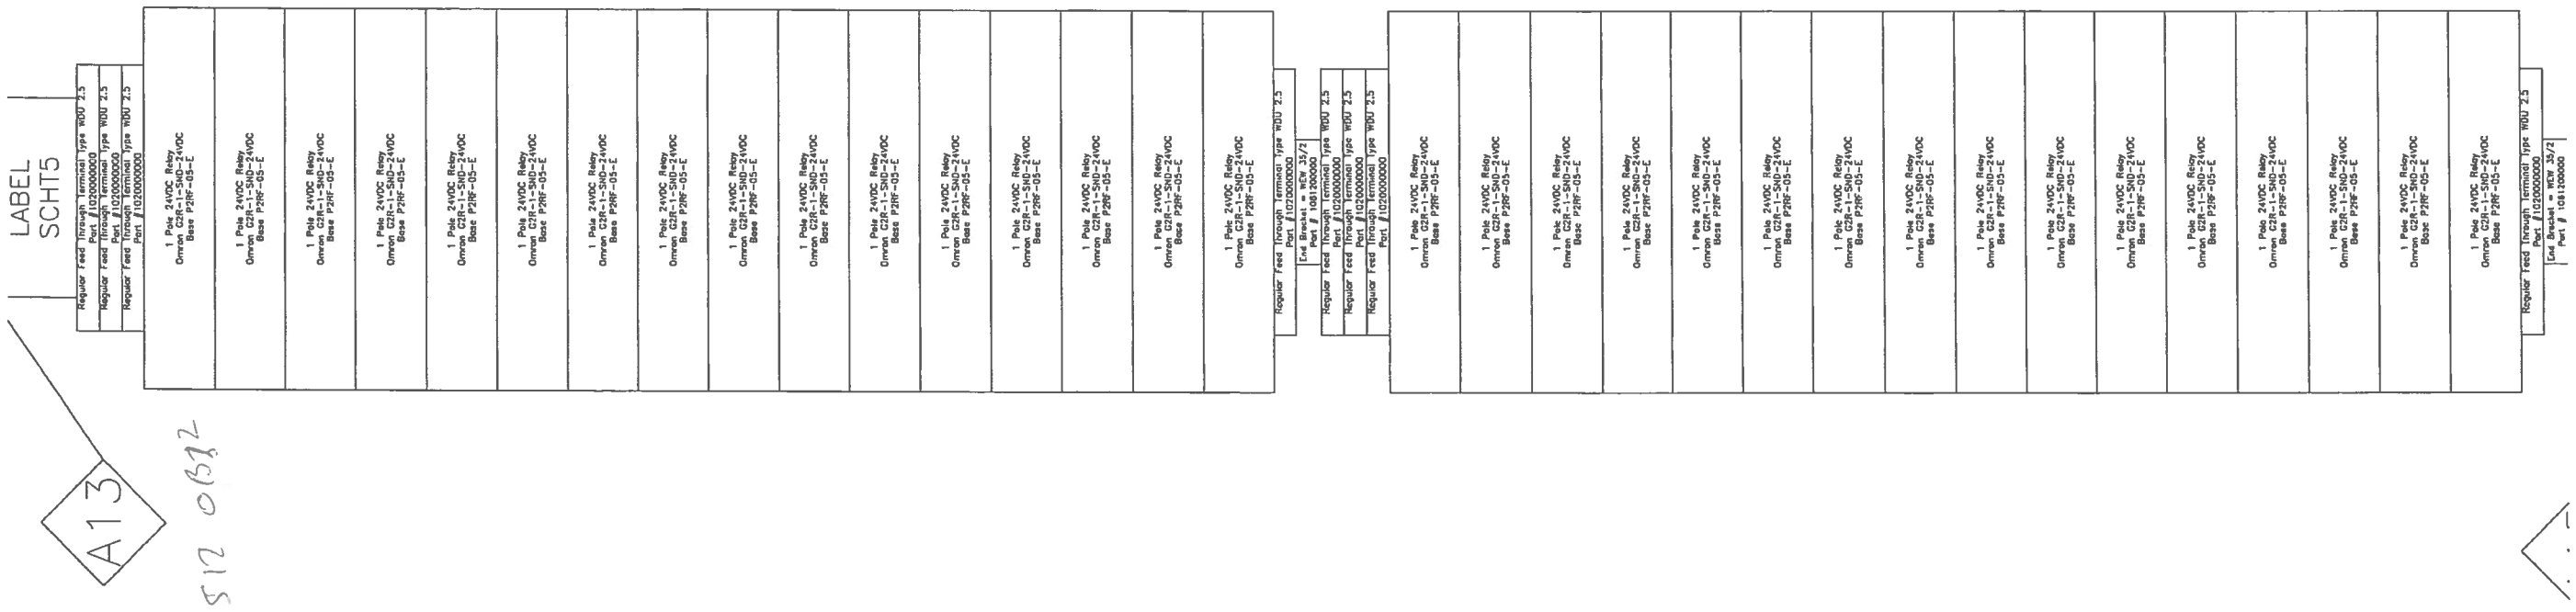

DRAWING#	REFERENCE DRAWING TITLE

REV	DATE	DESCRIPTION	DWN	CHKD	APPR
A	22JUL2013	ISSUED FOR REVIEW	RR	CF	–
B	08OCT2013	ISSUED FOR APPROVAL	R.R	MG	MG
0	21OCT2013	ISSUED FOR CONSTRUCTION	R.R	MG	MG

ENGINEER STAMP

PROFESSIONAL ENGINEER — PROVINCE OF BRITISH COLUMBIA — M. A. GHALY # 38913

THIS DRAWING IS THE PROPERTY OF PENN WEST ENERGY TRUST AND ANY REPRODUCTION IN WHOLE OR PART WITHOUT EXPRESS WRITTEN PERMISSION IS PROHIBITED.

PIONEER ENGINEERING INC.

THIRD PARTY LOGO

SCALE: AS SHOWN | SIZE: D

EPCM PROJECT#: 13053

PennWest Exploration

CORDOVA – MULTI WELL TIE-IN
PENN WEST WELLSITE
d-055-A/094-P-10
CONTROL PANEL TERMINAL LAYOUT

DWG# d055A094P10-ELC-3416 | SHT 7 OF 10 | REV 0

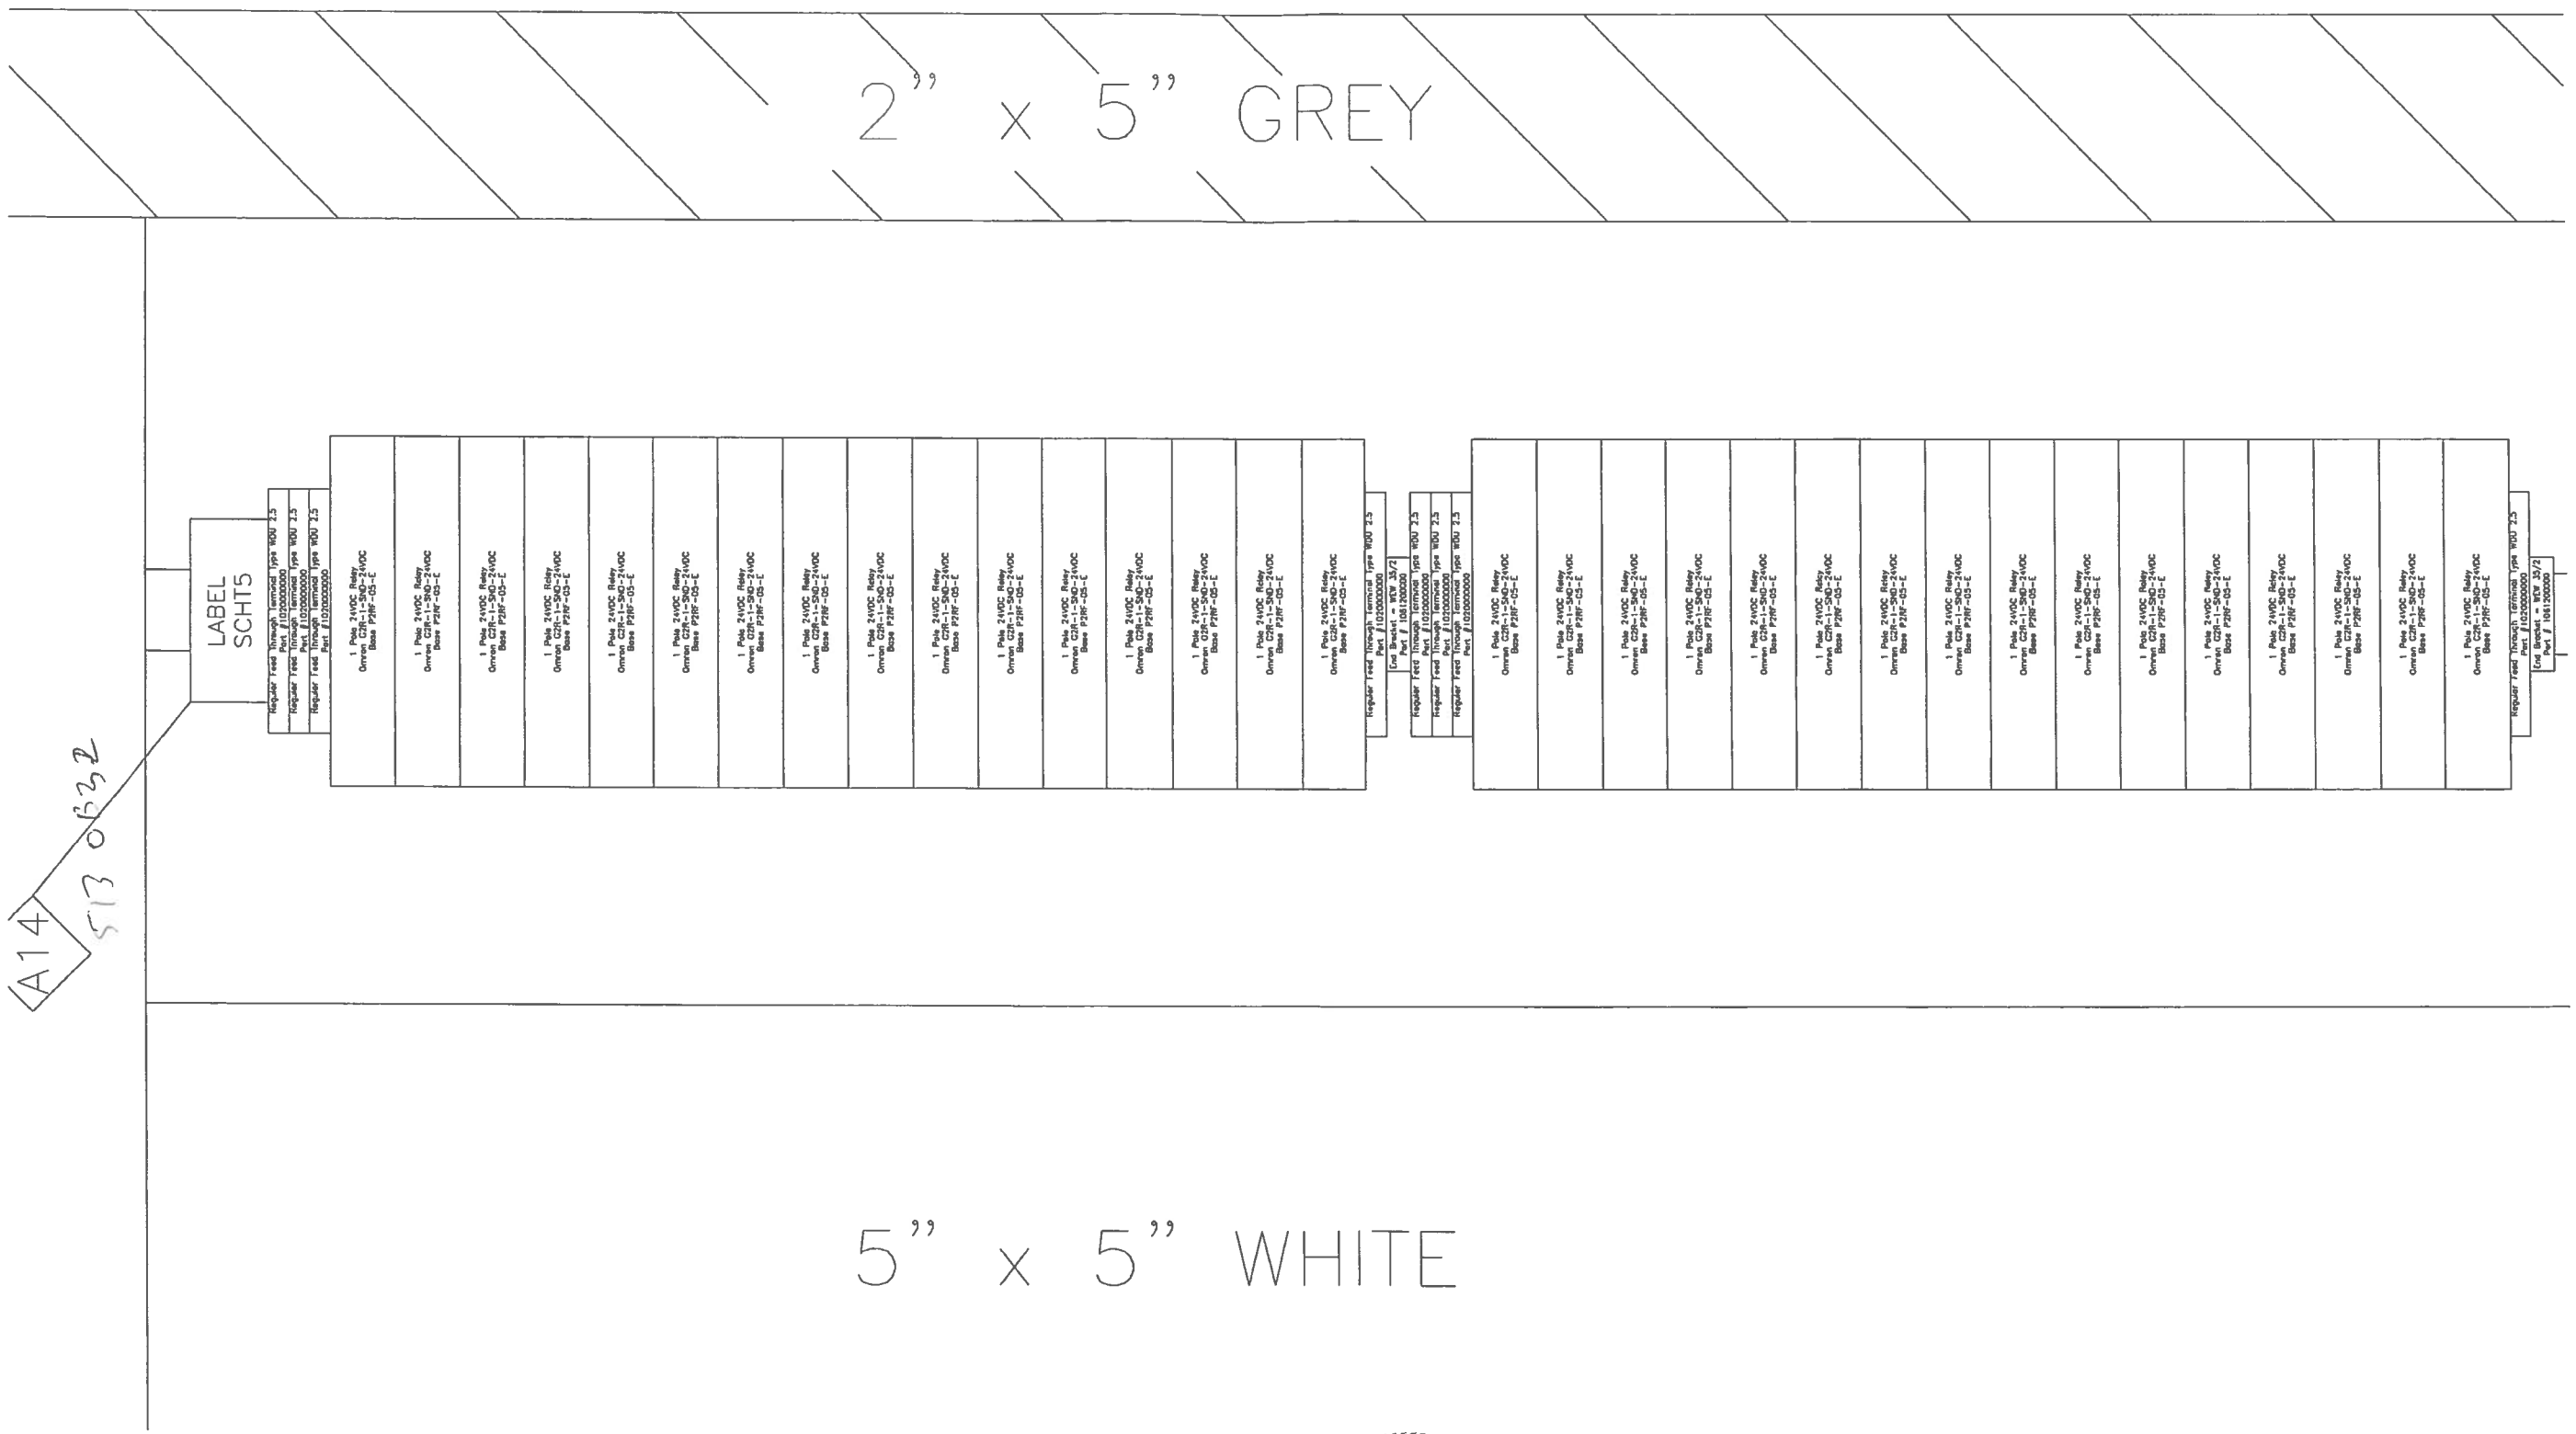

DRAWING#	REFERENCE DRAWING TITLE

REV	DATE	DESCRIPTION	DWN	CHKD	APPR
A	22JUL2013	ISSUED FOR REVIEW	RR	CF	–
B	08OCT2013	ISSUED FOR APPROVAL	R.R	MG	MG
0	21OCT2013	ISSUED FOR CONSTRUCTION	R.R	MG	MG

ENGINEER STAMP

PROFESSIONAL ENGINEER — PROVINCE OF BRITISH COLUMBIA — M. A. GHALY # 38913

OCT 2 4 2013

THIS DRAWING IS THE PROPERTY OF PENN WEST ENERGY TRUST AND ANY REPRODUCTION IN WHOLE OR PART WITHOUT EXPRESS WRITTEN PERMISSION IS PROHIBITED.

PIONEER ENGINEERING INC.

THIRD PARTY LOGO

SCALE: AS SHOWN | SIZE: D

EPCM PROJECT#: 13053

PennWest Exploration

CORDOVA – MULTI WELL TIE-IN
PENN WEST WELLSITE
d-055-A/094-P-10
CONTROL PANEL TERMINAL LAYOUT

DWG# d055A094P10-ELC-3417 | SHT 8 OF 10 | REV 0

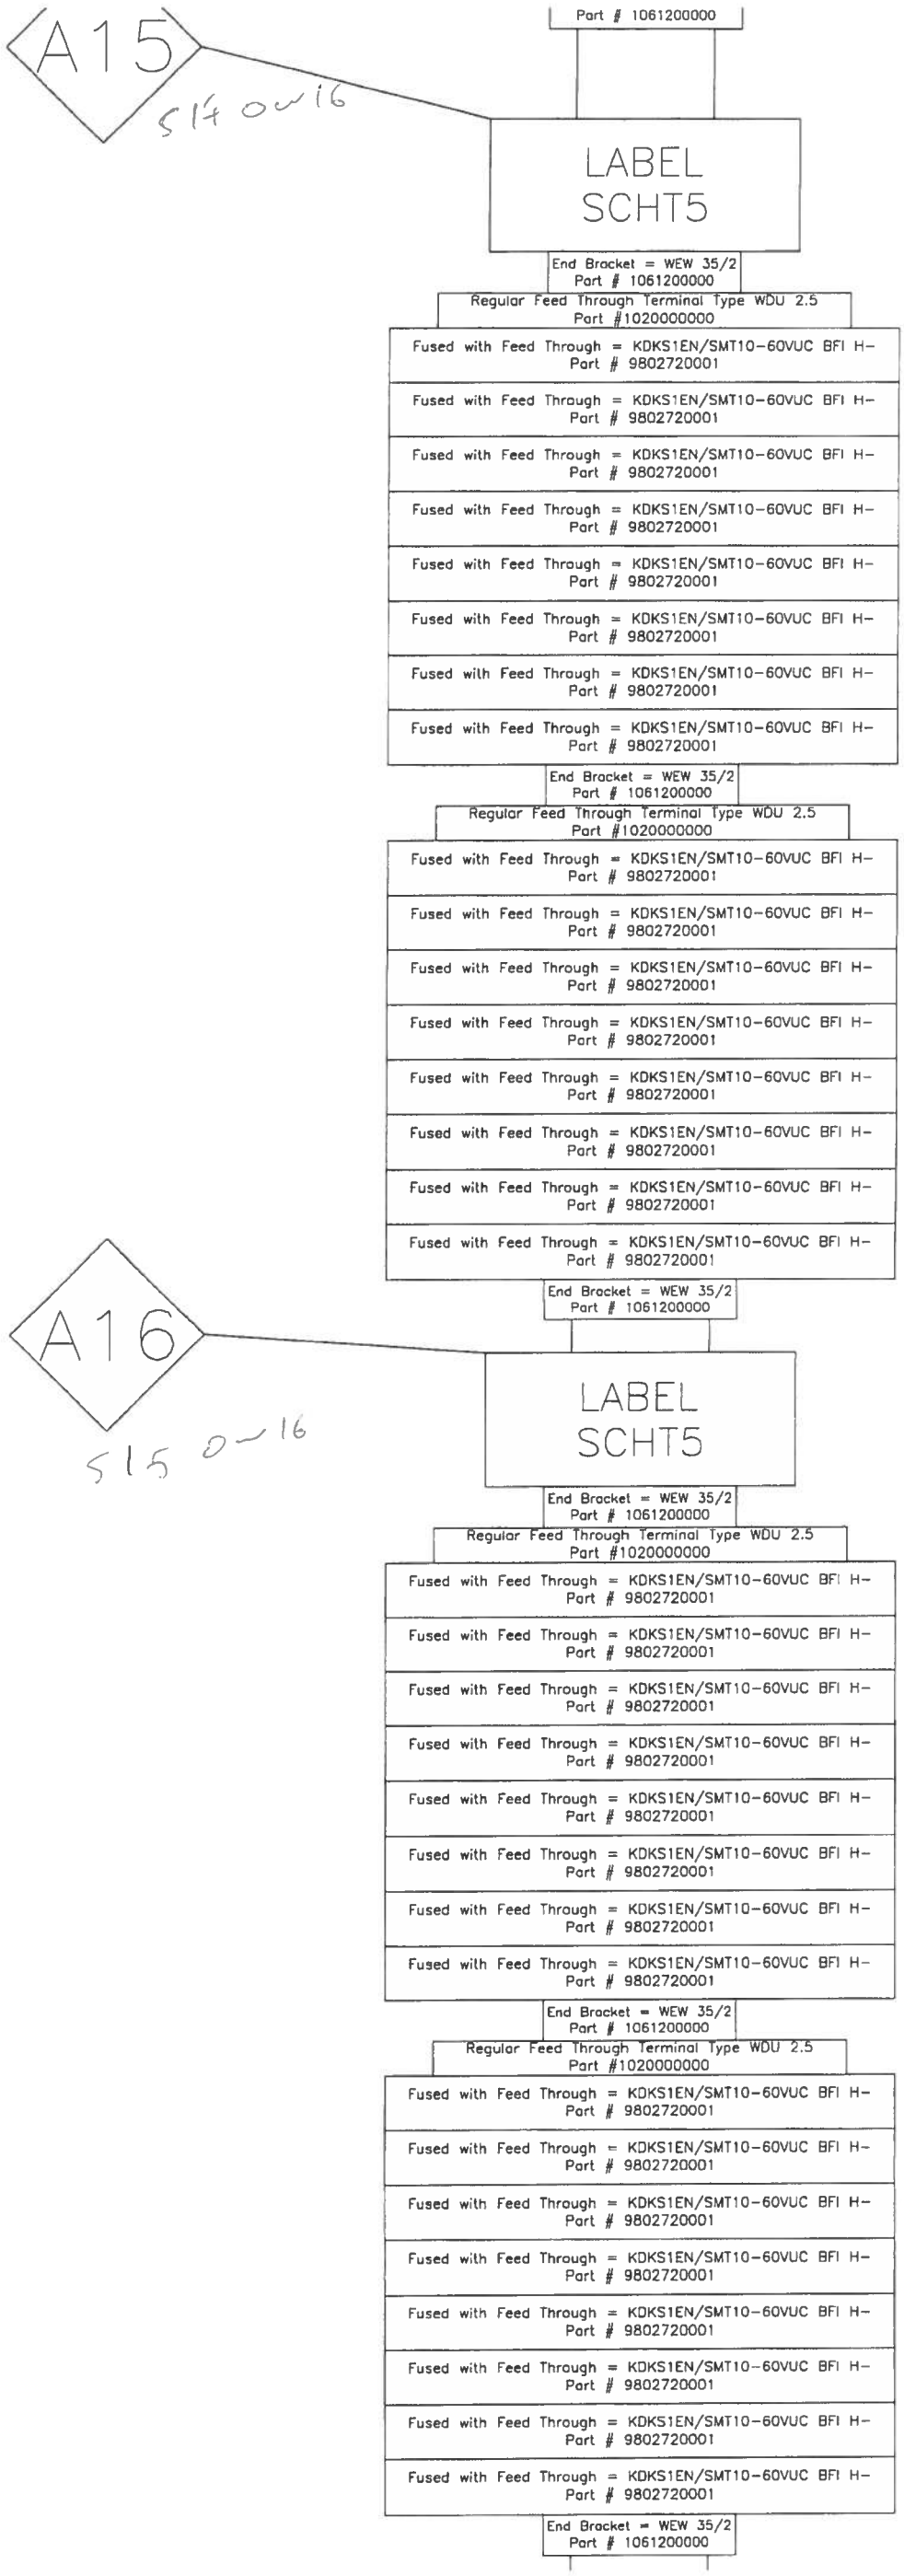

DRAWING#	REFERENCE DRAWING TITLE

REV	DATE	DESCRIPTION	DWN	CHKD	APPR
A	22JUL2013	ISSUED FOR REVIEW	RR	CF	-
B	08OCT2013	ISSUED FOR APPROVAL	R.R	MG	MG
0	21OCT2013	ISSUED FOR CONSTRUCTION	R.R	MG	MG

ENGINEER STAMP

PROFESSIONAL ENGINEER
PROVINCE OF ALBERTA
M. A. GHALY
38913
OCT 24 2013

THIS DRAWING IS THE PROPERTY OF PENN WEST ENERGY TRUST AND ANY REPRODUCTION IN WHOLE OR PART WITHOUT EXPRESS WRITTEN PERMISSION IS PROHIBITED.

PIONEER ENGINEERING INC.

THIRD PARTY LOGO

SCALE: AS SHOWN | SIZE: D

EPCM PROJECT#: 13053

PennWest Exploration

CORDOVA - MULTI WELL TIE-IN
PENN WEST WELLSITE
d-055-A/094-P-10
CONTROL PANEL TERMINAL LAYOUT

DWG# d055A094P10-ELC-3418 | SHT 9 OF 10 | REV 0

A12

511 IB 32

LABEL SCHT5

End Bracket = WEW 35/2
Part # 1061200000

Regular Feed Through Terminal Type WDU 2.5
Part #1020000000

Regular Feed Through Terminal Type WDU 2.5
Part #1020000000

Fused with Feed Through = KDKS1EN/SMT10-60VUC BFI H-
Part # 9802720001

Fused with Feed Through = KDKS1EN/SMT10-60VUC BFI H-
Part # 9802720001

Fused with Feed Through = KDKS1EN/SMT10-60VUC BFI H-
Part # 9802720001

Fused with Feed Through = KDKS1EN/SMT10-60VUC BFI H-
Part # 9802720001

Fused with Feed Through = KDKS1EN/SMT10-60VUC BFI H-
Part # 9802720001

Fused with Feed Through = KDKS1EN/SMT10-60VUC BFI H-
Part # 9802720001

Fused with Feed Through = KDKS1EN/SMT10-60VUC BFI H-
Part # 9802720001

Fused with Feed Through = KDKS1EN/SMT10-60VUC BFI H-
Part # 9802720001

Fused with Feed Through = KDKS1EN/SMT10-60VUC BFI H-
Part # 9802720001

Fused with Feed Through = KDKS1EN/SMT10-60VUC BFI H-
Part # 9802720001

Fused with Feed Through = KDKS1EN/SMT10-60VUC BFI H-
Part # 9802720001

Fused with Feed Through = KDKS1EN/SMT10-60VUC BFI H-
Part # 9802720001

Fused with Feed Through = KDKS1EN/SMT10-60VUC BFI H-
Part # 9802720001

Fused with Feed Through = KDKS1EN/SMT10-60VUC BFI H-
Part # 9802720001

End Bracket = WEW 35/2
Part # 1061200000

Fused with Feed Through = KDKS1EN/SMT10-60VUC BFI H-
Part # 9802720001

Fused with Feed Through = KDKS1EN/SMT10-60VUC BFI H-
Part # 9802720001

Fused with Feed Through = KDKS1EN/SMT10-60VUC BFI H-
Part # 9802720001

Fused with Feed Through = KDKS1EN/SMT10-60VUC BFI H-
Part # 9802720001

Fused with Feed Through = KDKS1EN/SMT10-60VUC BFI H-
Part # 9802720001

Fused with Feed Through = KDKS1EN/SMT10-60VUC BFI H-
Part # 9802720001

Fused with Feed Through = KDKS1EN/SMT10-60VUC BFI H-
Part # 9802720001

Fused with Feed Through = KDKS1EN/SMT10-60VUC BFI H-
Part # 9802720001

Fused with Feed Through = KDKS1EN/SMT10-60VUC BFI H-
Part # 9802720001

Fused with Feed Through = KDKS1EN/SMT10-60VUC BFI H-
Part # 9802720001

Fused with Feed Through = KDKS1EN/SMT10-60VUC BFI H-
Part # 9802720001

Fused with Feed Through = KDKS1EN/SMT10-60VUC BFI H-
Part # 9802720001

Fused with Feed Through = KDKS1EN/SMT10-60VUC BFI H-
Part # 9802720001

Fused with Feed Through = KDKS1EN/SMT10-60VUC BFI H-
Part # 9802720001

End Bracket = WEW 35/2
Part # 1061200000

DRAWING#	REFERENCE DRAWING TITLE

REV	DATE	DESCRIPTION	DWN	CHKD	APPR
A	22JUL2013	ISSUED FOR REVIEW	RR	CF	-
B	08OCT2013	ISSUED FOR APPROVAL	R.R	MG	MG
0	21OCT2013	ISSUED FOR CONSTRUCTION	R.R	MG	MG

PROFESSIONAL ENGINEER
PROVINCE OF BRITISH COLUMBIA
M. A. GHALY
38013

ENGINEER STAMP

OCT 24 2013

THIS DRAWING IS THE PROPERTY OF PENN WEST ENERGY TRUST AND ANY REPRODUCTION IN WHOLE OR PART WITHOUT EXPRESS WRITTEN PERMISSION IS PROHIBITED.

PIONEER ENGINEERING INC.

THIRD PARTY LOGO

SCALE: AS SHOWN
SIZE: 0
EPCM PROJECT#: 13053

PennWest Exploration

CORDOVA - MULTI WELL TIE-IN
PENN WEST WELLSITE
d-055-A/094-P-10
CONTROL PANEL TERMINAL LAYOUT

DWG# d055A094P10-ELC-3419
SHT 10 OF 10
REV 0

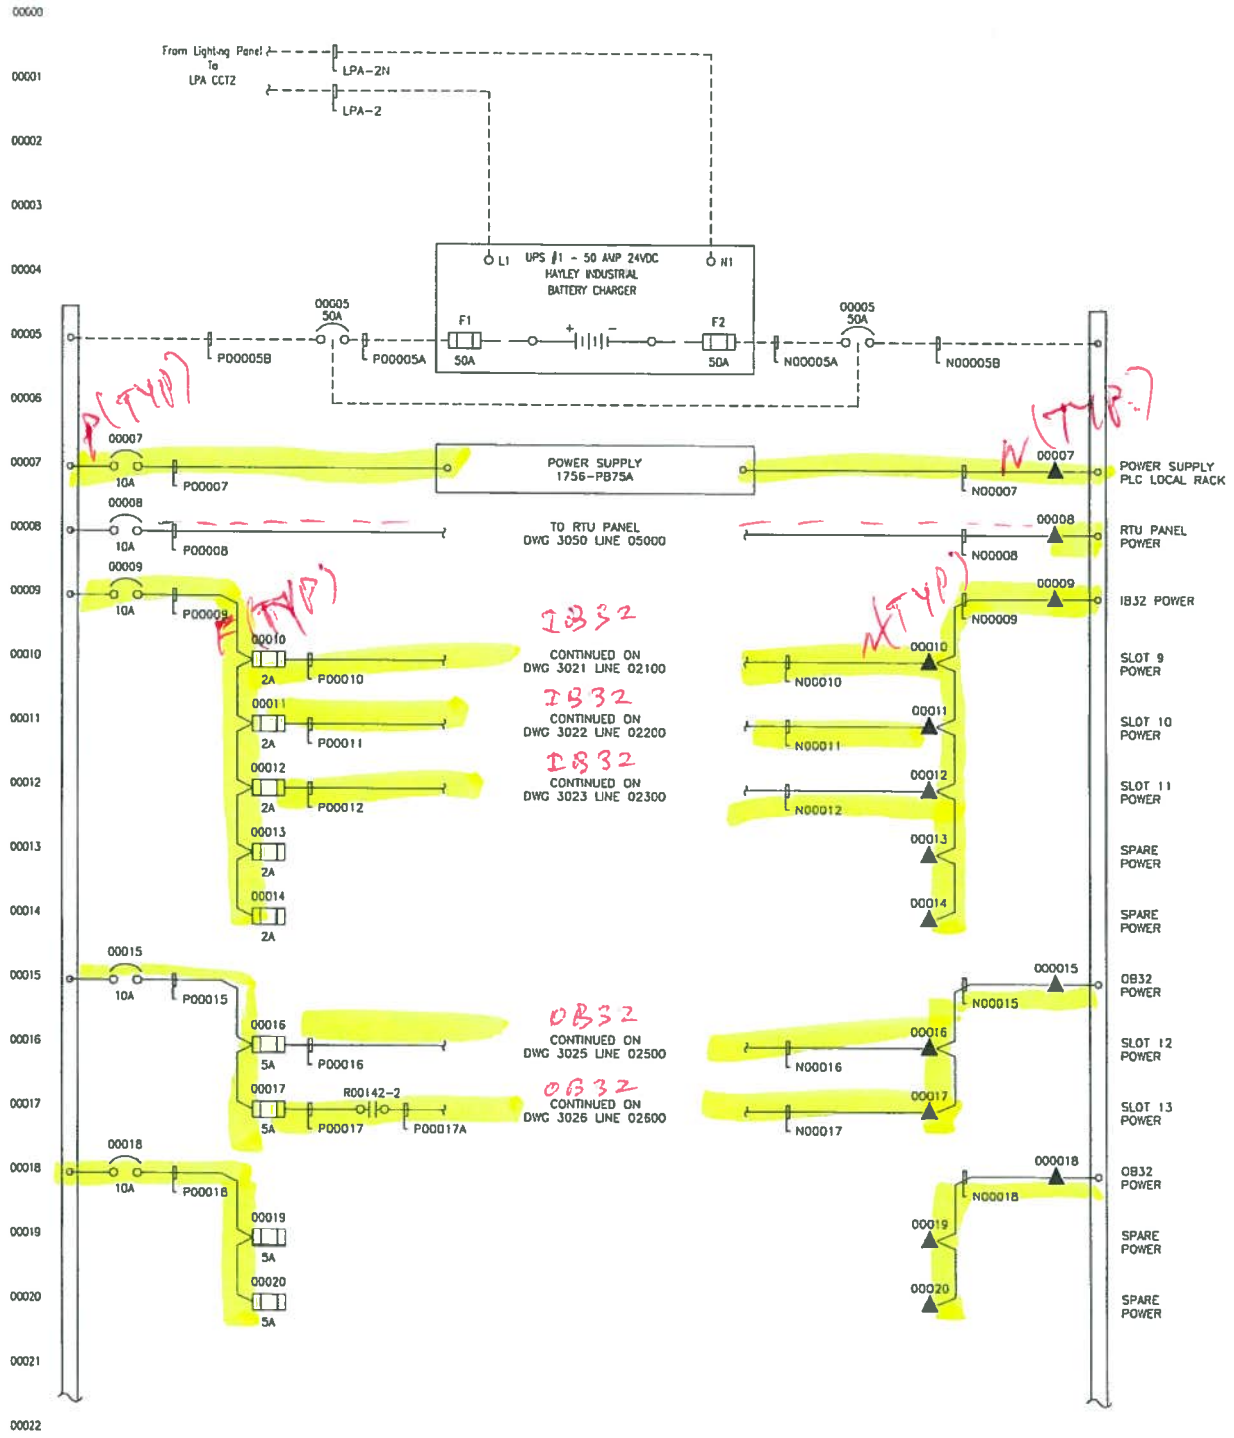

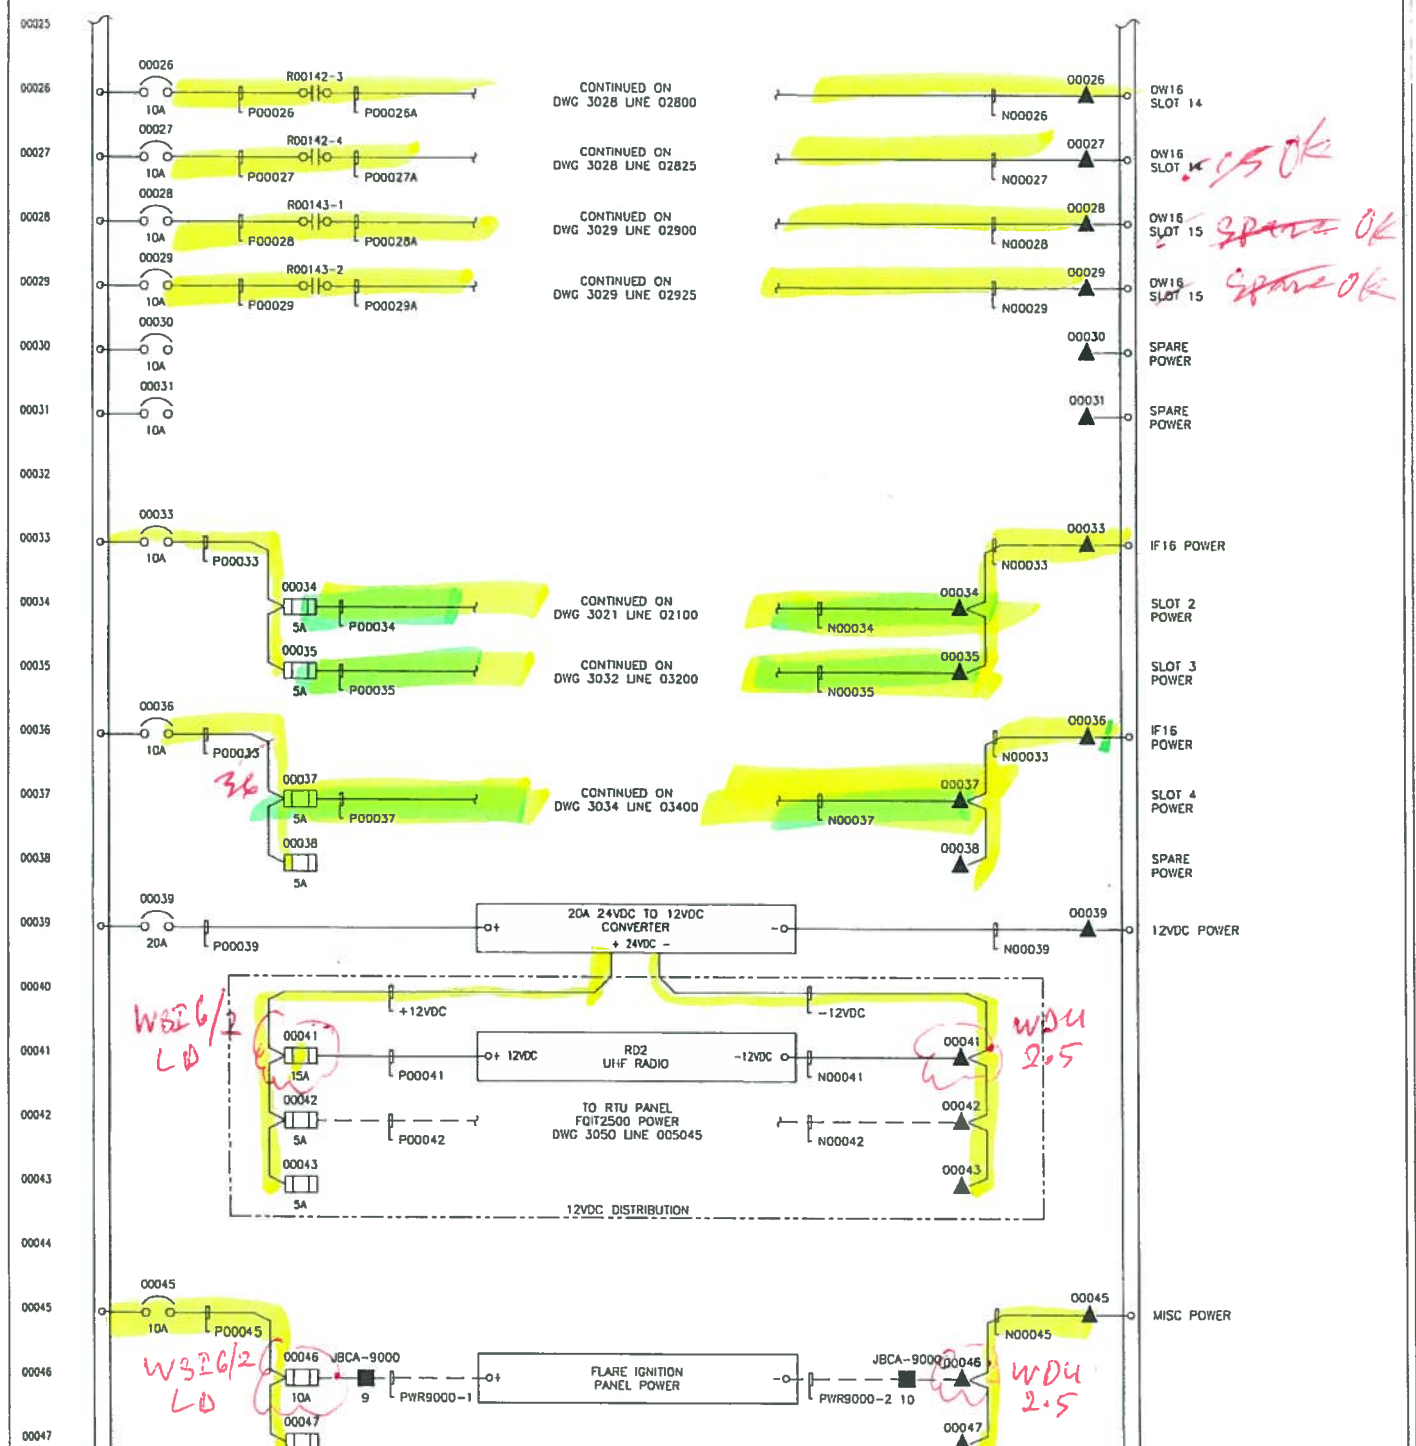

DRAWING#	REFERENCE DRAWING TITLE

REV	DATE	DESCRIPTION	DWN	CHKD	APPR
A	22JUL2013	ISSUED FOR REVIEW	RR	CF	–
B	10OCT2013	ISSUED FOR APPROVAL	R.R	MG	MG
0	21Oct2013	ISSUED FOR CONSTRUCTION	R.R	MG	MG

ENGINEER STAMP

PROFESSIONAL ENGINEER — PROVINCE OF BRITISH COLUMBIA — M. A. GHALY # 38913

OCT 2 4 2013

THIS DRAWING IS THE PROPERTY OF PENN WEST ENERGY TRUST AND ANY REPRODUCTION IN WHOLE OR PART WITHOUT EXPRESS WRITTEN PERMISSION IS PROHIBITED.

PIONEER ENGINEERING INC.

THIRD PARTY LOGO

SCALE: AS SHOWN | SIZE: D

EPCM PROJECT#: 13053

PennWest Exploration

CORDOVA – MULTI WELL TIE-IN
PENN WEST WELLSITE
d-055-A/094-P-10
24VDC DISTRIBUTION

DWG# d055A094P10-ELC-3000 | SHT 1 OF 2 | REV 0

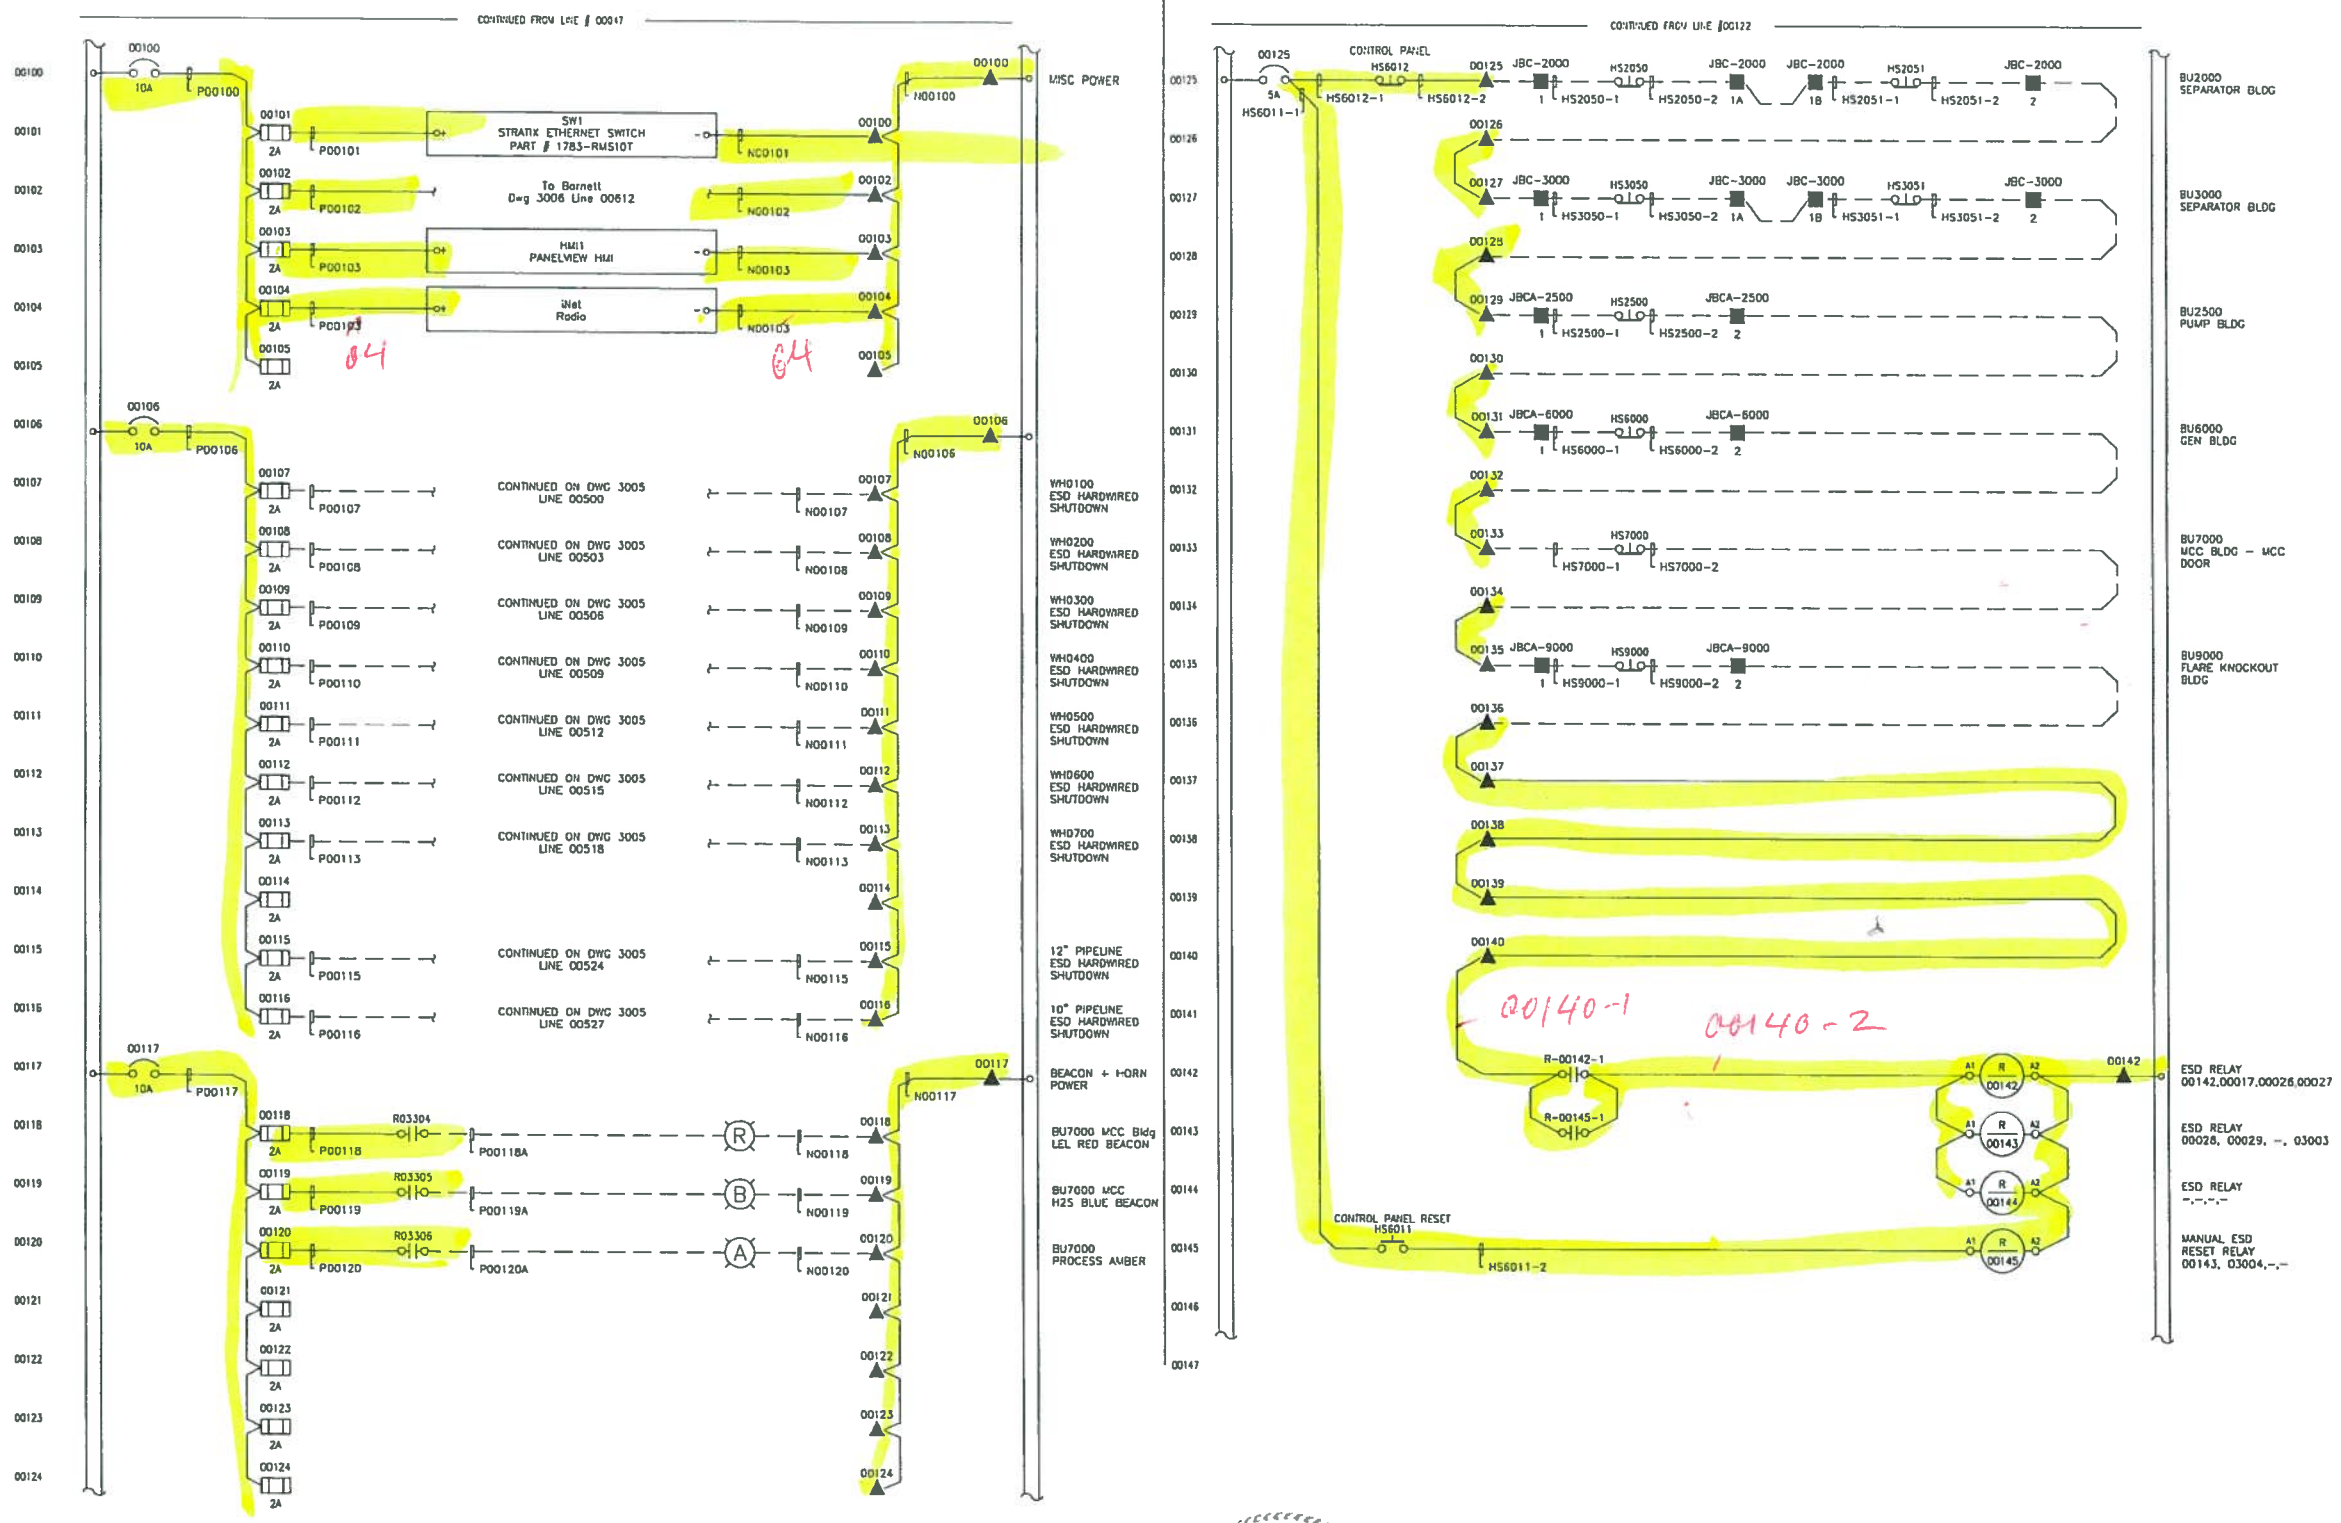

DRAWING#	REFERENCE DRAWING TITLE

REV	DATE	DESCRIPTION	DWN	CHKD	APPR
A	22JUL2013	ISSUED FOR REVIEW	RR	CF	–
B	08OCT2013	ISSUED FOR APPROVAL	R.R	MG	MG
0	21OCT2013	ISSUED FOR CONSTRUCTION	R.R	MG	MG

ENGINEER STAMP

PROFESSIONAL ENGINEER — PROVINCE OF BRITISH COLUMBIA — M. A. GHALY # 38913

OCT 2 4 2013

THIS DRAWING IS THE PROPERTY OF PENN WEST ENERGY TRUST AND ANY REPRODUCTION IN WHOLE OR PART WITHOUT EXPRESS WRITTEN PERMISSION IS PROHIBITED.

PIONEER ENGINEERING INC.

THIRD PARTY LOGO

SCALE: AS SHOWN | SIZE: D

EPCM PROJECT#: 13053

PennWest Exploration

CORDOVA – MULTI WELL TIE-IN
PENN WEST WELLSITE
d-055-A/094-P-10
24VDC DISTRIBUTION

DWG# d055A094P10-ELC-3001 | SHT 1 OF 2 | REV 0

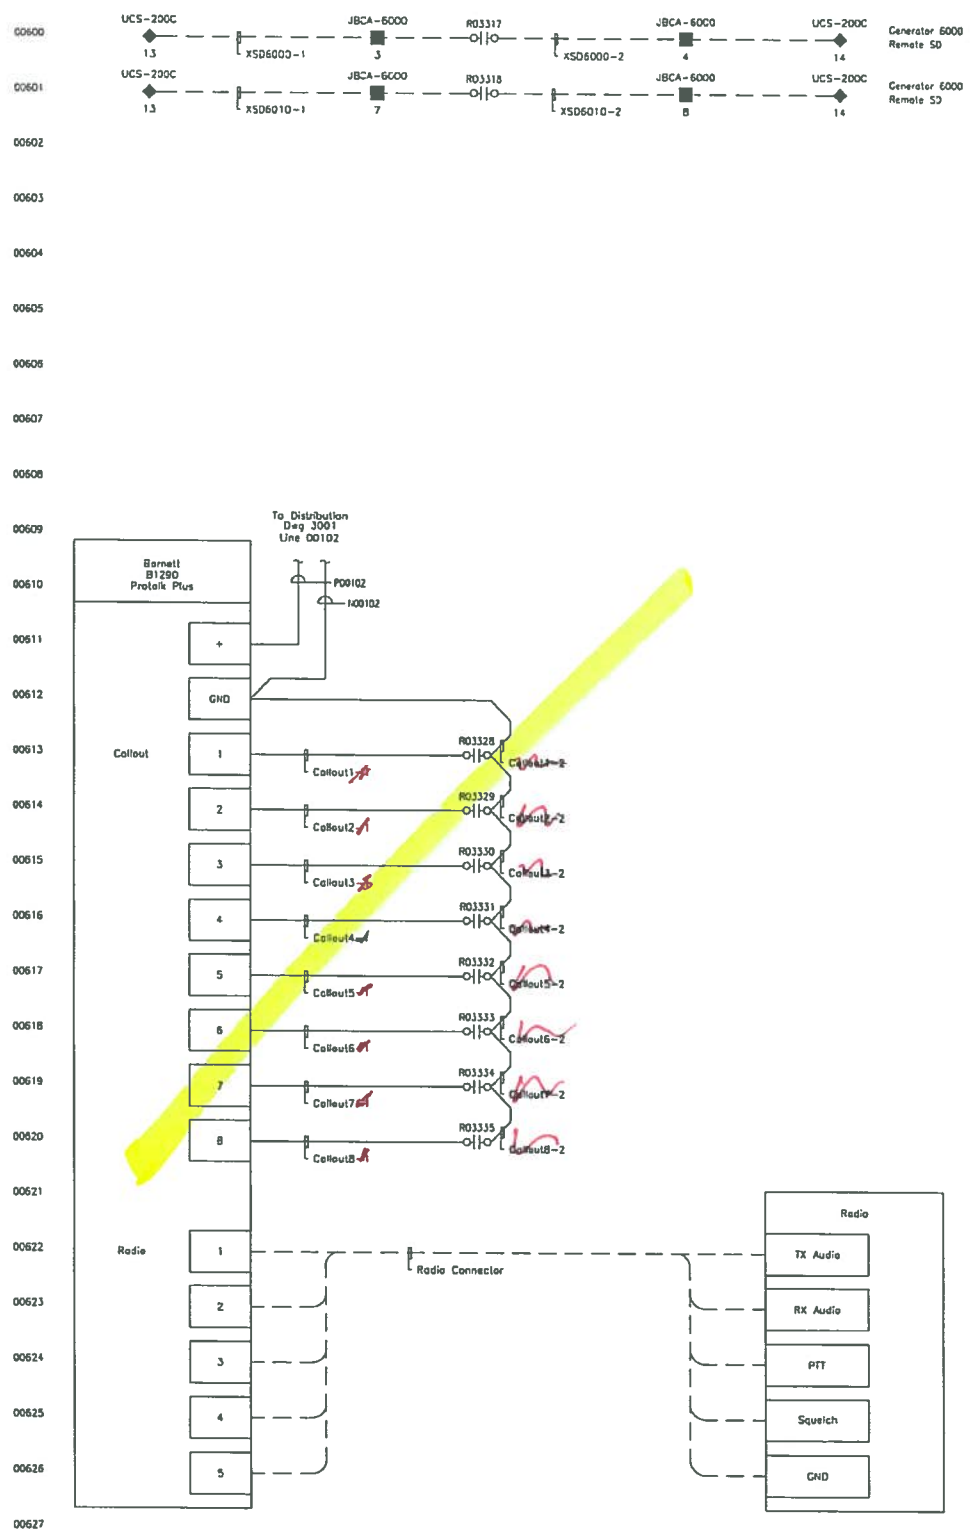

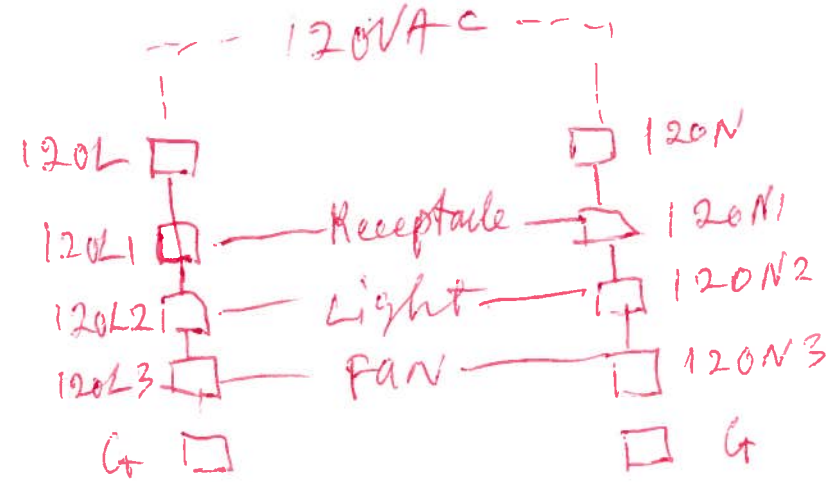

DRAWING#	REFERENCE DRAWING TITLE

REV	DATE	DESCRIPTION	DWN	CHKD	APPR
A	22JUL2013	ISSUED FOR REVIEW	RR	CF	–
B	08OCT2013	ISSUED FOR APPROVAL	R.R	MG	MG
0	21OCT2013	ISSUED FOR CONSTRUCTION	R.R	MG	MG

ENGINEER STAMP

PROFESSIONAL ENGINEER — PROVINCE OF BRITISH COLUMBIA — M. A. GHALY # 38913

OCT 2 4 2013

THIS DRAWING IS THE PROPERTY OF PENN WEST ENERGY TRUST AND ANY REPRODUCTION IN WHOLE OR PART WITHOUT EXPRESS WRITTEN PERMISSION IS PROHIBITED.

PIONEER ENGINEERING INC.

THIRD PARTY LOGO

SCALE: AS SHOWN | SIZE: D

EPCM PROJECT#: 13053

PennWest Exploration

CORDOVA – MULTI WELL TIE-IN
PENN WEST WELLSITE
d-055-A/094-P-10
24VDC SCHEMATIC

DWG# d055A094P10-ELC-3006 | SHT 2 OF 2 | REV 0

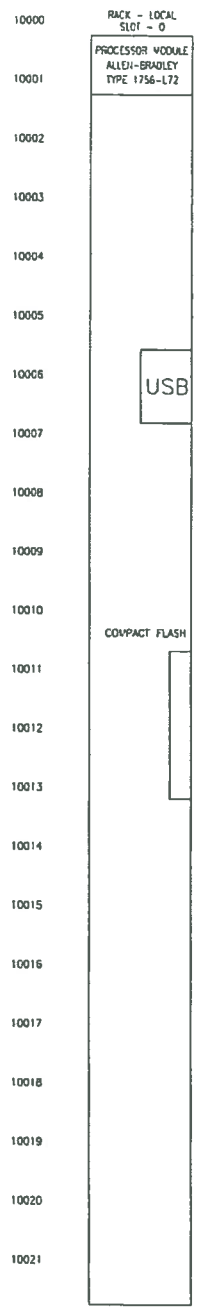

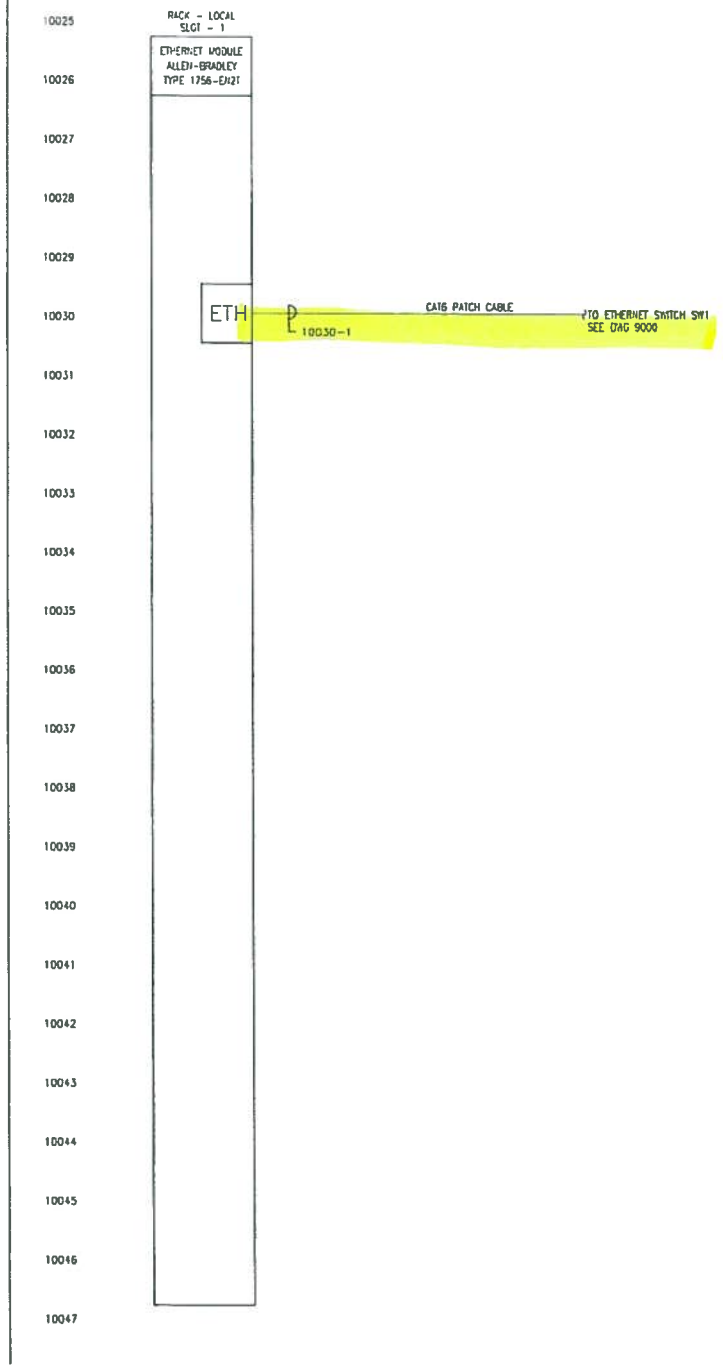

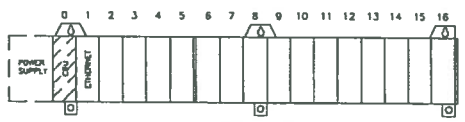

RACK "LOCAL"

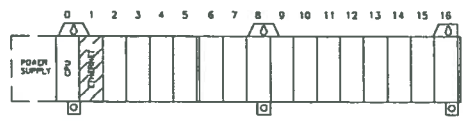

RACK "LOCAL"

DRAWING#	REFERENCE DRAWING TITLE

REV	DATE	DESCRIPTION	DWN	CHKD	APPR
A	22JUL2013	ISSUED FOR REVIEW	RR	CF	–
B	08OCT2013	ISSUED FOR APPROVAL	R.R	MG	MG
0	21OCT2013	ISSUED FOR CONSTRUCTION	R.R	MG	MG

ENGINEER STAMP

PROFESSIONAL ENGINEER
PROVINCE OF BRITISH COLUMBIA
M. A. GHALY
38913

OCT 2 4 2013

THIS DRAWING IS THE PROPERTY OF PENN WEST ENERGY TRUST AND
ANY REPRODUCTION IN WHOLE OR PART WITHOUT EXPRESS WRITTEN PERMISSION IS PROHIBITED.

PIONEER ENGINEERING INC.

THIRD PARTY LOGO

SCALE: AS SHOWN | SIZE: D

EPCM PROJECT#: 13053

PennWest Exploration

CORDOVA – MULTI WELL TIE-IN
PENN WEST WELLSITE
d-055-A/094-P-10
IO SCHEMATICS

DWG# d055A094P10-ELC-3020 | SHT 1 OF 17 | REV 0

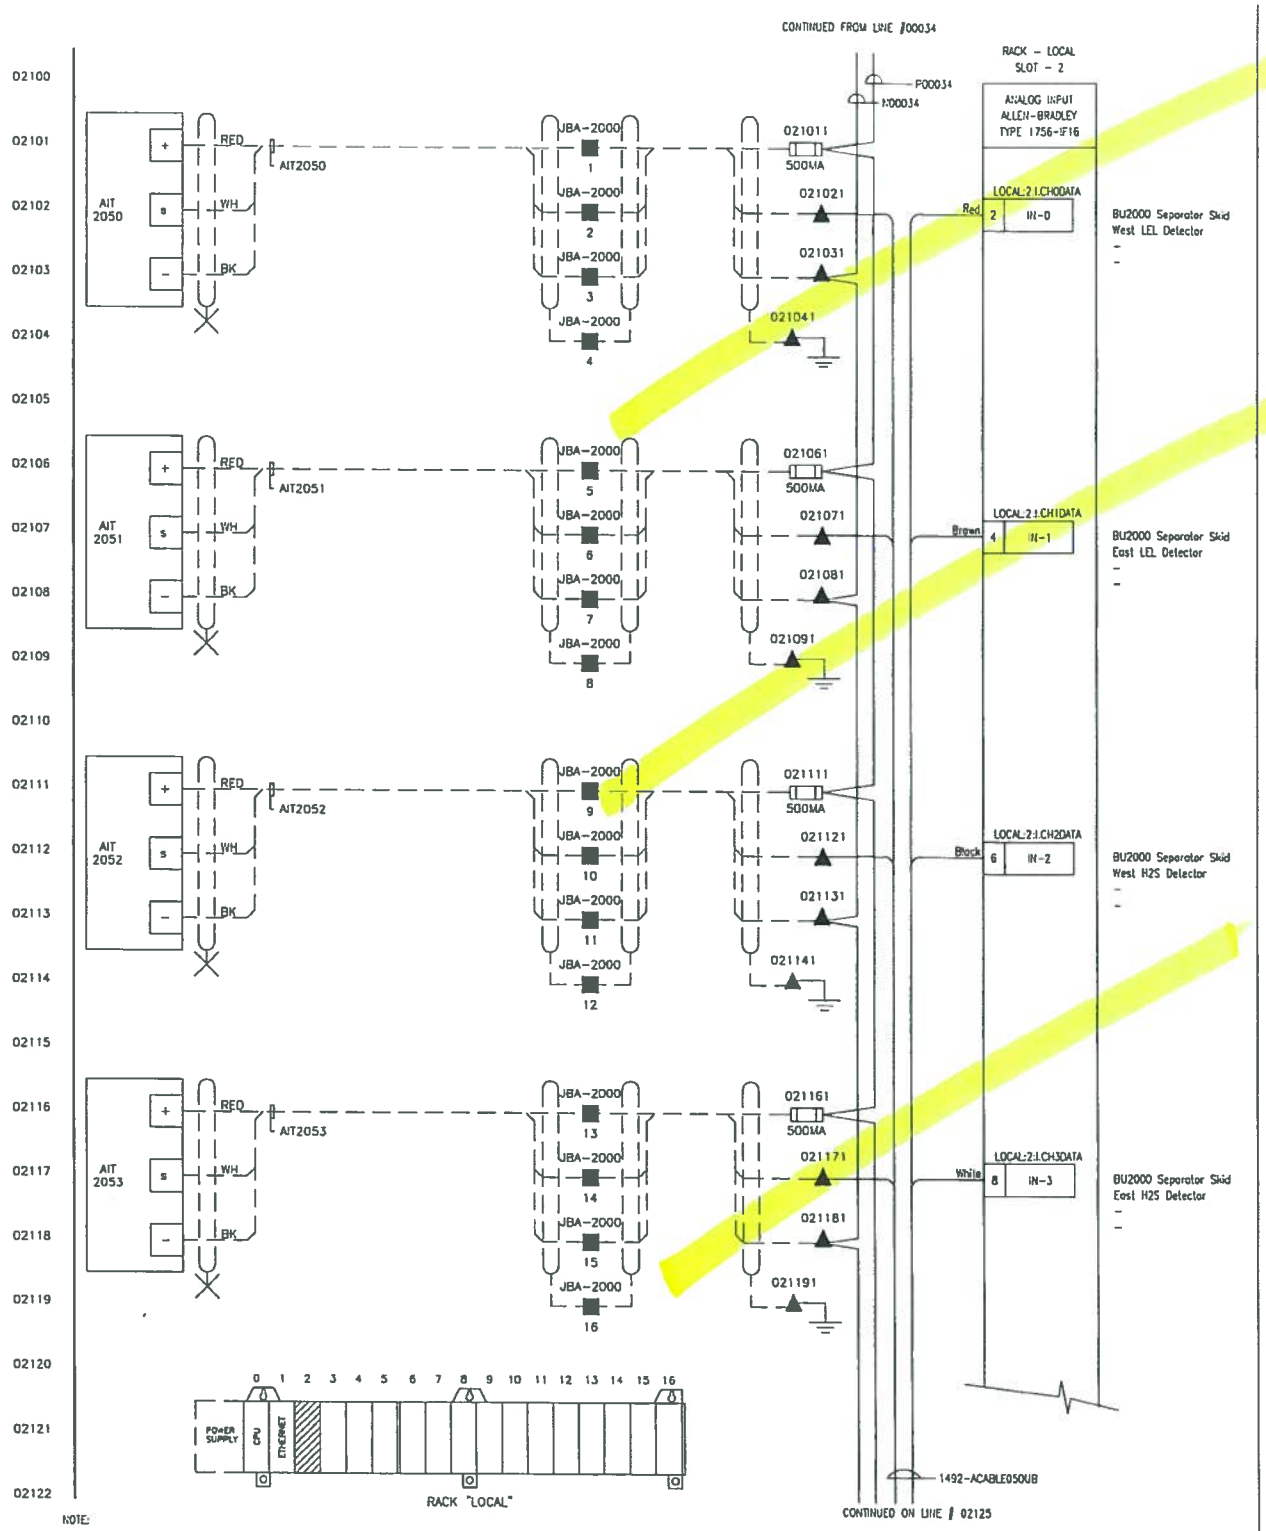

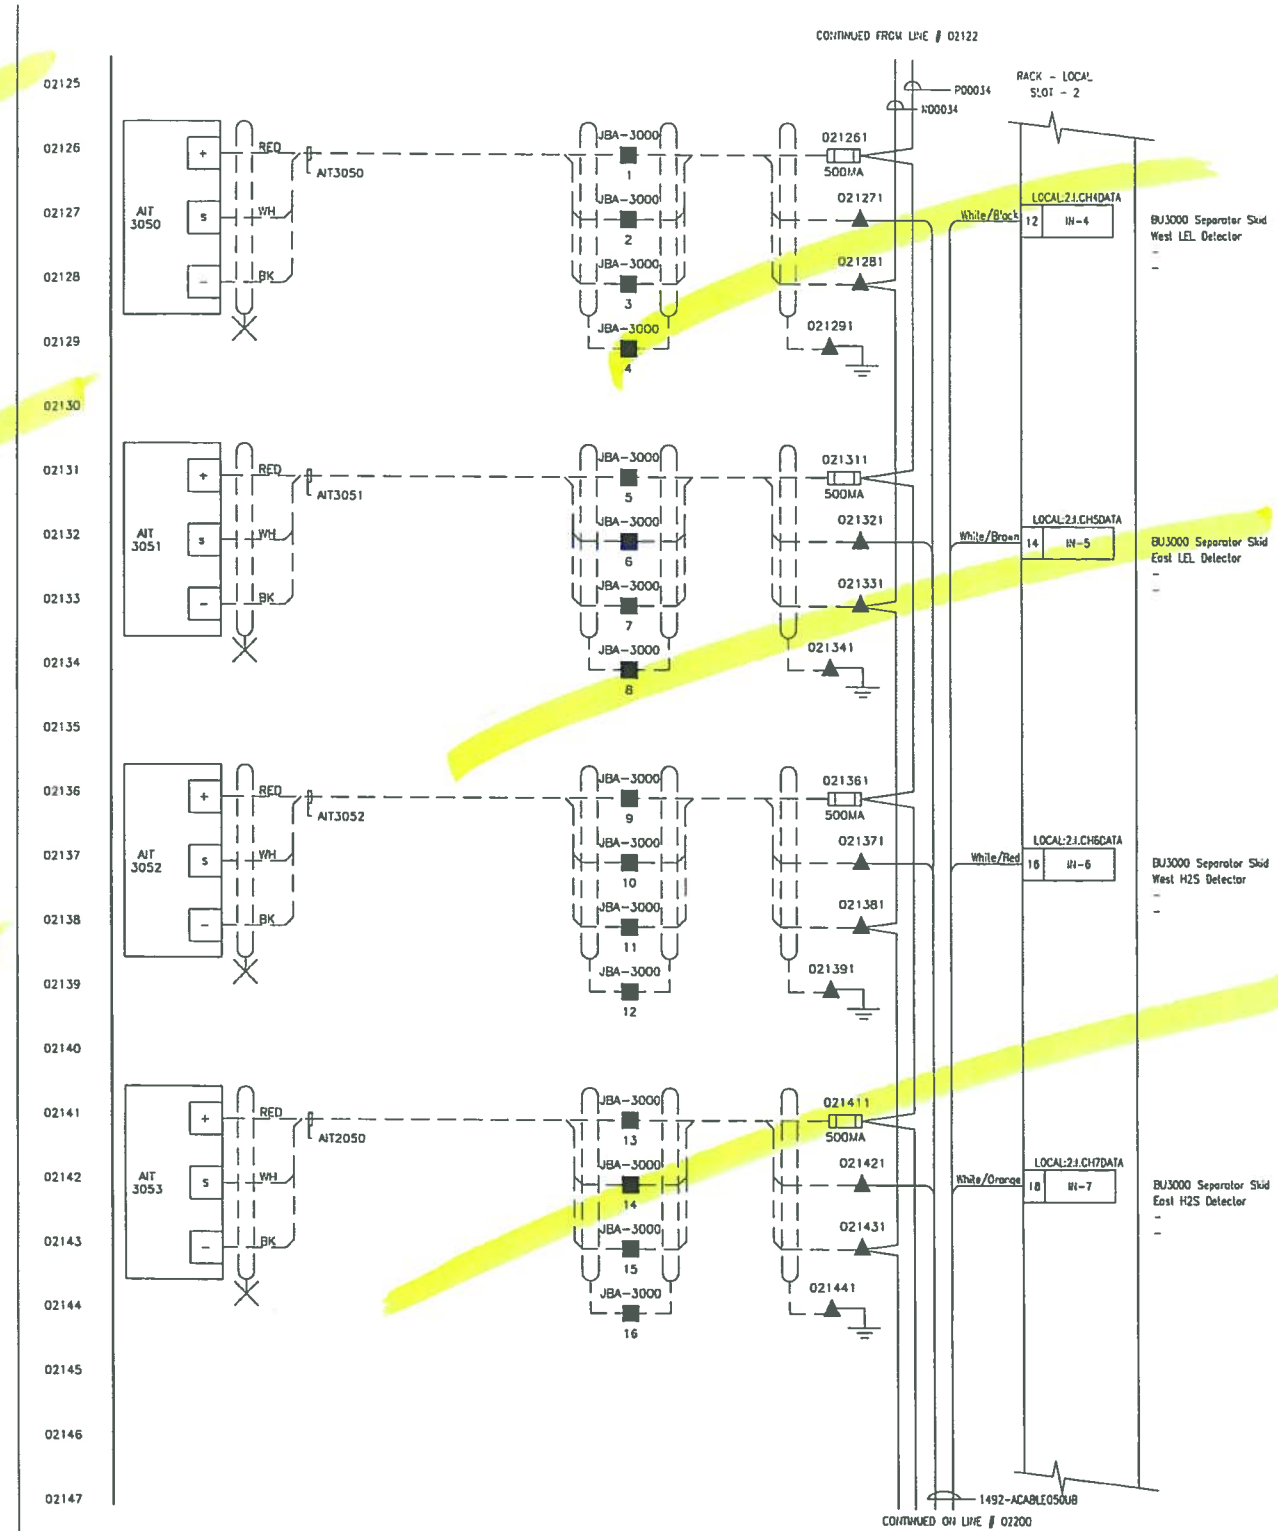

DRAWING#	REFERENCE DRAWING TITLE

REV	DATE	DESCRIPTION	DWN	CHKD	APPR
A	22JUL2013	ISSUED FOR REVIEW	RR	CF	-
B	08OCT2013	ISSUED FOR APPROVAL	R.R	MG	MG
0	21OCT2013	ISSUED FOR CONSTRUCTION	R.R	MG	MG

ENGINEER STAMP

PROFESSIONAL ENGINEER PROVINCE OF BRITISH COLUMBIA M. A. GHALY # 38913

OCT 2 4 2013

THIS DRAWING IS THE PROPERTY OF PENN WEST ENERGY TRUST AND ANY REPRODUCTION IN WHOLE OR PART WITHOUT EXPRESS WRITTEN PERMISSION IS PROHIBITED.

PIONEER ENGINEERING INC.

THIRD PARTY LOGO

SCALE	AS SHOWN	SIZE: D
EPCM PROJECT#: 13053		

PennWest Exploration

CORDOVA - MULTI WELL TIE-IN
PENN WEST WELLSITE
d-055-A/094-P-10
IO SCHEMATICS

DWG# d055A094P10-ELC-3021 | SHT 2 OF 17 | REV 0

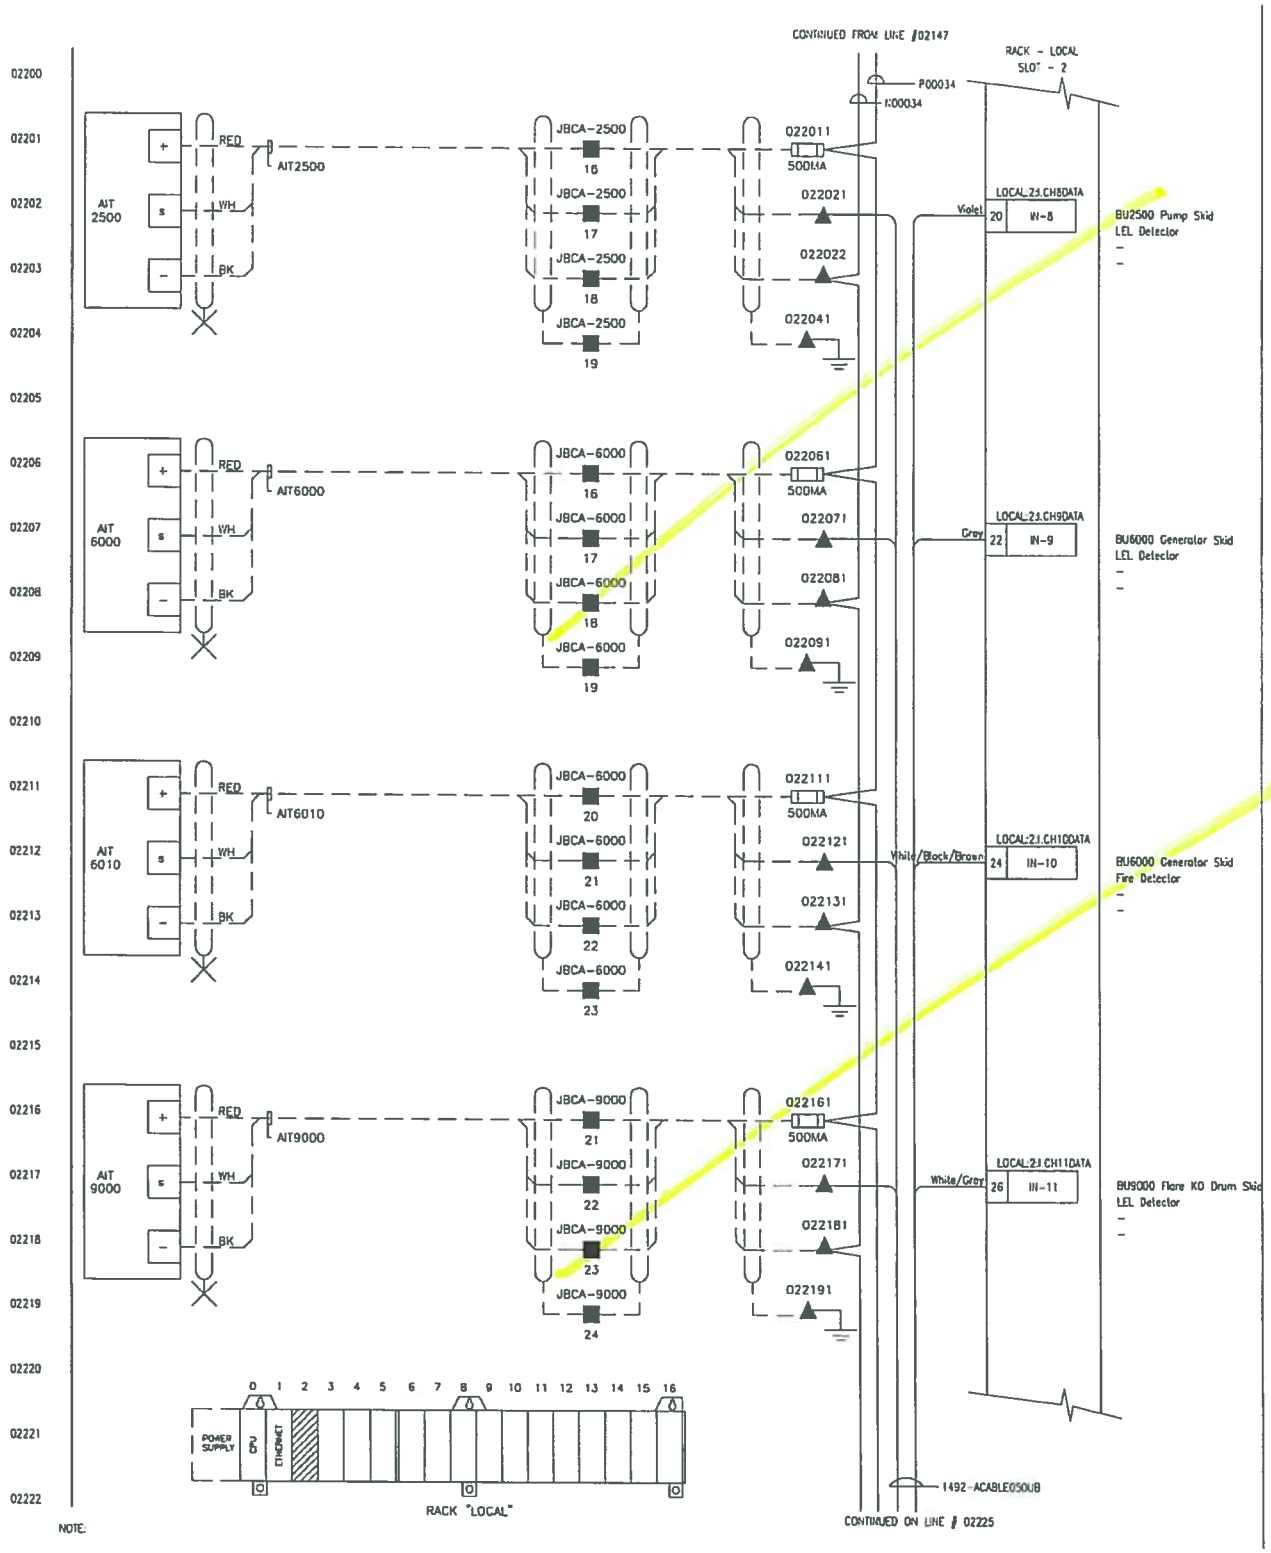

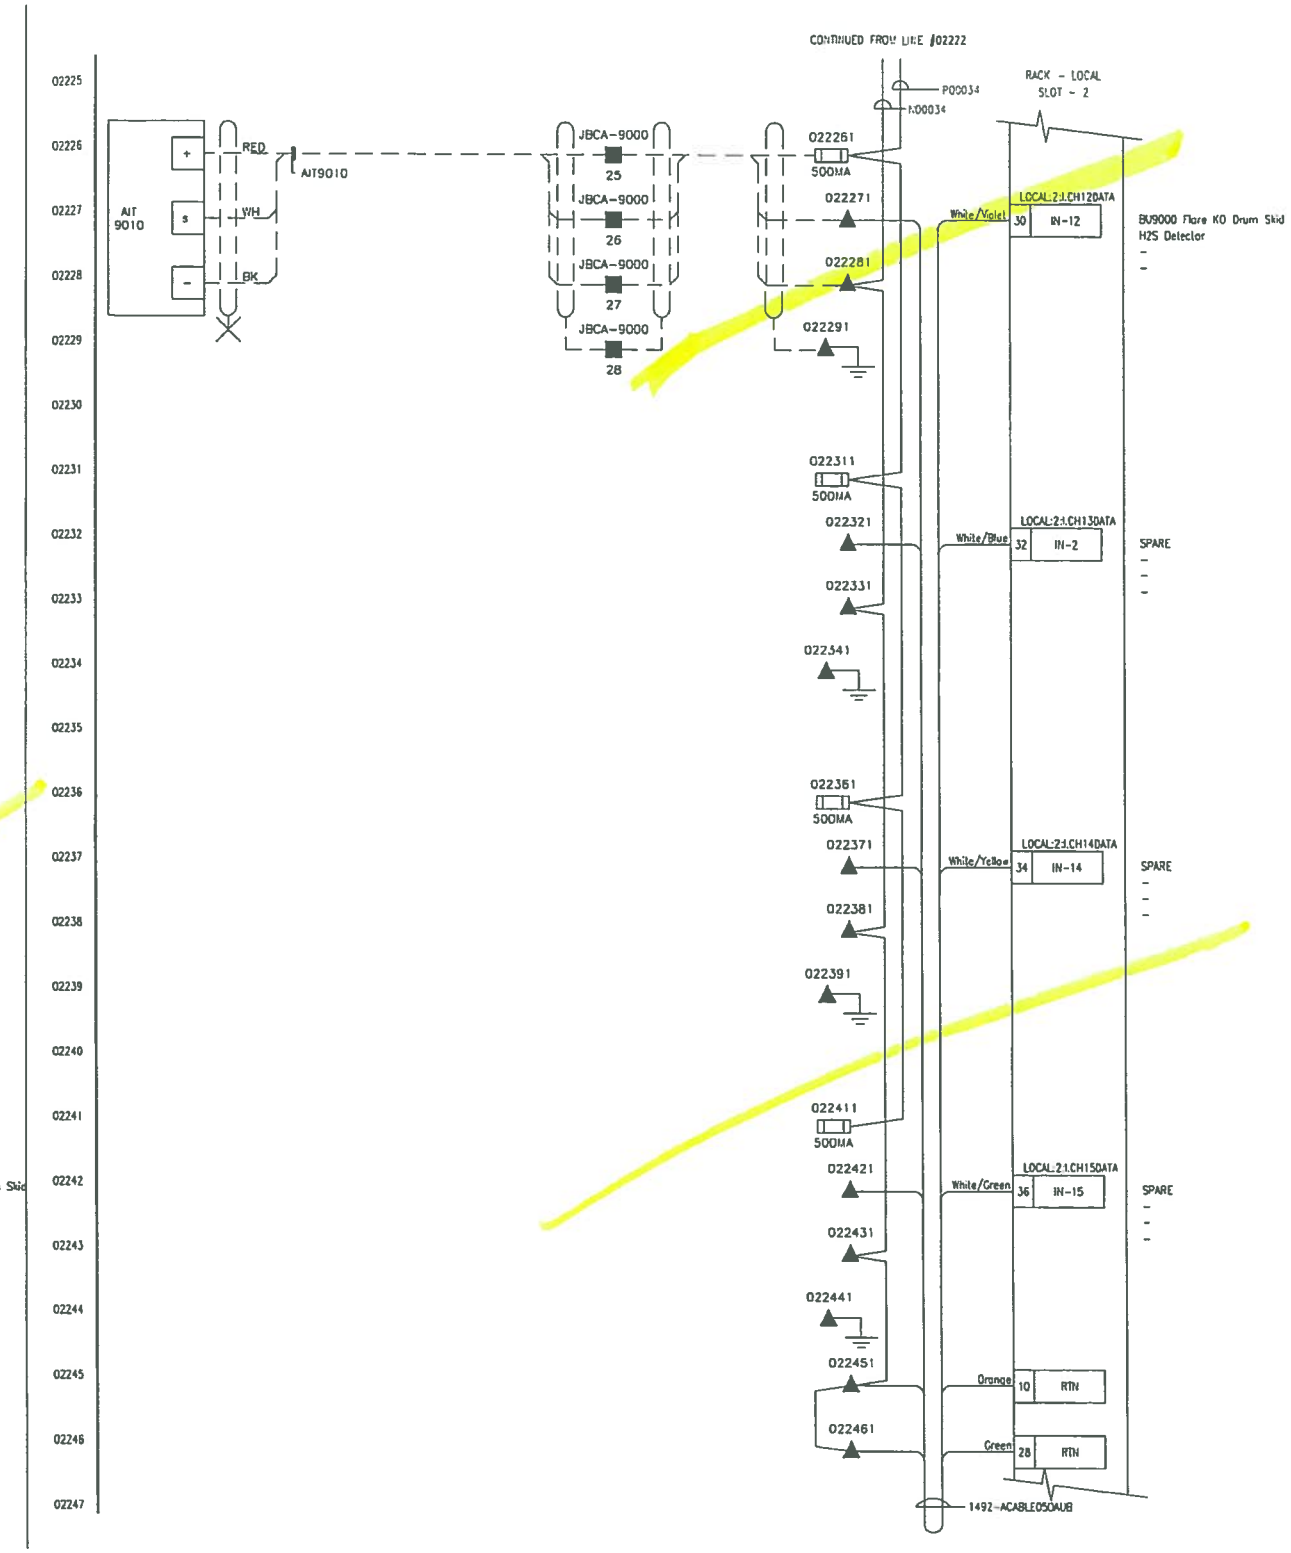

DRAWING#	REFERENCE DRAWING TITLE

REV	DATE	DESCRIPTION	DWN	CHKD	APPR
A	22JUL2013	ISSUED FOR REVIEW	RR	CF	–
B	08OCT2013	ISSUED FOR APPROVAL	R.R	MG	MG
0	21OCT2013	ISSUED FOR CONSTRUCTION	R.R	MG	MG

ENGINEER STAMP

PROFESSIONAL ENGINEER PROVINCE OF BRITISH COLUMBIA
M. A. GHALY
38913

OCT 2 4 2013

THIS DRAWING IS THE PROPERTY OF PENN WEST ENERGY TRUST AND ANY REPRODUCTION IN WHOLE OR PART WITHOUT EXPRESS WRITTEN PERMISSION IS PROHIBITED.

PIONEER ENGINEERING INC.

THIRD PARTY LOGO

SCALE: AS SHOWN | SIZE: D

EPCM PROJECT#: 13053

PennWest Exploration

CORDOVA – MULTI WELL TIE-IN
PENN WEST WELLSITE
d-055-A/094-P-10
IO SCHEMATICS

DWG# d055A094P10-ELC-3022 | SHT 3 OF 17 | REV 0

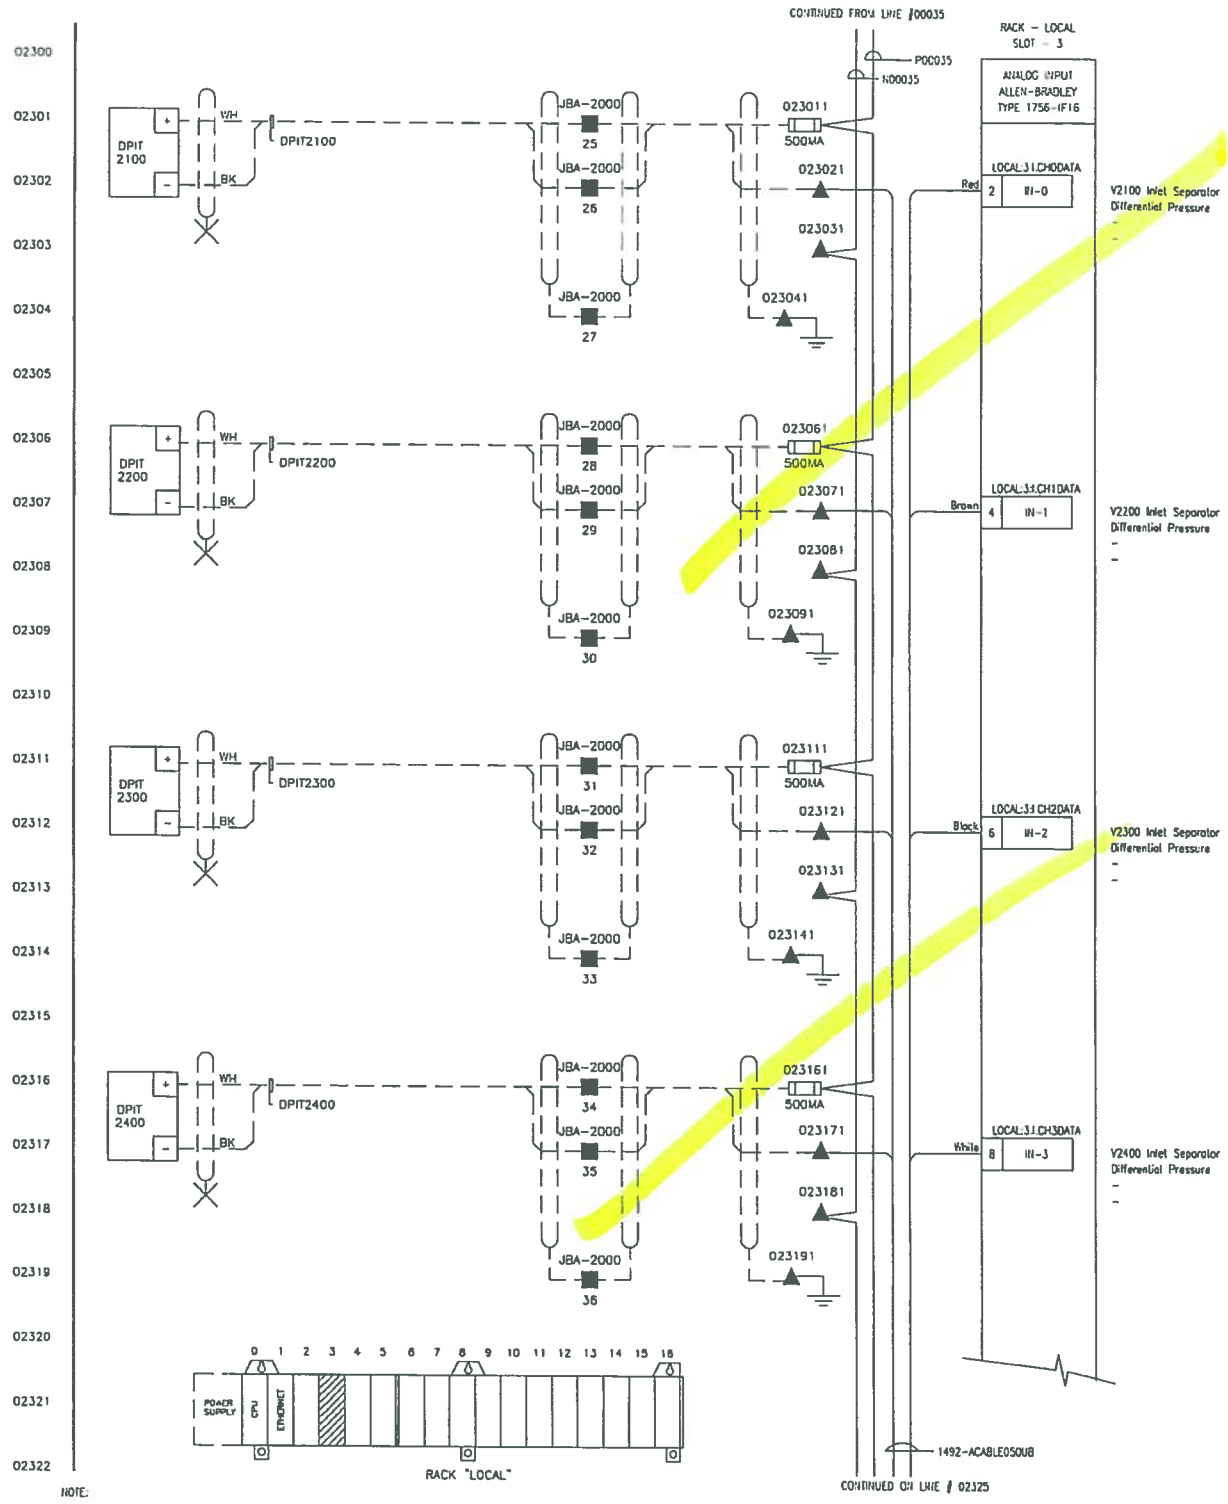

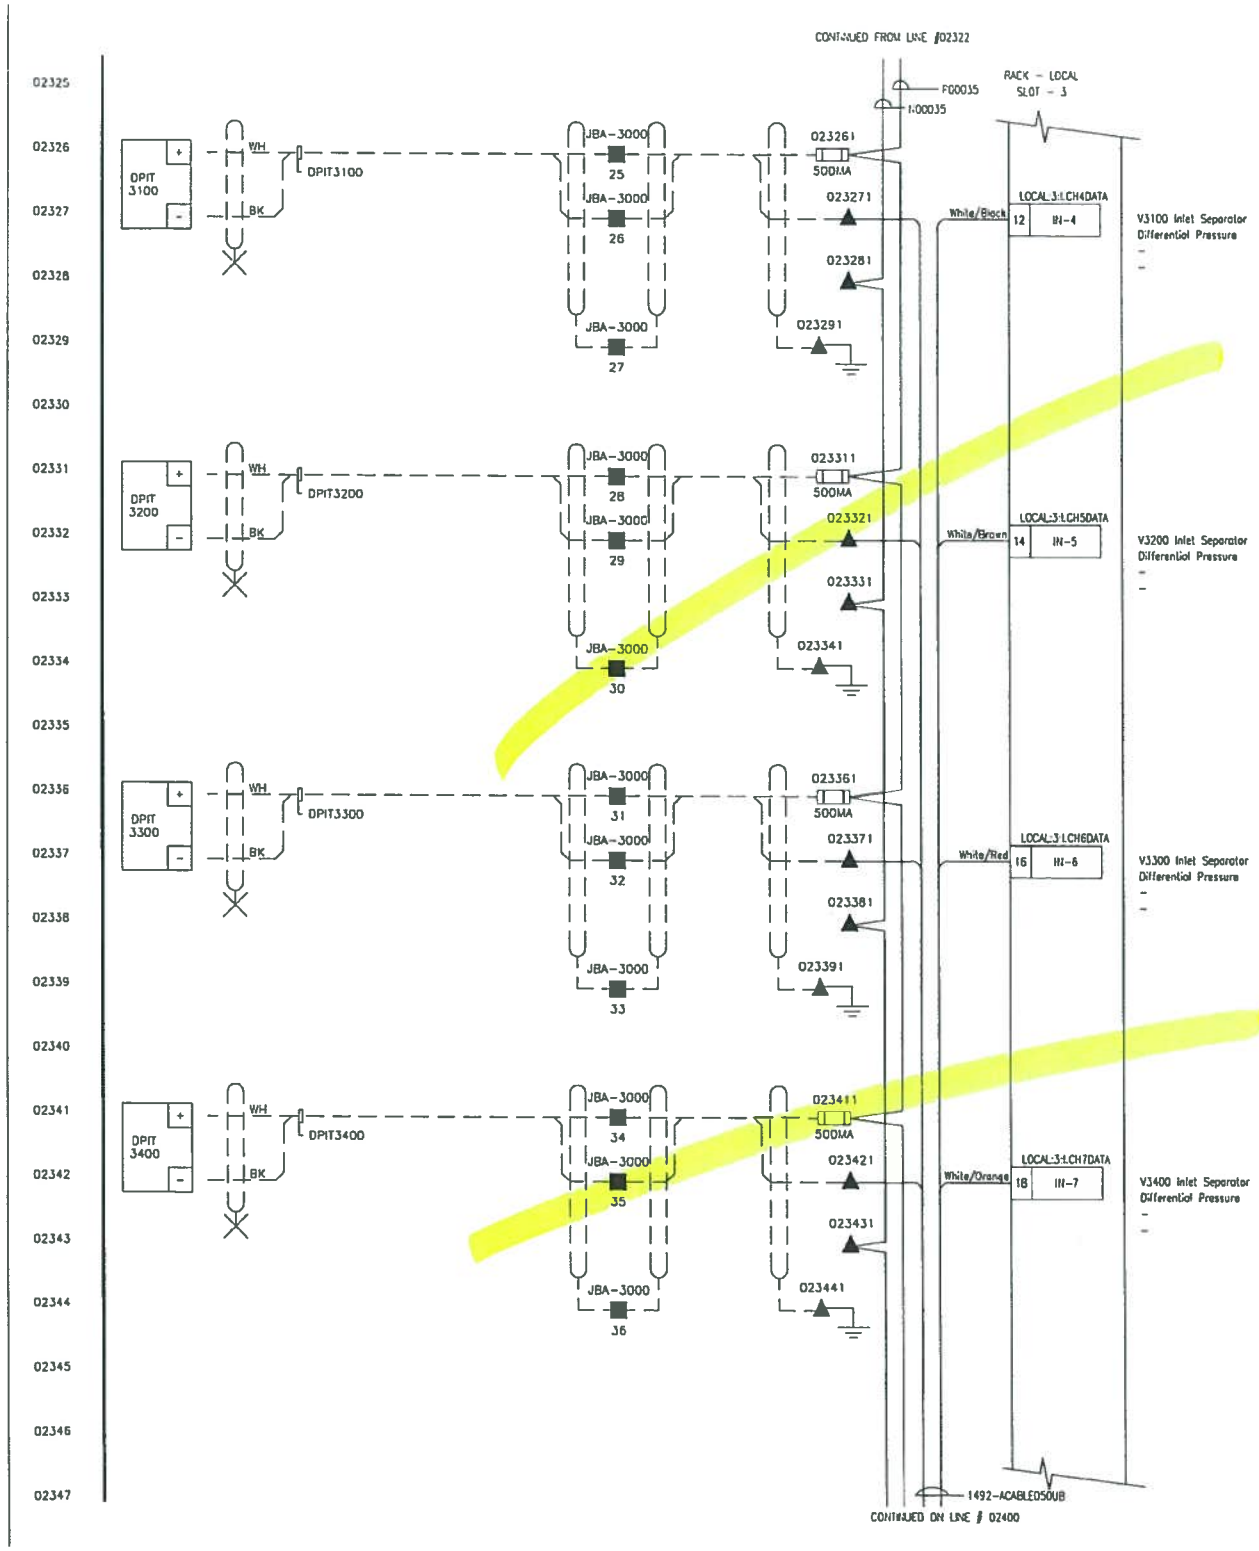

DRAWING#	REFERENCE DRAWING TITLE

REV	DATE	DESCRIPTION	DWN	CHKD	APPR
A	22JUL2013	ISSUED FOR REVIEW	RR	CF	–
B	08OCT2013	ISSUED FOR APPROVAL	R.R	MG	MG
0	21OCT2013	ISSUED FOR CONSTRUCTION	R.R	MG	MG

ENGINEER STAMP

PROFESSIONAL ENGINEER – PROVINCE OF BRITISH COLUMBIA – M. A. GHALY # 38913

OCT 2 4 2013

THIS DRAWING IS THE PROPERTY OF PENN WEST ENERGY TRUST AND ANY REPRODUCTION IN WHOLE OR PART WITHOUT EXPRESS WRITTEN PERMISSION IS PROHIBITED.

PIONEER ENGINEERING INC.

THIRD PARTY LOGO

SCALE: AS SHOWN | SIZE: D

EPCM PROJECT#: 13053

PennWest Exploration

CORDOVA – MULTI WELL TIE-IN
PENN WEST WELLSITE
d-055-A/094-P-10
IO SCHEMATICS

DWG# d055A094P10-ELC-3023 | SHT 4 OF 17 | REV 0

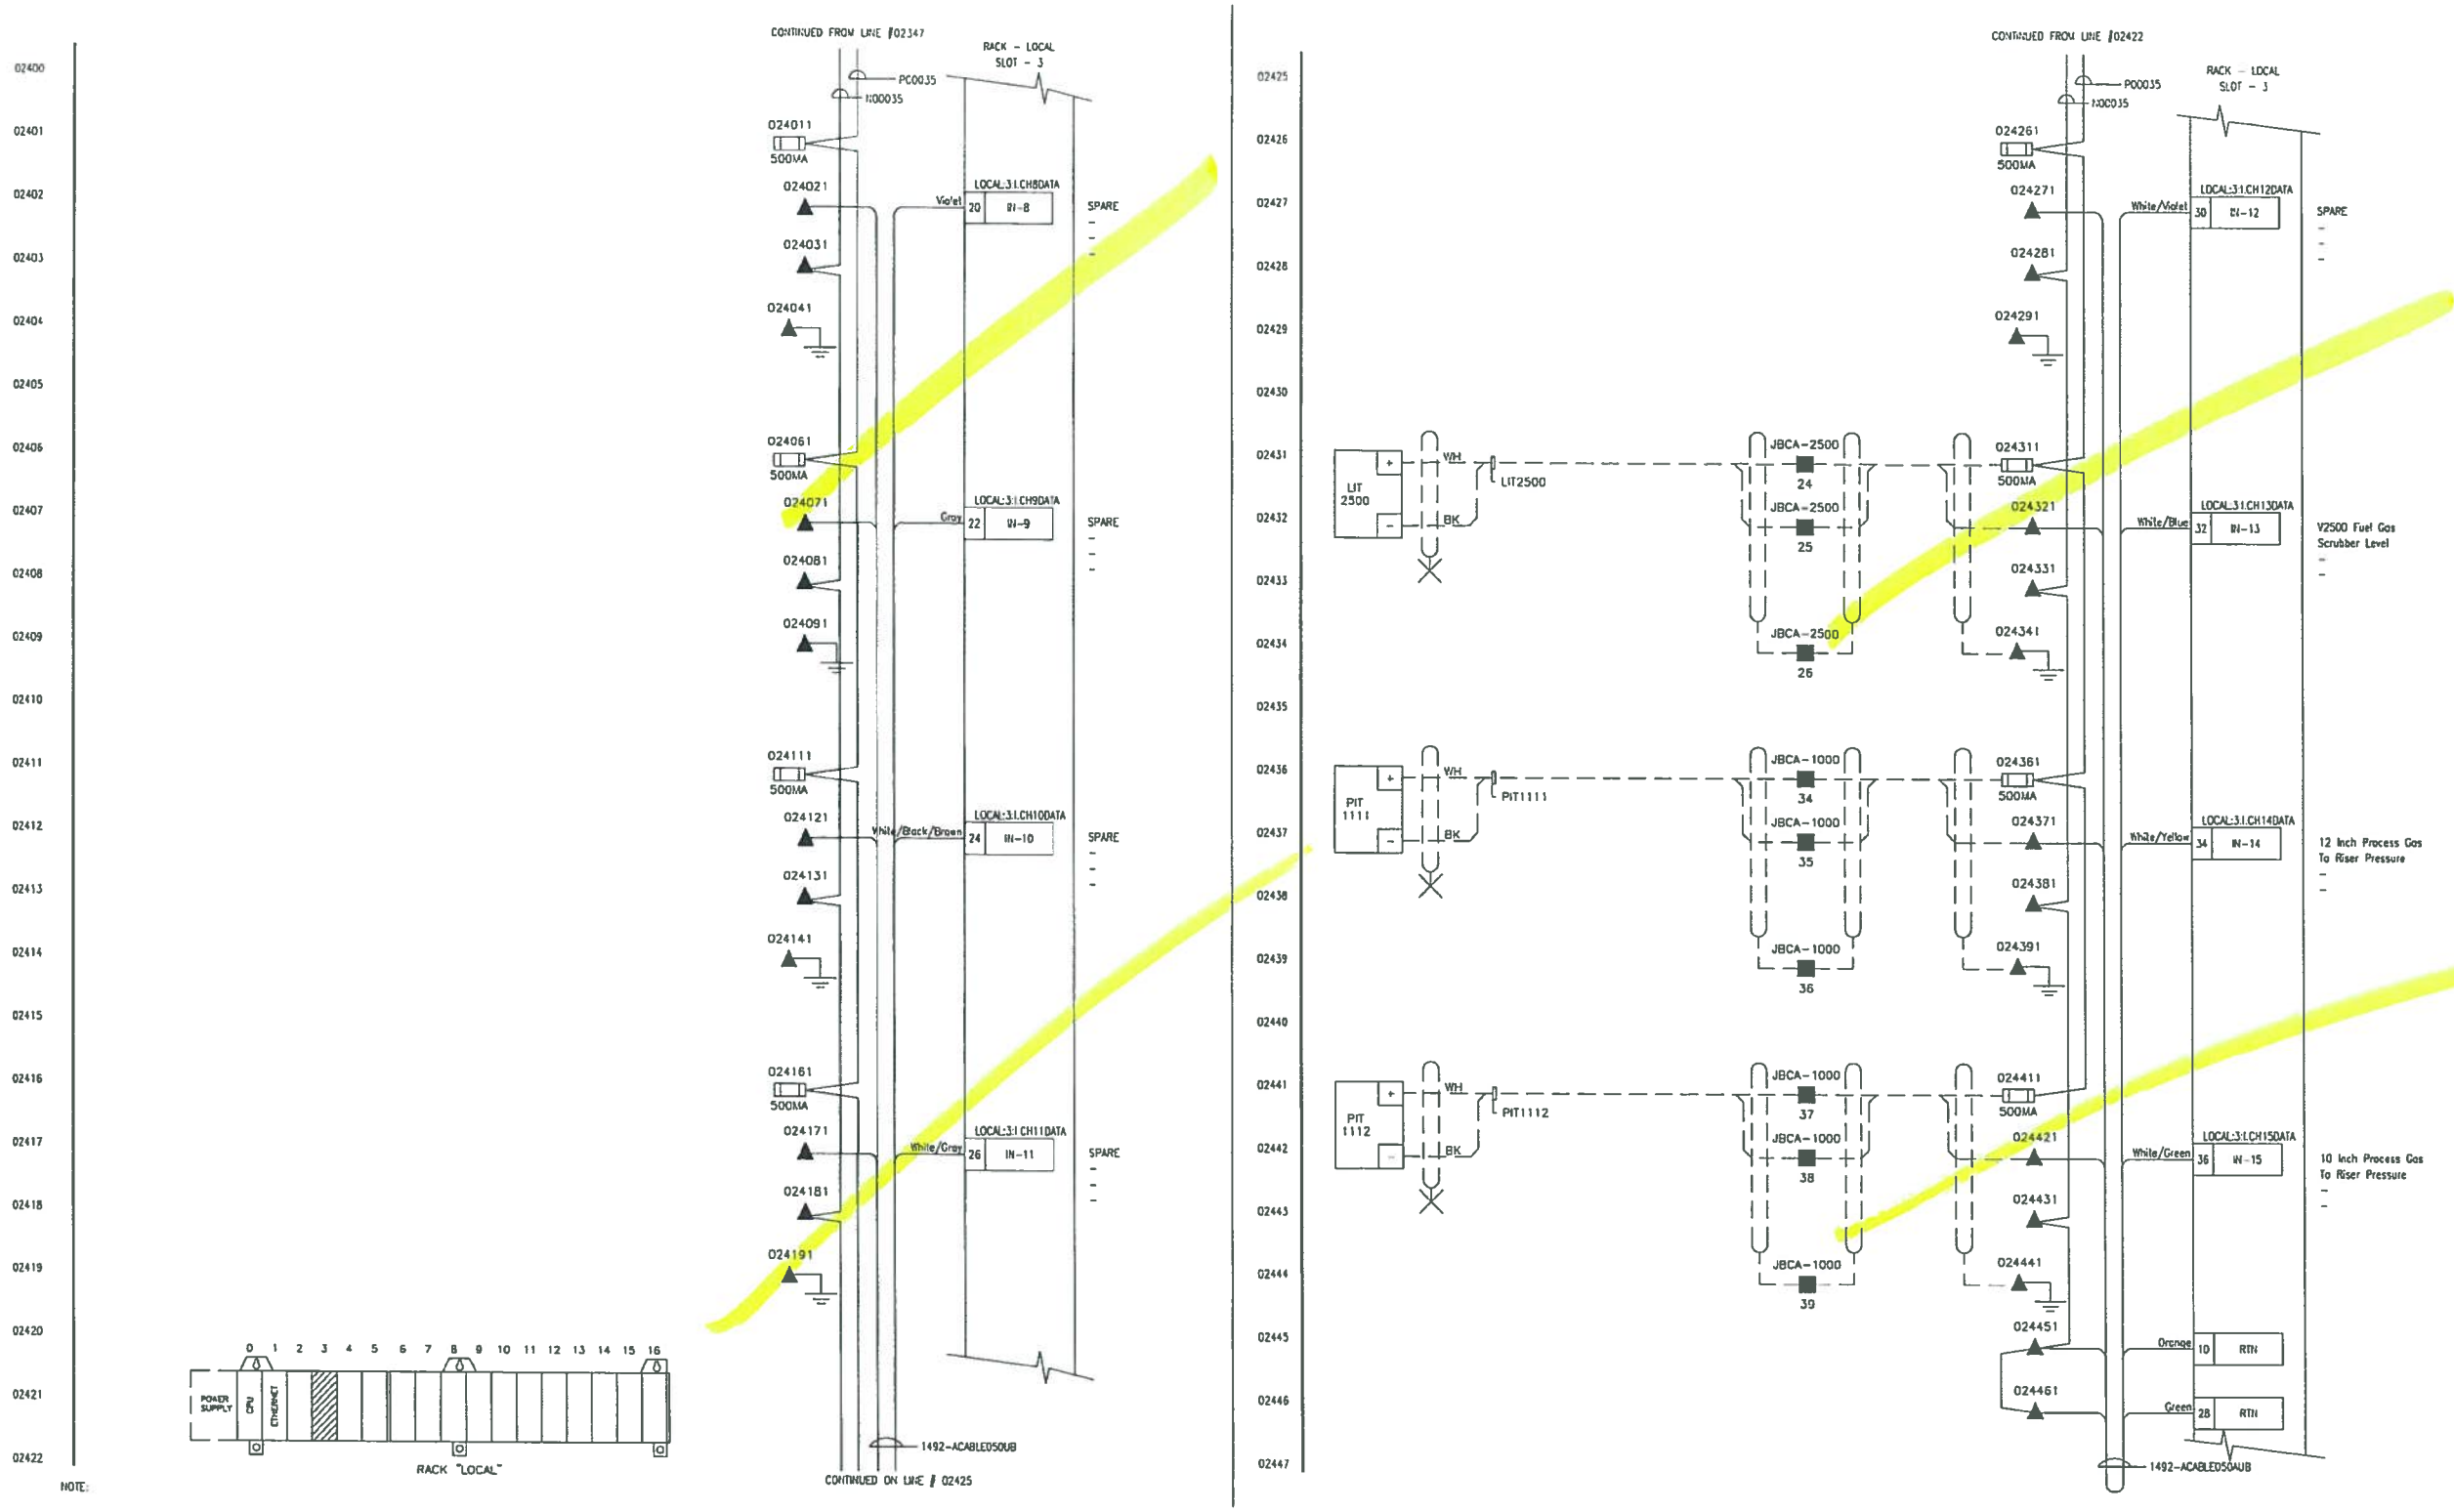

DRAWING#	REFERENCE DRAWING TITLE

REV	DATE	DESCRIPTION	DWN	CHKD	APPR
A	22JUL2013	ISSUED FOR REVIEW	RR	CF	–
B	08OCT2013	ISSUED FOR APPROVAL	R.R	MG	MG
0	21OCT2013	ISSUED FOR CONSTRUCTION	R.R	MG	MG

ENGINEER STAMP

PROFESSIONAL ENGINEER — PROVINCE OF BRITISH COLUMBIA — M. A. GHALY # 38913

OCT 2 4 2013

THIS DRAWING IS THE PROPERTY OF PENN WEST ENERGY TRUST AND ANY REPRODUCTION IN WHOLE OR PART WITHOUT EXPRESS WRITTEN PERMISSION IS PROHIBITED.

PIONEER ENGINEERING INC.

THIRD PARTY LOGO

SCALE: AS SHOWN | SIZE: D

EPCM PROJECT#: 13053

PennWest Exploration

CORDOVA – MULTI WELL TIE-IN
PENN WEST WELLSITE
d-055-A/094-P-10
IO SCHEMATICS

DWG# d055A094P10-ELC-3024 | SHT 5 OF 17 | REV 0

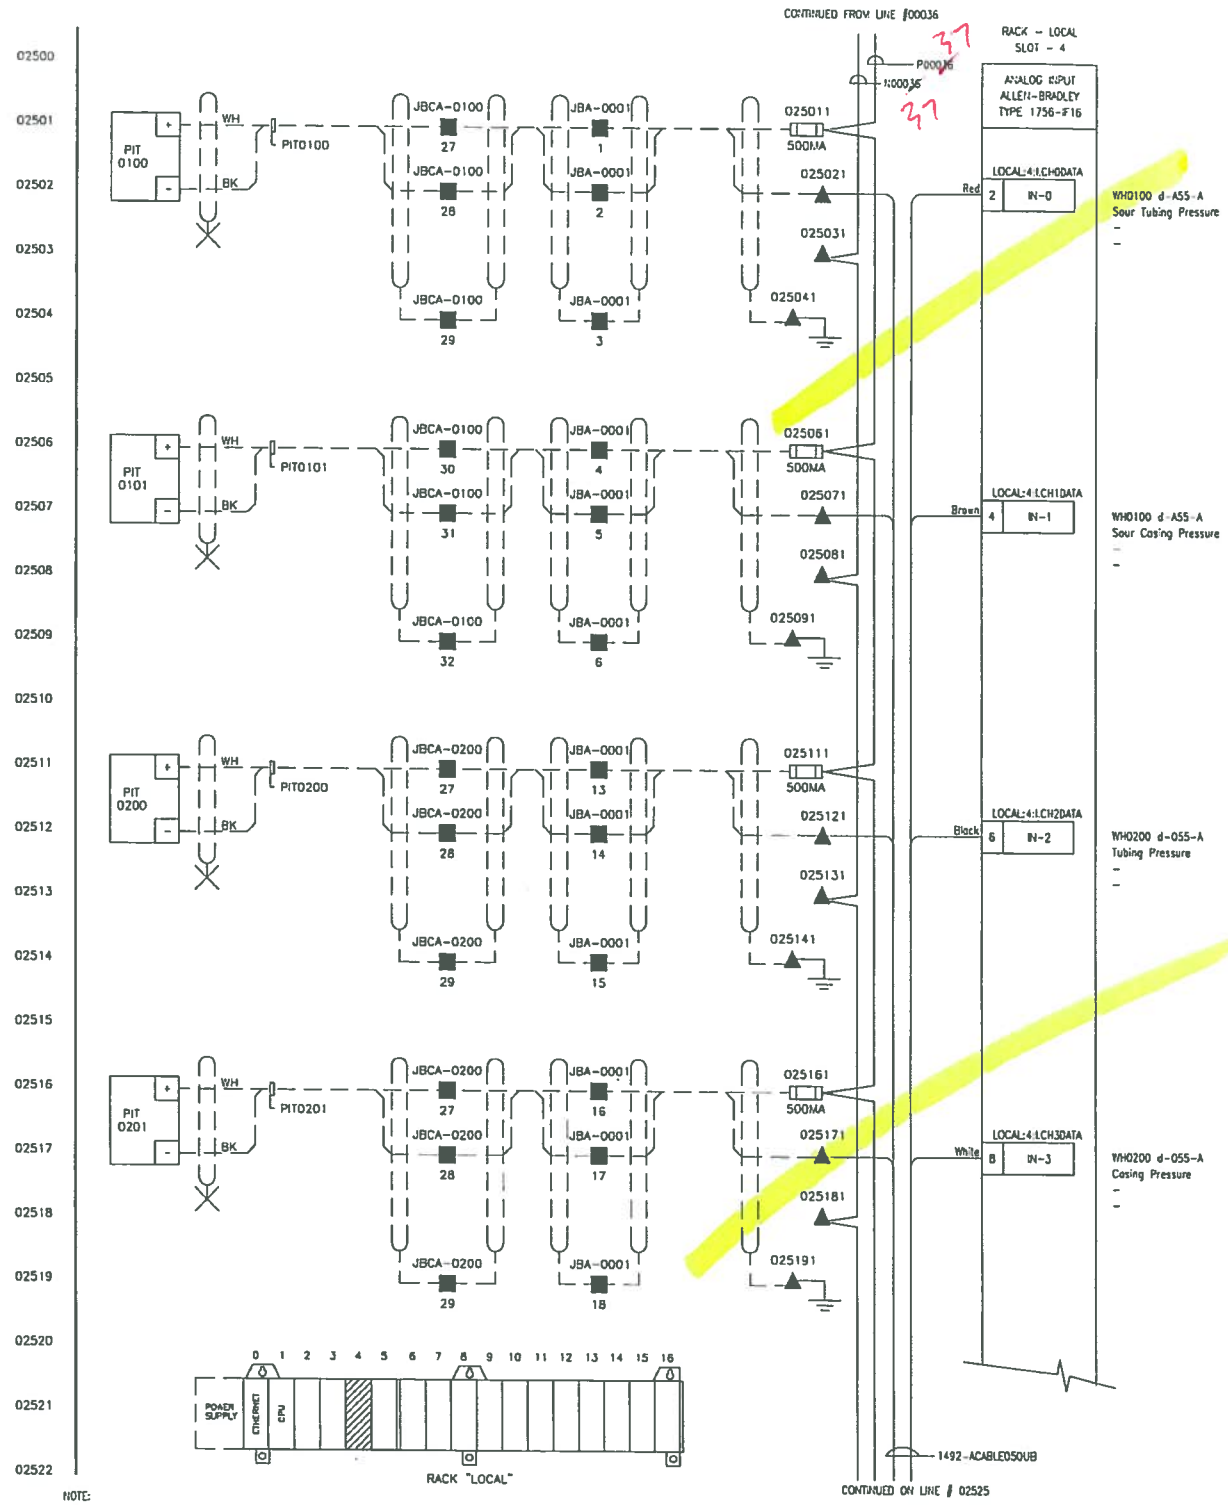

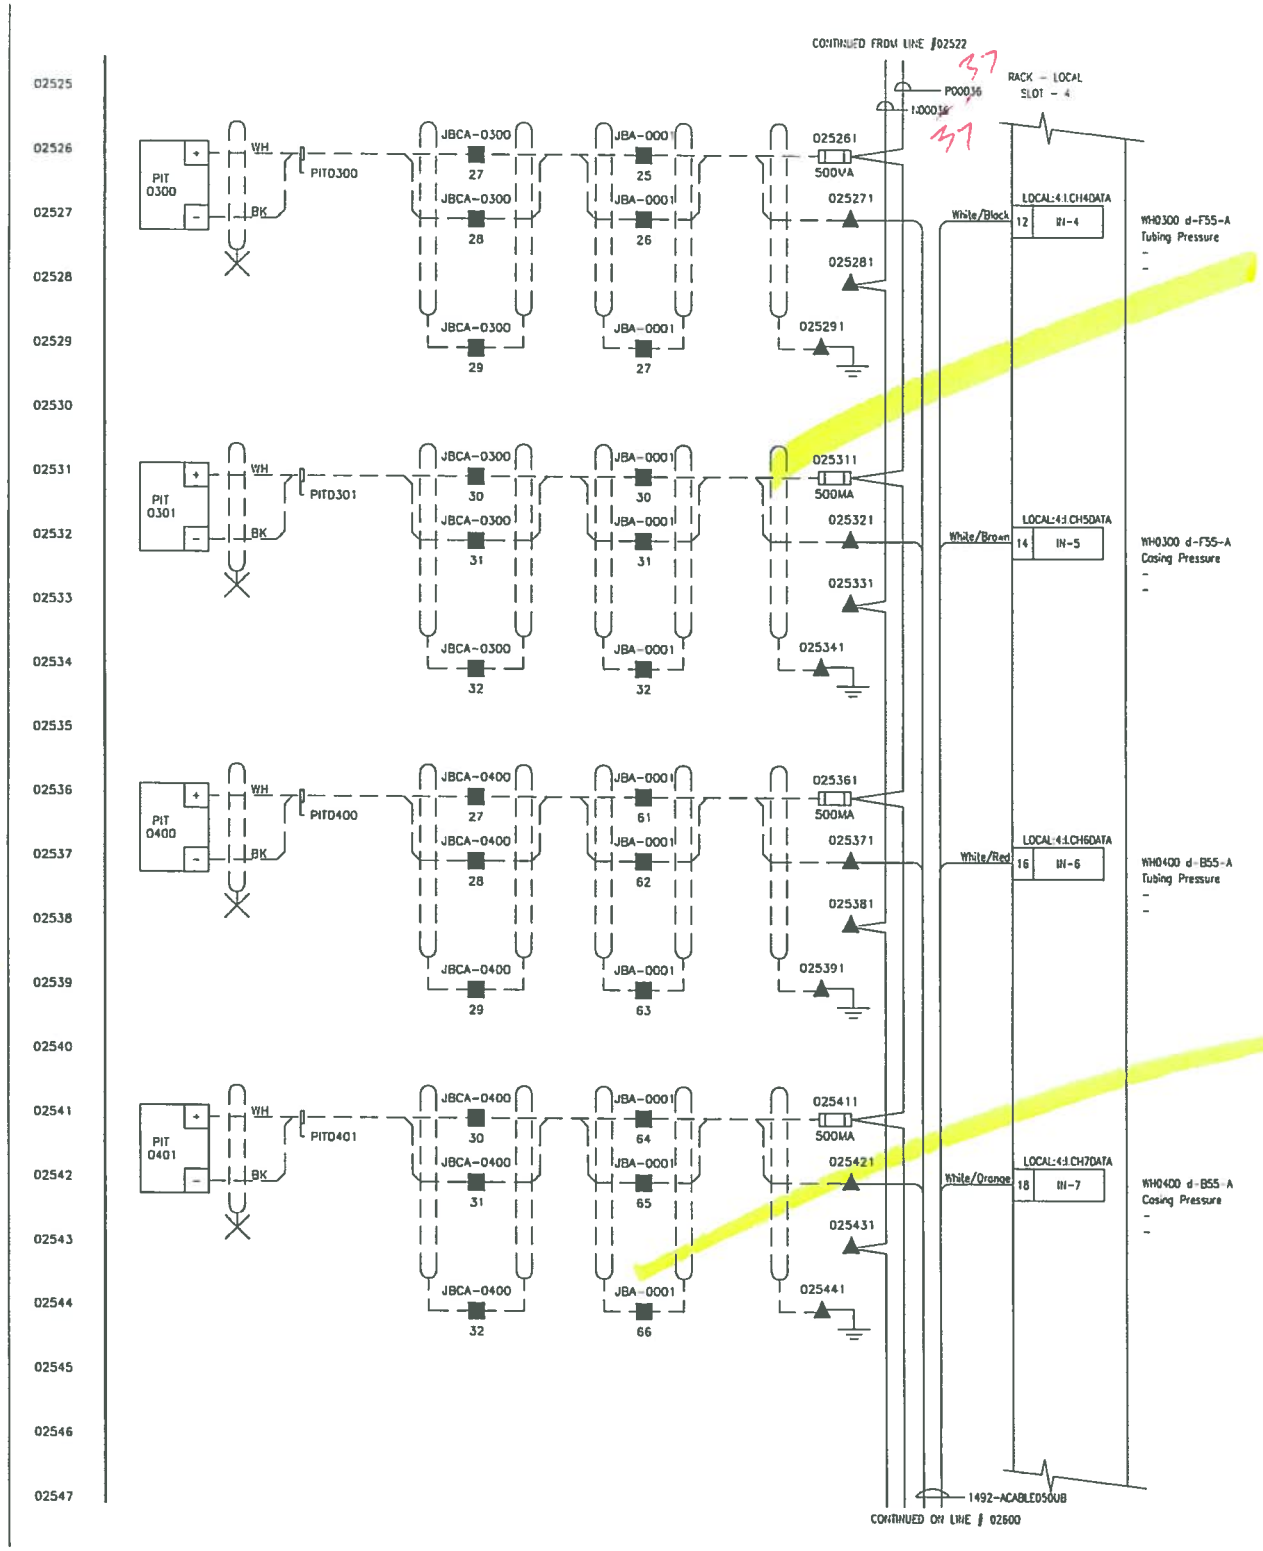

DRAWING#	REFERENCE DRAWING TITLE

REV	DATE	DESCRIPTION	DWN	CHKD	APPR
A	22JUL2013	ISSUED FOR REVIEW	RR	CF	–
B	08OCT2013	ISSUED FOR APPROVAL	R.R	MG	MG
0	21OCT2013	ISSUED FOR CONSTRUCTION	R.R	MG	MG

ENGINEER STAMP

PROFESSIONAL ENGINEER – PROVINCE OF ALBERTA – M. A. GHALY # 38913

OCT 2 4 2013

THIS DRAWING IS THE PROPERTY OF PENN WEST ENERGY TRUST AND ANY REPRODUCTION IN WHOLE OR PART WITHOUT EXPRESS WRITTEN PERMISSION IS PROHIBITED.

PIONEER ENGINEERING INC.

THIRD PARTY LOGO

SCALE	AS SHOWN	SIZE: D
EPCM PROJECT#: 13053		

PennWest Exploration

CORDOVA – MULTI WELL TIE-IN
PENN WEST WELLSITE
d-055-A/094-P-10
IO SCHEMATICS

DWG# d055A094P10-ELC-3025 | SHT 6 OF 17 | REV 0

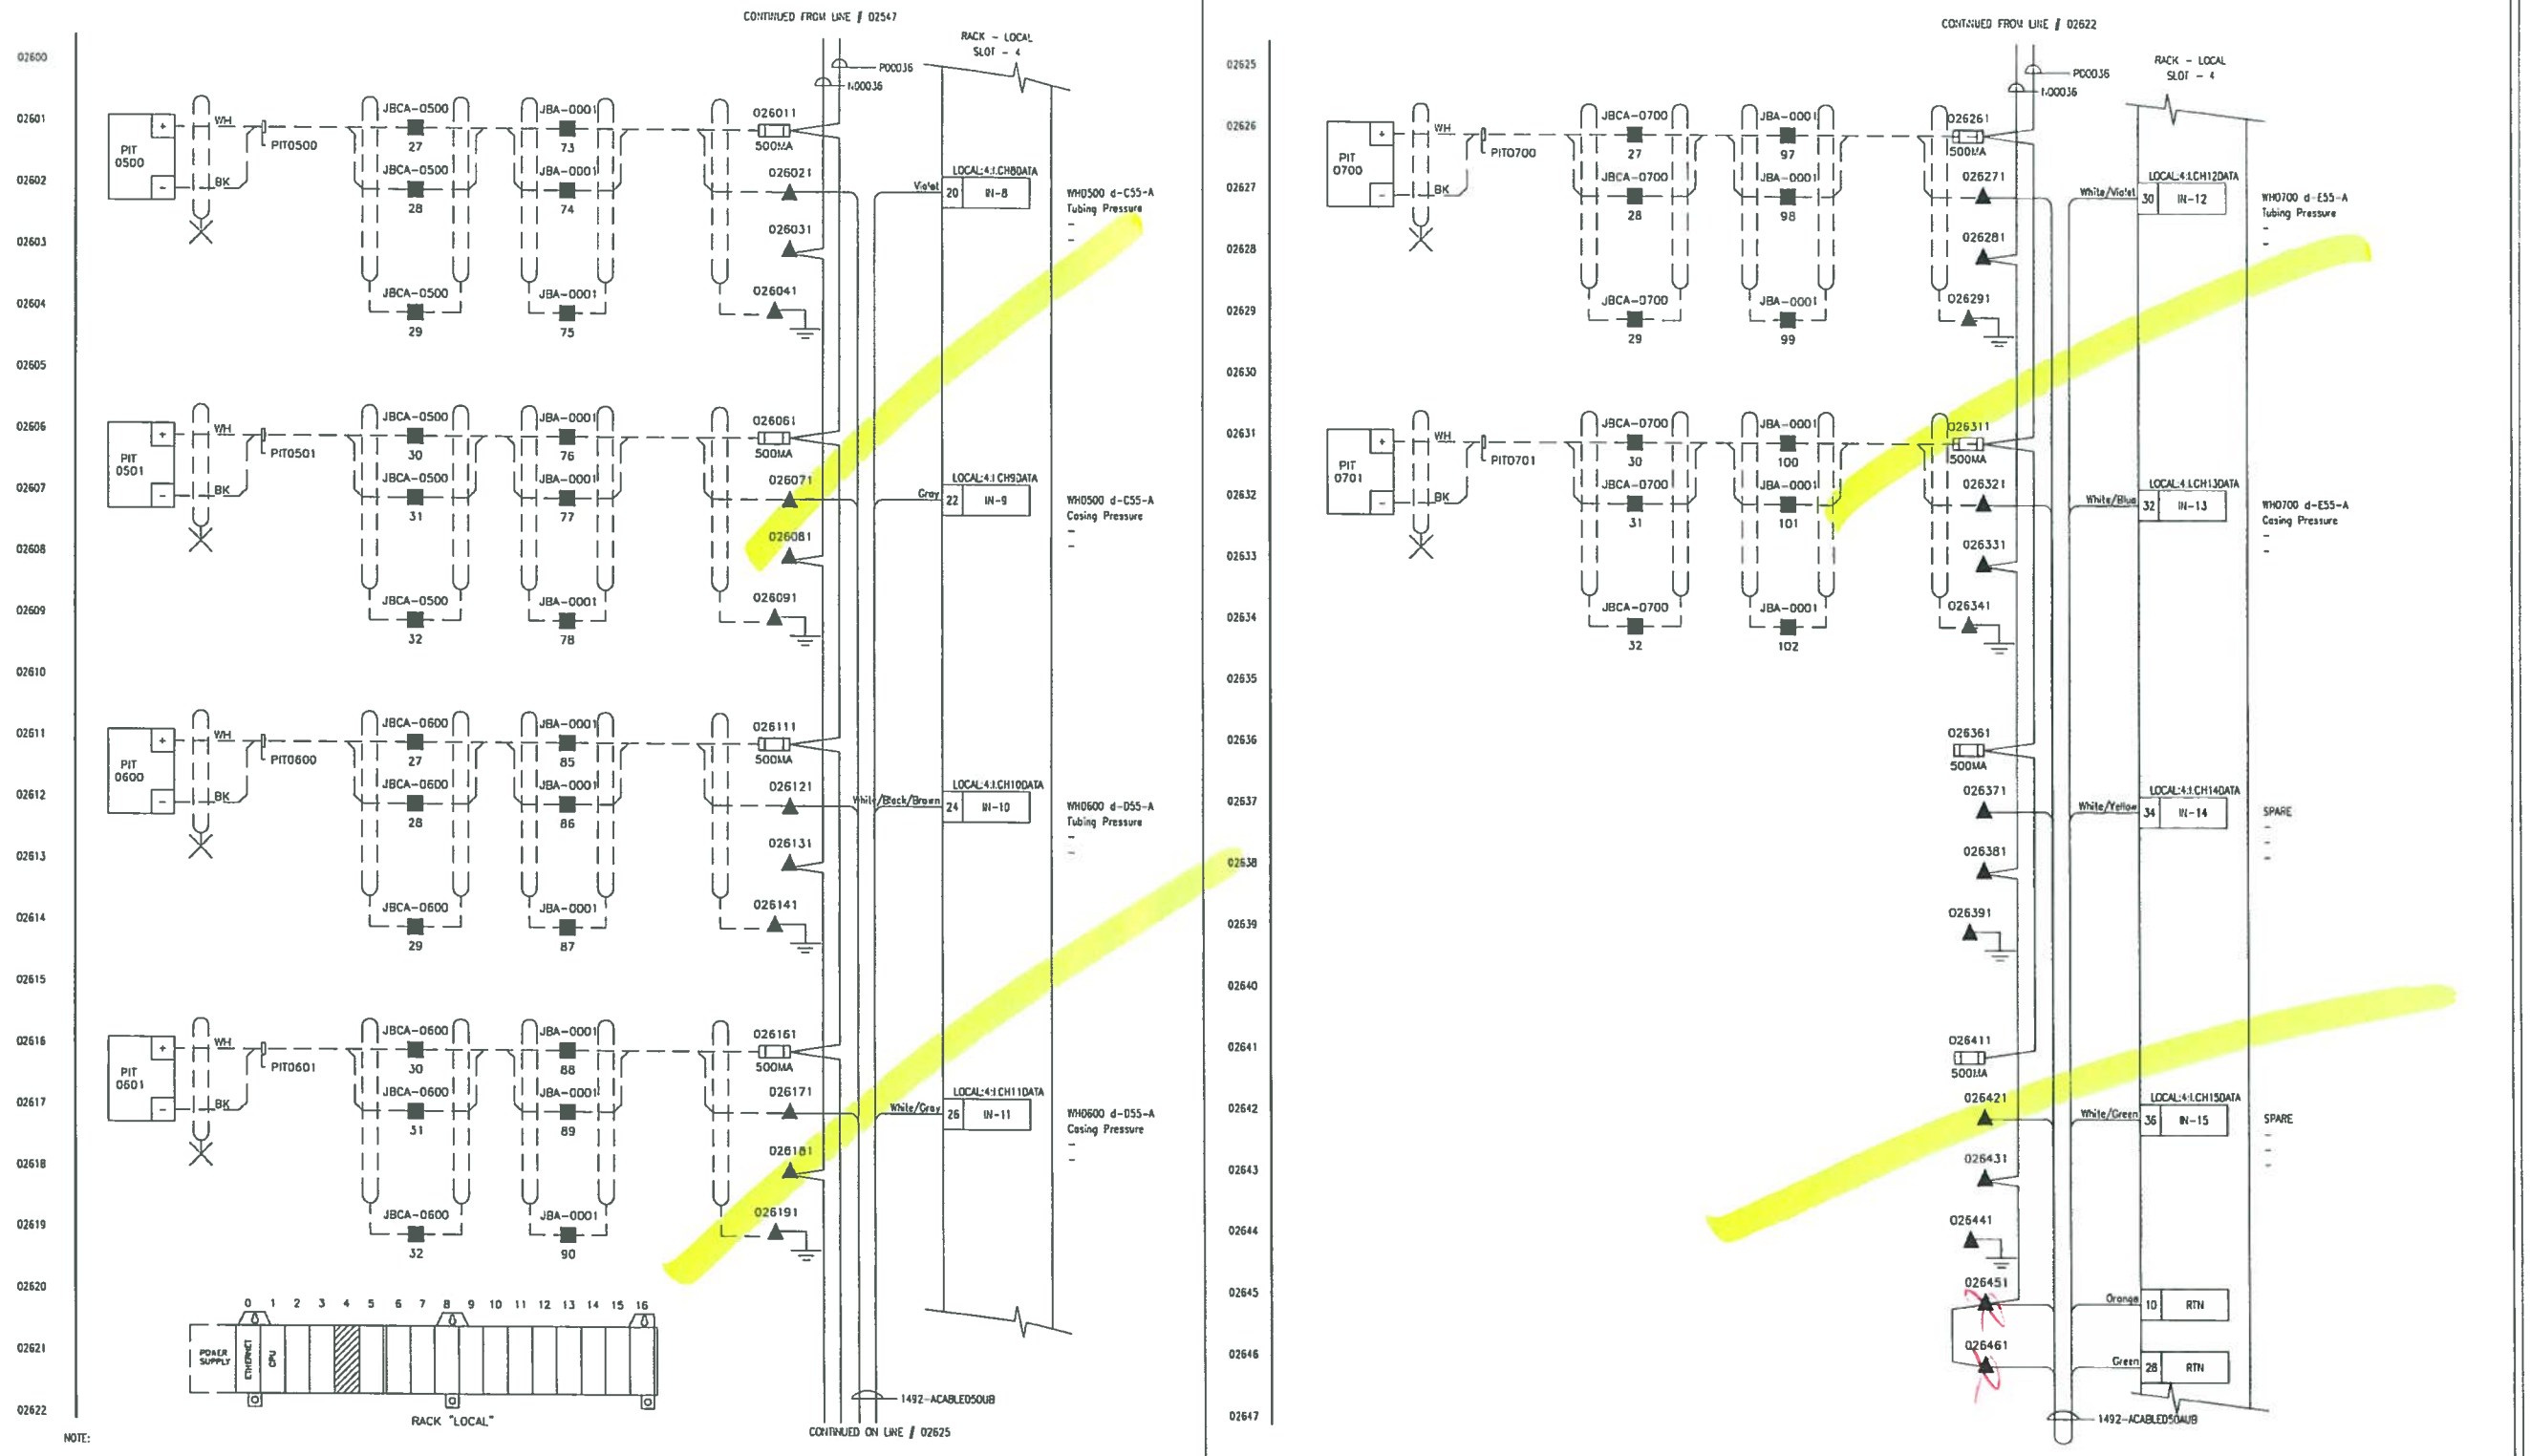

DRAWING#	REFERENCE DRAWING TITLE

REV	DATE	DESCRIPTION	DWN	CHKD	APPR
A	22JUL2013	ISSUED FOR REVIEW	RR	CF	–
B	08OCT2013	ISSUED FOR APPROVAL	R.R	MG	MG
0	21OCT2013	ISSUED FOR CONSTRUCTION	R.R	MG	MG

ENGINEER STAMP


OCT 2 4 2013

THIS DRAWING IS THE PROPERTY OF PENN WEST ENERGY TRUST AND ANY REPRODUCTION IN WHOLE OR PART WITHOUT EXPRESS WRITTEN PERMISSION IS PROHIBITED.

PIONEER ENGINEERING INC.

THIRD PARTY LOGO

SCALE: AS SHOWN | SIZE: D

EPCM PROJECT#: 13053

PennWest Exploration

CORDOVA – MULTI WELL TIE-IN
PENN WEST WELLSITE
d-055-A/094-P-10
IO SCHEMATICS

DWG# d055A094P10-ELC-3026 | SHT 7 OF 17 | REV 0

02700

02701

02702

02703

02704

02705

02706

02707

02708

02709

02710

02711

02712

02713

02714

02715

02716

02717

02718

02719

02720

02721

02722

02723

02724

02725

02726

02727

02728

02729

02730

02731

02732

02733

02734

02735

02736

02737

02738

02739

02740

02741

02742

02743

02744

02745

02746

02747

02748

02749

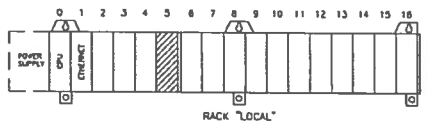

RACK "LOCAL"

DRAWING#	REFERENCE DRAWING TITLE

REV	DATE	DESCRIPTION	DWN	CHKD	APPR
A	22JUL2013	ISSUED FOR REVIEW	RR	CF	-
B	08OCT2013	ISSUED FOR APPROVAL	R.R	MG	MG
0	21OCT2013	ISSUED FOR CONSTRUCTION	R.R	MG	MG

ENGINEER STAMP

PROFESSIONAL ENGINEER PROVINCE OF ALBERTA M. A. GHALY # 38918

OCT 2 4 2013

THIS DRAWING IS THE PROPERTY OF PENN WEST ENERGY TRUST AND ANY REPRODUCTION IN WHOLE OR PART WITHOUT EXPRESS WRITTEN PERMISSION IS PROHIBITED.

PIONEER ENGINEERING INC.

THIRD PARTY LOGO

SCALE: AS SHOWN | SIZE: D

EPCM PROJECT#: 13053

PennWest Exploration

CORDOVA – MULTI WELL TIE–IN
PENN WEST WELLSITE
d–055–A/094–P–10
IO SCHEMATICS

DWG# d055A094P10–ELC–3027 | SHT 8 OF 17 | REV 0

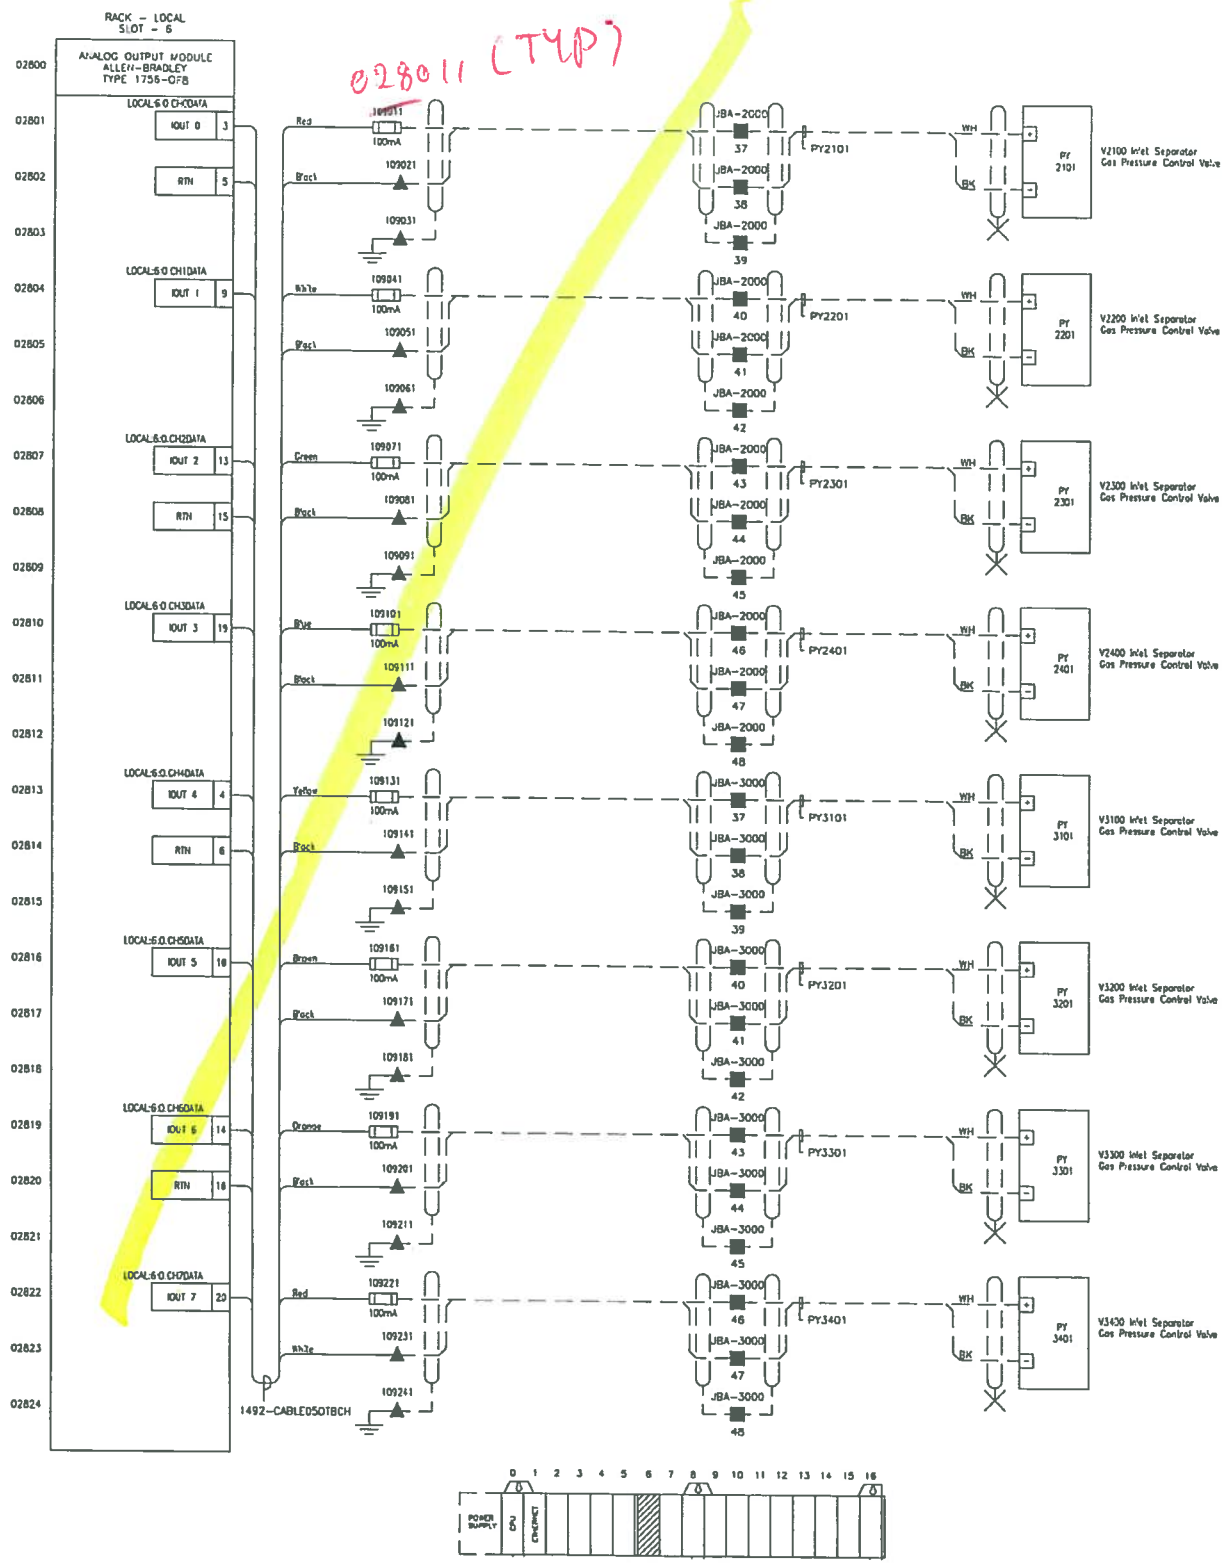

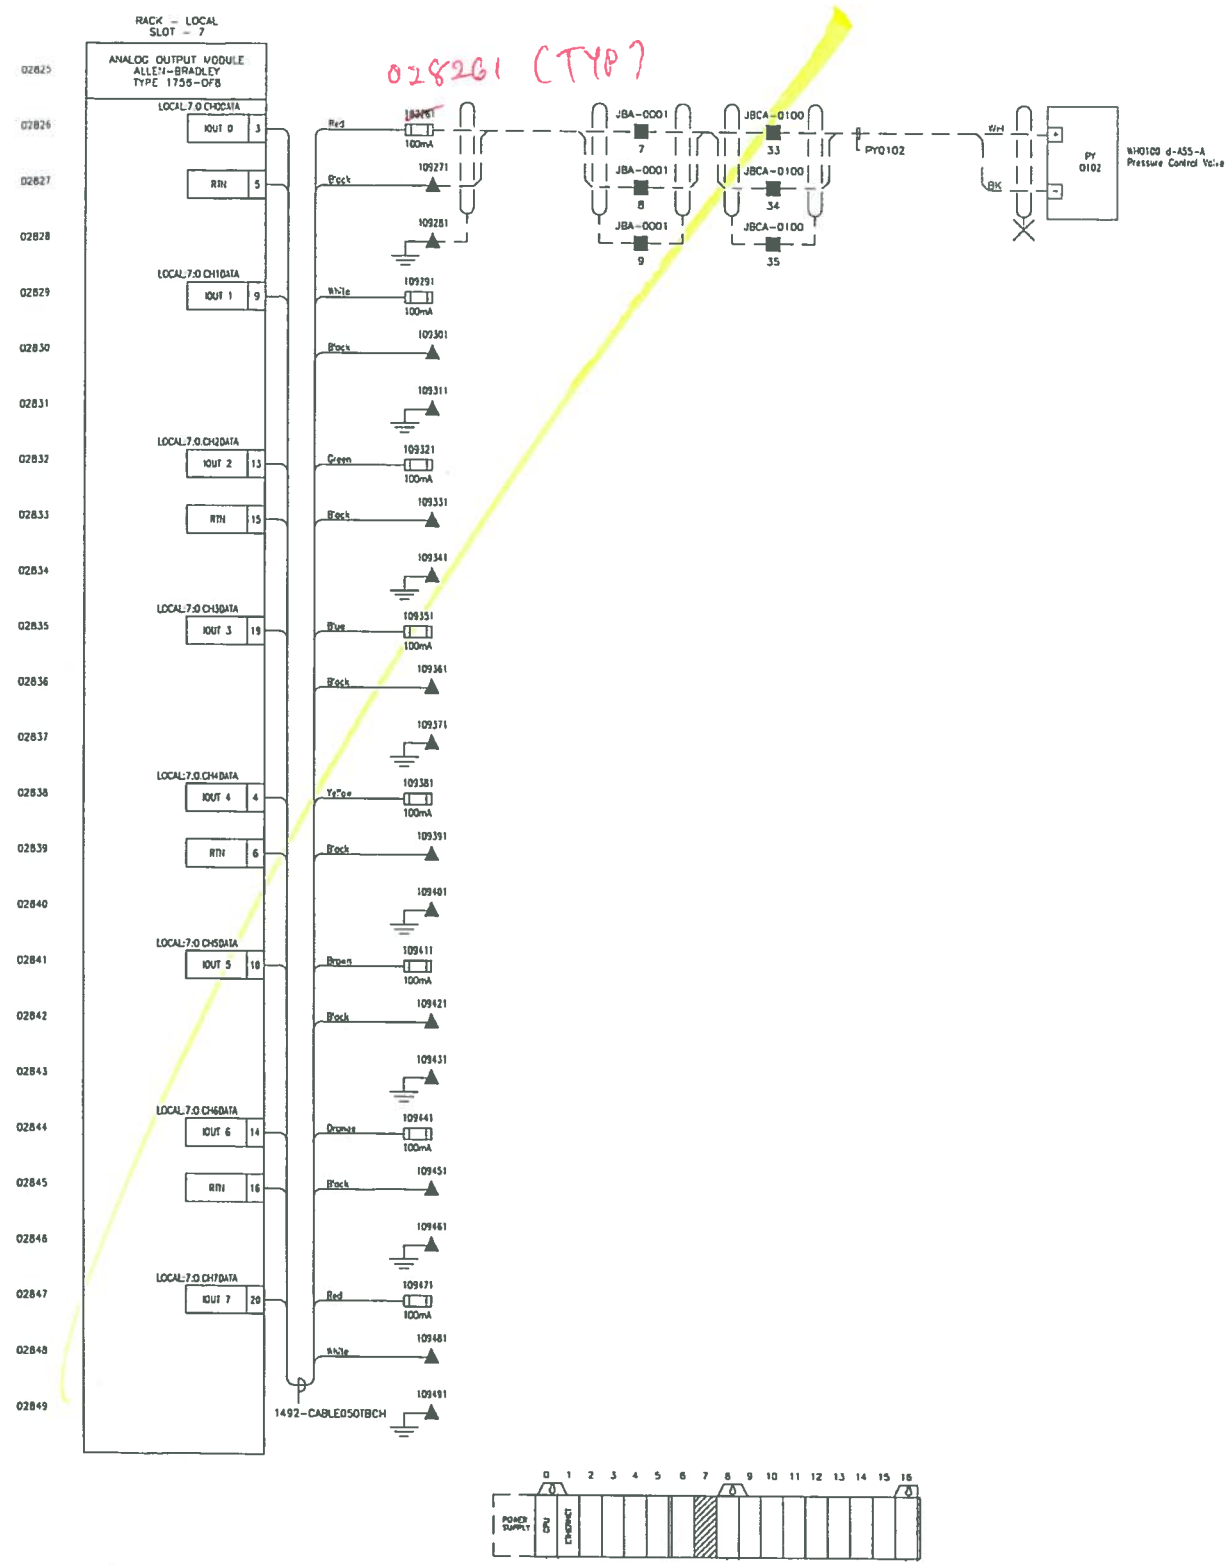

DRAWING#	REFERENCE DRAWING TITLE

REV	DATE	DESCRIPTION	DWN	CHKD	APPR
A	22JUL2013	ISSUED FOR REVIEW	RR	CF	–
B	08OCT2013	ISSUED FOR APPROVAL	R.R	MG	MG
0	21OCT2013	ISSUED FOR CONSTRUCTION	R.R	MG	MG

ENGINEER STAMP

PROFESSIONAL ENGINEER – PROVINCE OF ALBERTA – M. A. GHALY # 38913

OCT 2 4 2013

THIS DRAWING IS THE PROPERTY OF PENN WEST ENERGY TRUST AND ANY REPRODUCTION IN WHOLE OR PART WITHOUT EXPRESS WRITTEN PERMISSION IS PROHIBITED.

PIONEER ENGINEERING INC.

THIRD PARTY LOGO

SCALE: AS SHOWN | SIZE: D

EPCM PROJECT#: 13053

PennWest Exploration

CORDOVA – MULTI WELL TIE-IN
PENN WEST WELLSITE
d-055-A/094-P-10
IO SCHEMATICS

DWG# d055A094P10-ELC-3028 | SHT 9 OF 17 | REV 0

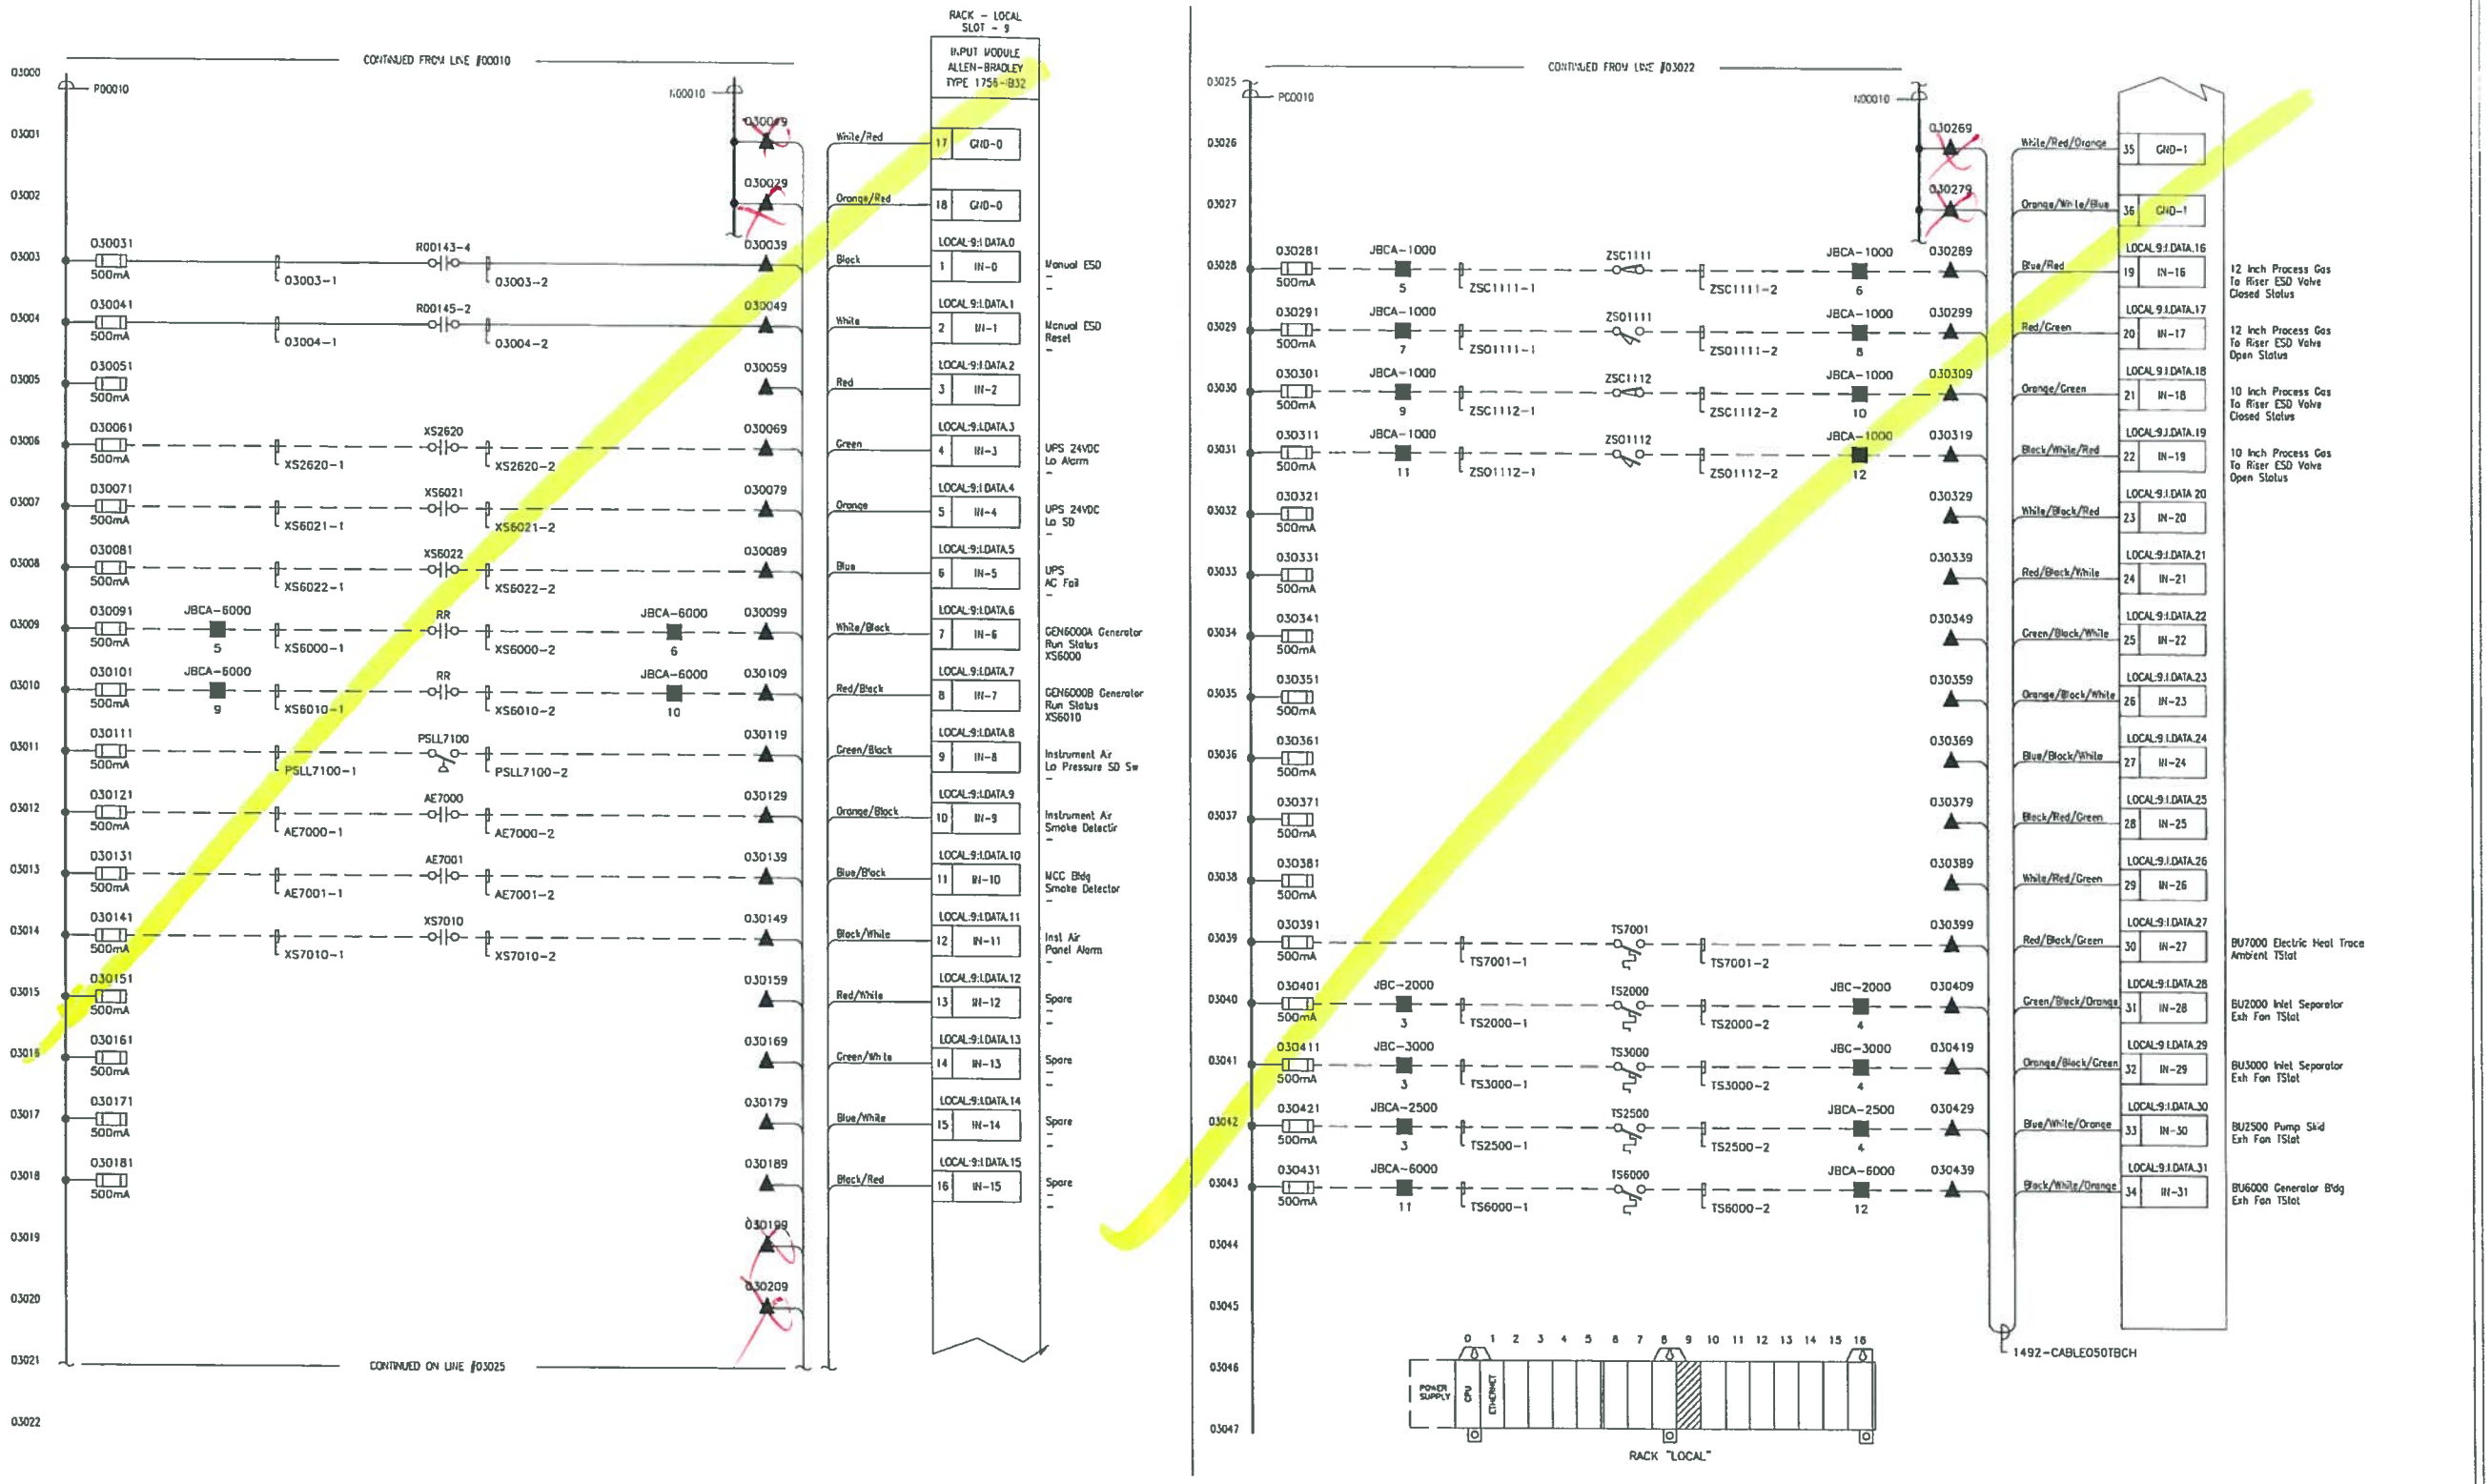

DRAWING#	REFERENCE DRAWING TITLE

REV	DATE	DESCRIPTION	DWN	CHKD	APPR
A	22JUL2013	ISSUED FOR REVIEW	RR	CF	–
B	08OCT2013	ISSUED FOR APPROVAL	R.R	MG	MG
0	21OCT2013	ISSUED FOR CONSTRUCTION	R.R	MG	MG

PROFESSIONAL ENGINEER STAMP
PROVINCE OF BRITISH COLUMBIA
M. A. GHALY
38913
OCT 2 4 2013

THIS DRAWING IS THE PROPERTY OF PENN WEST ENERGY TRUST AND ANY REPRODUCTION IN WHOLE OR PART WITHOUT EXPRESS WRITTEN PERMISSION IS PROHIBITED.

PIONEER ENGINEERING INC.
THIRD PARTY LOGO
SCALE: AS SHOWN | SIZE: D
EPCM PROJECT#: 13053

PennWest Exploration

CORDOVA – MULTI WELL TIE-IN
PENN WEST WELLSITE
d-055-A/094-P-10
IO SCHEMATICS

DWG# d055A094P10-ELC-3030 | SHT 11 OF 17 | REV 0

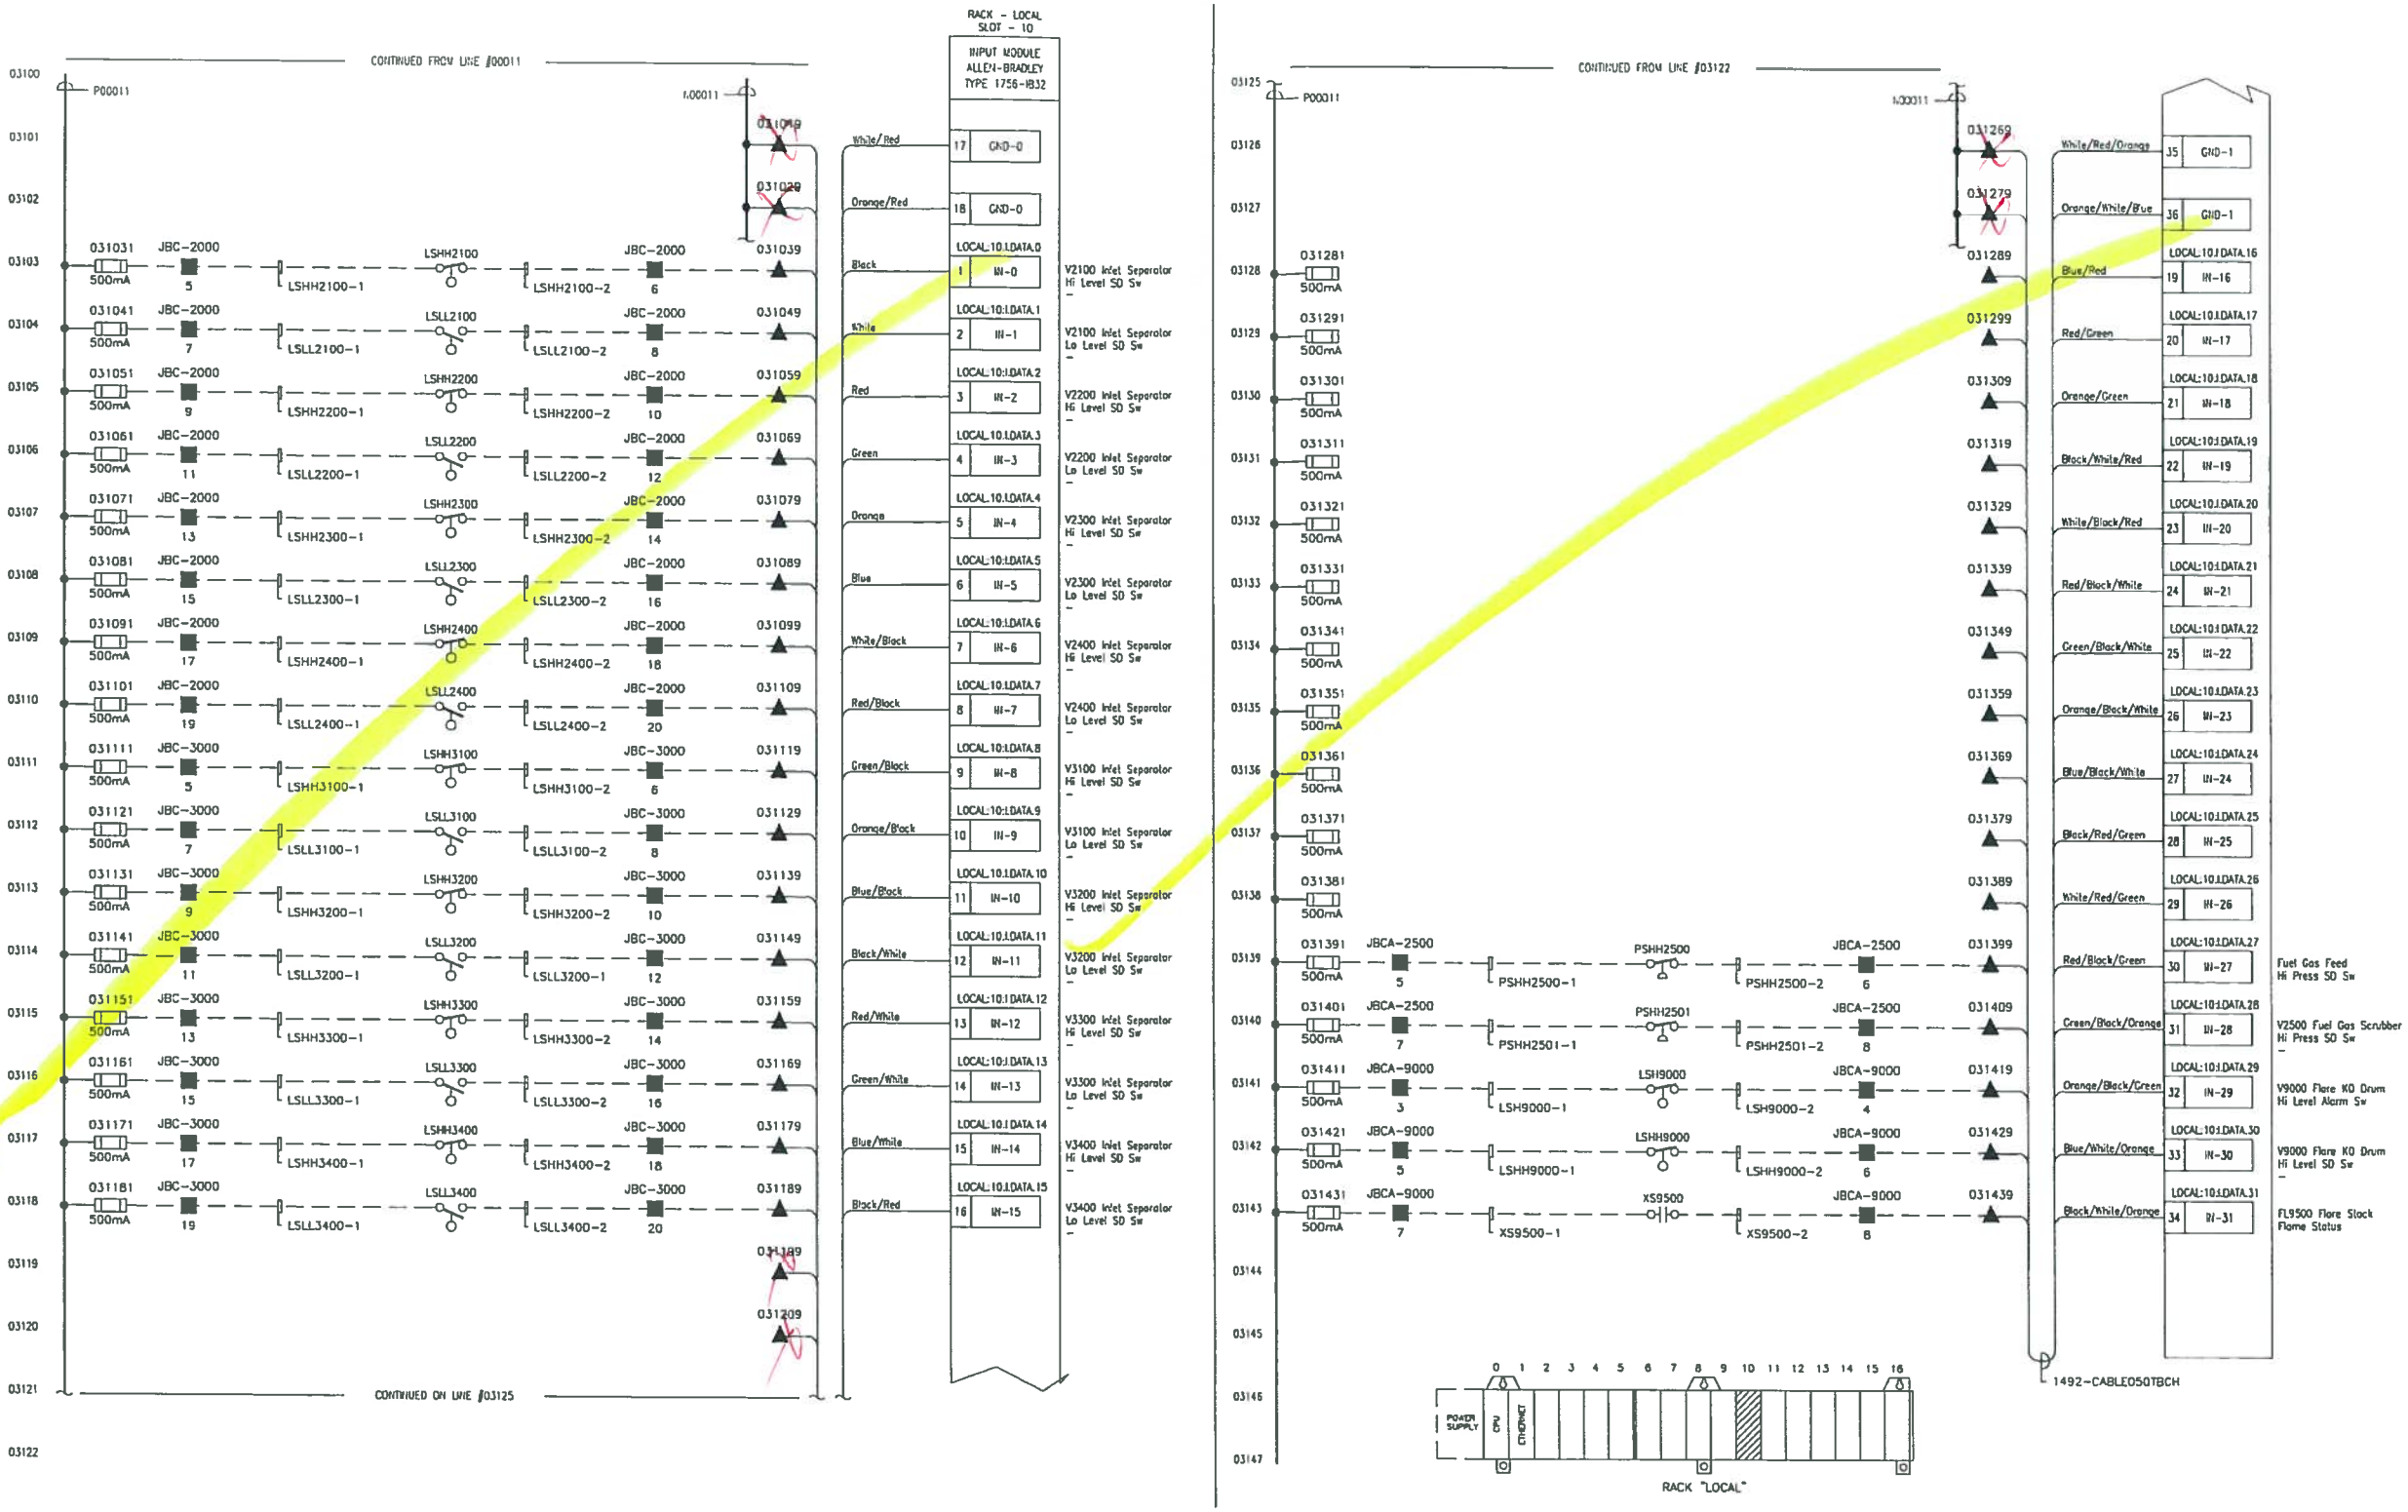

DRAWING#	REFERENCE DRAWING TITLE

REV	DATE	DESCRIPTION	DWN	CHKD	APPR
A	22JUL2013	ISSUED FOR REVIEW	RR	CF	–
B	08OCT2013	ISSUED FOR APPROVAL	R R	MG	MG
0	21OCT2013	ISSUED FOR CONSTRUCTION	R.R	MG	MG

ENGINEER STAMP

PROFESSIONAL ENGINEER — PROVINCE OF BRITISH COLUMBIA — M. A. GHALY # 38913

OCT 2 4 2013

THIS DRAWING IS THE PROPERTY OF PENN WEST ENERGY TRUST AND ANY REPRODUCTION IN WHOLE OR PART WITHOUT EXPRESS WRITTEN PERMISSION IS PROHIBITED.

PIONEER ENGINEERING INC.

THIRD PARTY LOGO

SCALE AS SHOWN | SIZE: D

EPCM PROJECT#: 13053

PennWest Exploration

CORDOVA – MULTI WELL TIE-IN
PENN WEST WELLSITE
d-055-A/094-P-10
IO SCHEMATICS

DWG# d055A094P10-ELC-3031 | SHT 12 OF 17 | REV 0

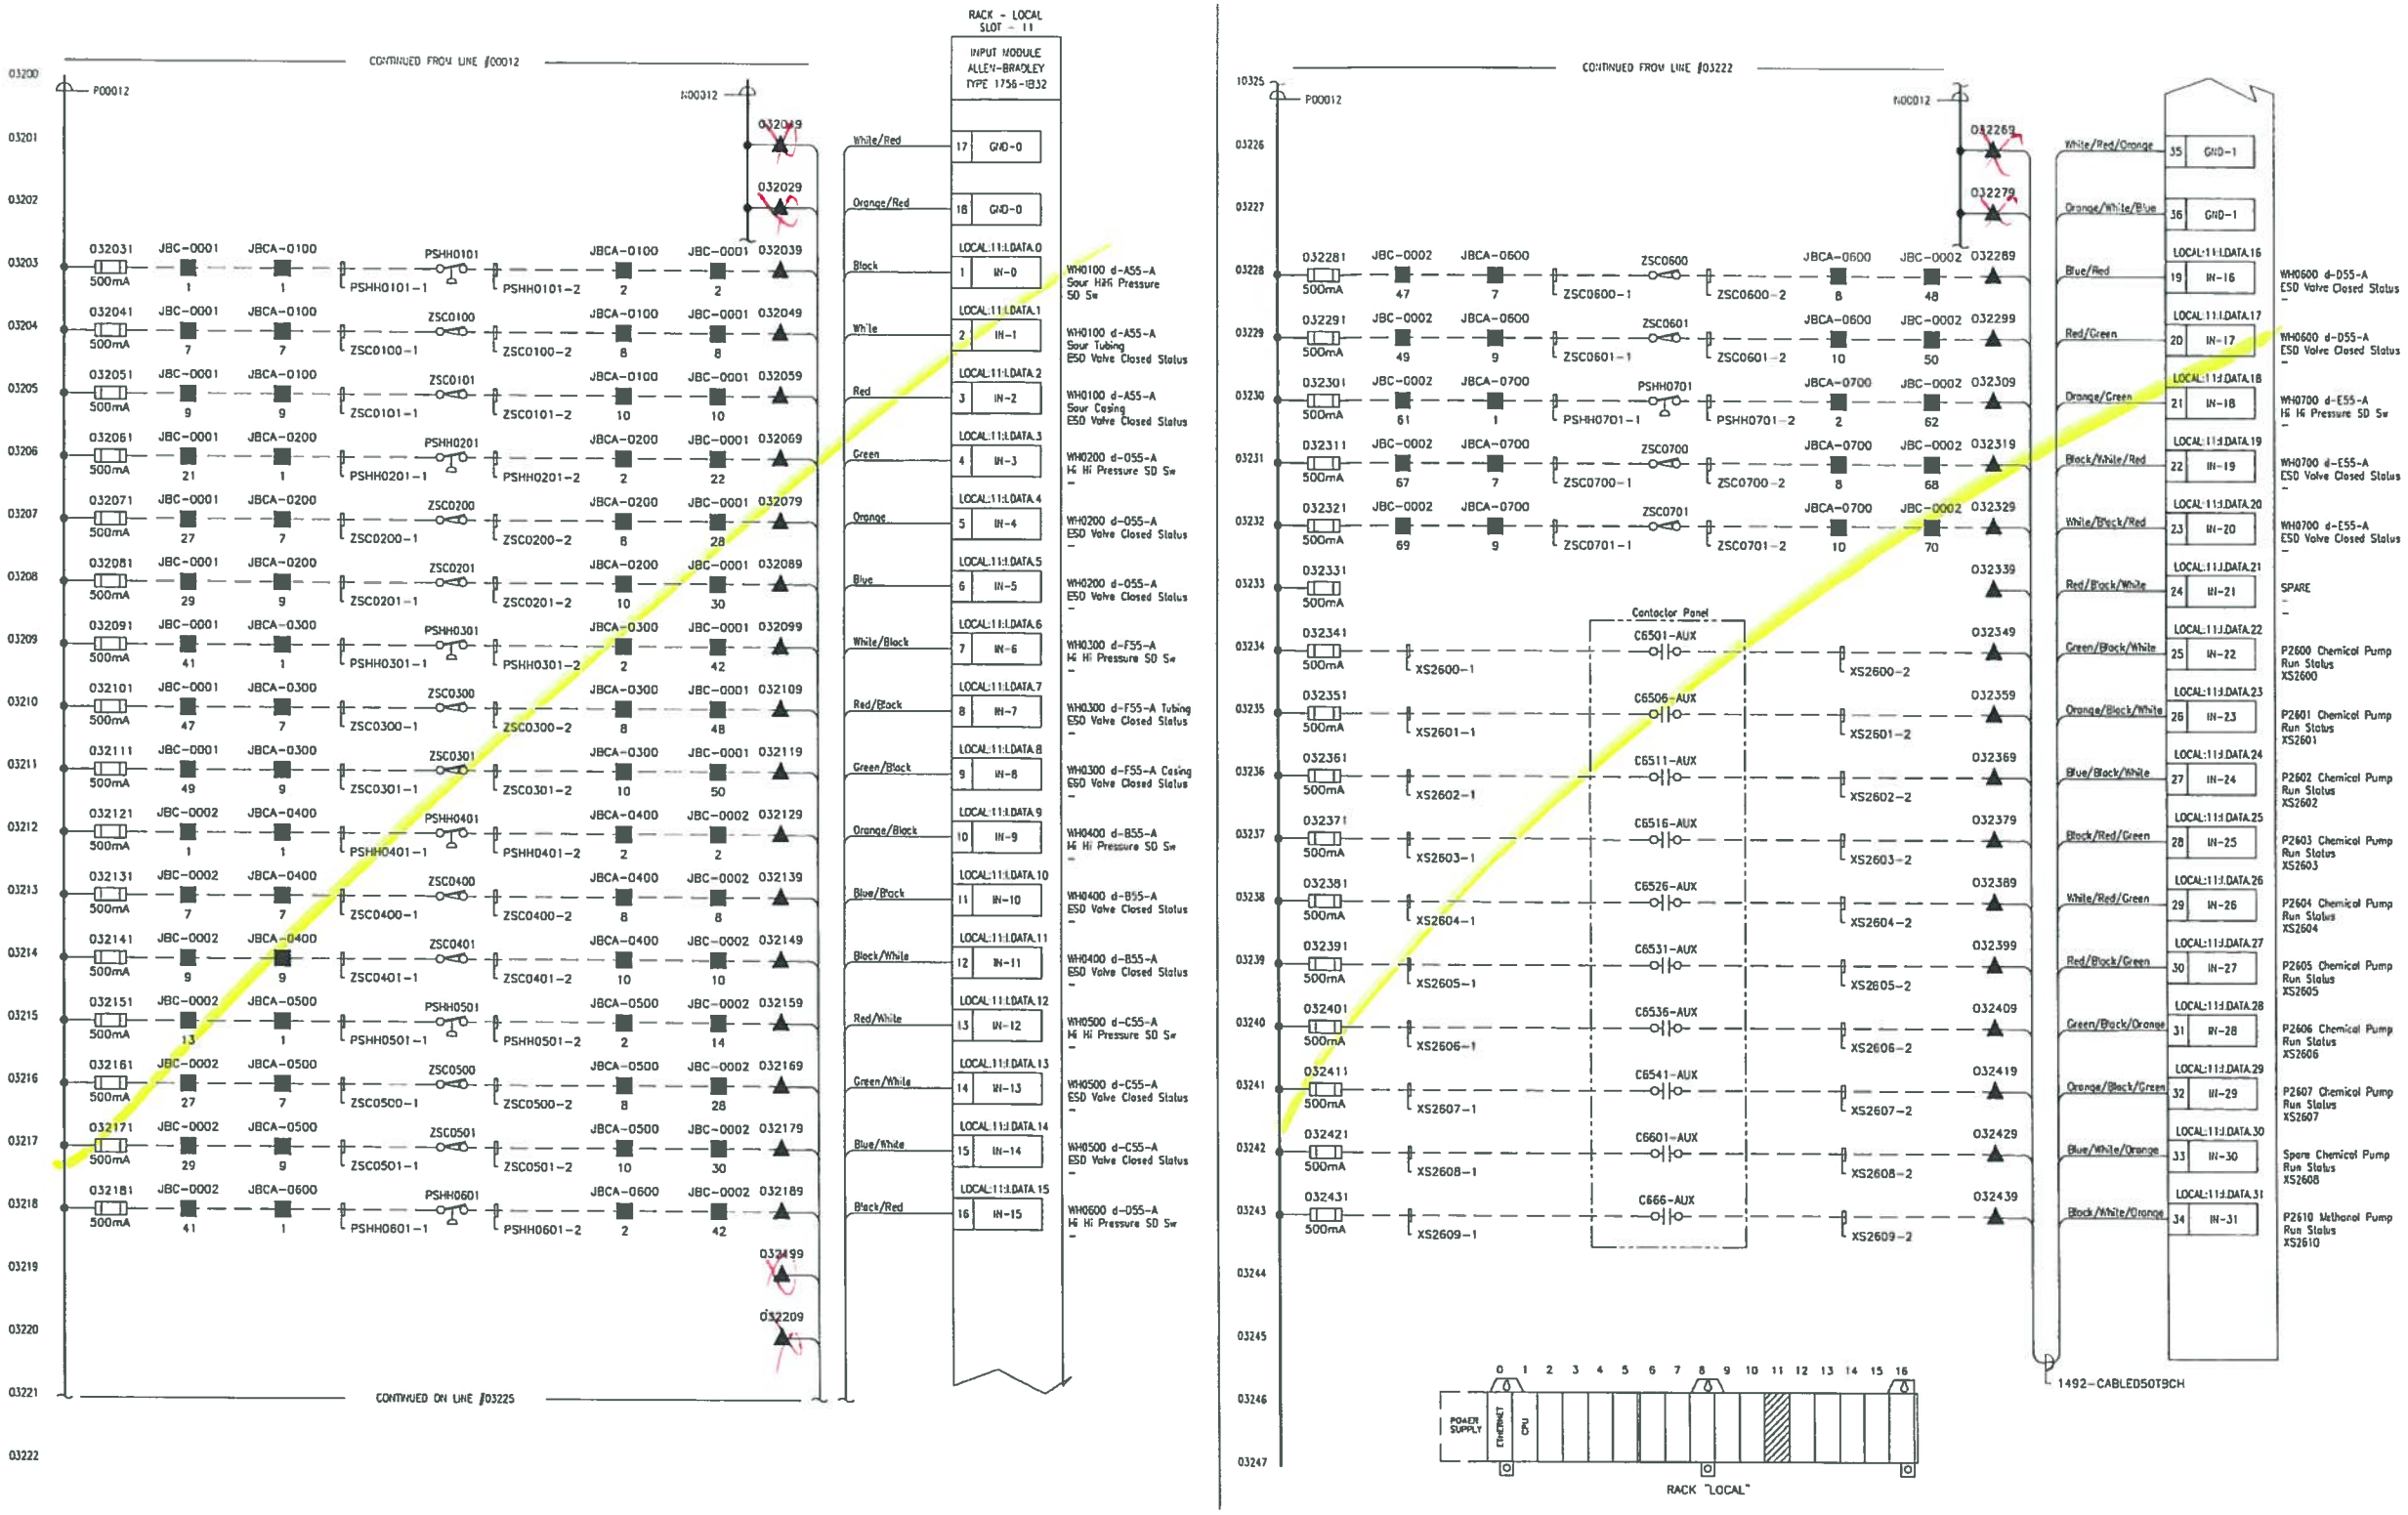

DRAWING#	REFERENCE DRAWING TITLE

REV	DATE	DESCRIPTION	DWN	CHKD	APPR
0	22JUL2013	ISSUED FOR REVIEW	RR	CF	–
B	08OCT2013	ISSUED FOR APPROVAL	R.R	MG	MG
0	21OCT2013	ISSUED FOR CONSTRUCTION	R.R	MG	MG

ENGINEER STAMP

PROFESSIONAL ENGINEER — PROVINCE OF BRITISH COLUMBIA — M. A. GHALY # 38913

OCT 2 4 2013

THIS DRAWING IS THE PROPERTY OF PENN WEST ENERGY TRUST AND ANY REPRODUCTION IN WHOLE OR PART WITHOUT EXPRESS WRITTEN PERMISSION IS PROHIBITED.

PIONEER ENGINEERING INC.

THIRD PARTY LOGO

SCALE: AS SHOWN | SIZE: D

EPCM PROJECT#: 13053

PennWest Exploration

CORDOVA – MULTI WELL TIE-IN
PENN WEST WELLSITE
d-055-A/094-P-10
IO SCHEMATICS

DWG# d055A094P10-ELC-3032 | SHT 13 OF 17 | REV B

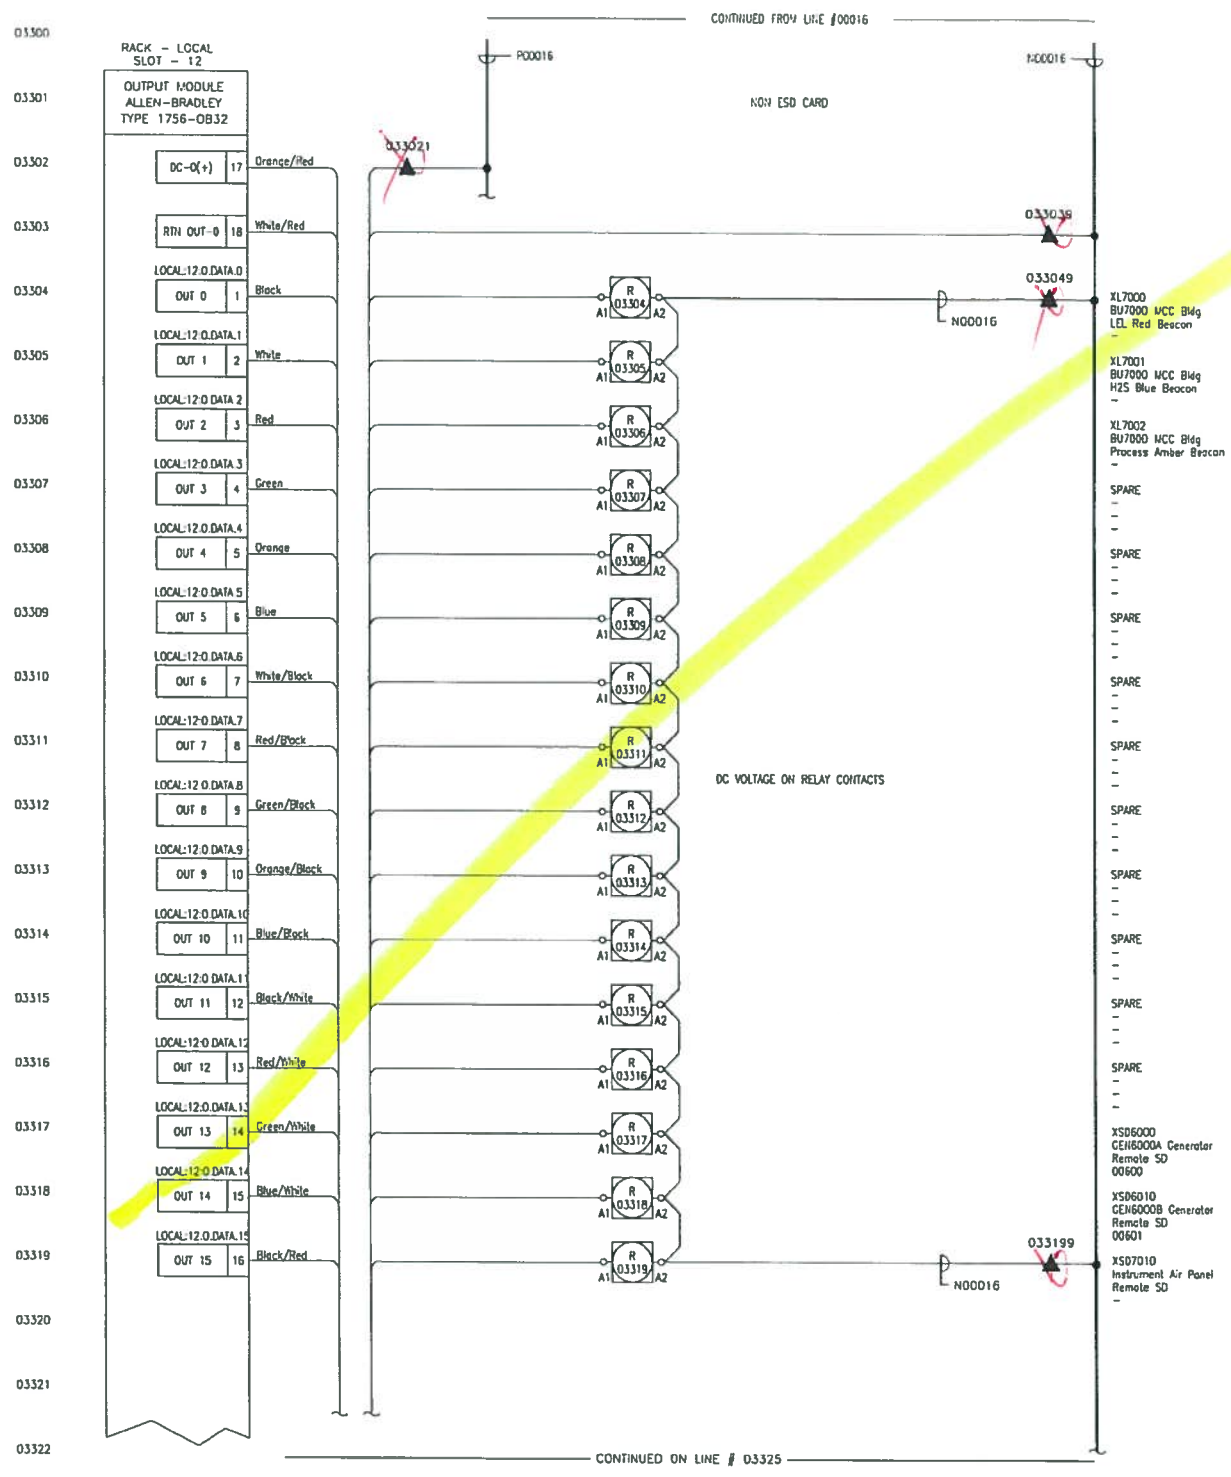

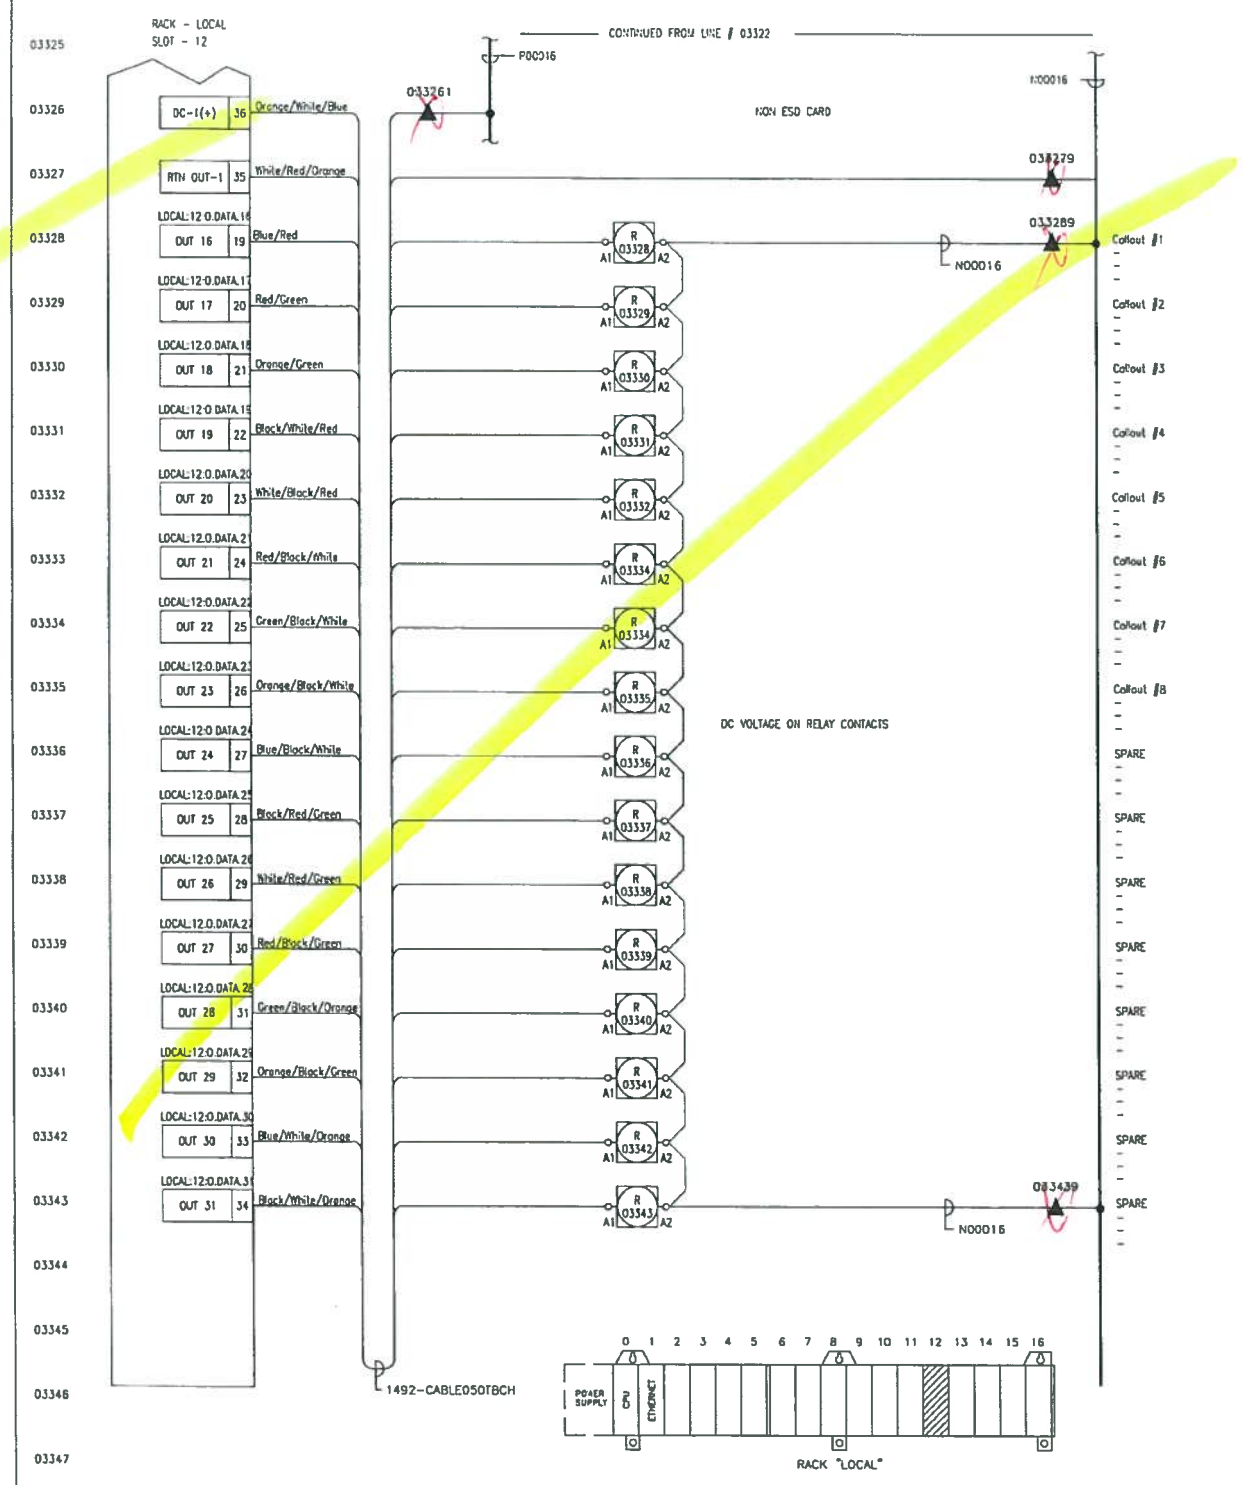

DRAWING#	REFERENCE DRAWING TITLE

REV	DATE	DESCRIPTION	DWN	CHKD	APPR
0	22JUL2013	ISSUED FOR REVIEW	RR	CF	–
B	08OCT2013	ISSUED FOR APPROVAL	R.R	MG	MG
0	21OCT2013	ISSUED FOR CONSTRUCTION	R.R	MG	MG

ENGINEER STAMP

PROFESSIONAL ENGINEER — PROVINCE OF BRITISH COLUMBIA — M. A. GHALY # 38913

OCT 2 4 2013

THIS DRAWING IS THE PROPERTY OF PENN WEST ENERGY TRUST AND ANY REPRODUCTION IN WHOLE OR PART WITHOUT EXPRESS WRITTEN PERMISSION IS PROHIBITED.

PIONEER ENGINEERING INC.

THIRD PARTY LOGO

SCALE	AS SHOWN	SIZE: D
EPCM PROJECT#: 13053		

PennWest Exploration

CORDOVA – MULTI WELL TIE-IN
PENN WEST WELLSITE
d-055-A/094-P-10
IO SCHEMATICS

DWG# d055A094P10-ELC-3033 | SHT 14 OF 17 | REV B

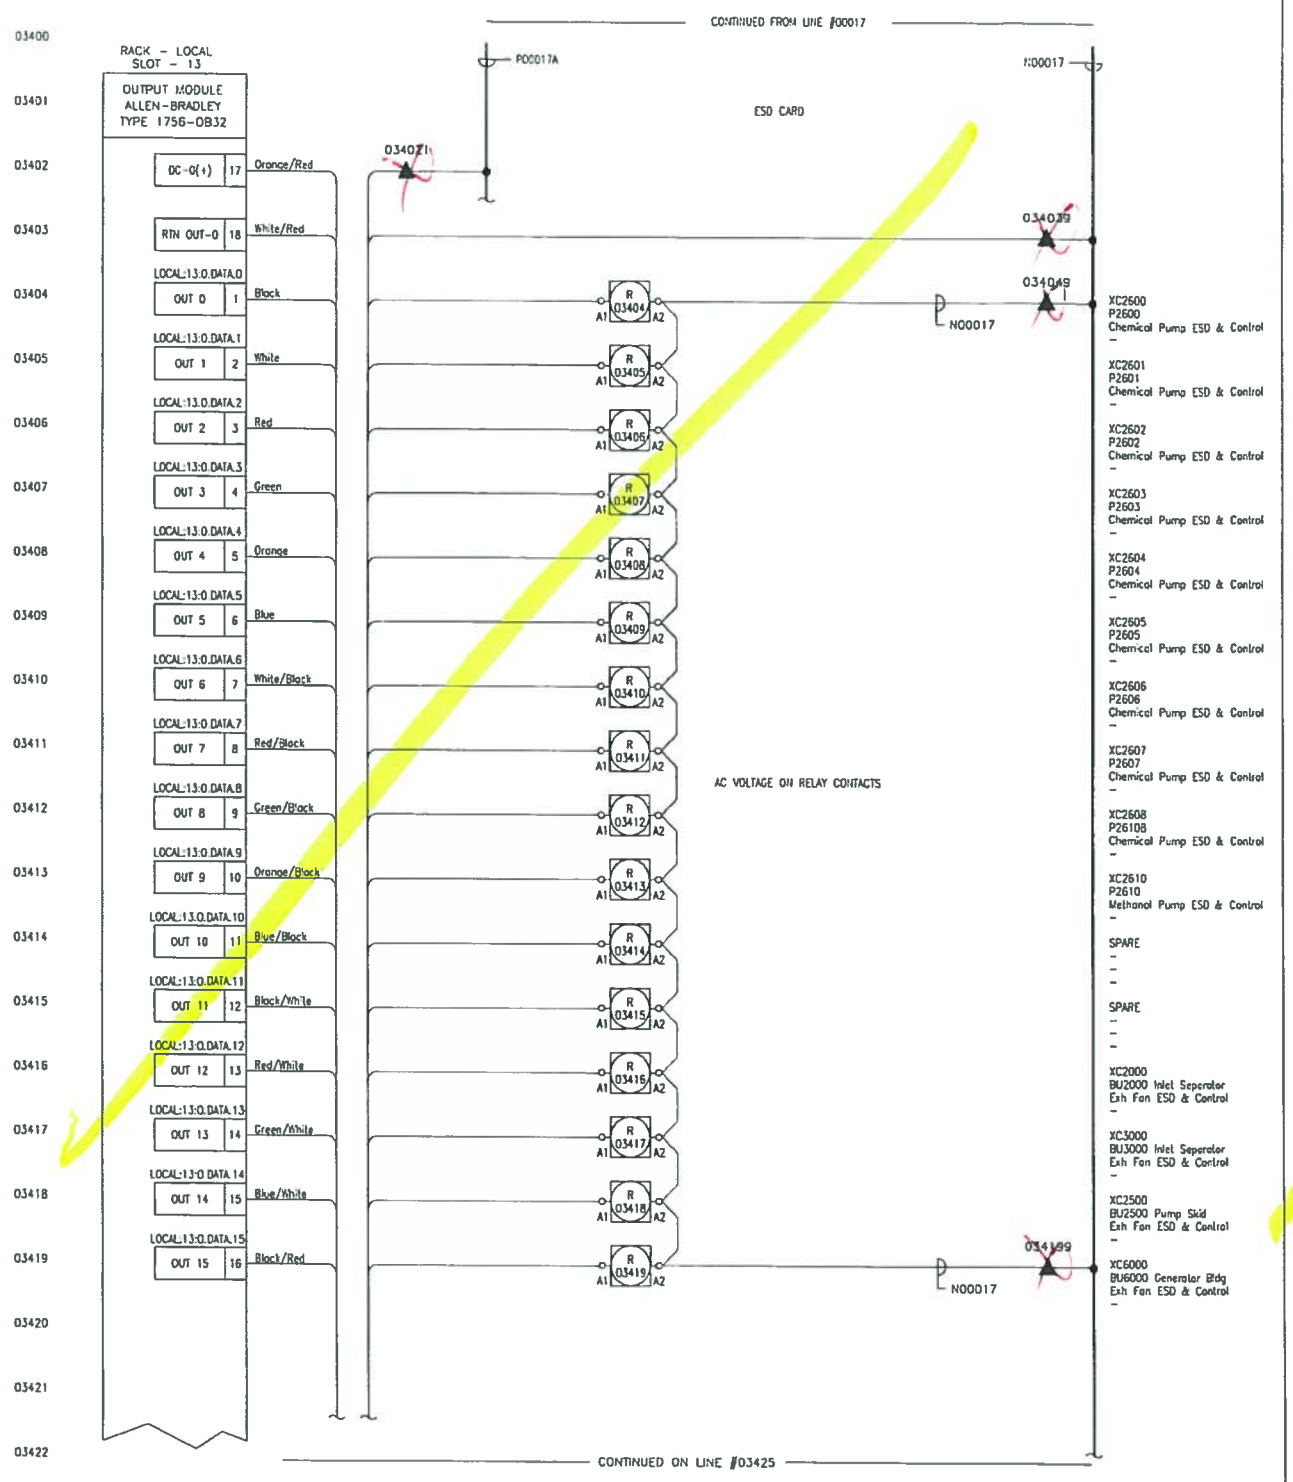

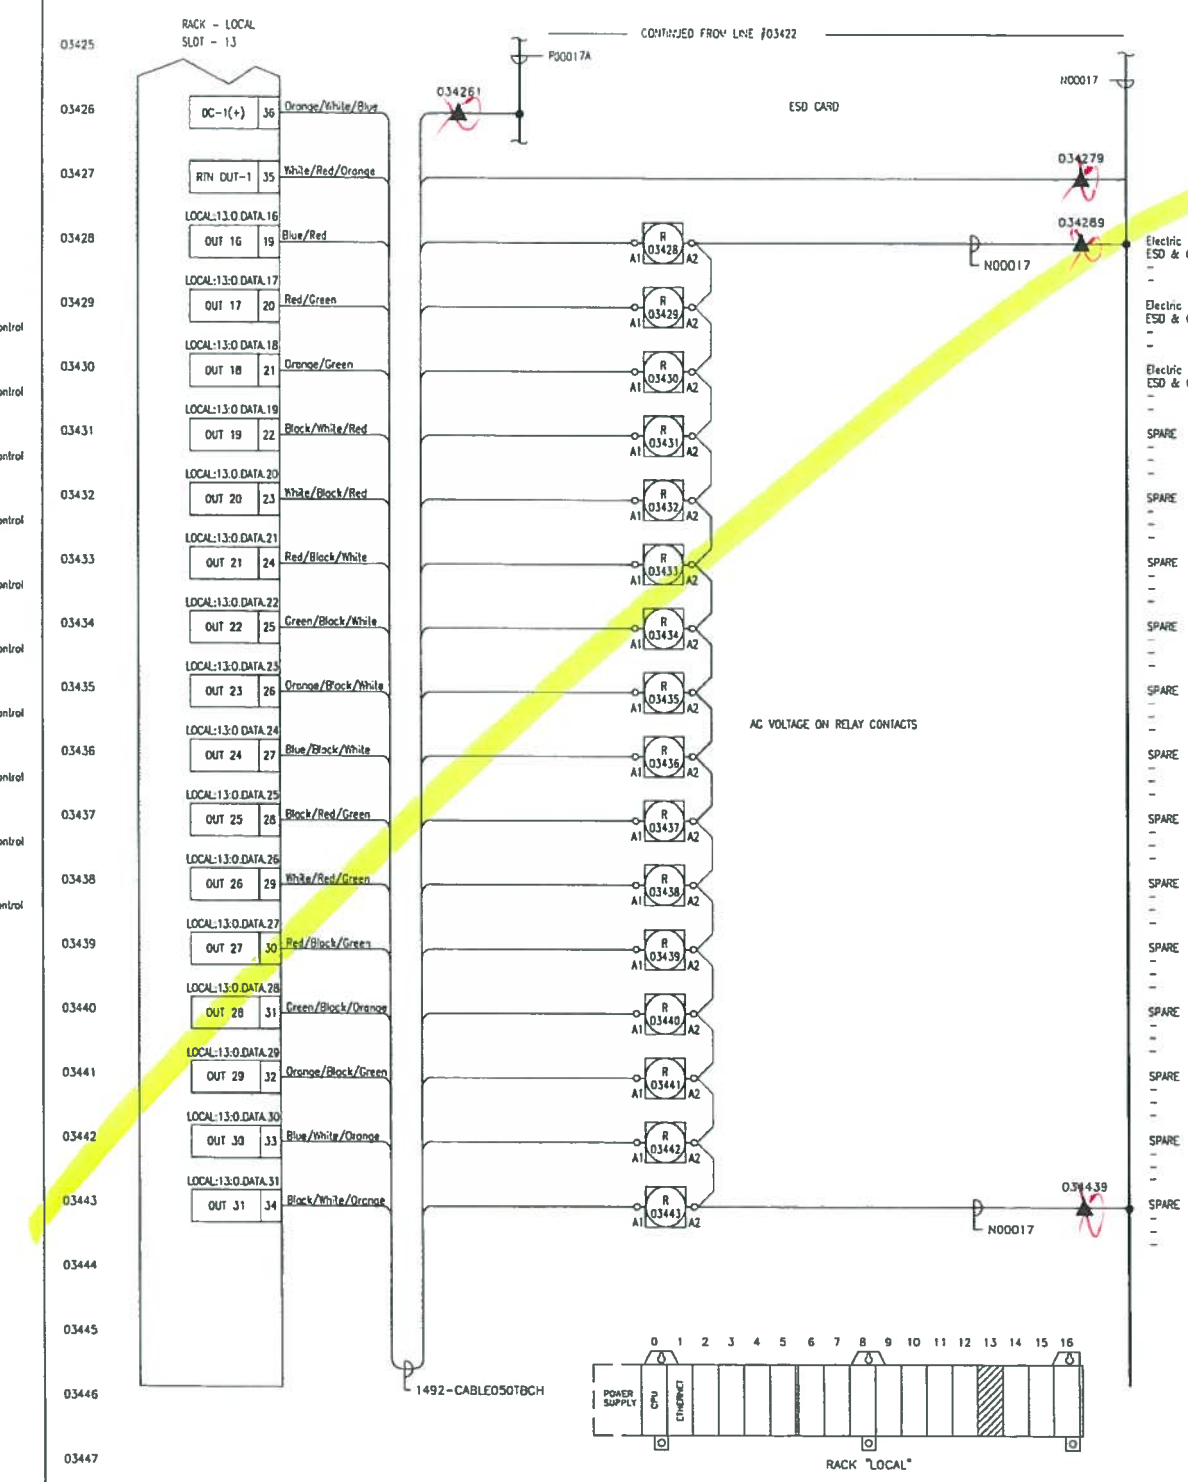

DRAWING#	REFERENCE DRAWING TITLE

REV	DATE	DESCRIPTION	DWN	CHKD	APPR
A	22JUL2013	ISSUED FOR REVIEW	RR	CF	–
B	08OCT2013	ISSUED FOR APPROVAL	R.R	MG	MG
0	21OCT2013	ISSUED FOR CONSTRUCTION	R.R	MG	MG

ENGINEER STAMP

PROFESSIONAL ENGINEER PROVINCE OF BRITISH COLUMBIA M. A. GHALY #38913

OCT 2 4 2013

THIS DRAWING IS THE PROPERTY OF PENN WEST ENERGY TRUST AND ANY REPRODUCTION IN WHOLE OR PART WITHOUT EXPRESS WRITTEN PERMISSION IS PROHIBITED.

PIONEER ENGINEERING INC.

THIRD PARTY LOGO

SCALE: AS SHOWN | SIZE: D

EPCM PROJECT#: 13053

PennWest Exploration

CORDOVA – MULTI WELL TIE-IN
PENN WEST WELLSITE
d-055-A/094-P-10
IO SCHEMATICS

DWG# d055A094P10-ELC-3034 | SHT 15 OF 17 | REV 0

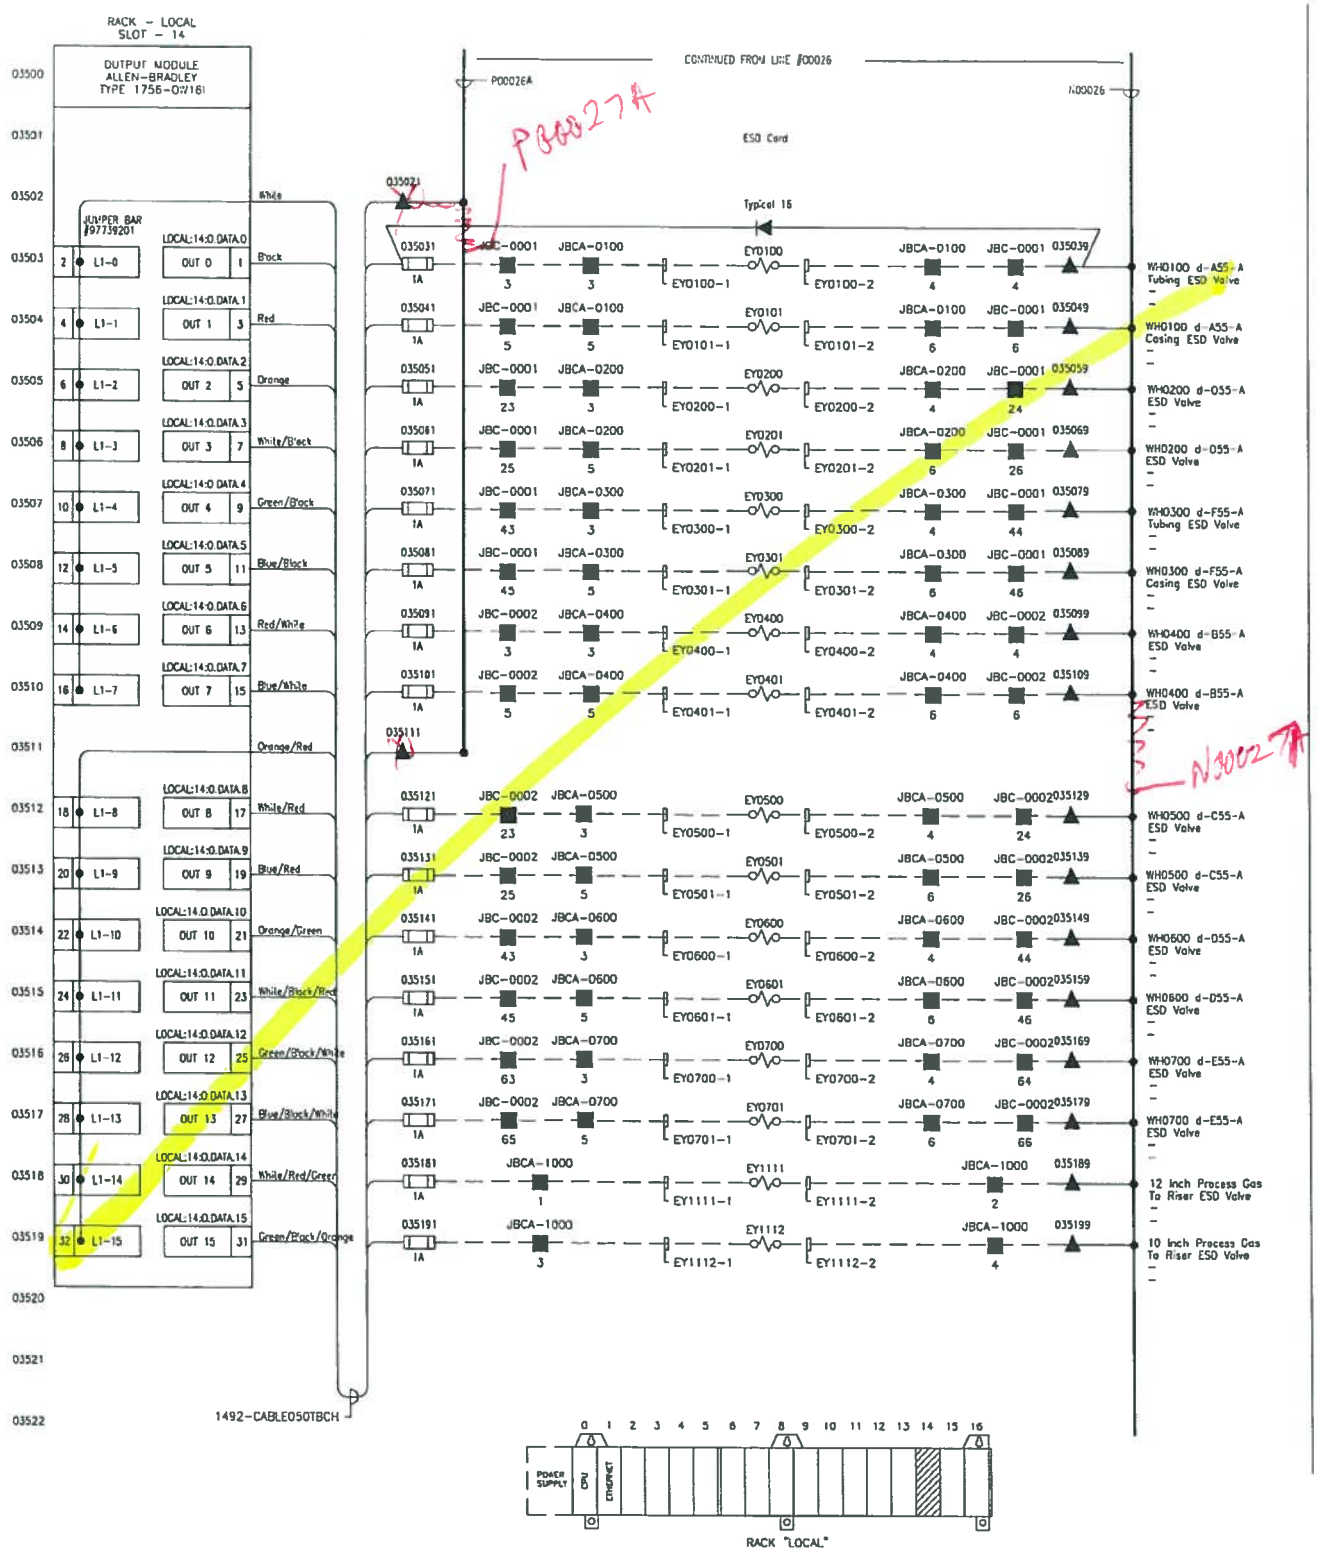

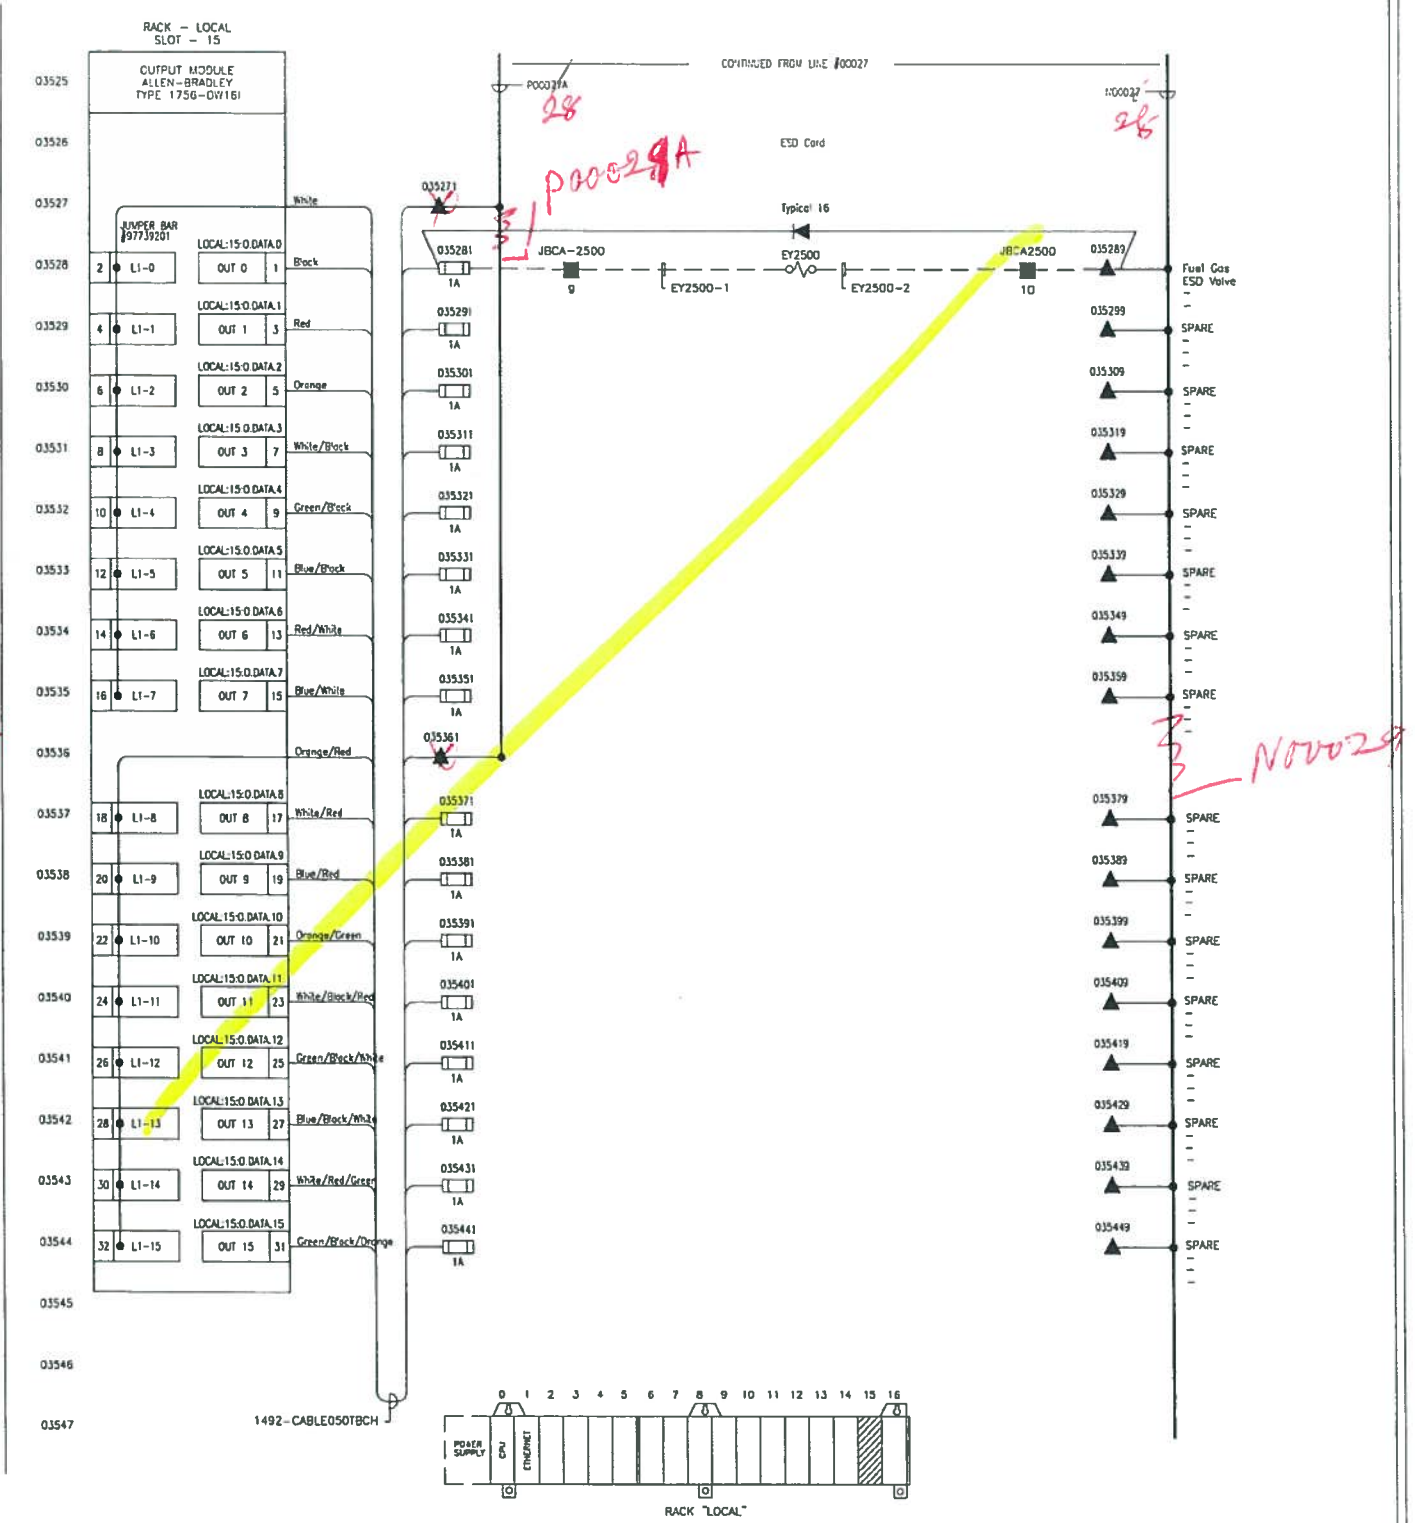

DRAWING#	REFERENCE DRAWING TITLE

REV	DATE	DESCRIPTION	DWN	CHKD	APPR
A	22JUL2013	ISSUED FOR REVIEW	RR	CF	–
B	08OCT2013	ISSUED FOR APPROVAL	R.R	MG	MG
0	21OCT2013	ISSUED FOR CONSTRUCTION	R.R	MG	MG

ENGINEER STAMP

PROFESSIONAL ENGINEER – PROVINCE OF BRITISH COLUMBIA – M. A. GHALY #38913

OCT 24 2013

THIS DRAWING IS THE PROPERTY OF PENN WEST ENERGY TRUST AND ANY REPRODUCTION IN WHOLE OR PART WITHOUT EXPRESS WRITTEN PERMISSION IS PROHIBITED.

PIONEER ENGINEERING INC.

THIRD PARTY LOGO

SCALE: AS SHOWN | SIZE: D

EPCM PROJECT#: 13053

PennWest Exploration

CORDOVA – MULTI WELL TIE-IN
PENN WEST WELLSITE
d-055-A/094-P-10
IO SCHEMATICS

DWG# d055A094P10-ELC-3035 | SHT 16 OF 17 | REV 0

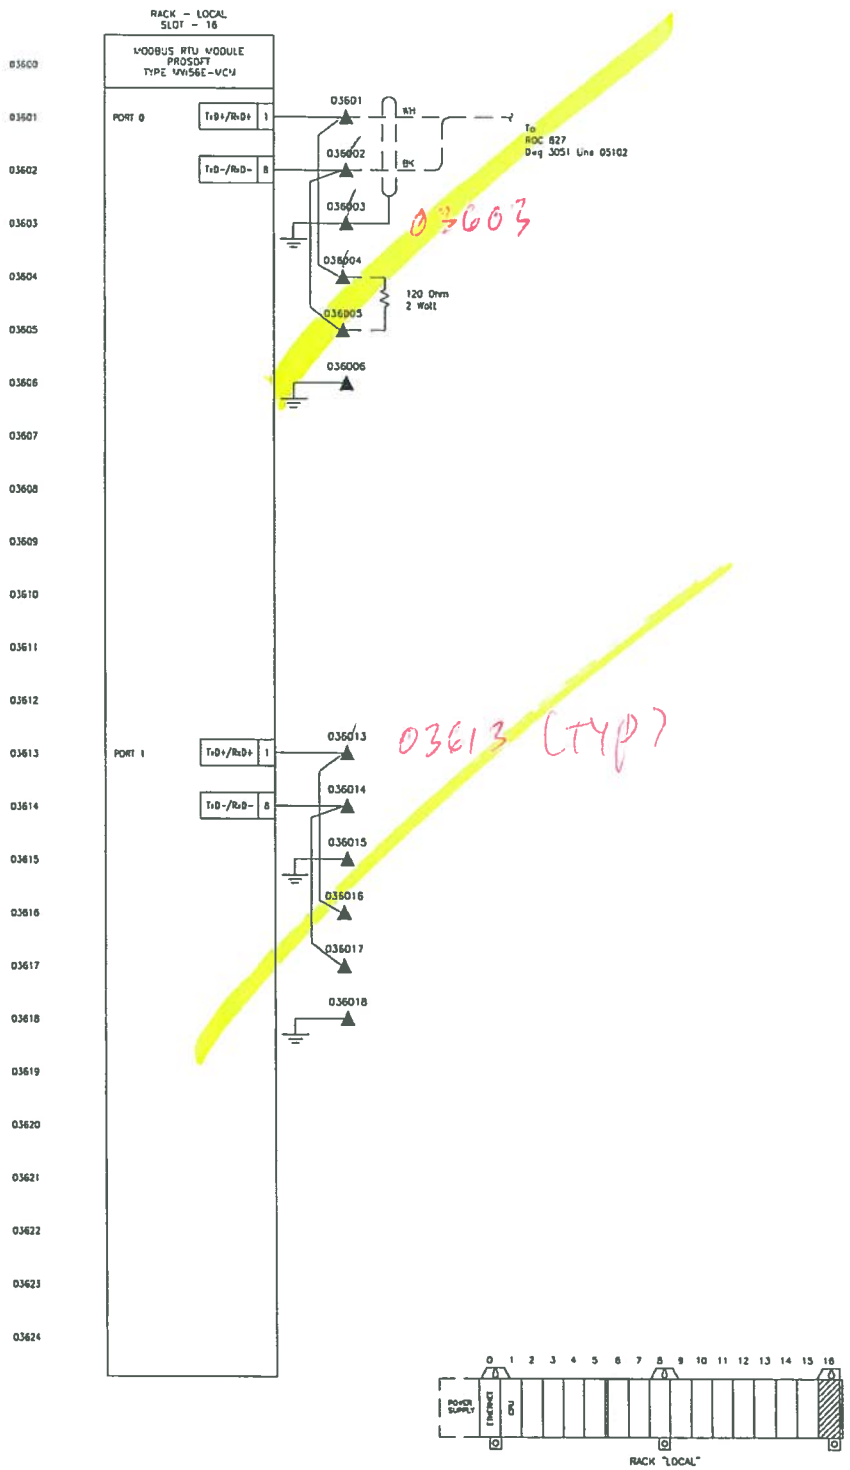

DRAWING#	REFERENCE DRAWING TITLE

REV	DATE	DESCRIPTION	DWN	CHKD	APPR
A	22JUL2013	ISSUED FOR REVIEW	RR	CF	–
B	08OCT2013	ISSUED FOR APPROVAL	R.R	MG	MG
0	21OCT2013	ISSUED FOR CONSTRUCTION	R.R	MG	MG

ENGINEER STAMP

PROFESSIONAL ENGINEER
PROVINCE OF BRITISH COLUMBIA
M. A. GHALY
38913

OCT 2 4 2013

THIS DRAWING IS THE PROPERTY OF PENN WEST ENERGY TRUST AND ANY REPRODUCTION IN WHOLE OR PART WITHOUT EXPRESS WRITTEN PERMISSION IS PROHIBITED.

PIONEER ENGINEERING INC.

THIRD PARTY LOGO

SCALE: AS SHOWN | SIZE: D

EPCM PROJECT#: 13053

PennWest Exploration

CORDOVA – MULTI WELL TIE-IN
PENN WEST WELLSITE
d-055-A/094-P-10
IO SCHEMATICS

DWG# d055A094P10-ELC-3036 | SHT 17 OF 17 | REV 0