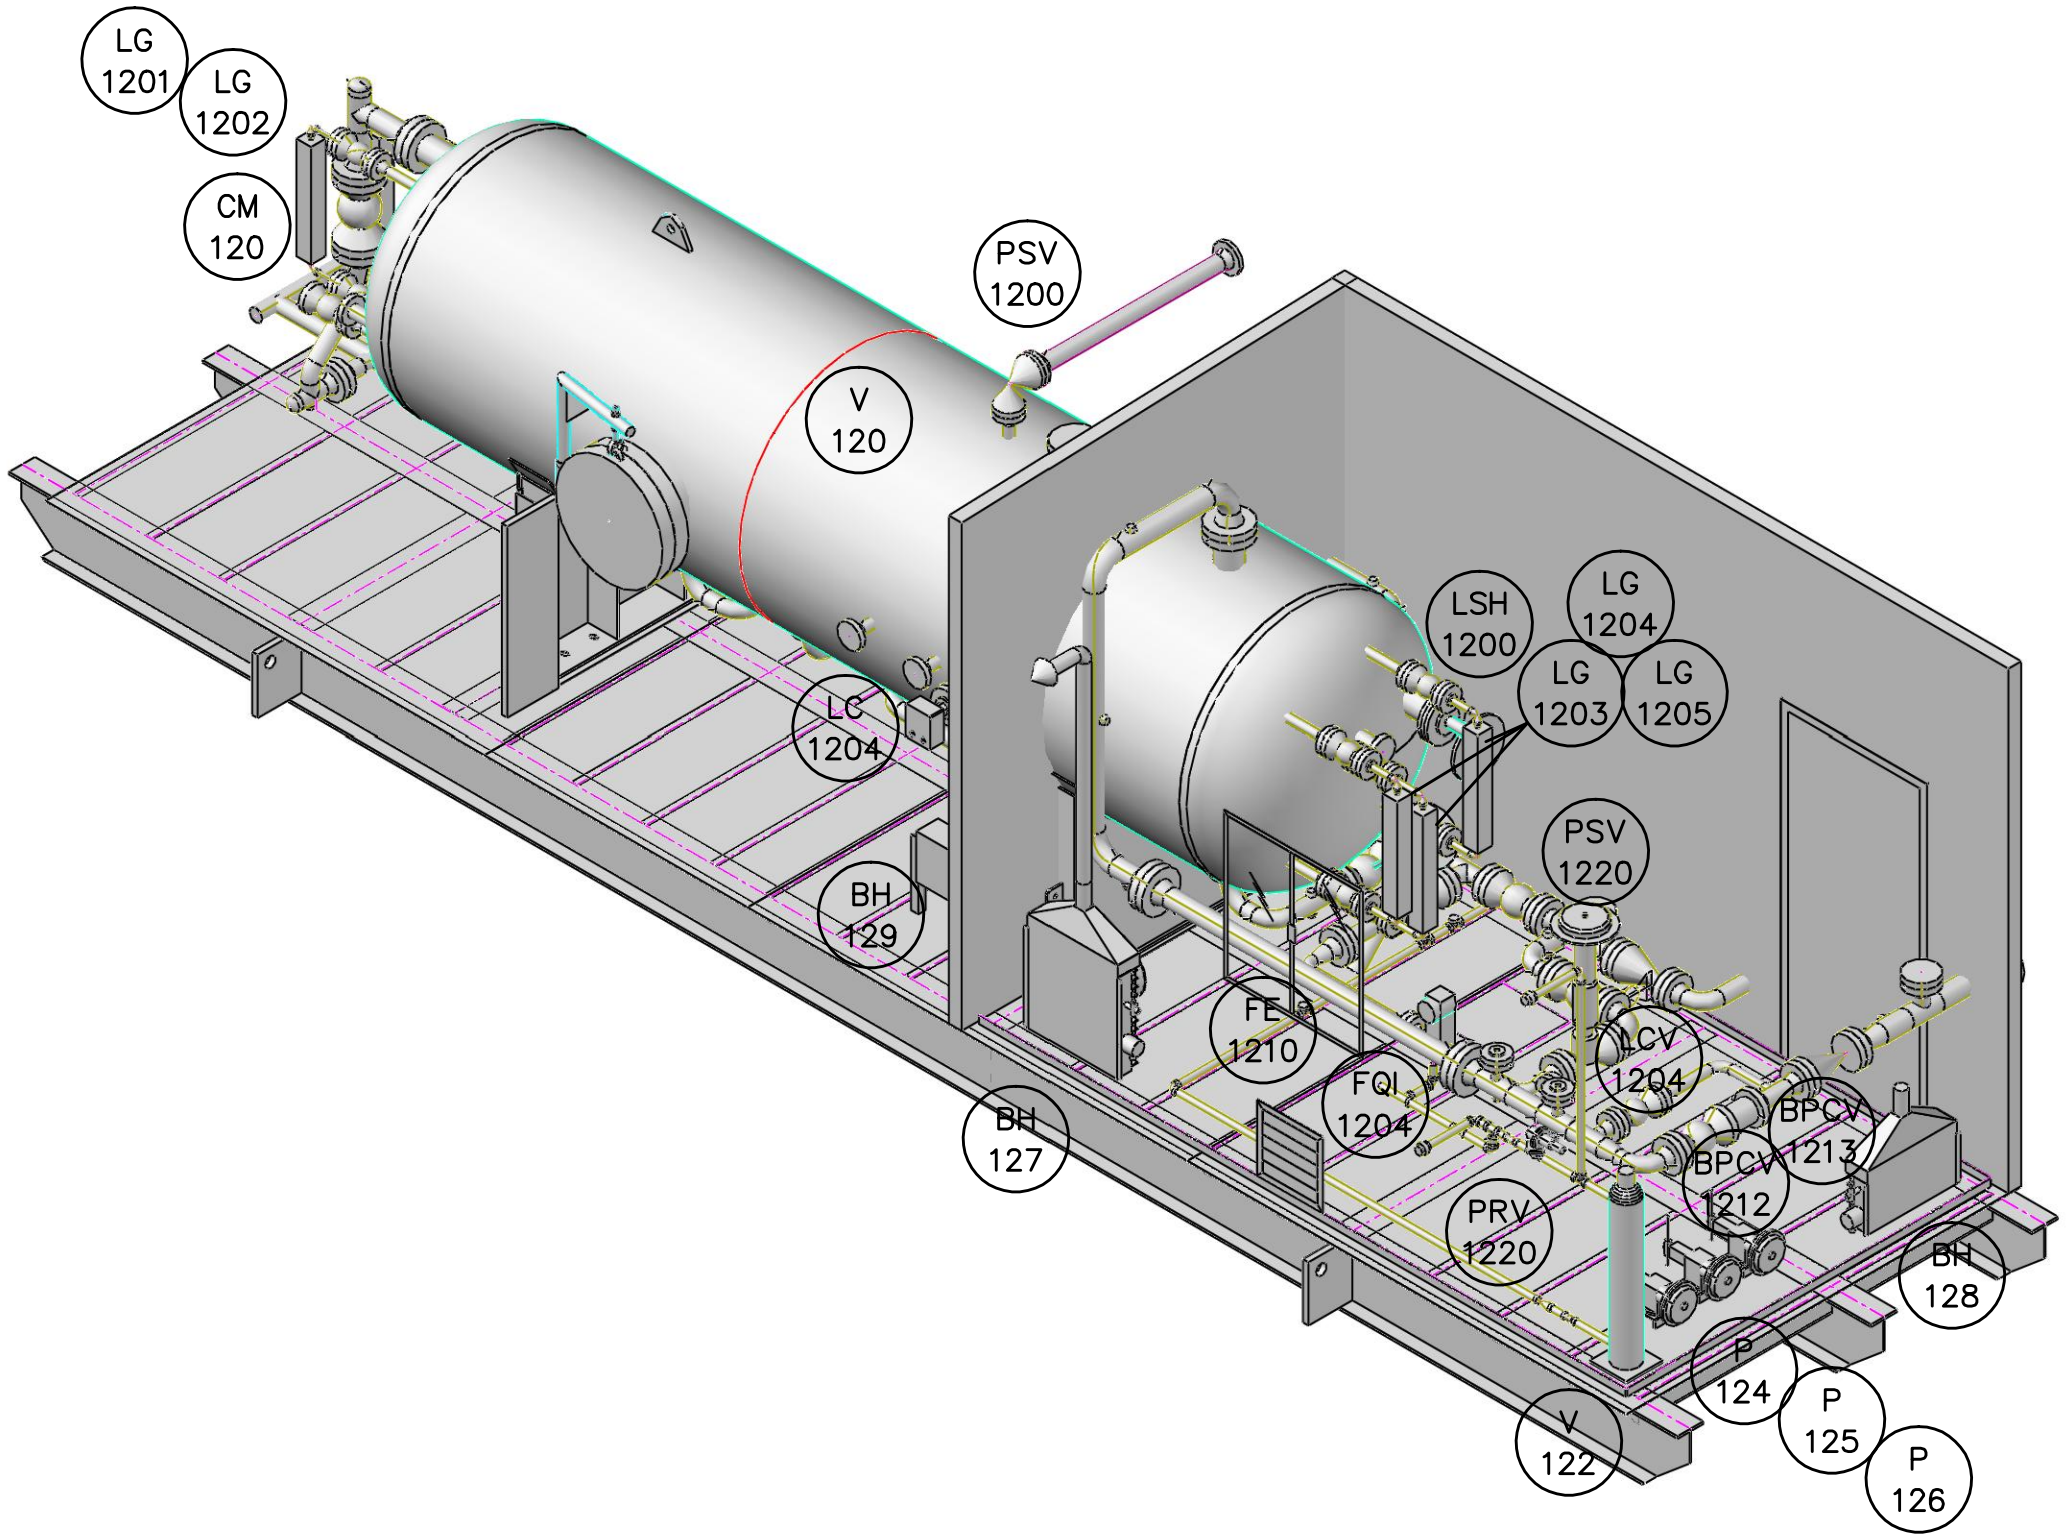

WELD DETAIL 1 (SEE NOTE 4) | WELD DETAIL 2 | WELD DETAIL 3

REV	REVISIONS	DATE	BY	CHK'D	APP'D	OWNR APP'D
2	AS BUILT	10-01-18	JS			
1	REVISED AS PER CUSTOMER	09-11-19	JS			
0	ISSUED FOR CONSTRUCTION	09-08-10	DF			
C	REVISED VESSEL	09-08-04	JS			
B	REVISED VESSEL	09-07-28	JS			
A	ISSUED FOR APPROVAL	09-07-23	JS			

Paintearth ENERGY SERVICES

THIS DRAWING IS THE PROPERTY OF PAINTEARTH ENERGY SERVICES.
ANY UNAUTHORIZED USE OR REPRODUCTION OF THIS DESIGN OR
DRAWING WITHOUT WRITTEN AUTHORIZATION IS STRICTLY PROHIBITED.

DESIGNED	PES	
DRAWN	PES	-
CHECKED		
OWNER APP.		
OWNER APP.		

APACHE
CO CODE: APPROVER ID#:
LSD:

60"ID x 18'-0"S/S SOUR HORIZ. DESAND PACKAGE
DESIGN PRESSURE: 1000 PSIG @500'F

PROJECT NO.	FILE NAME	REFERENCE NO.
10449	10449 GA ISO	.

SHEET NO.	SCALE	DWG. NO.	
1 OF 4	AS SHOWN	PES-10449 GA ISO	2