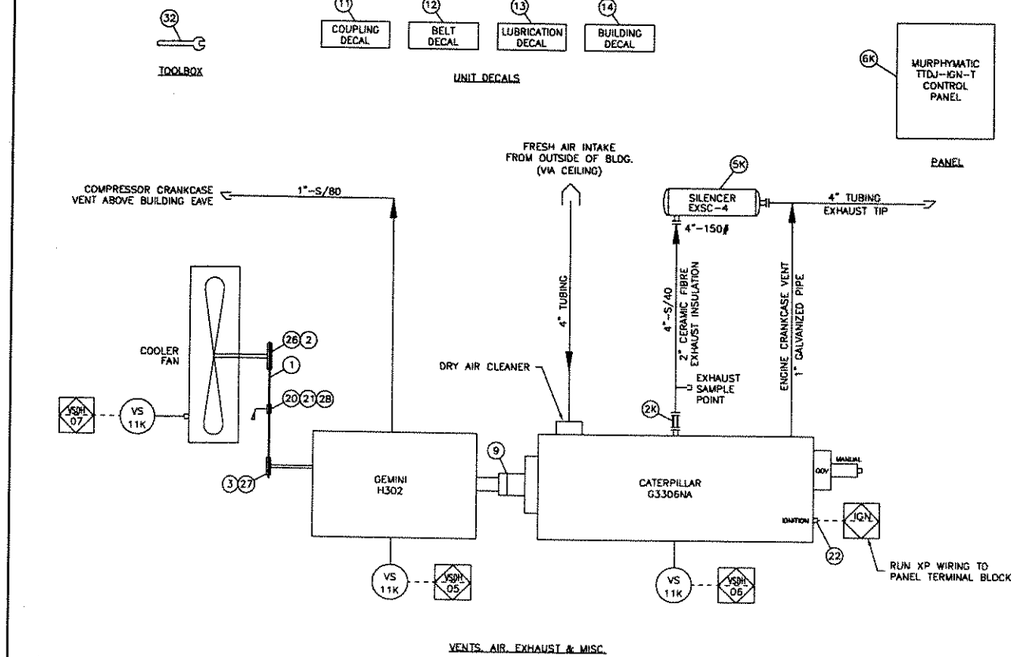

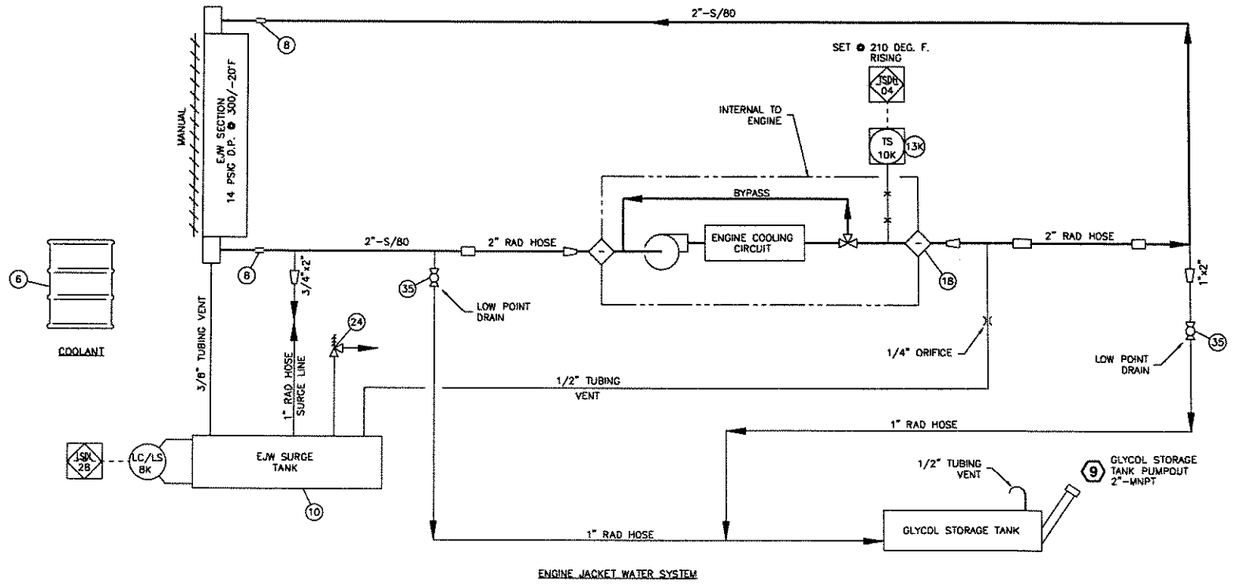

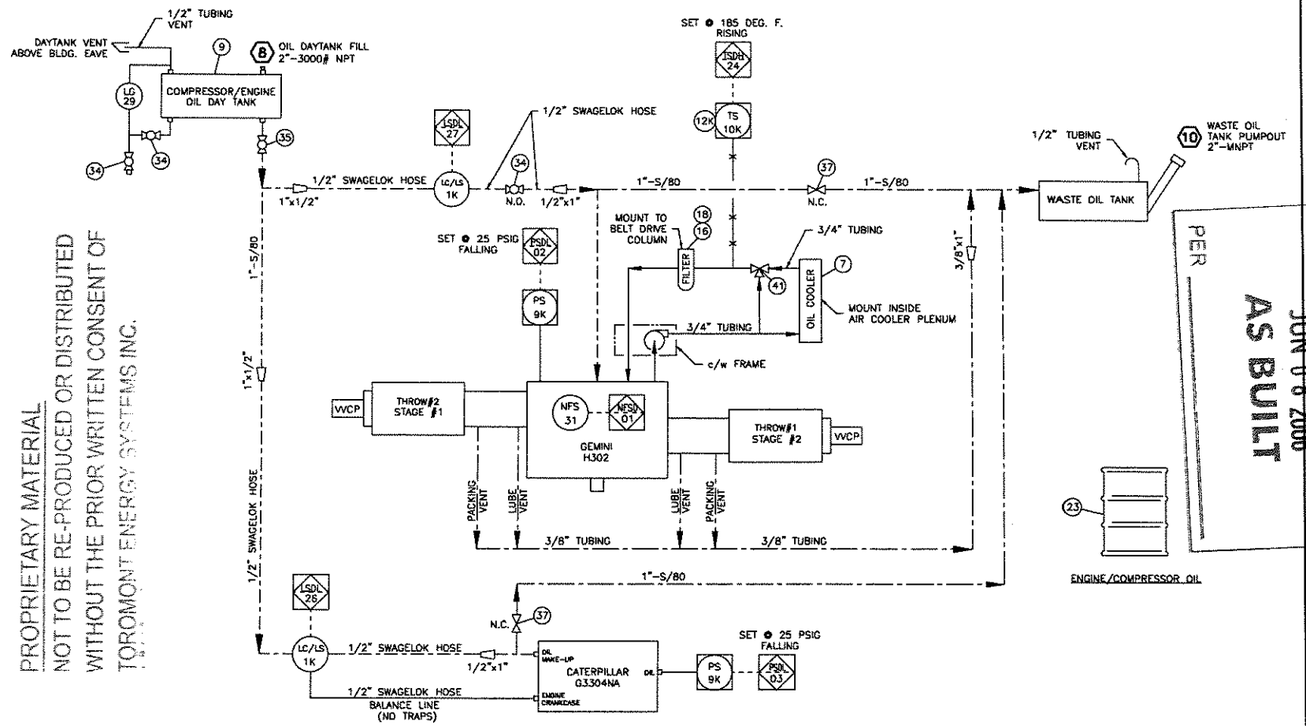

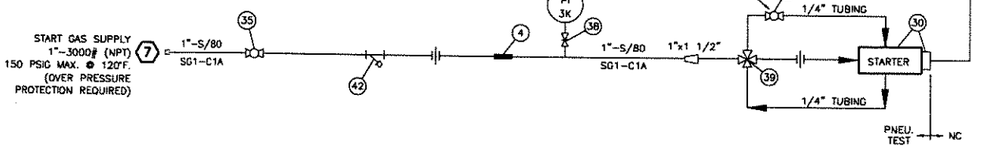

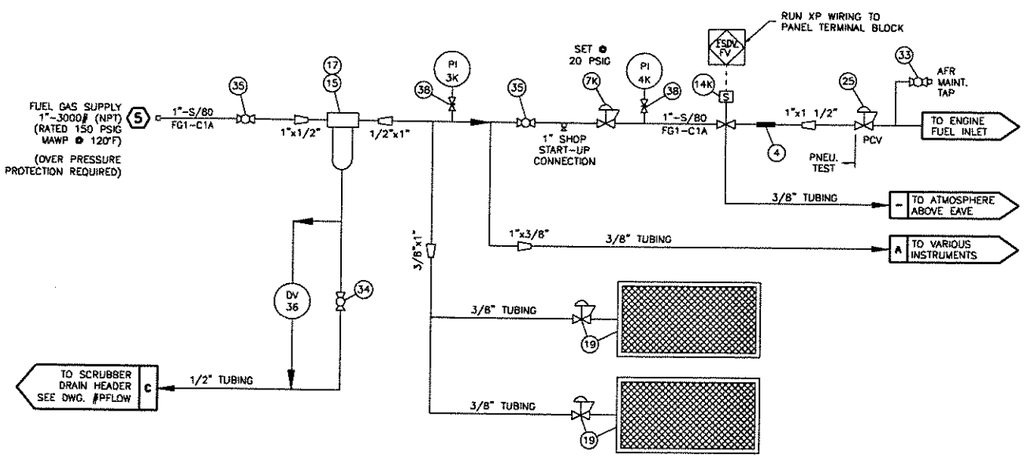

PROPRIETARY MATERIAL
NOT TO BE RE-PRODUCED OR DISTRIBUTED
WITHOUT THE PRIOR WRITTEN CONSENT OF
TOROMONT ENERGY SYSTEMS INC.

NOTES

1. START & FUEL VALVES SHOULD BE EASILY ACCESSIBLE.
2. FOR ALL OTHER NOTES AND GENERAL INFORMATION, SEE DWG. #PFLOW.

No.	REVISION	DATE	BY
2	AS BUILT	03/30/06	TN
1	UNIT RENTED TO YOHO RESOURCES INC.	01/20/06	TN
0	ISSUED FOR CONSTRUCTION	04/25/05	GP

TOROMONT ENERGY SYSTEMS

10121 – BARLOW TRAIL N.E. CALGARY ALBERTA CANADA

TITLE: UTILITY FLOW DIAGRAM CATERPILLAR G3306NA / GEMINI H302-2 AIR-X-CHANGERS 48EH

CUSTOMER: TOROMONT ENERGY SYSTEMS INC. STOCK 145 HP GAS COMPRESSOR

SCALE: NONE | DATE: 04/25/05 | BY: GP | DATE RELEASED: 6/19/06 | RELEASED BY: [illegible]

STEP # 510 | UNIT # 31296 | DRAWING NO.: 31296-UFLOW | REV. 2

JUN 0 8 2006
AS BUILT
PER
TOROMONT ENERGY SYSTEMS